

**WILLIAM J. CLINTON
PRESIDENTIAL
CENTER**

LITTLE ROCK, ARKANSAS

Architect
POLSHKE PARTNERSHIP LLP
320 West 13th Street
New York, New York 10014
212.807.7171

Coordinating Architects
POLK STANLEY YEARY ARCHITECTS Ltd
700 South Schiller Street
Little Rock, Arkansas 72201
501.378.0878

WITSELL EVANS RASCO
901 West Third Street
Little Rock, Arkansas 72201
501.374.5300

WOODS CARADINE ARCHITECTS
2200 South Main Street
Little Rock, Arkansas 72206
501.374.4060

Landscape Architects
HARGREAVES ASSOCIATES
118 Magazine Street
Cambridge, Massachusetts 02139
617.661.0070

LANDSCAPE ARCHITECTURE, Inc.
2300 Cottondale Lane Suite 202
Little Rock, Arkansas 72202
501.374.5810

Structural Engineer
LESLIE E. ROBERTSON ASSOC., RLLP
30 Broad Street, 47th Floor
New York, New York 10004
212.750.9000

MEP Engineers
FLACK + KURTZ, Inc.
475 Fifth Avenue
New York, New York 10017
212.532.9600

CROMWELL ARCHITECTS ENGINEERS
101 South Spring Street
Little Rock, Arkansas 72201
501.372.2900

Curtainwall Consultant
R. A. HEINTGES ARCHITECTS
126 Fifth Avenue, 9th Floor
New York, New York 10011
212.652.2968

Seal

AS1 # 23	09/12/03
AS1 # 20	08/06/03
AS1 # 19	05/07/03
AS1 # 18	04/18/03
AS1 # 15	02/28/03
100% Construction Documents	09/27/02
90% Progress Printing	08/30/02
100% Struct./CD Progress	07/01/02
Issue	Date


Job No. 9908
Scale 1/4" = 1'-0"
Date September 27, 2002
Title

**ORIENTATION THEATER:
ENLARGED PLANS
AND ELEVATIONS**


Sheet No.

A551


FOR OFFICIAL USE ONLY

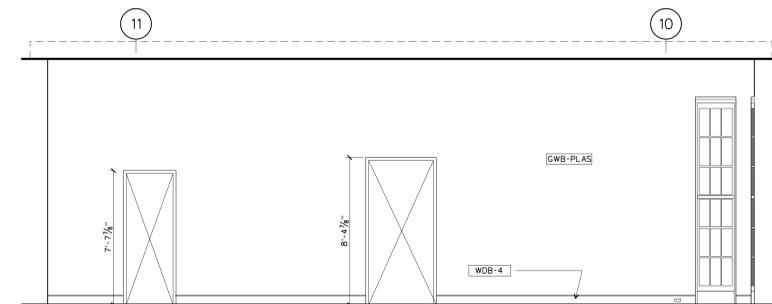


4-02 SKY LOBBY: PARTIAL WEST ELEVATION 50
SCALE: 1/4" = 1'-0"
9908/base/elev/b-inel15

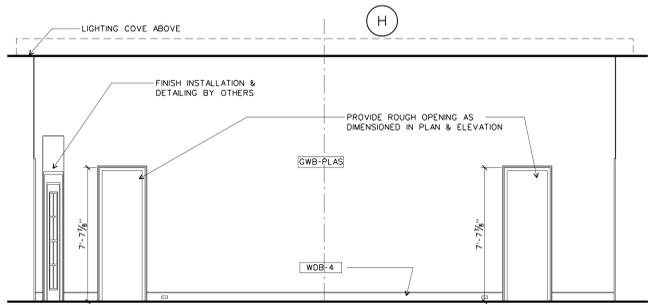


4-02 SKY LOBBY: PARTIAL NORTH ELEVATION 42
SCALE: 1/4" = 1'-0"
9908/base/elev/b-inel15

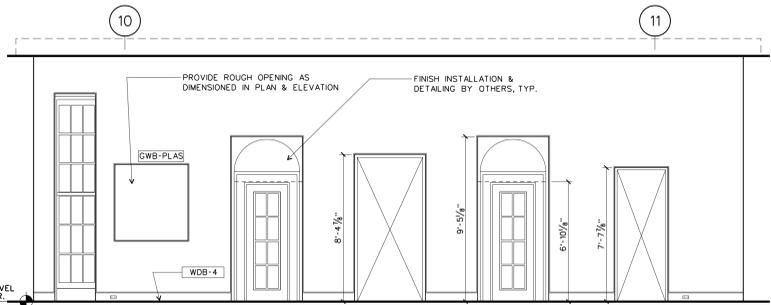


4-02 SKY LOBBY: PARTIAL WEST ELEVATION 41
SCALE: 1/4" = 1'-0"
9908/base/elev/b-inel15

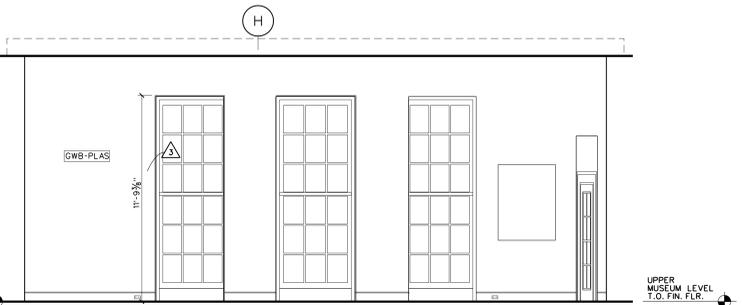


4-02 SKY LOBBY: PARTIAL SOUTH ELEVATION 40
SCALE: 1/4" = 1'-0"
9908/base/elev/b-inel15

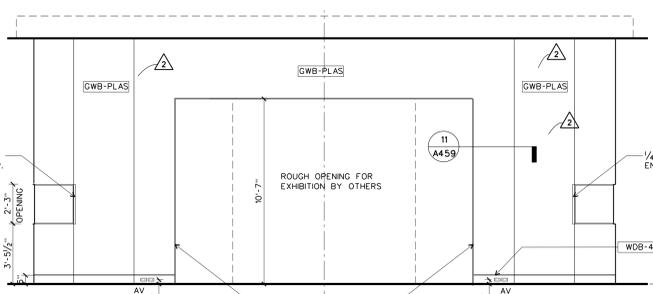


3-02 SKY LOBBY: PARTIAL NORTH ELEVATION 32
SCALE: 1/4" = 1'-0"
9908/base/elev/b-inel15

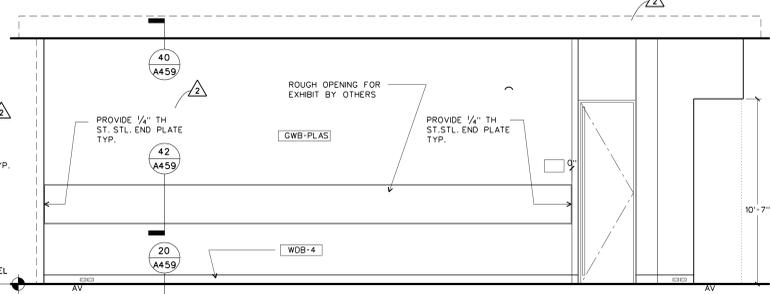


3-02 SKY LOBBY: PARTIAL WEST ELEVATION 31
SCALE: 1/4" = 1'-0"
9908/base/elev/b-inel15

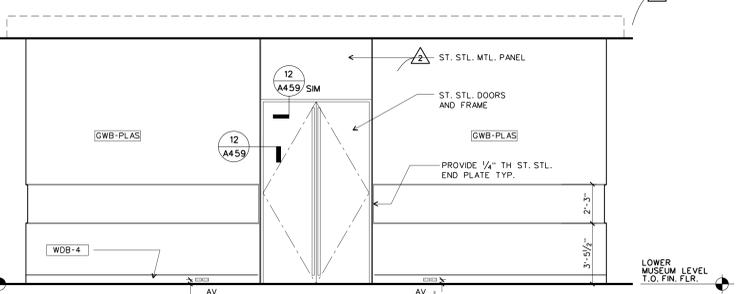


3-02 SKY LOBBY: PARTIAL SOUTH ELEVATION 30
SCALE: 1/4" = 1'-0"
9908/base/elev/b-inel15

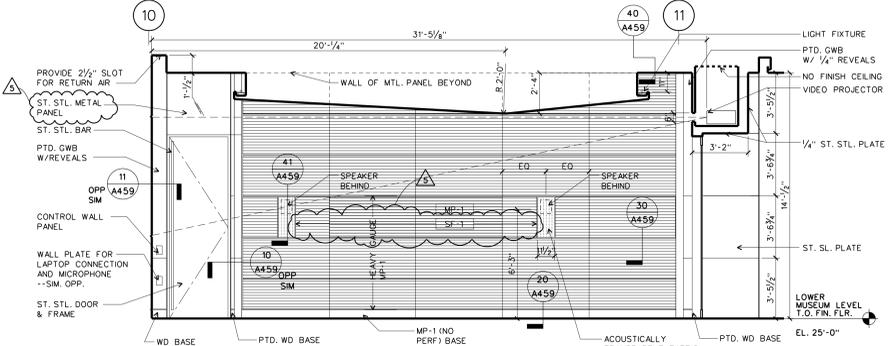


3-05 ORIENTATION THEATER: EAST ELEVATION 21
SCALE: 1/4" = 1'-0"
9908/base/elev/b-inel14

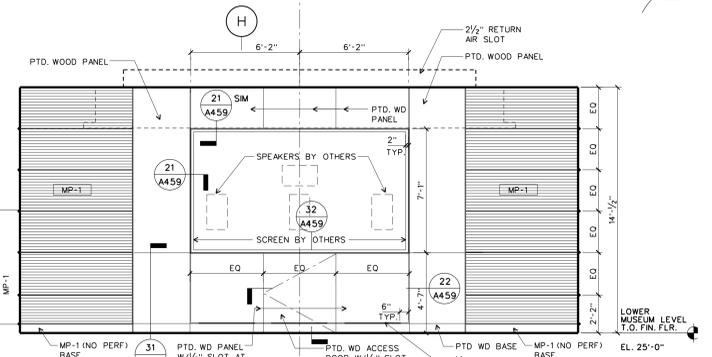

3-05 ORIENTATION THEATER: NORTH ELEVATION 12
SCALE: 1/4" = 1'-0"
9908/base/elev/b-inel14

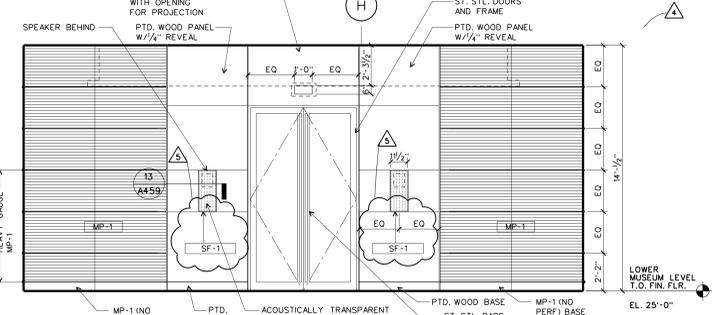

3-05 ORIENTATION THEATER: SOUTH ELEVATION 11
SCALE: 1/4" = 1'-0"
9908/base/elev/b-inel14

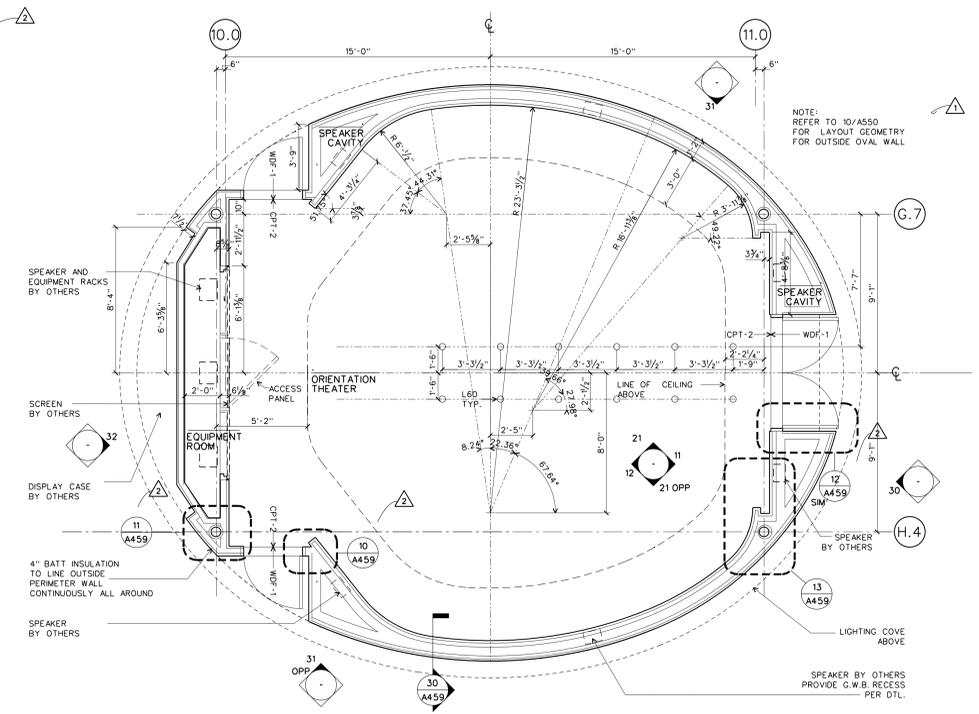

3-05 ORIENTATION THEATER: ENLARGED PLAN 10
SCALE: 1/4" = 1'-0"
9908/base/plans/orientation