

**WILLIAM J. CLINTON
PRESIDENTIAL
CENTER**

LITTLE ROCK, ARKANSAS

Architect
POLSHEK PARTNERSHIP LLP
320 West 13th Street
New York, New York 10014
212.807.7171

Coordinating Architects
POLK STANLEY YEARY ARCHITECTS Ltd
700 South Schiller Street
Little Rock, Arkansas 72201
501.378.0878

WITSELL EVANS RASCO
901 West Third Street
Little Rock, Arkansas 72201
501.374.5300

WOODS CARADINE ARCHITECTS
2200 South Main Street
Little Rock, Arkansas 72206
501.374.4060

Landscape Architects
HARGREAVES ASSOCIATES
118 Magazine Street
Cambridge, Massachusetts 02139
617.661.0070

LANDSCAPE ARCHITECTURE, Inc.
2300 Cottondale Lane Suite 202
Little Rock, Arkansas 72202
501.374.5810


Structural Engineer
LESLIE E. ROBERTSON ASSOC., RLLP
30 Broad Street, 47th Floor
New York, New York 10004
212.750.9000

MEP Engineers
FLACK + KURTZ Inc.
475 Fifth Avenue
New York, New York 10017
212.532.9600


CROMWELL ARCHITECTS ENGINEERS
101 South Spring Street
Little Rock, Arkansas 72201
501.372.2900

Curtainwall Consultant
R. A. HEINTGES ARCHITECTS
126 Fifth Avenue, 9th Floor
New York, New York 10011
212.652-2968


- NOTES:
1. OVAL OFFICE SECTIONS ARE DIMENSIONED TO THE STUDS UNLESS OTHERWISE NOTED
 2. SEE EXHIBIT CONSTRUCTION DRAWINGS FOR ADDITIONAL ROOM INFORMATION

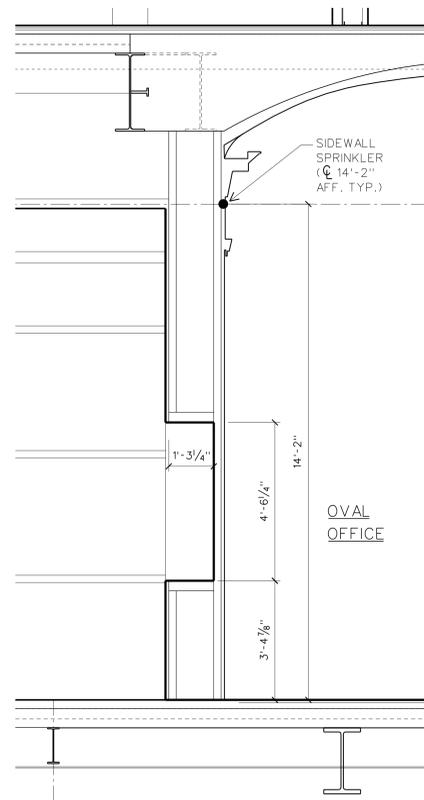


OVAL OFFICE WALL SECTION 22
SCALE: 1/2" = 1'-0" OVAL4.DGN

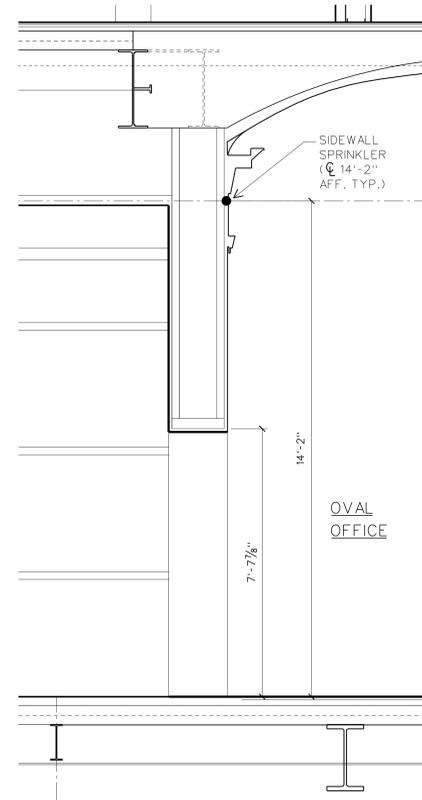


OVAL OFFICE WALL SECTION 21
SCALE: 1/2" = 1'-0" OVAL4.DGN

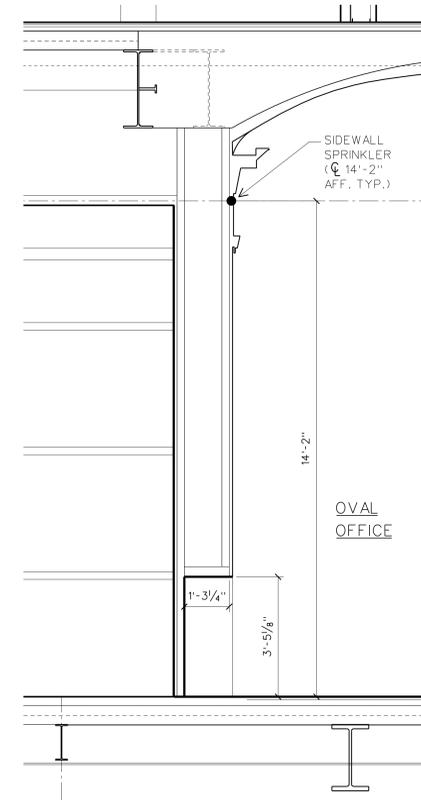


OVAL OFFICE WALL SECTION 20
SCALE: 1/2" = 1'-0" OVAL4.DGN

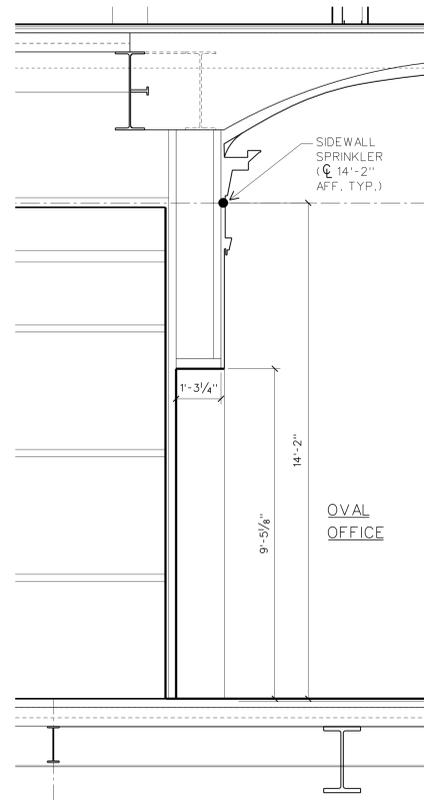


OVAL OFFICE WALL SECTION 13
SCALE: 1/2" = 1'-0" OVAL4.DGN

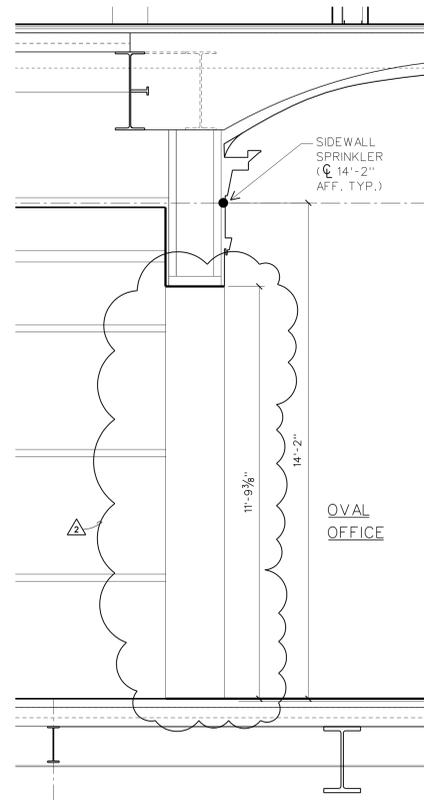

OVAL OFFICE WALL SECTION 12
SCALE: 1/2" = 1'-0" OVAL4.DGN

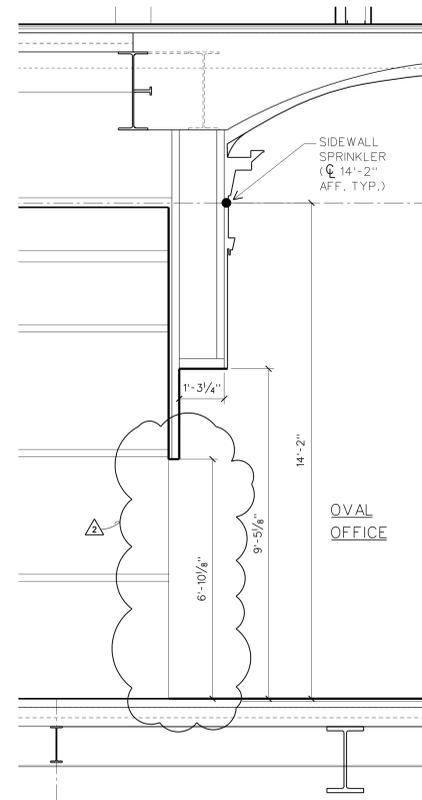


OVAL OFFICE WALL SECTION 11
SCALE: 1/2" = 1'-0" OVAL4.DGN

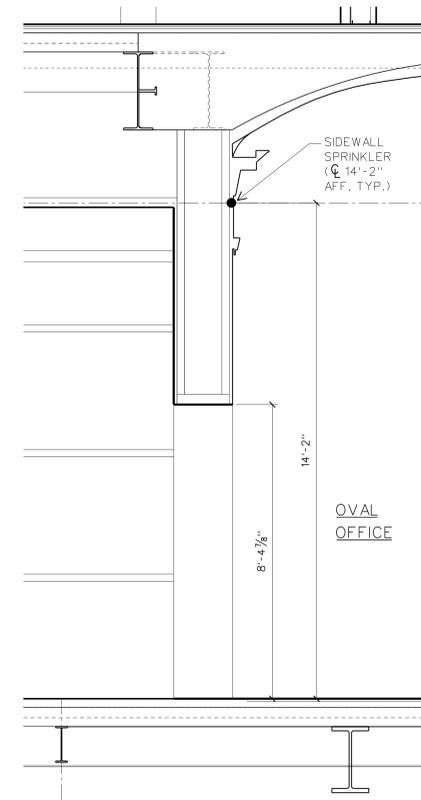

OVAL OFFICE WALL SECTION 10
SCALE: 1/2" = 1'-0" OVAL4.DGN

Seal

Issue	Date
ASI # 15	02/28/03
ASI # 13	02/14/03

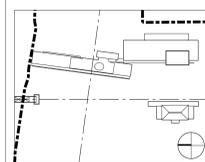

Job No. 9908

Scale 1/4" = 1'-0"

Date September 27, 2002

Title

**OVAL OFFICE
WALL SECTIONS**

Sheet No. SDA-048

A552

FOR OFFICIAL USE ONLY