




**CABINET ROOM SECTION 34**  
SCALE: 1/2" = 1'-0" CABINET.DGN

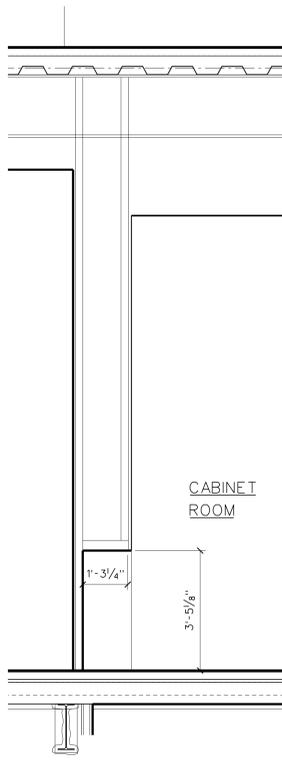


**CABINET ROOM SECTION 33**  
SCALE: 1/2" = 1'-0" CABINET.DGN

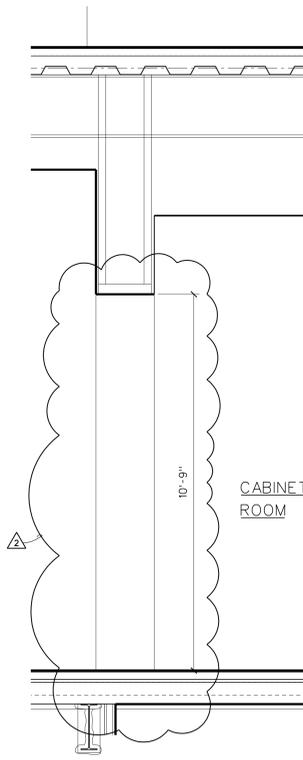


**CABINET ROOM SECTION 32**  
SCALE: 1/2" = 1'-0" CABINET.DGN

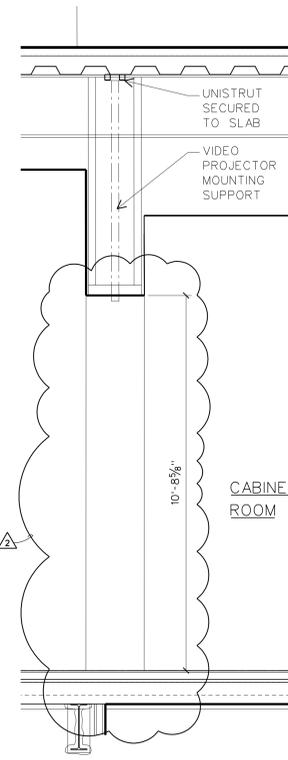


**CABINET ROOM SECTION 31**  
SCALE: 1/2" = 1'-0" CABINET.DGN

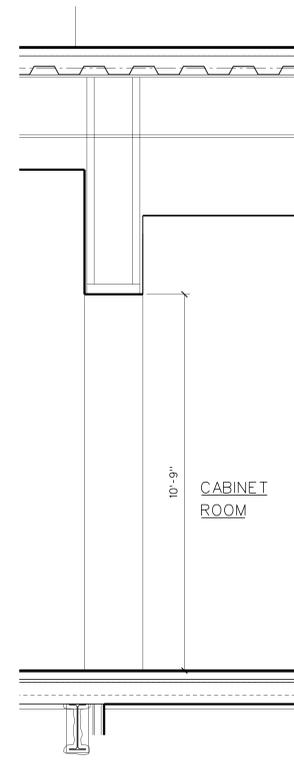


**CABINET ROOM SECTION 30**  
SCALE: 1/2" = 1'-0" CABINET.DGN

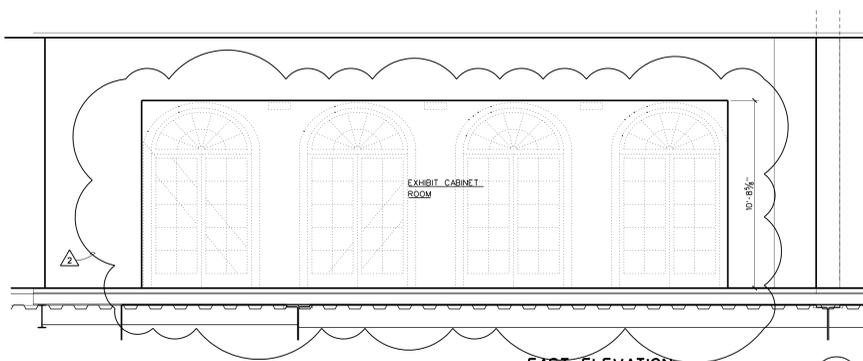


**EAST ELEVATION 22**  
SCALE: 1/4" = 1'-0" CABINET.DGN

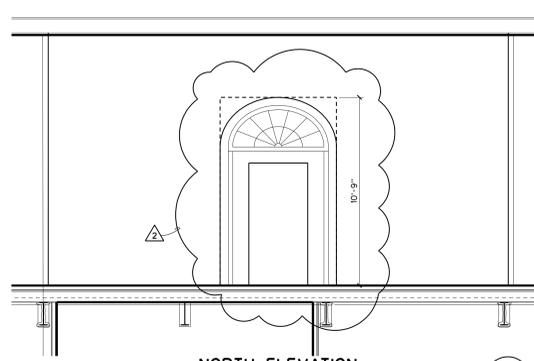

**NORTH ELEVATION 21**  
SCALE: 1/4" = 1'-0" CABINET.DGN

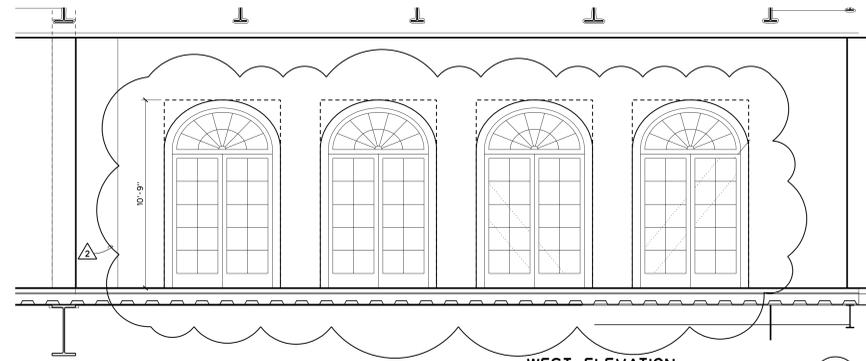


**WEST ELEVATION 20**  
SCALE: 1/4" = 1'-0" CABINET.DGN

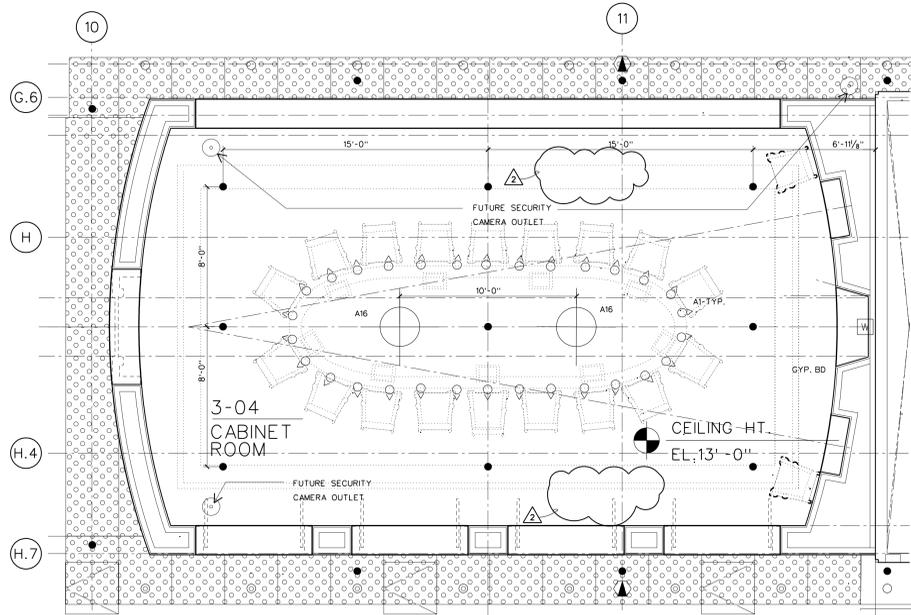

**CABINET ROOM CEILING PLAN 11**  
SCALE: 1/4" = 1'-0" CABINET.DGN

- NOTES:
1. CABINET ROOM SECTIONS ARE DIMENSIONED TO THE STUDS UNLESS OTHERWISE NOTED
  2. SEE EXHIBIT CONSTRUCTION DRAWINGS FOR ADDITIONAL ROOM INFORMATION

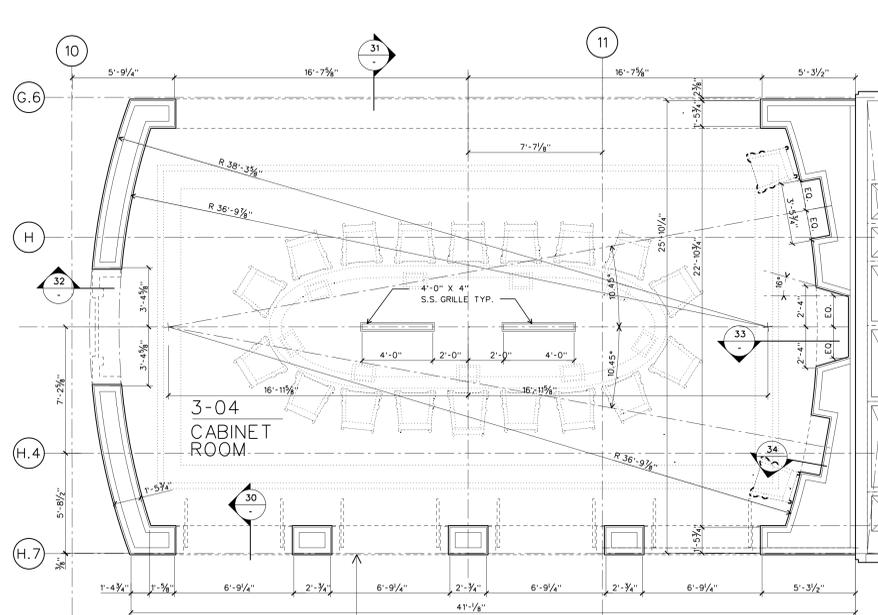

**CABINET ROOM PLAN 10**  
SCALE: 1/4" = 1'-0" CABINET.DGN