


ARCHITECTURAL FINISHES & MATERIALS

FLOORING

ST - 2
STONE FLOORING

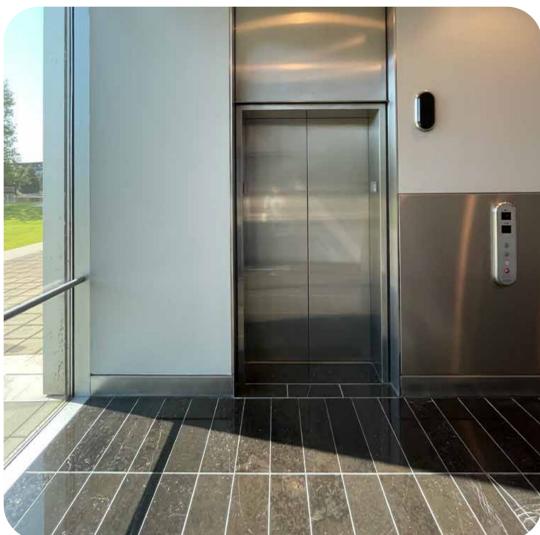


DESCRIPTION
Marble Flooring

LOCATIONS
- Basement & Ground Floor Elevator Lobby
- Ground Floor Primary Lobby
- Ground Floor Travelling Exhibit Space - at entry and perimeter of room
- NARA Main Stair

CONDITION
- Fair
- Some scratches at Ground Level

ST - 2E
EXTERIOR STONE FLOORING

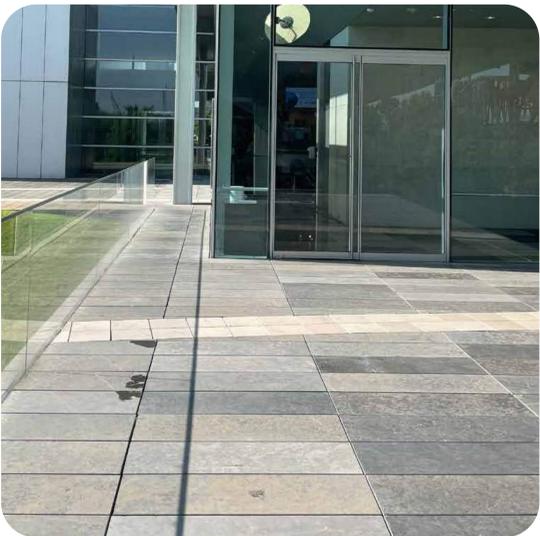

24"x48"x1" stone paver on pedestal system

- Ground Floor Outdoor Terrace (north and south)

- Fair
- Some tiles missing

ST - 3
STONE FLOORING



24"x48"x1" stone paver over 2" topping slab in 3" structural slab recess


- Basement Lobby and Ground Floor Main Lobby band
- Cafe Perimeter
- Corridor to Cafe
- Lower Museum Level
- North Stair

Fair

ARCHITECTURAL FINISHES & MATERIALS

FLOORING

ST - 4
EXTERIOR CONCRETE PAVER

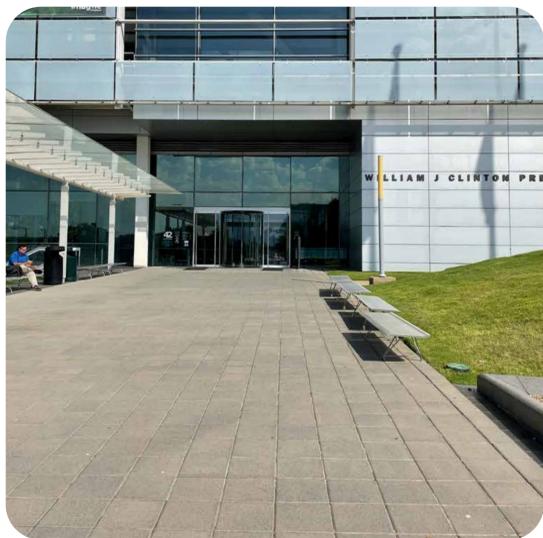

DESCRIPTION

Precast Concrete Paver - Exterior use only

LOCATIONS

- Cafe Terrace Border
- Ground Floor Outdoor Terrace band (north and south)

CONDITION

Good

ST - 5
EXTERIOR STONE FLOORING




(Light) 24"x48"x1" Precast Concrete Paver on pedestal system - Exterior use only

- Cafe Terrace Border
- Ground Floor Outdoor Terrace band (north and south)

Good

ST - 5A
EXTERIOR STONE FLOORING

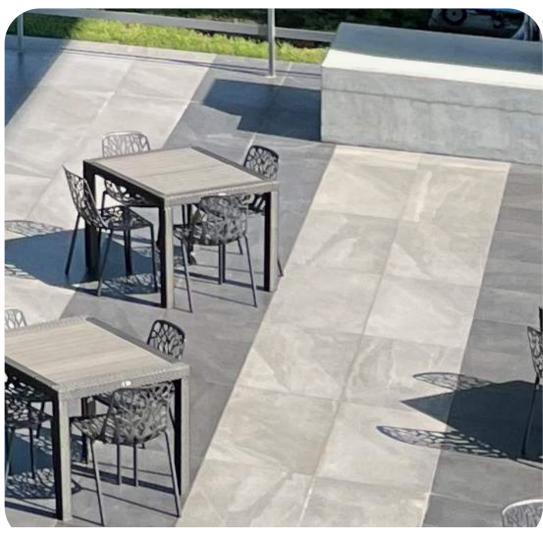

(Dark) 24"x48"x1" Precast Concrete Paver on pedestal system - Exterior use only


- Cafe Terrace Border
- Ground Floor Outdoor Terrace band (north and south)

Good

ARCHITECTURAL FINISHES & MATERIALS

FLOORING

CT - 1
TILE FLOORING

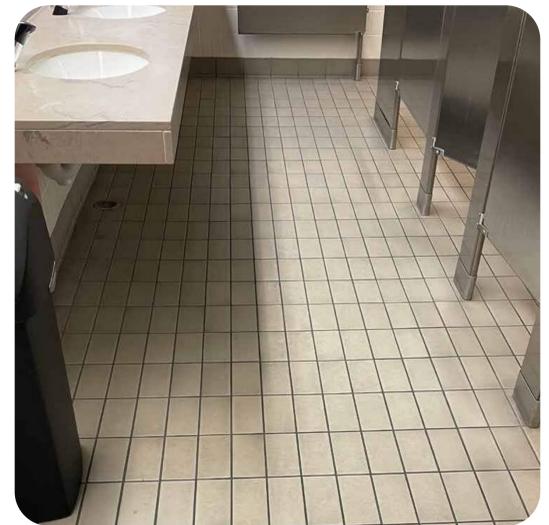

DESCRIPTION
Ceramic Tile

LOCATIONS
- Basement public re-
strooms
- Ground public re-
strooms
- Museum public re-
strooms

CONDITION
Fair
clean grout

QT - 1
TILE FLOORING



DESCRIPTION
Quarry tile on
topping slab
Base type varies

LOCATIONS
- Cafe Kitchen

CONDITION
Poor
Clean grout

WDF - 1
WOOD FLOORING



DESCRIPTION
Bamboo Wood
Flooring


LOCATIONS
- NARA Permanent
Exhibits
- NARA Temporary
Exhibits
- SKy Lobby
- Great Hall

CONDITION
- Fair
- Some scratches,
dents, marks

ARCHITECTURAL FINISHES & MATERIALS

FLOORING

WDF - 2
WOOD FLOORING

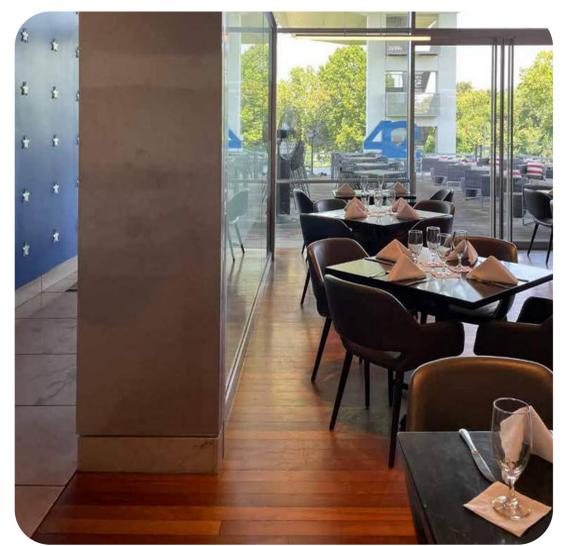

DESCRIPTION



LOCATIONS

CONDITION

- Cafe dining area
- beverage station in kitchen

- Water damage at bev. station

WDF - 3
WOOD DECK

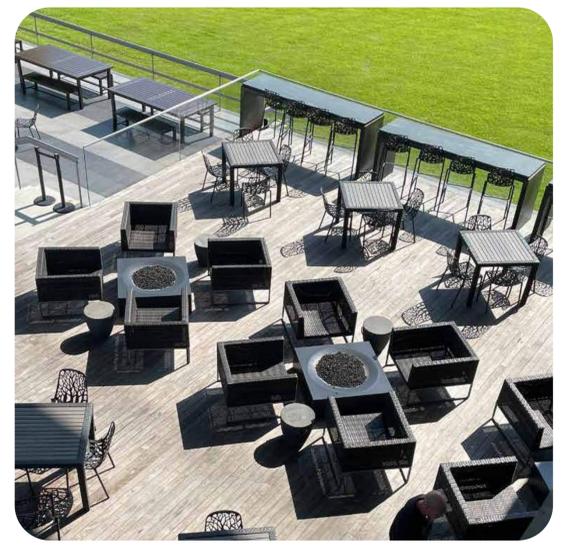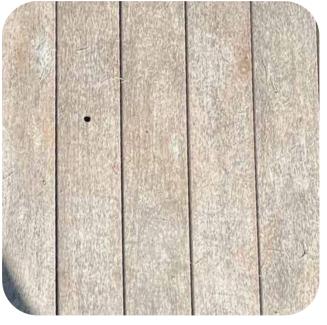

- Wood Deck (Exterior)

- Cafe Terrace

- Good

WDF - 4
WOOD FLOORING




- Executive Level Kitchen, Living room, Library

- Good

ARCHITECTURAL FINISHES & MATERIALS

FLOORING

WDF - 5
WOOD FLOORING

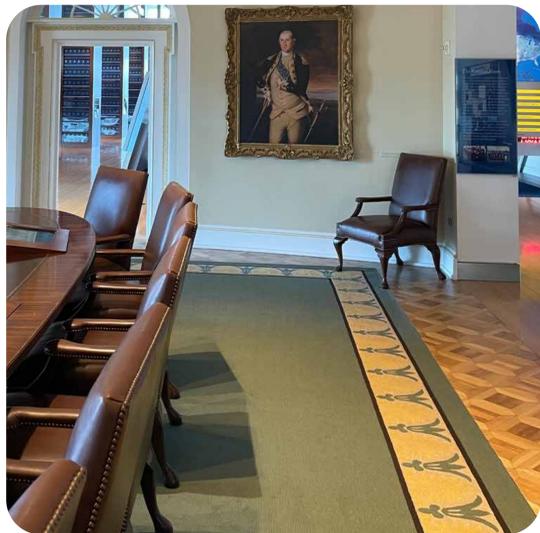

DESCRIPTION

Parquet Wood
Flooring


LOCATIONS

- Cabinet Room
(around carpet)

CONDITION

- fair
- deep scratches
- some damage at
edge transitions


CPT - 2
CARPET

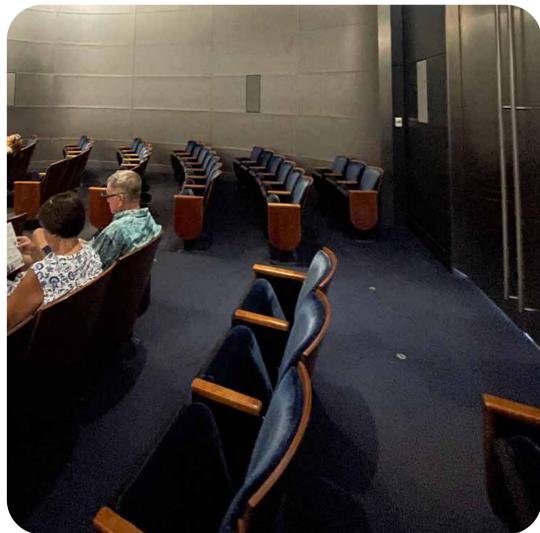

- Orientation Theater

- Good

CPT - 3
CARPET

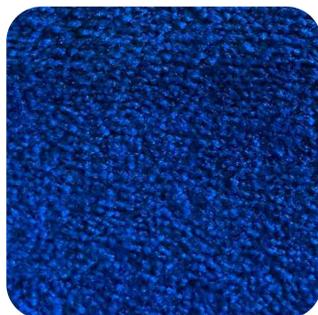


- NARA Permanent
Exhibit
- Green Rm
- Cabinet Rm

- Good

ARCHITECTURAL FINISHES & MATERIALS

FLOORING

CPT - X
CARPET

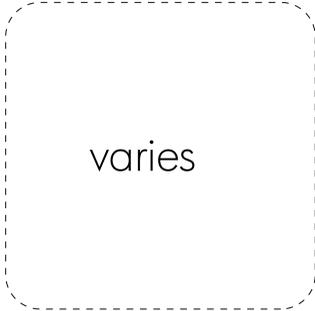

DESCRIPTION

- unknown

LOCATIONS

- Private Dining Rm (Basement Level)
- Lobby Event Space (Ground Floor)
- NARA Offices, Volunteer Lounge and Coordination
- Secret Service RM

CONDITION

- Good


RF - 1
RESILIENT FLOOR



- Core Lobby at Basement, Ground Level, Lower Museum Level, Upper Museum Level
- Freight Elevator Lobby

- Fair
- Some scratches

SC - 1
SEALED CONCRETE

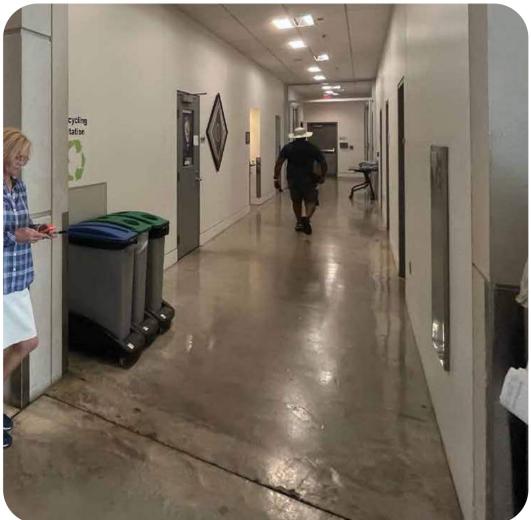


- NARA Corridors

- Good

ARCHITECTURAL FINISHES & MATERIALS

FLOORING LOCATIONS





FINISH LEGEND		
STONE FLOORING		
FLOORING	X ST-2	STONE
	X ST-2E	STONE (EXTERIOR)
	X ST-3	STONE
	X ST-4	CONC PAVERS (EXTERIOR)
	X ST-5	STONE (EXTERIOR)
	X ST-5a	STONE (EXTERIOR)
TILE FLOORING		
X CT-1	CERAMIC TILE	
X QT-1	QUARRY TILE	
WOOD FLOORING		
X WDF-1	WOOD FLOOR	
X WDF-2	WOOD FLOOR	
X WDF-3	WOOD FLOOR	
X WDF-4	WOOD FLOOR	
X WDF-5	WOOD FLOOR	
CARPET		
X CPT-1A	CARPET 1	
X CPT-2	CARPET 2	
X CPT-3	CARPET 3	
X CPT-X	CARPET TYPE TBD	
X RF-1	RESILIENT FLOOR	
X SC-1	SEALED CONCRETE	

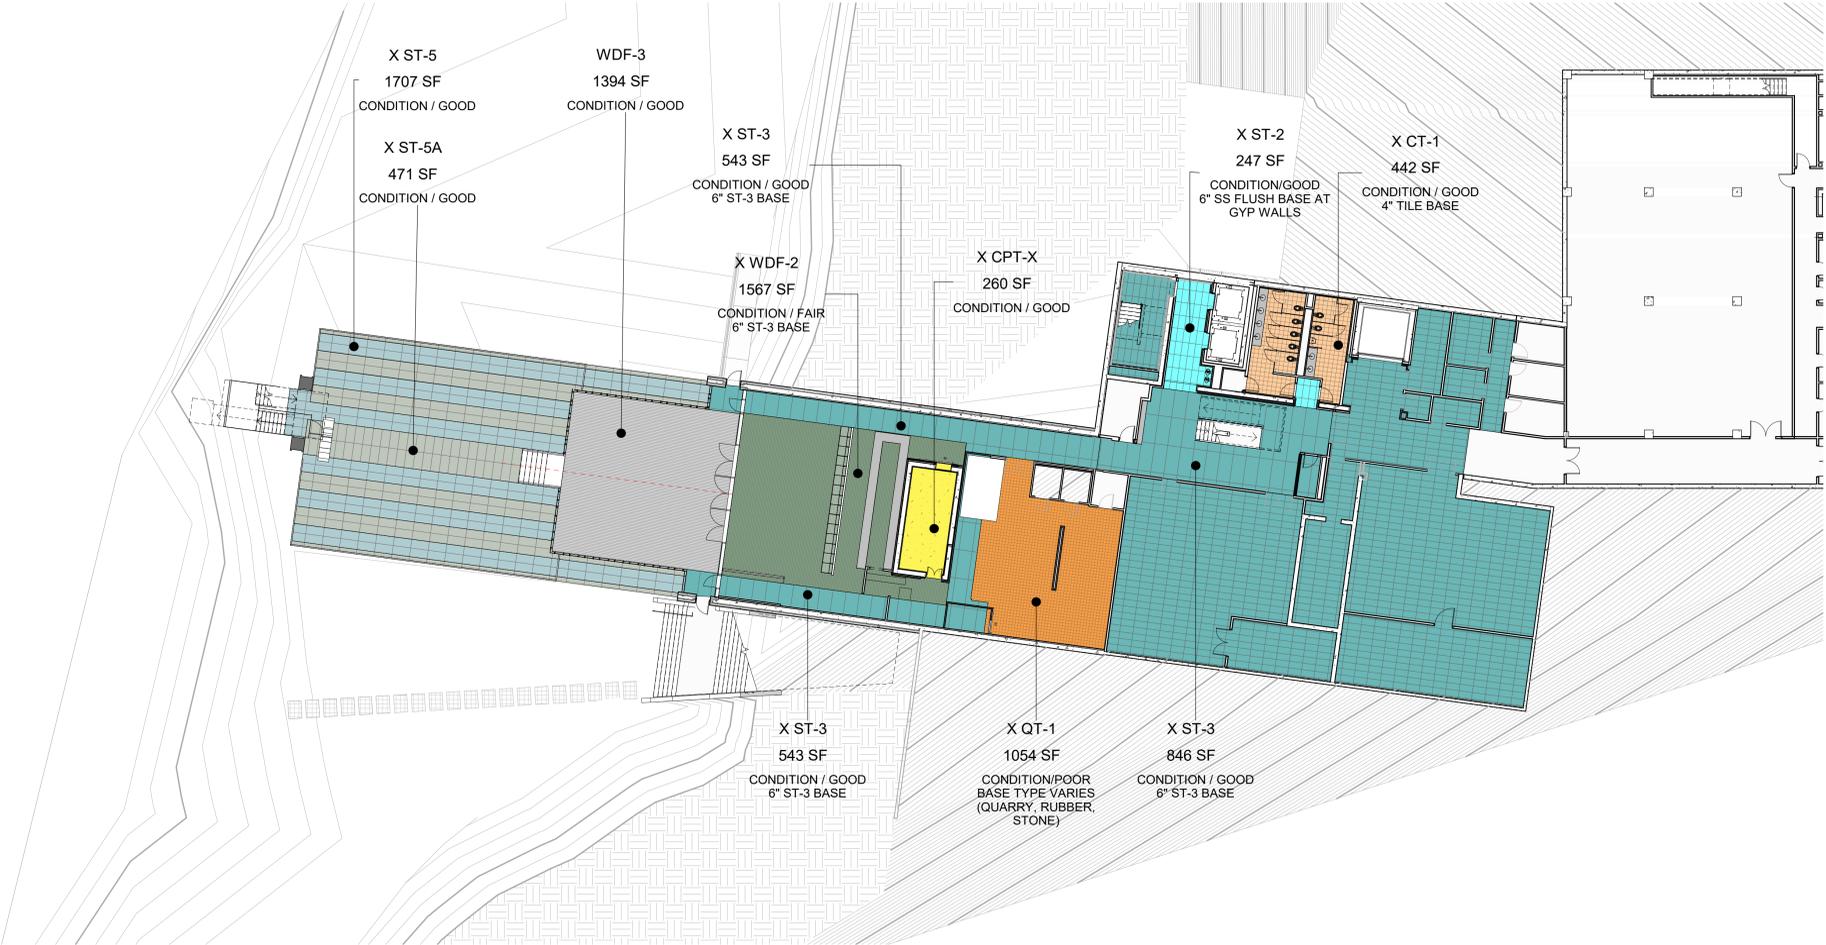

BASEMENT LEVEL

ARCHITECTURAL FINISHES & MATERIALS


FLOORING ASSESSMENT

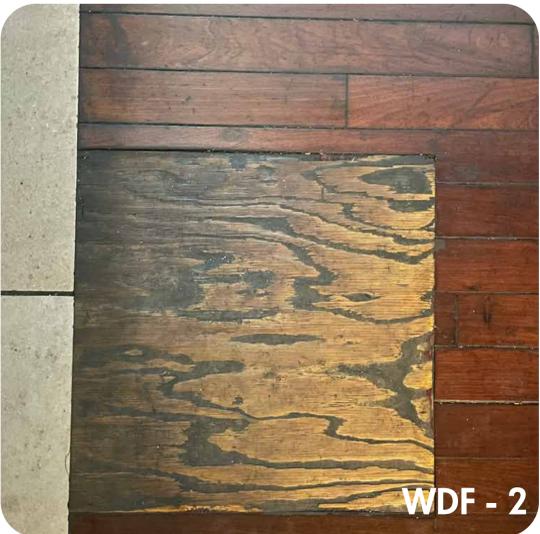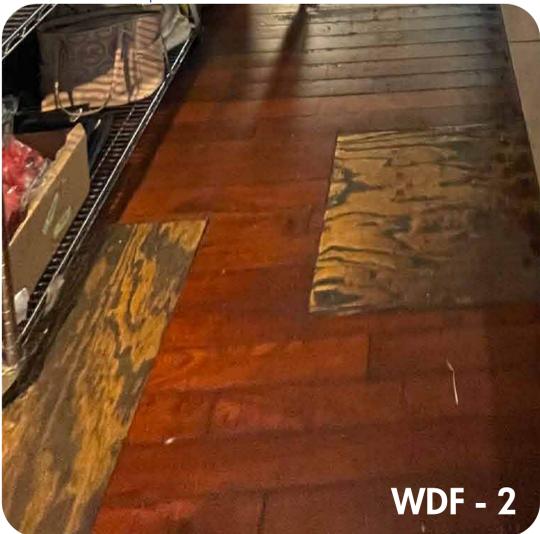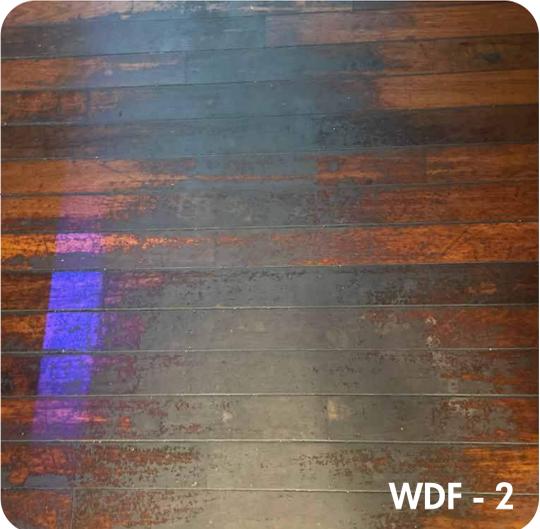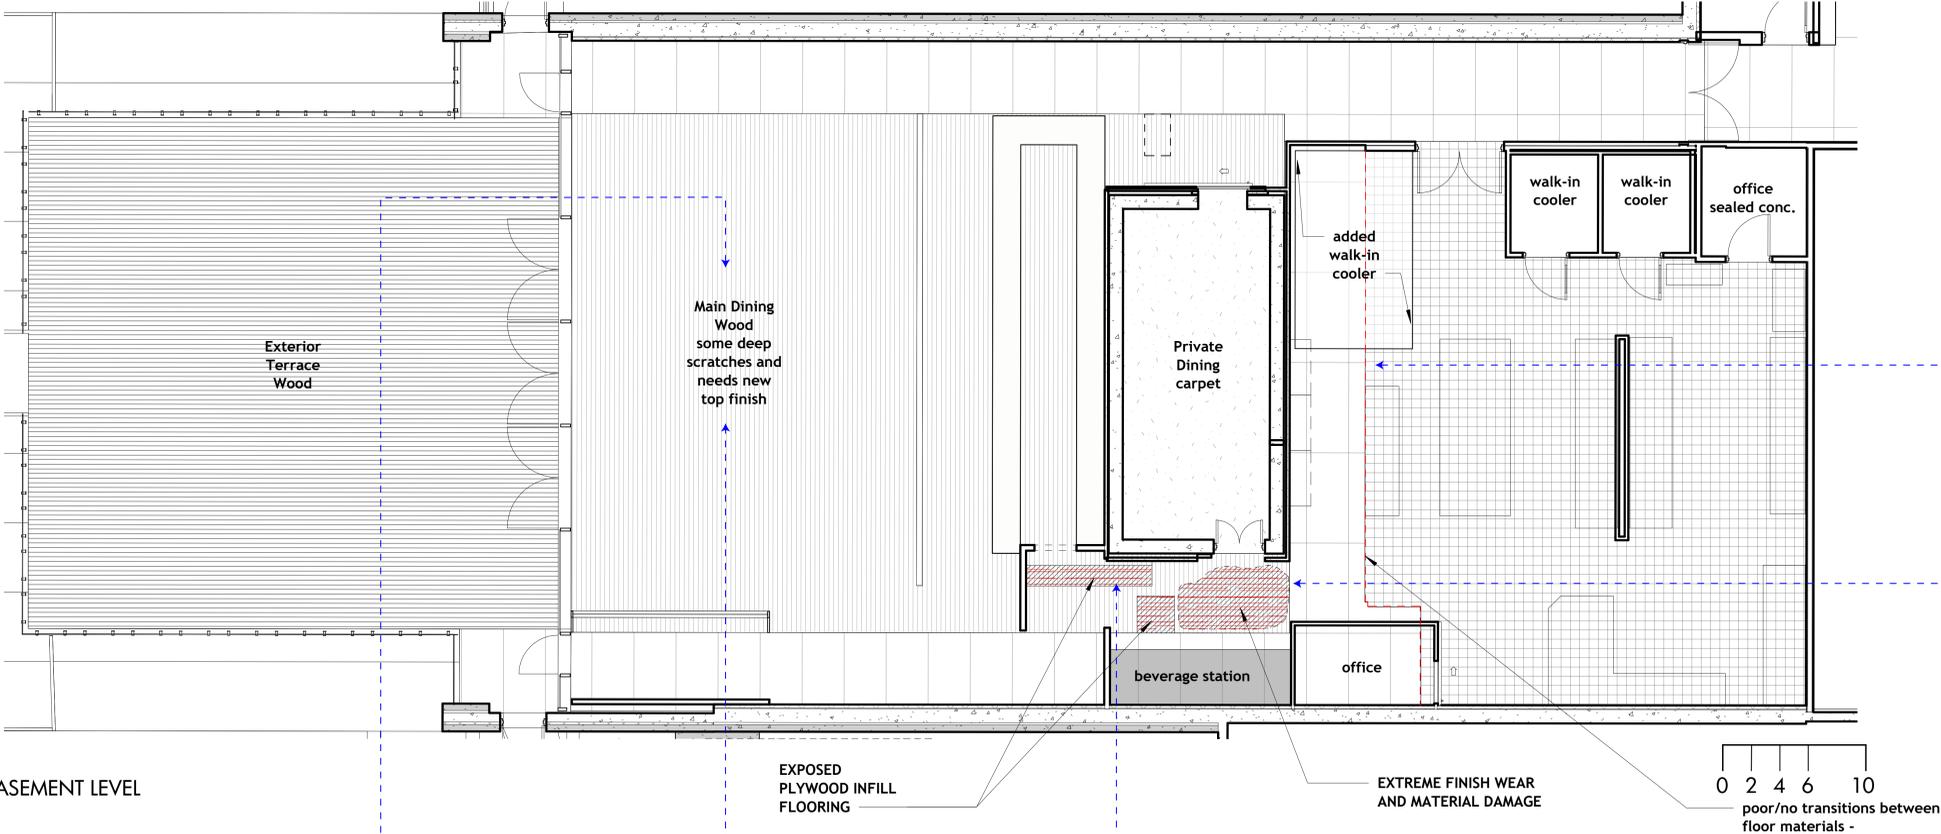

ARCHITECTURAL FINISHES & MATERIALS

FLOORING LOCATIONS


FINISH LEGEND		
STONE FLOORING		
FLOORING	X ST-2	STONE
	X ST-2E	STONE (EXTERIOR)
	X ST-3	STONE
	X ST-4	CONC PAVERS (EXTERIOR)
	X ST-5	STONE (EXTERIOR)
	X ST-5a	STONE (EXTERIOR)
TILE FLOORING		
X CT-1	CERAMIC TILE	
X QT-1	QUARRY TILE	
WOOD FLOORING		
X WDF-1	WOOD FLOOR	
X WDF-2	WOOD FLOOR	
X WDF-3	WOOD FLOOR	
X WDF-4	WOOD FLOOR	
X WDF-5	WOOD FLOOR	
CARPET		
X CPT-1A	CARPET 1	
X CPT-2	CARPET 2	
X CPT-3	CARPET 3	
X CPT-X	CARPET TYPE TBD	
X RF-1	RESILIENT FLOOR	
X SC-1	SEALED CONCRETE	

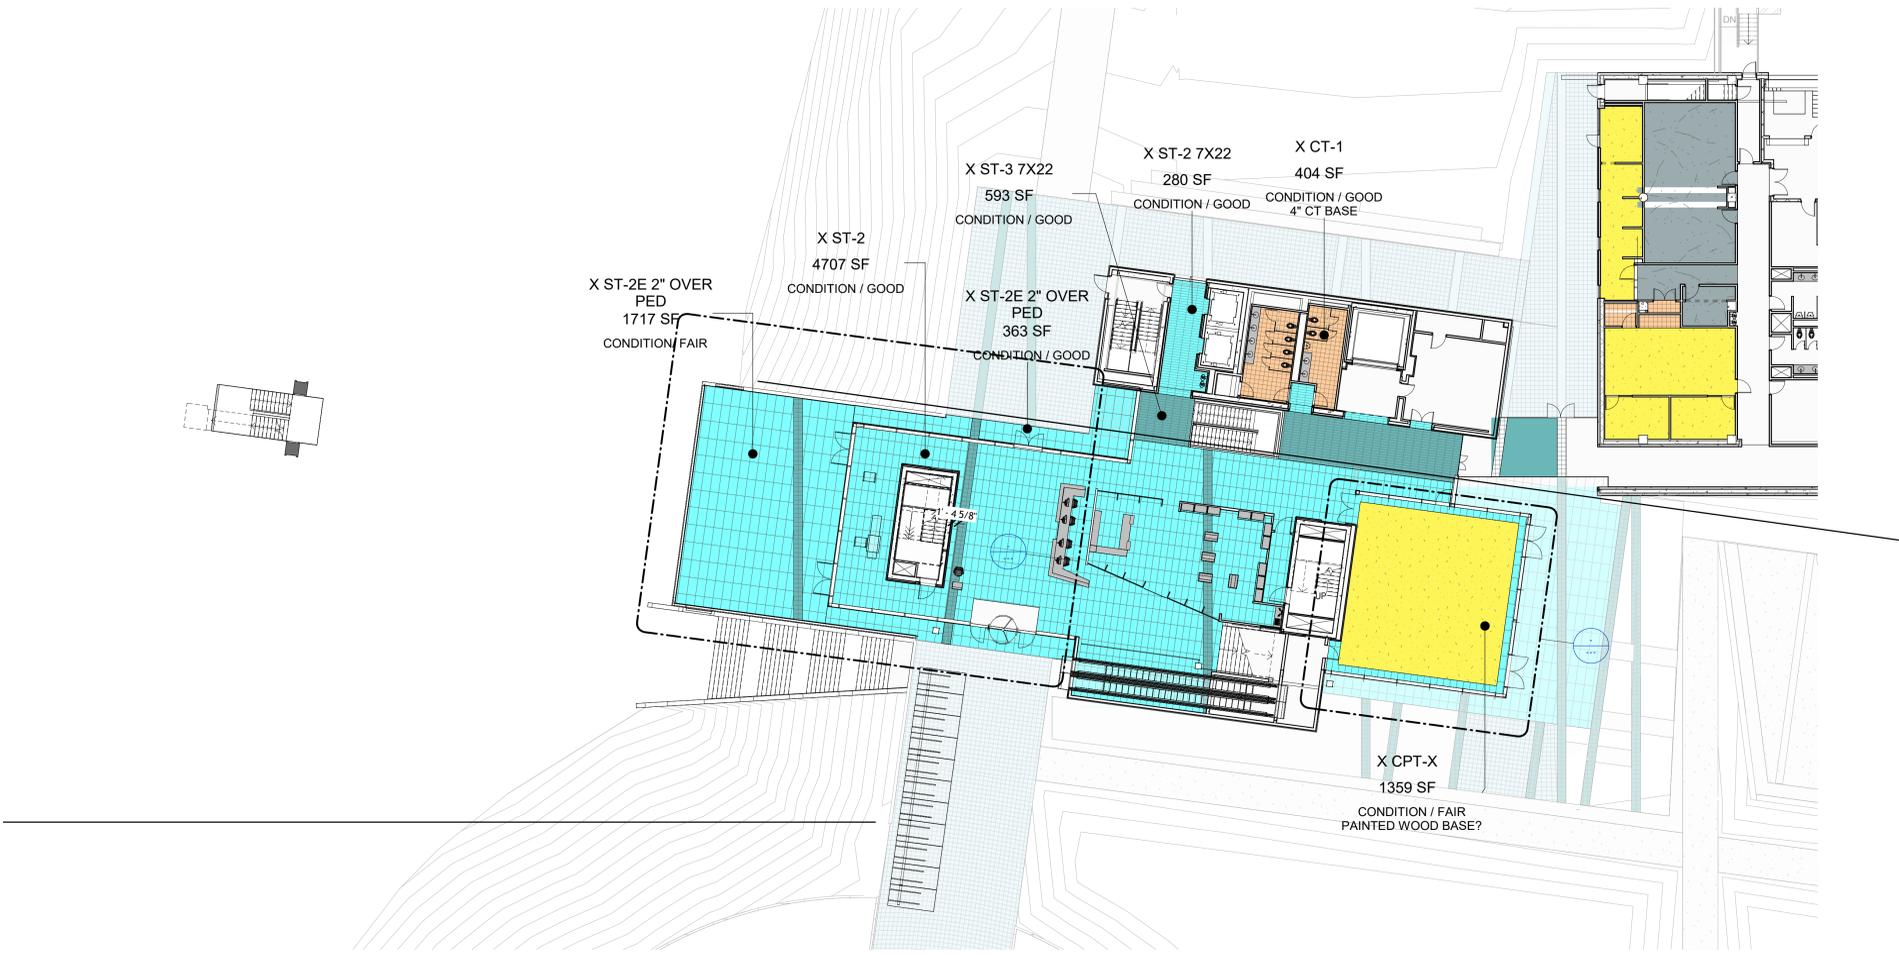

GROUND LEVEL


ARCHITECTURAL FINISHES & MATERIALS

FLOORING ASSESSMENT

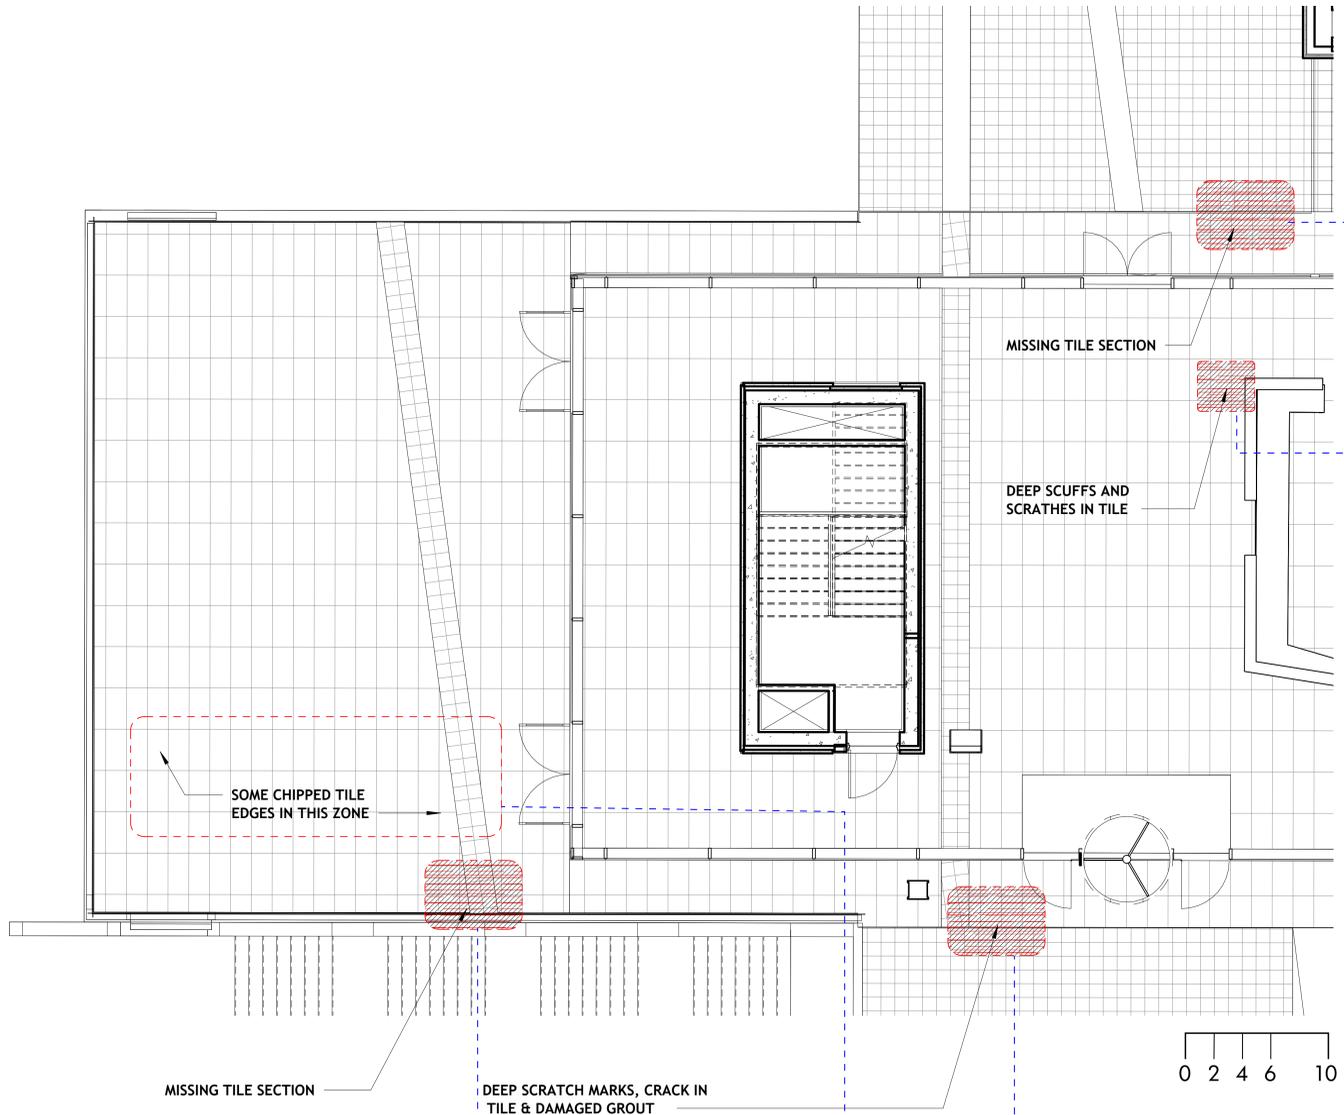

ARCHITECTURAL FINISHES & MATERIALS

FLOORING ASSESSMENT

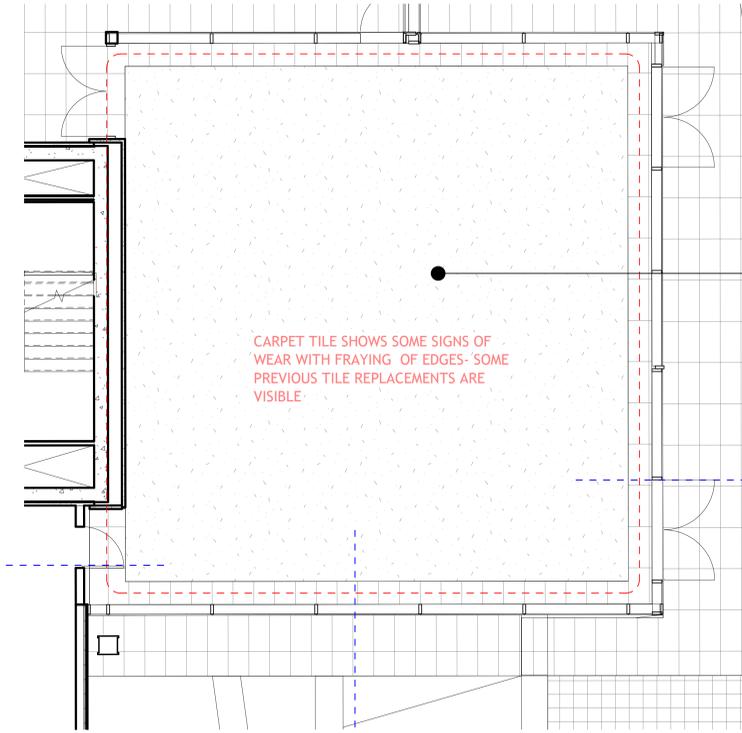

XINT CPT-X
1359 SF
CONDITION / FAIR
PAINTED WOOD BASE?

CARPET TILE SHOWS SOME SIGNS OF WEAR WITH FRAYING OF EDGES- SOME PREVIOUS TILE REPLACEMENTS ARE VISIBLE


GROUND LEVEL



ARCHITECTURAL FINISHES & MATERIALS

FLOORING LOCATIONS

FINISH LEGEND		
STONE FLOORING		
FLOORING	X ST-2	STONE
	X ST-2E	STONE (EXTERIOR)
	X ST-3	STONE
	X ST-4	CONC PAVERS (EXTERIOR)
	X ST-5	STONE (EXTERIOR)
	X ST-5a	STONE (EXTERIOR)
TILE FLOORING		
X CT-1	CERAMIC TILE	
X QT-1	QUARRY TILE	
WOOD FLOORING		
X WDF-1	WOOD FLOOR	
X WDF-2	WOOD FLOOR	
X WDF-3	WOOD FLOOR	
X WDF-4	WOOD FLOOR	
X WDF-5	WOOD FLOOR	
CARPET		
X CPT-1A	CARPET 1	
X CPT-2	CARPET 2	
X CPT-3	CARPET 3	
X CPT-X	CARPET TYPE TBD	
X RF-1	RESILIENT FLOOR	
X SC-1	SEALED CONCRETE	

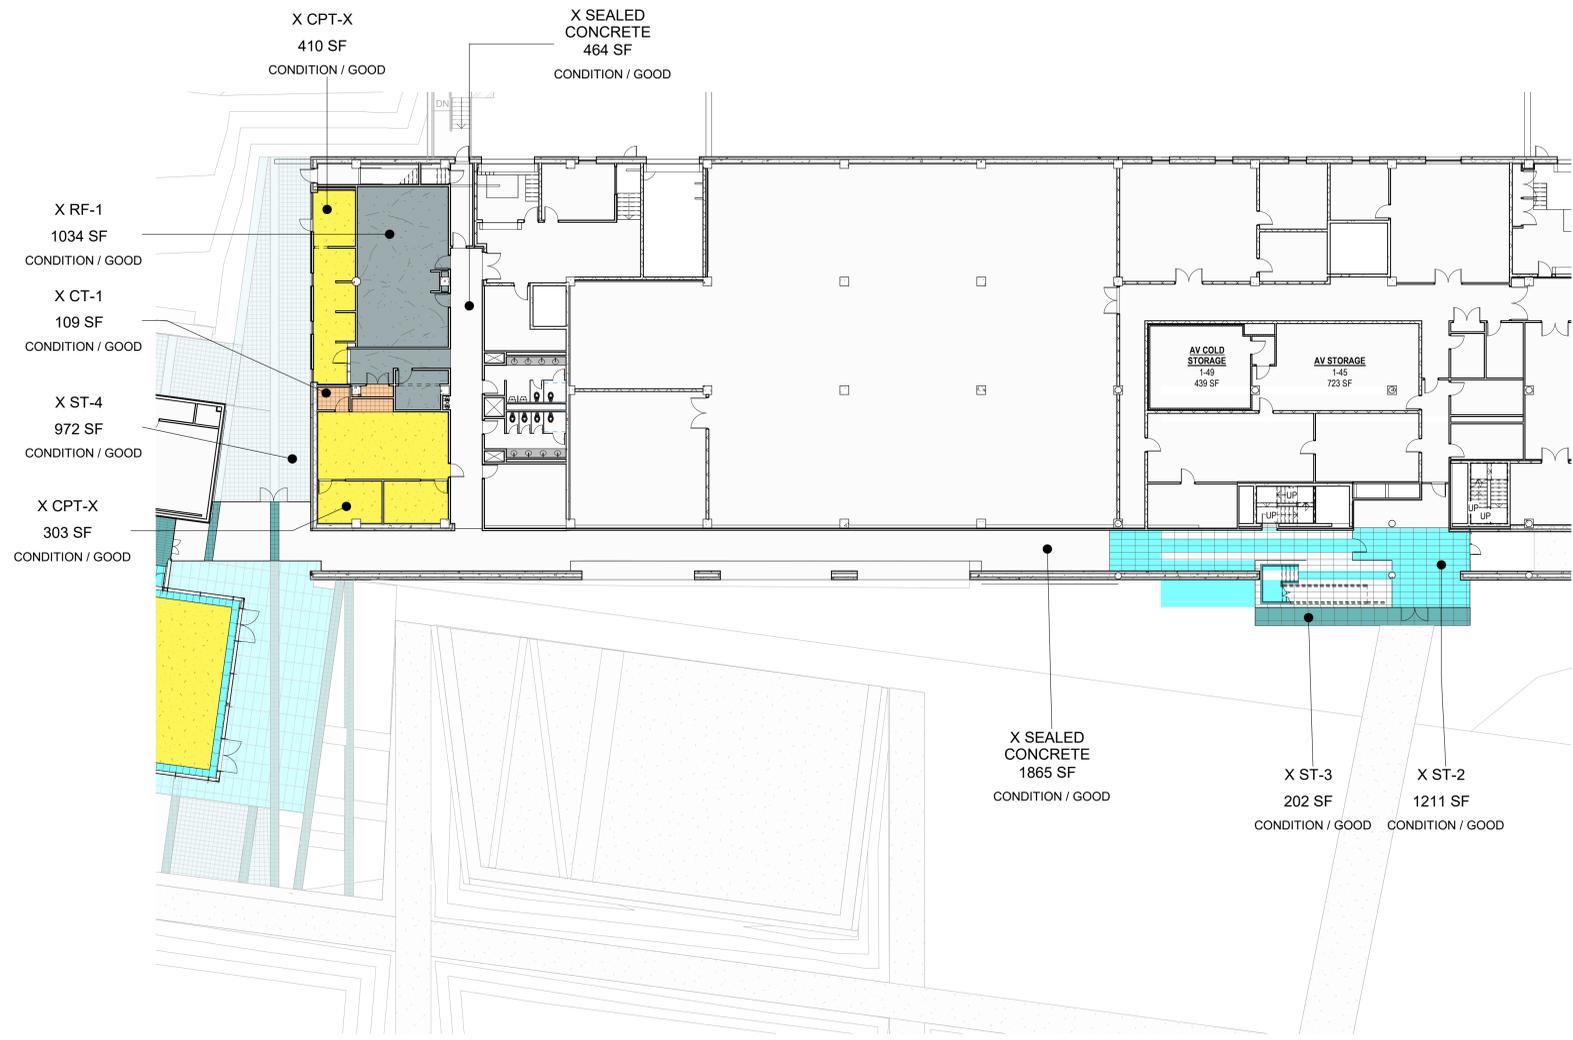


GROUND LEVEL

ARCHITECTURAL FINISHES & MATERIALS

FLOORING LOCATIONS


FINISH LEGEND		
STONE FLOORING		
FLOORING	X ST-2	STONE
	X ST-2E	STONE (EXTERIOR)
	X ST-3	STONE
	X ST-4	CONC PAVERS (EXTERIOR)
	X ST-5	STONE (EXTERIOR)
	X ST-5a	STONE (EXTERIOR)
TILE FLOORING		
X CT-1	CERAMIC TILE	
X QT-1	QUARRY TILE	
WOOD FLOORING		
X WDF-1	WOOD FLOOR	
X WDF-2	WOOD FLOOR	
X WDF-3	WOOD FLOOR	
X WDF-4	WOOD FLOOR	
X WDF-5	WOOD FLOOR	
CARPET		
X CPT-1A	CARPET 1	
X CPT-2	CARPET 2	
X CPT-3	CARPET 3	
X CPT-X	CARPET TYPE TBD	
X RF-1	RESILIENT FLOOR	
X SC-1	SEALED CONCRETE	

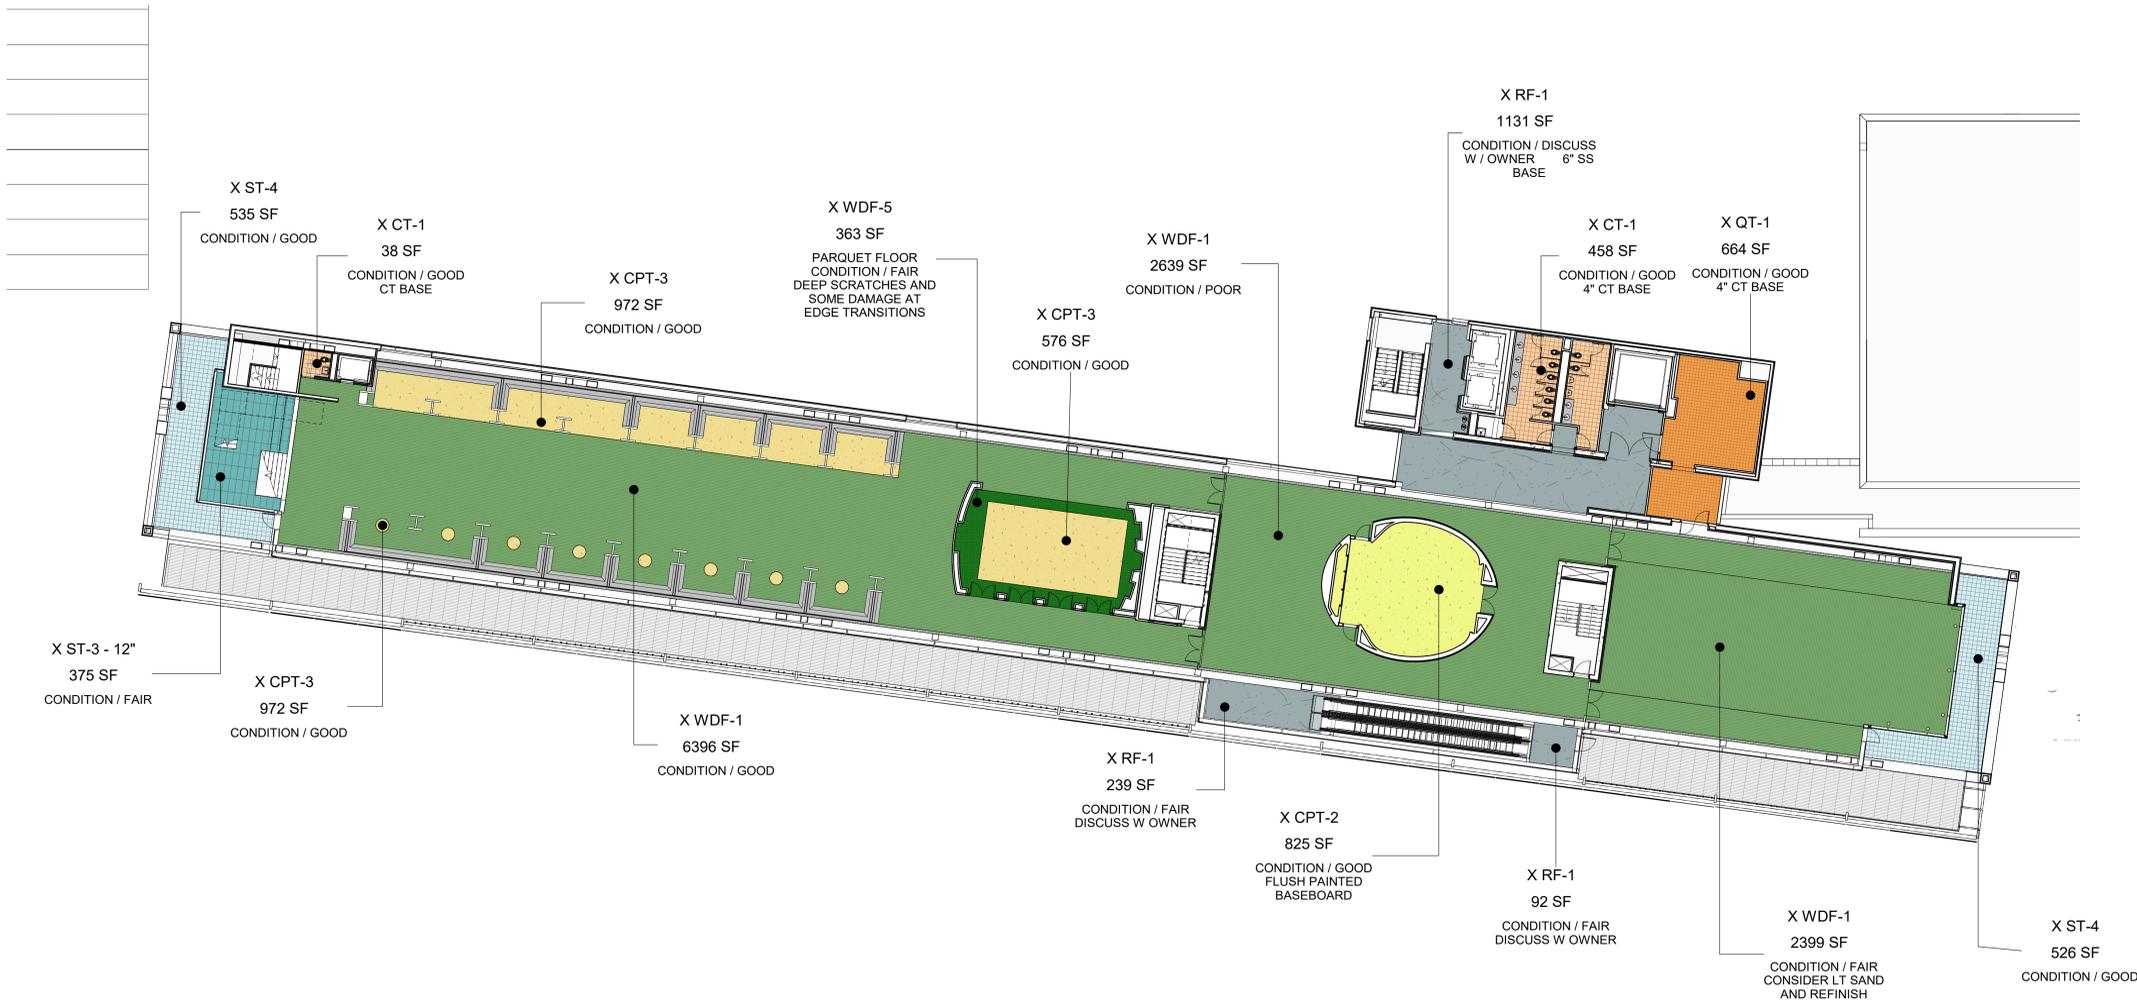



LOWER MUSEUM LEVEL

ARCHITECTURAL FINISHES & MATERIALS

FLOORING ASSESSMENT

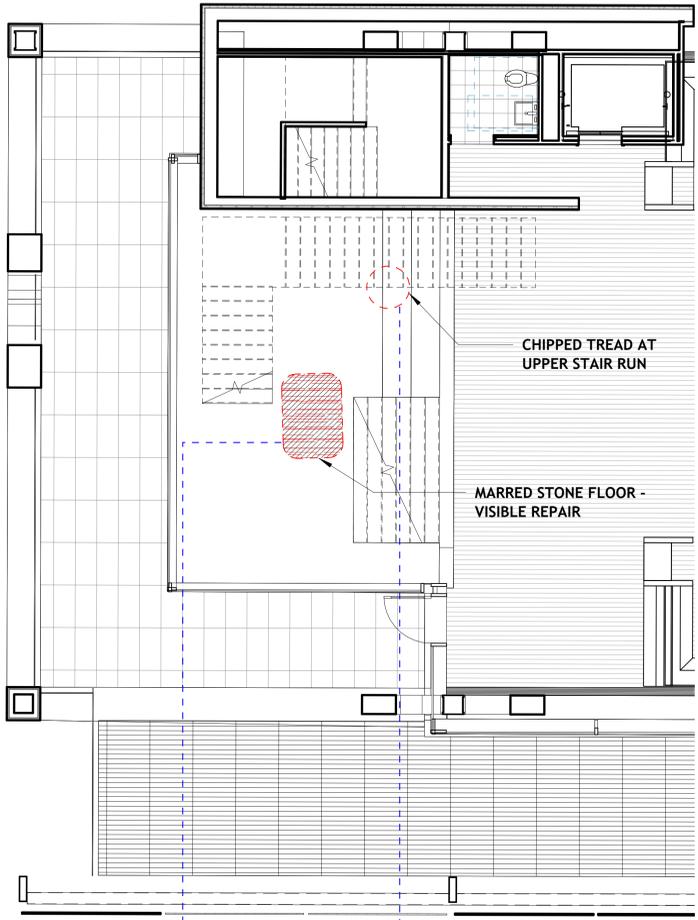


LOWER MUSEUM LEVEL

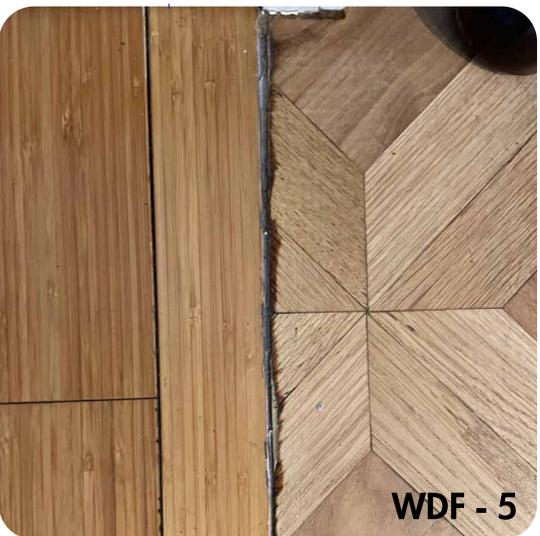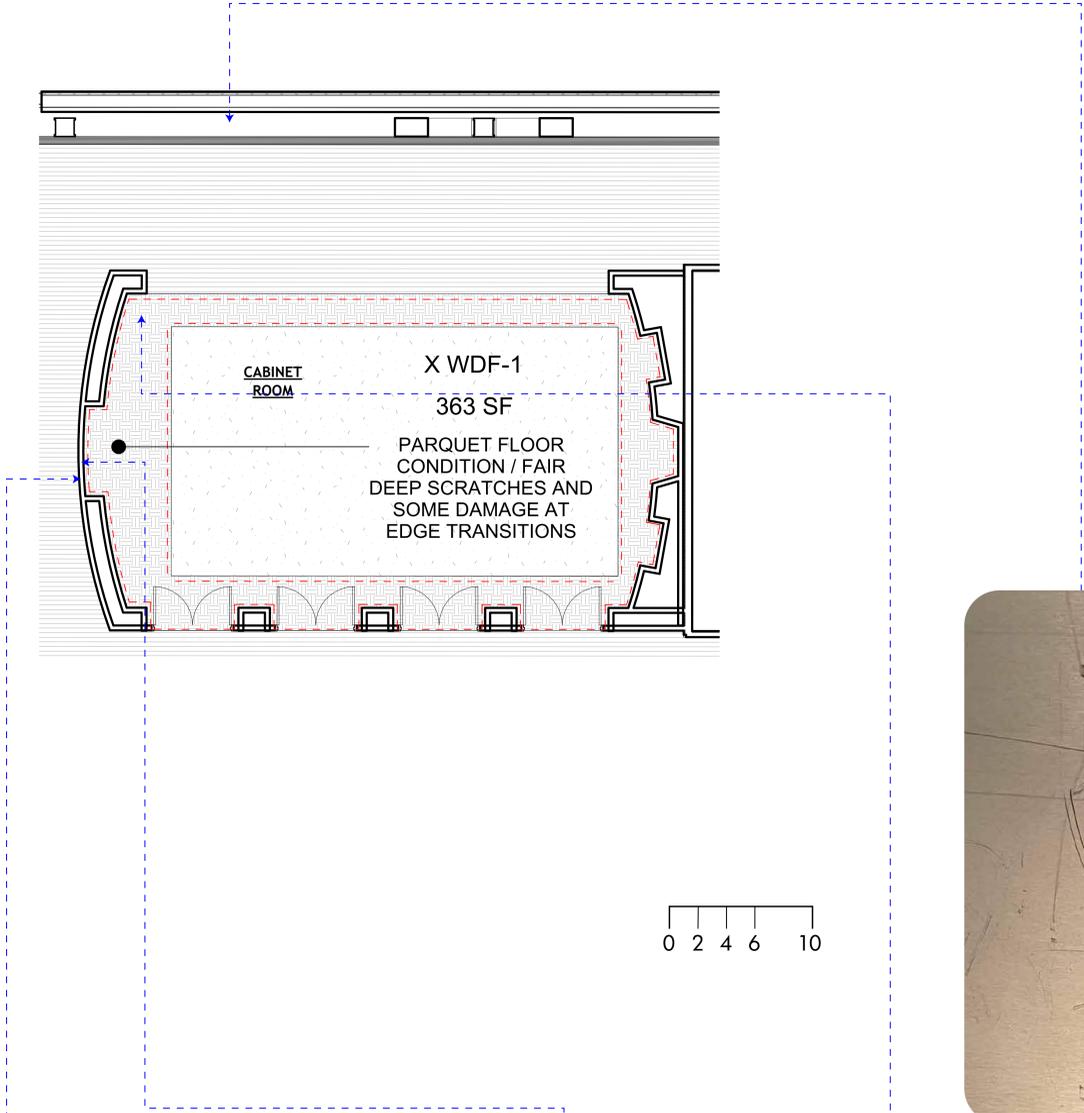

ARCHITECTURAL FINISHES & MATERIALS


FLOORING ASSESSMENT

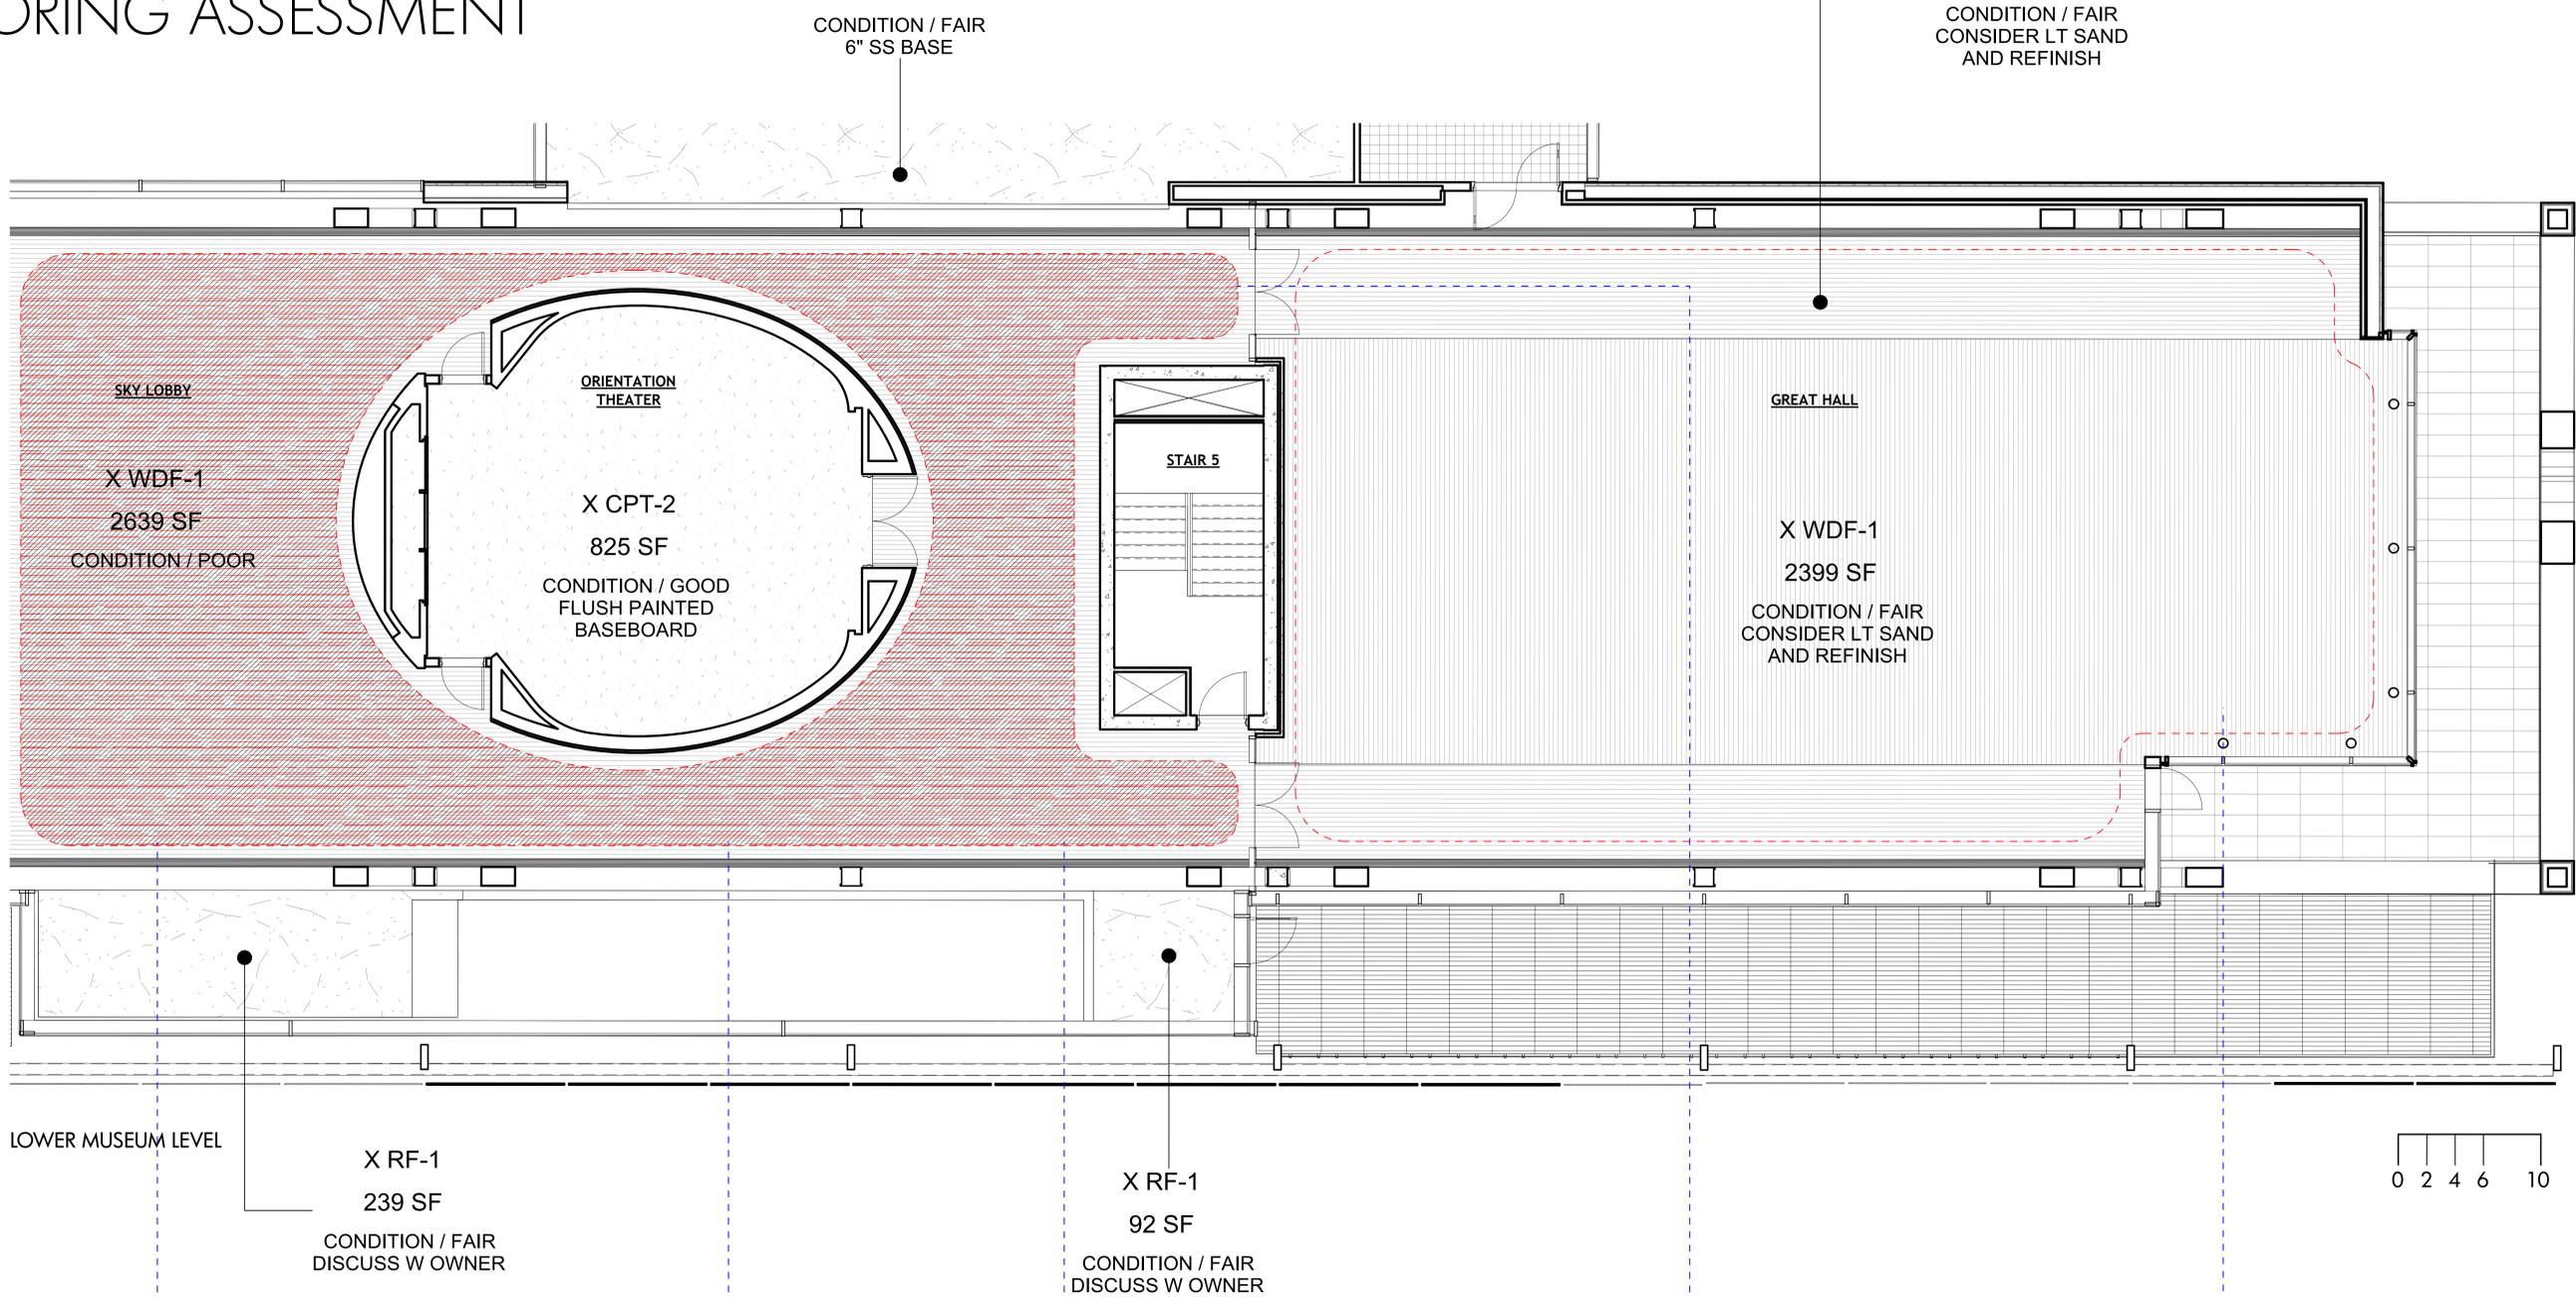

ARCHITECTURAL FINISHES & MATERIALS

FLOORING LOCATIONS


FINISH LEGEND		
STONE FLOORING		
FLOORING	X ST-2	STONE
	X ST-2E	STONE (EXTERIOR)
	X ST-3	STONE
	X ST-4	CONC PAVERS (EXTERIOR)
	X ST-5	STONE (EXTERIOR)
	X ST-5a	STONE (EXTERIOR)
TILE FLOORING		
X CT-1	CERAMIC TILE	
X QT-1	QUARRY TILE	
WOOD FLOORING		
X WDF-1	WOOD FLOOR	
X WDF-2	WOOD FLOOR	
X WDF-3	WOOD FLOOR	
X WDF-4	WOOD FLOOR	
X WDF-5	WOOD FLOOR	
CARPET		
X CPT-1A	CARPET 1	
X CPT-2	CARPET 2	
X CPT-3	CARPET 3	
X CPT-X	CARPET TYPE TBD	
X RF-1	RESILIENT FLOOR	
X SC-1	SEALED CONCRETE	

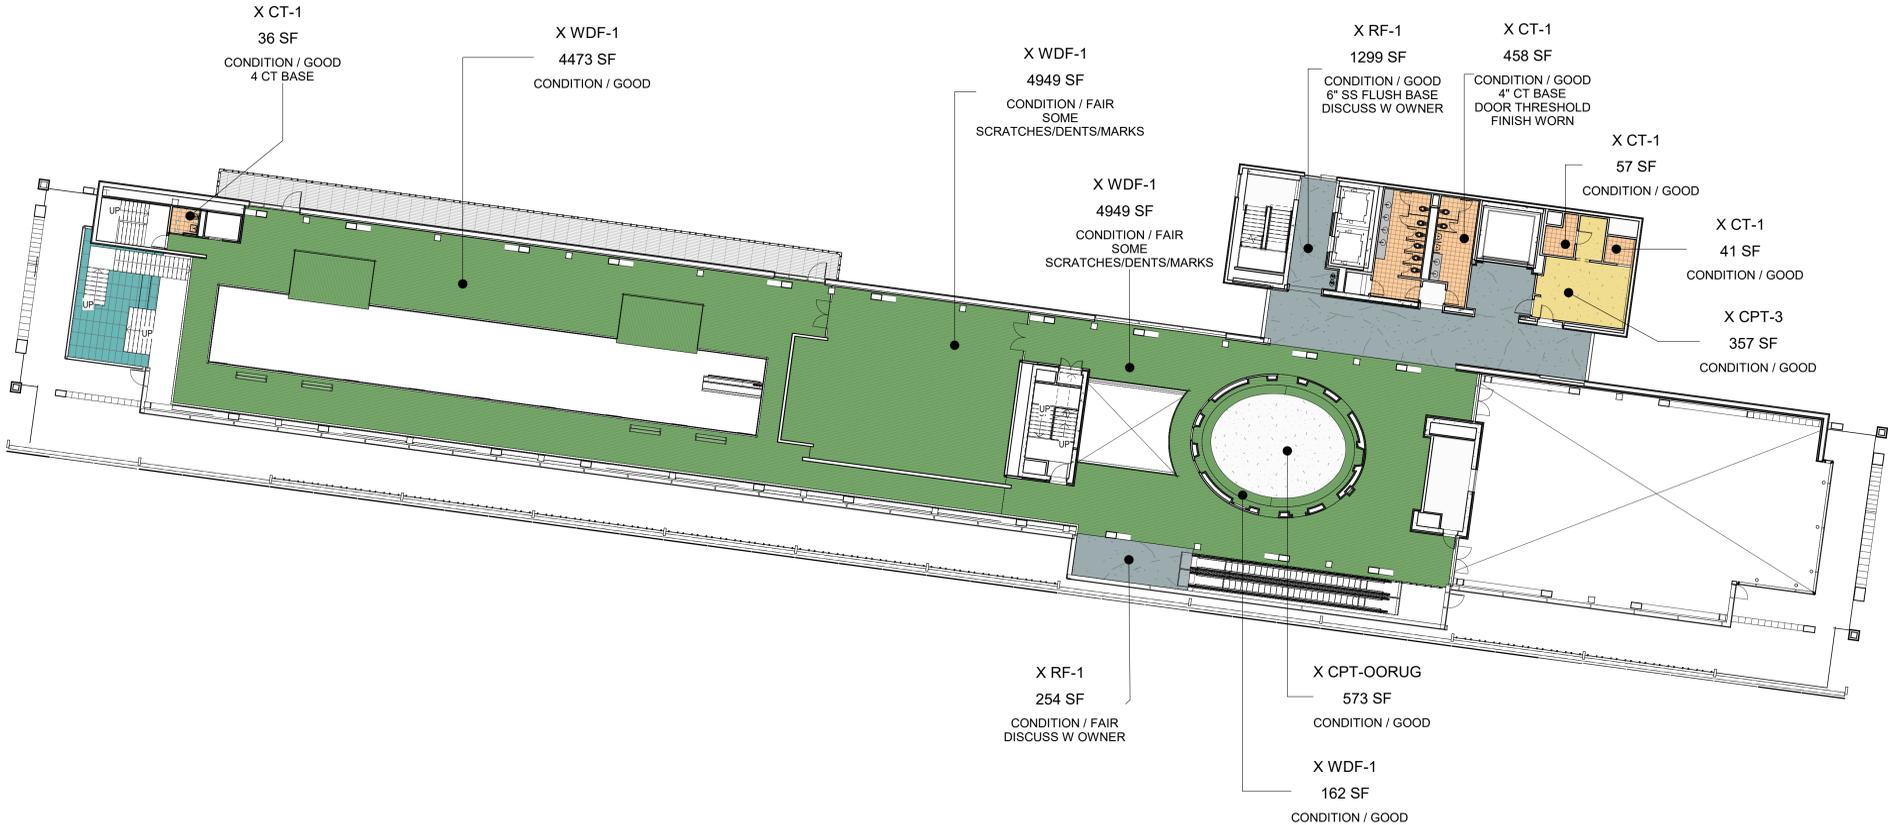


UPPER MUSEUM LEVEL

ARCHITECTURAL FINISHES & MATERIALS

FLOORING ASSESSMENT

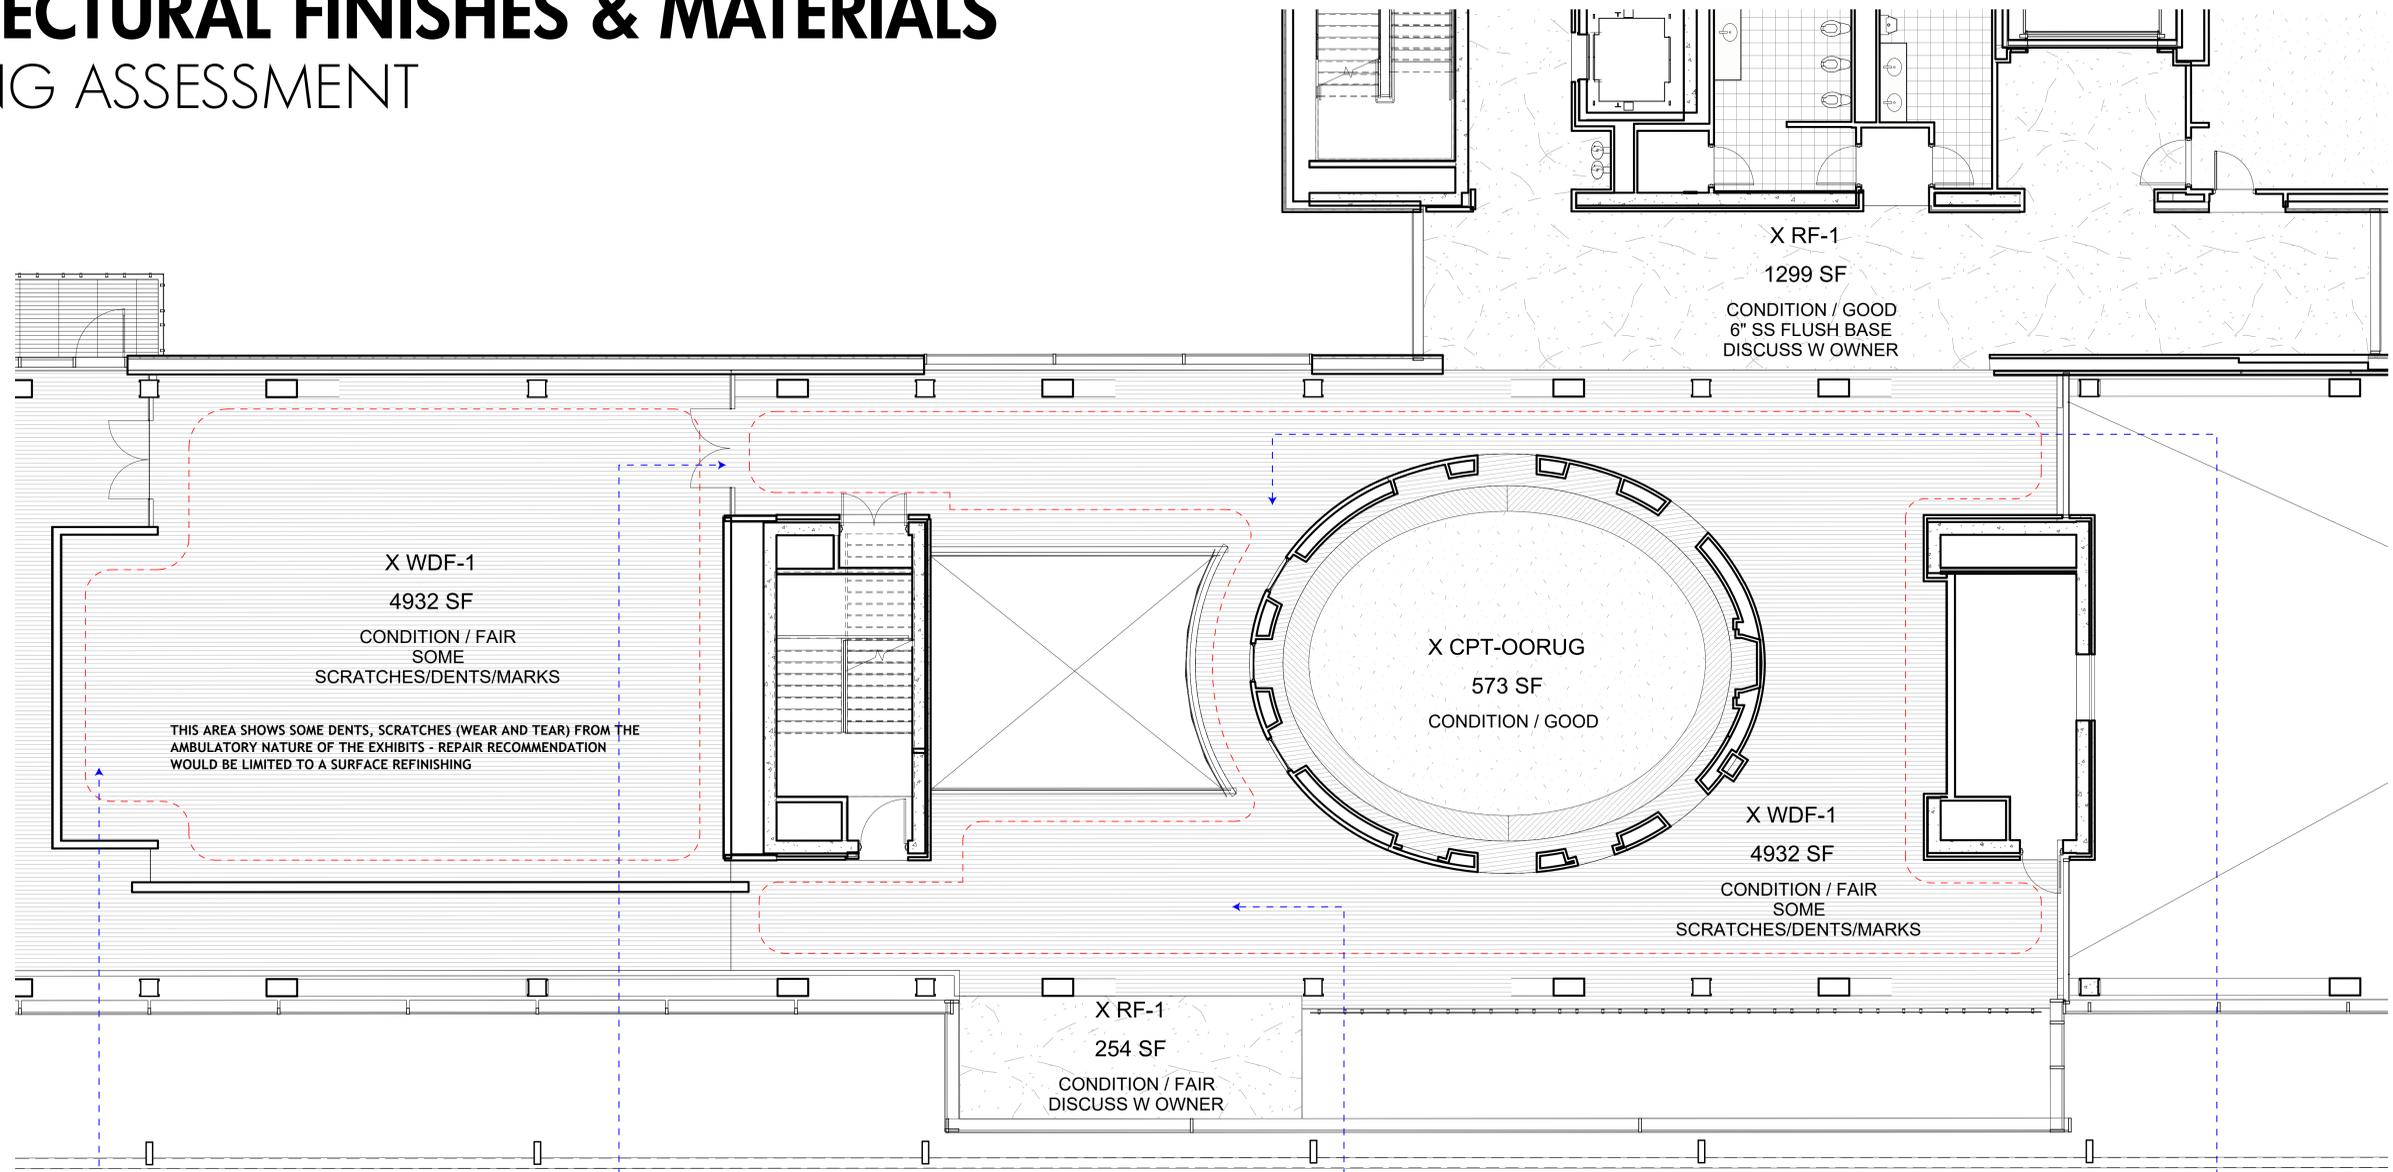


UPPER MUSEUM LEVEL

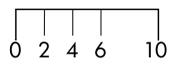

ARCHITECTURAL FINISHES & MATERIALS

FLOORING LOCATIONS

FINISH LEGEND		
STONE FLOORING		
FLOORING	X ST-2	STONE
	X ST-2E	STONE (EXTERIOR)
	X ST-3	STONE
	X ST-4	CONC PAVERS (EXTERIOR)
	X ST-5	STONE (EXTERIOR)
	X ST-5a	STONE (EXTERIOR)
TILE FLOORING		
X CT-1	CERAMIC TILE	
X QT-1	QUARRY TILE	
WOOD FLOORING		
X WDF-1	WOOD FLOOR	
X WDF-2	WOOD FLOOR	
X WDF-3	WOOD FLOOR	
X WDF-4	WOOD FLOOR	
X WDF-5	WOOD FLOOR	
CARPET		
X CPT-1A	CARPET 1	
X CPT-2	CARPET 2	
X CPT-3	CARPET 3	
X CPT-X	CARPET TYPE TBD	
X RF-1	RESILIENT FLOOR	
X SC-1	SEALED CONCRETE	


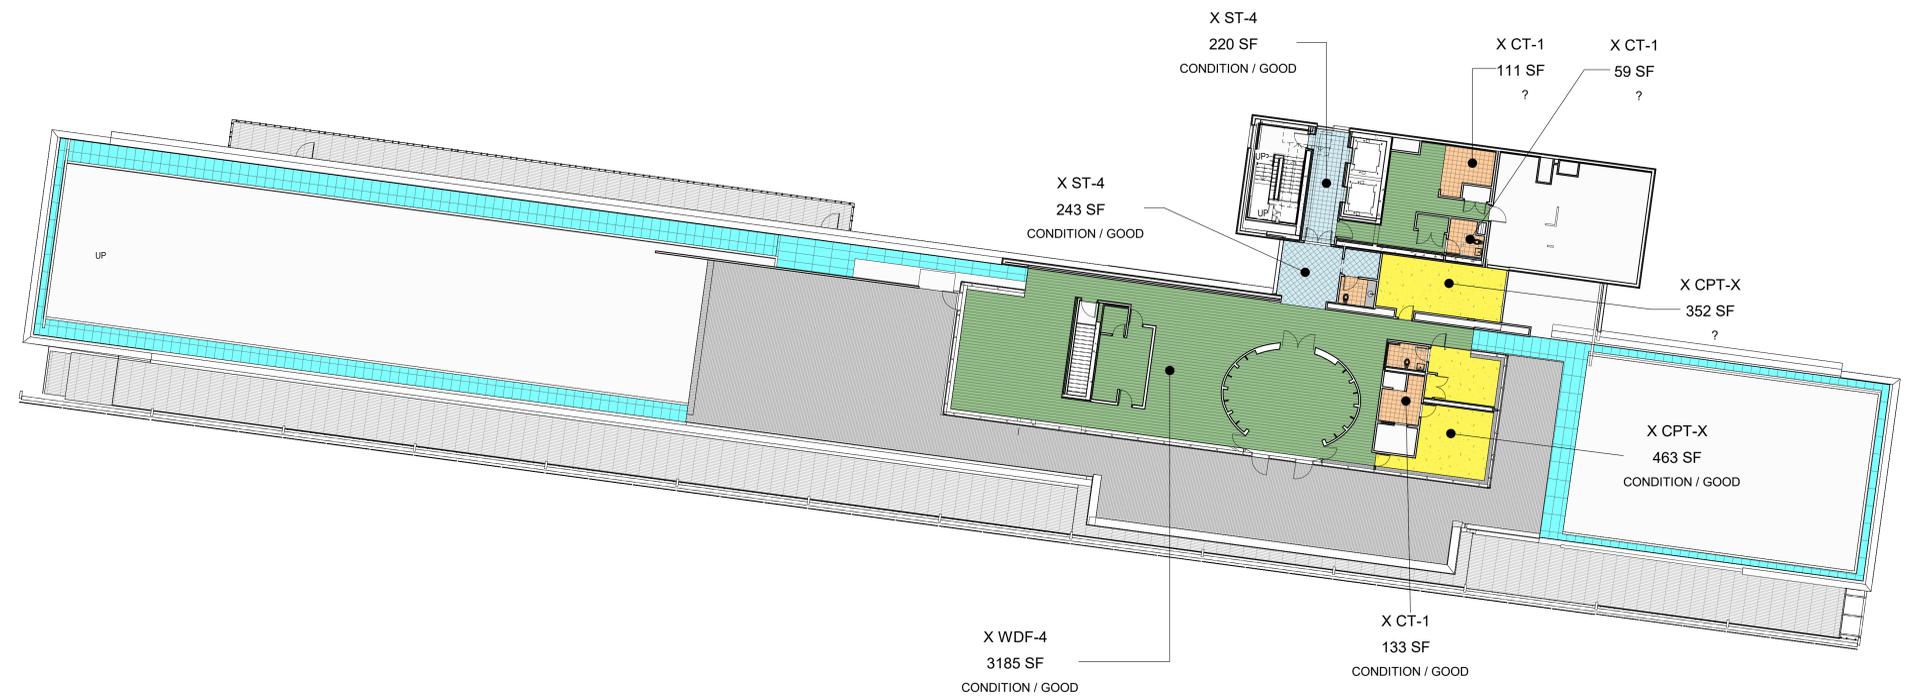


EXECUTIVE LEVEL

ARCHITECTURAL FINISHES & MATERIALS

CEILING

EXTERIOR CEMENT PLASTER

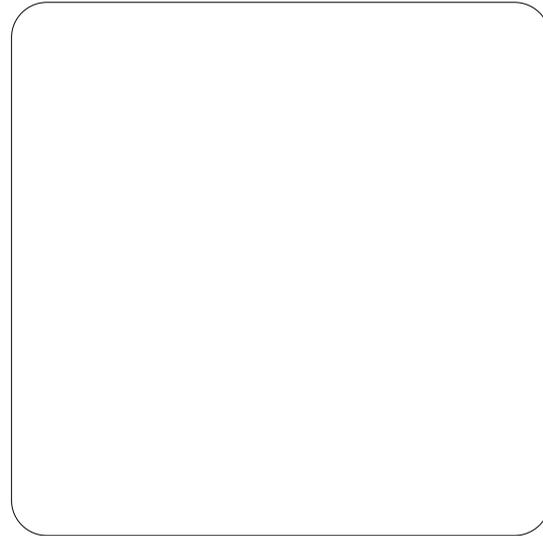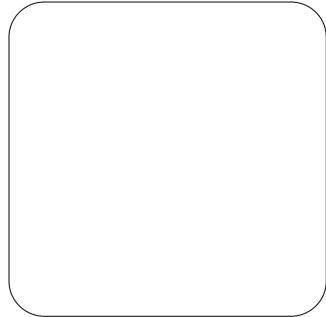

DESCRIPTION
Exterior Cement Plaster

LOCATIONS
-(Exterior) North of Cafe

CONDITION
-Good

GWB



DESCRIPTION
Gypsum Wall Board with paint
(Premium where noted)

LOCATIONS
-Cafe Corridor, Cafe perimeter, Cafe Kitchen (band)
-Elevator Lobby in Basement, Ground Level,
-Women, Men, Lavatory Vestibule in Basement, Ground Level,
-Coat Room
-NARA Corridor
-Cabinet Room

CONDITION
-Fair
-Consider re-paint

PLASTER FINISH



DESCRIPTION
Plaster Finish

LOCATIONS
-Oval Office

CONDITION
Good

ARCHITECTURAL FINISHES & MATERIALS

CEILING

ACP - 1




Aluminum Ceiling Panel (perforated)

- Ground Level Security
- Ground Level Main Lobby
- Lobby Event Space (Ground Level)

- Good
- Some panels not flush

ACP - 2

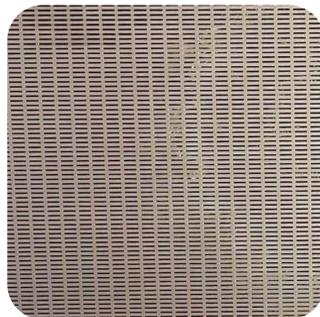

Perforated Aluminum Ceiling Panel

- NARA Permanent Exhibits
- Sky Lobby at Lower Museum Level
- Lower Museum Level Lavatory (3-08)

- Good
- Some signs of water

ACP - 2A



Aluminum Ceiling Panel

- Cafe Interior
- NARA Permanent Exhibits, North of Cabinet Room in Lower Museum level

Good

ARCHITECTURAL FINISHES & MATERIALS

CEILING

ACP - 2B



DESCRIPTION

Perforated Aluminum Ceiling Panel

LOCATIONS

- B-01 Basement Lobby

CONDITION

- Good
- Some signs of water

ACP - 2C





Aluminum Ceiling Panel

- B-01 Basement Lobby (Perimeter of stairs)
- Escalator Landing

- Good

ACP - 2D

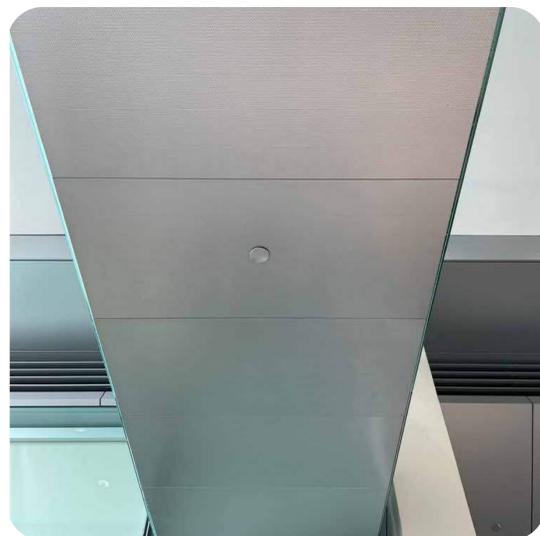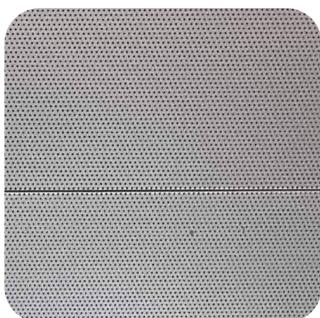

Perforated Aluminum Ceiling Panel



- 1-01 Main Lobby & Gift Shop
- B-01 Basement Lobby
- Bridge at Core Lobby in Ground Level

Good

ARCHITECTURAL FINISHES & MATERIALS

CEILING

ACT - WD

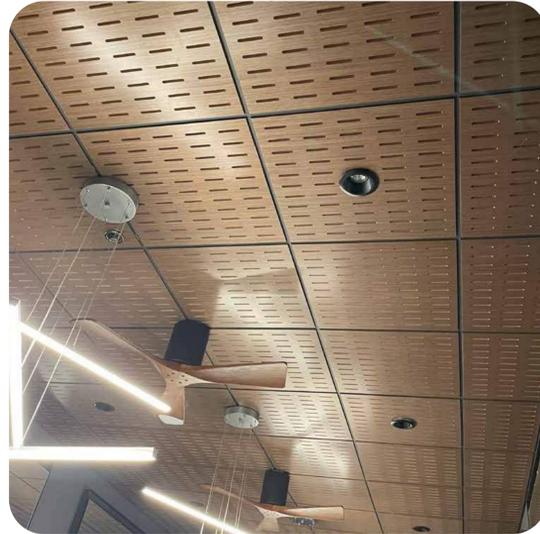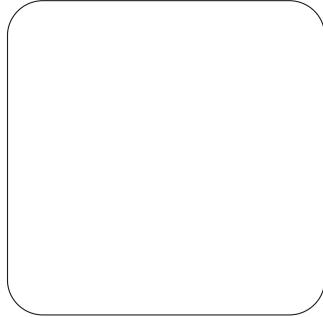

DESCRIPTION

2x2 Perforated Wood Acoustical Ceiling Panel


LOCATIONS

- Cafe Private Dining Room

CONDITION

- Good

ACT - 1

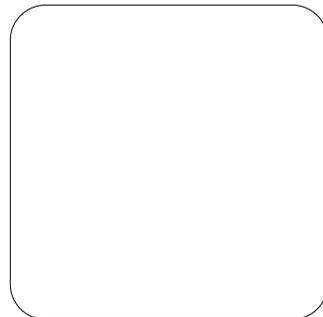

2x2 Acoustical Ceiling Tile (Wet Space)

- Cafe Kitchen

- Poor

ACT - 2



2x2 Acoustical Ceiling Tile



- Freight Elev. Vestibule (Basement & Ground Level)
- NARA Classrooms,
- NARA Offices, Volunteer Lounge, Coordination Room

Good

ARCHITECTURAL FINISHES & MATERIALS

CEILING

SS-1

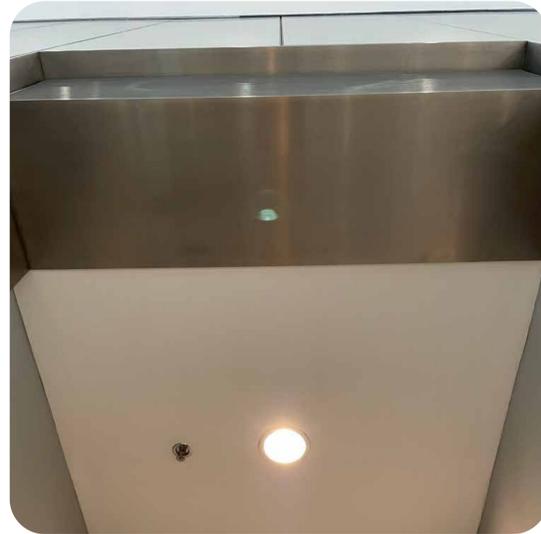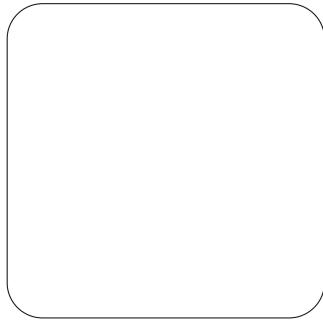

DESCRIPTION

Stainless Steel Finish
(Plate where noted)


LOCATIONS

- Basement and Ground Level Elevator Lobby
- Basement and Ground Level Lavatory Vestibule threshold
- South entry to Orientation Theater

CONDITION

- Good

ACM - 1

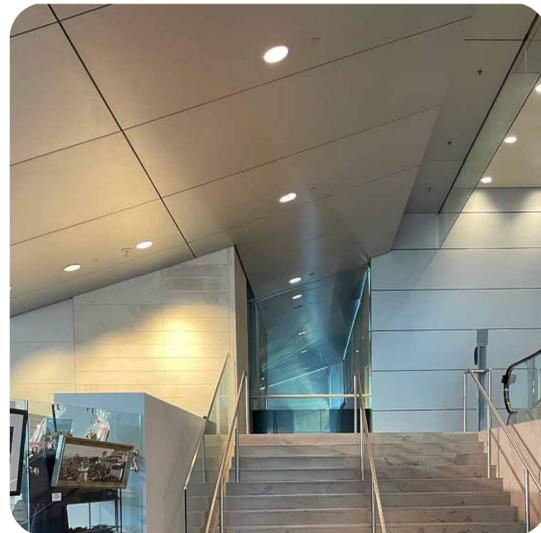

Stainless Steel Finish
(Plate where noted)


- Basement and Ground Level Elevator Lobby
- Basement and Ground Level Lavatory Vestibule threshold
- South entry to Orientation Theater

- Good

ARCHITECTURAL FINISHES & MATERIALS

CEILING LOCATIONS


FINISH LEGEND		
CEILING	X ECP	EXTERIOR CEMENT PLASTER
	X GWB	GYPSUM WALL BOARD (GWB-P AS NOTED)
	X PLSTR	PLASTER FINISH
	ACP - 1	ALUMINUM COMPOSITE PANEL
	ACP - 2	ACP - 2
	ACP - 2A	ACP - 2A
	ACP - 2B	ACP - 2B
	ACP - 2C	ACP - 2C
	ACP - 2D	ACP - 2 D
	ACP - 4	ACP - 4
ACM - 1	ACM 1 WALL SYSTEM C	
ACT - WD	ACT WD PRF	
ACT - 1	ACT - 1	
ACT - 2	ACT - 2	
SS - 1	STAINLESS STEEL FINISH	

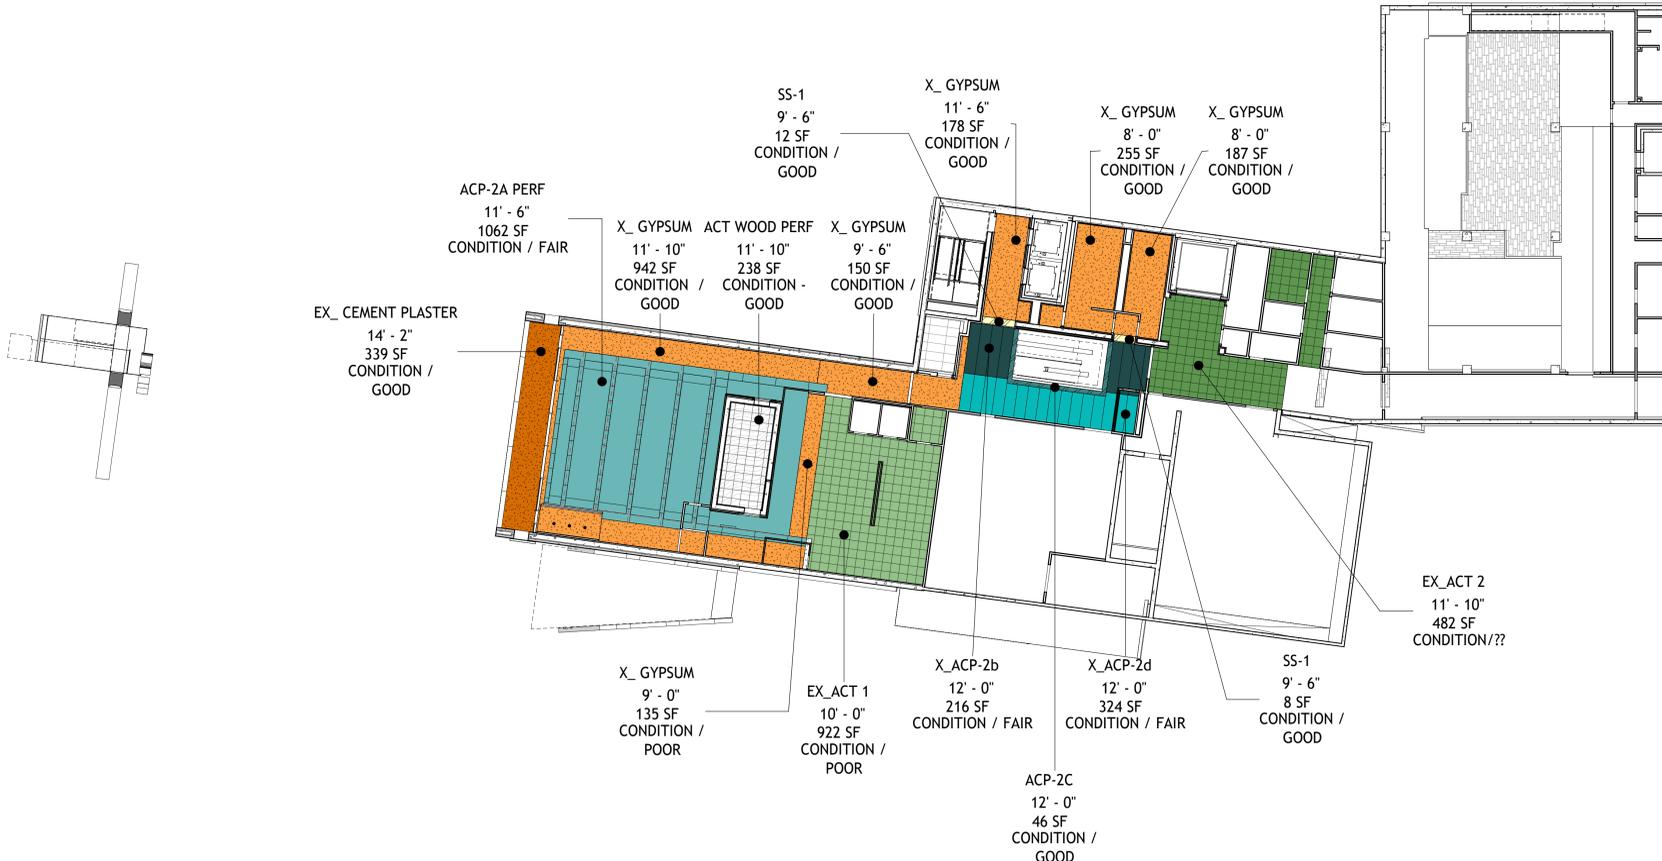

BASEMENT LEVEL

ARCHITECTURAL FINISHES & MATERIALS


CEILING ASSESSMENT

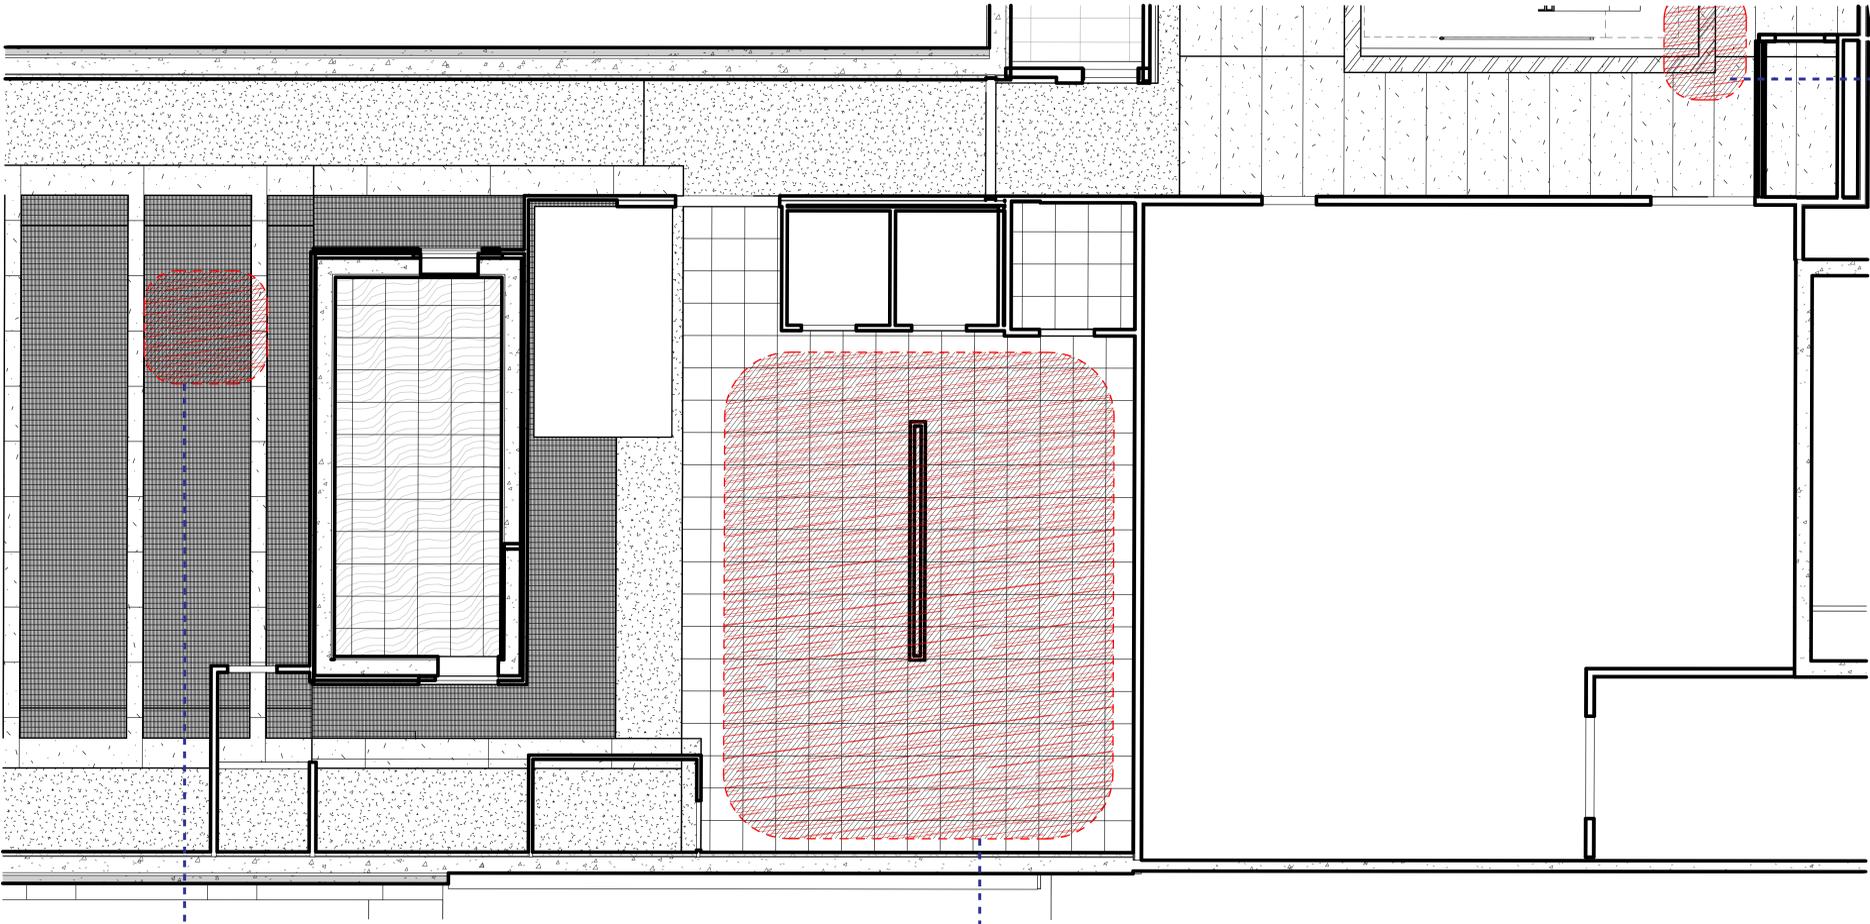

ARCHITECTURAL FINISHES & MATERIALS

CEILING LOCATIONS




FINISH LEGEND		
CEILING	X ECP	EXTERIOR CEMENT PLASTER
	X GWB	GYPSUM WALL BOARD (GWB-P AS NOTED)
	X PLSTR	PLASTER FINISH
ACP - 1	ALUMINUM COMPOSITE PANEL	
ACP - 2	ACP - 2	
ACP - 2A	ACP - 2A	
ACP - 2B	ACP - 2B	
ACP - 2C	ACP - 2C	
ACP - 2D	ACP - 2 D	
ACP - 4	ACP - 4	
ACM - 1	ACM 1 WALL SYSTEM C	
ACT - WD	ACT WD PRF	
ACT - 1	ACT - 1	
ACT - 2	ACT - 2	
SS - 1	STAINLESS STEEL FINISH	

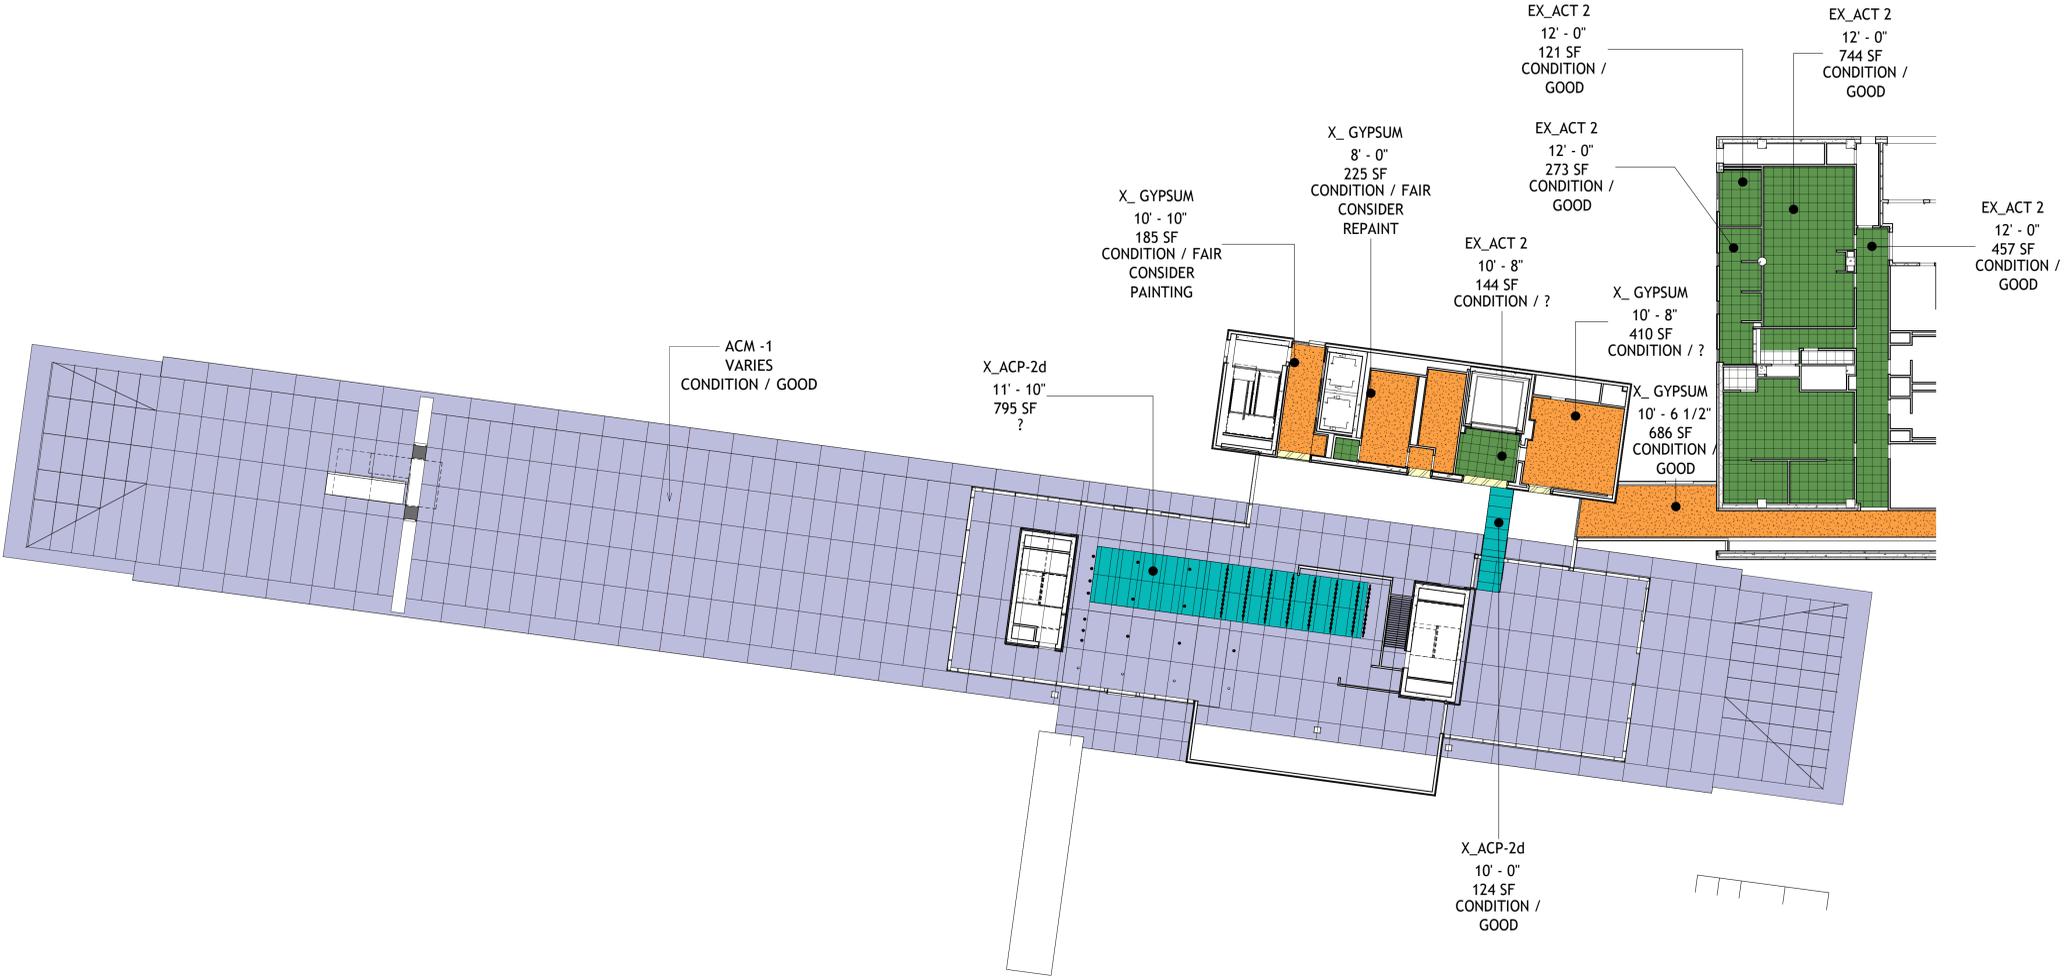

GROUND LEVEL


ARCHITECTURAL FINISHES & MATERIALS

CEILING ASSESSMENT

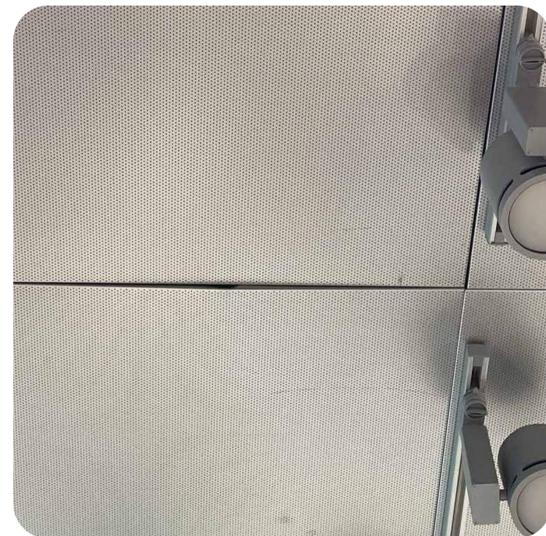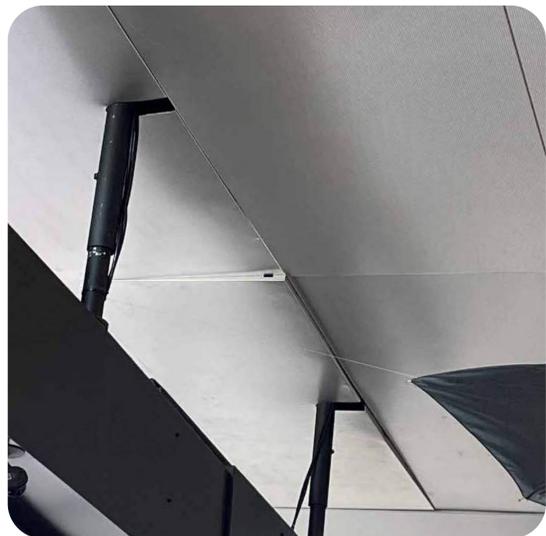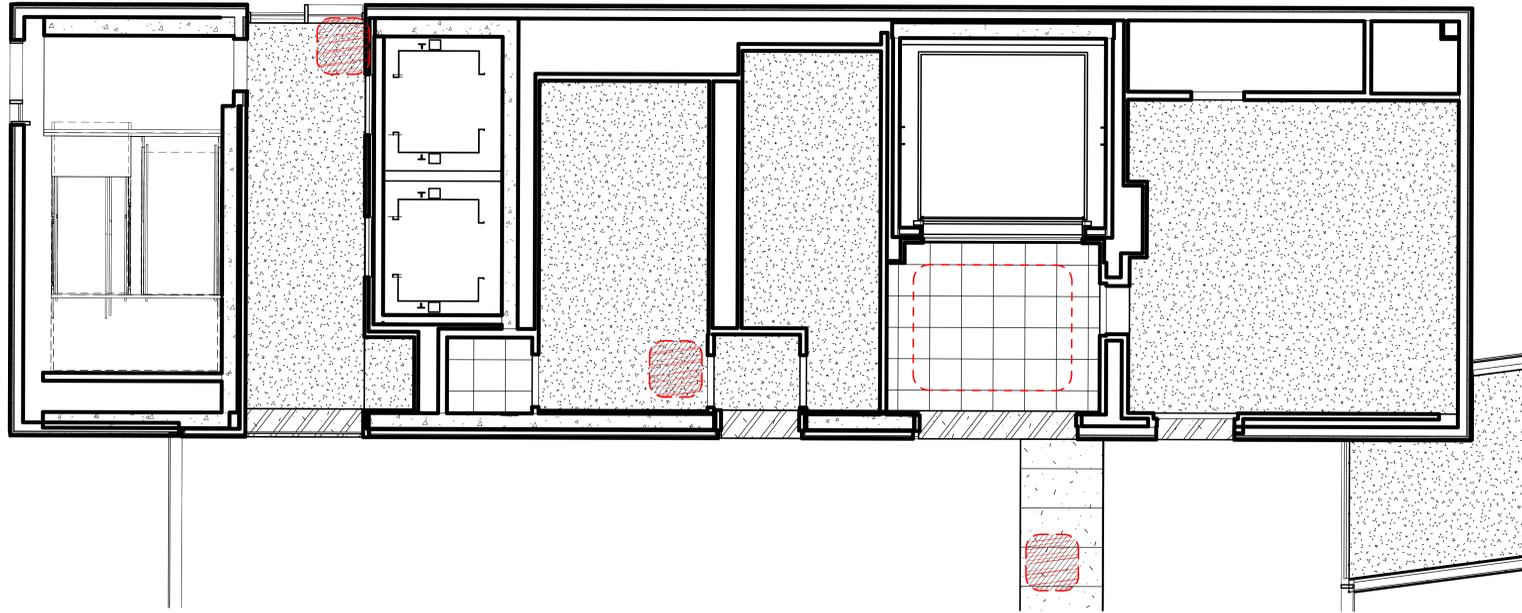

ARCHITECTURAL FINISHES & MATERIALS


CEILING ASSESSMENT

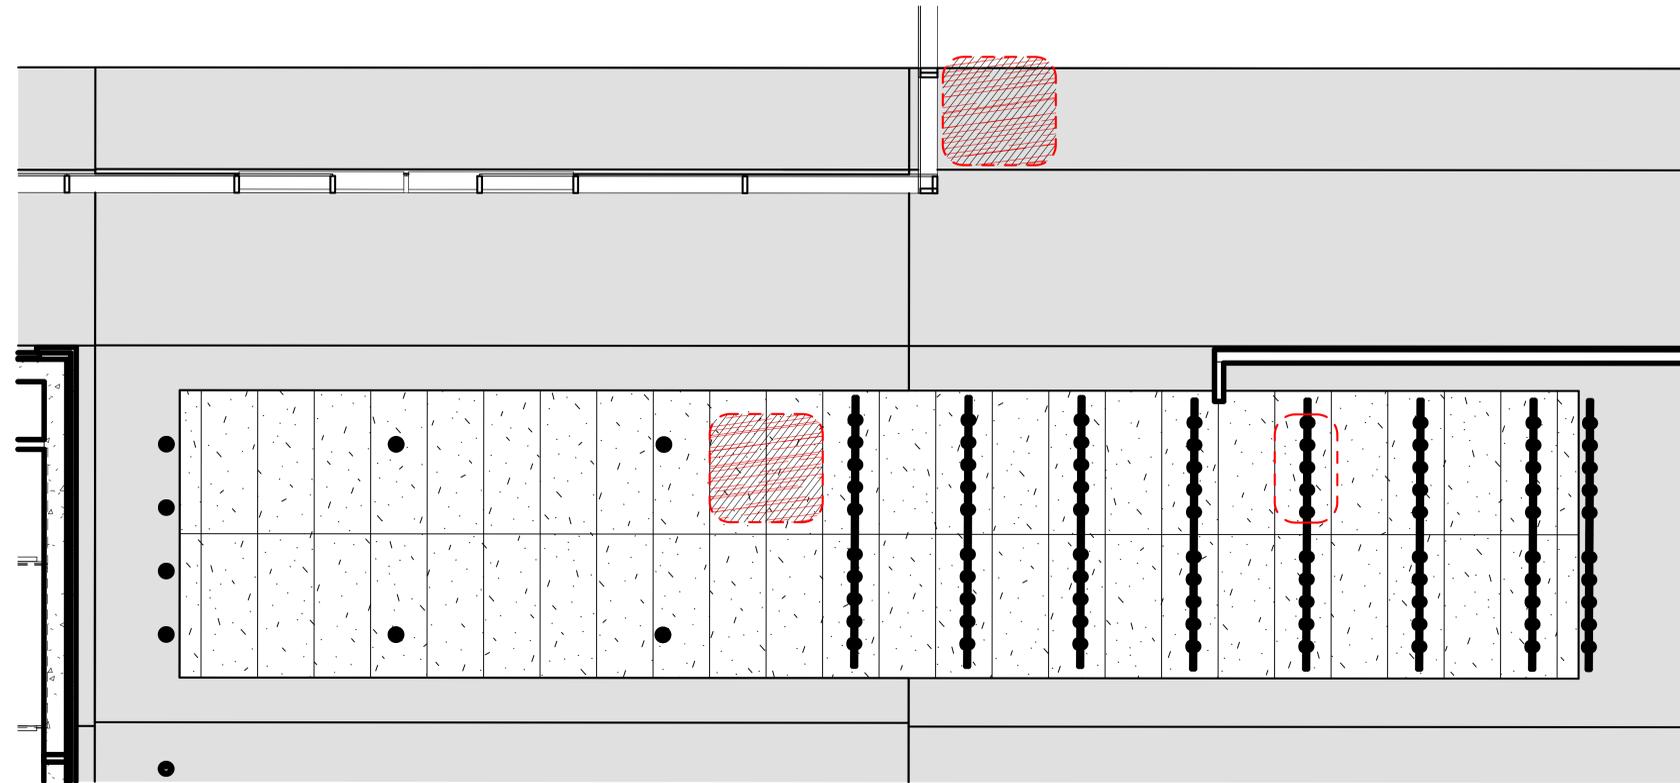

ARCHITECTURAL FINISHES & MATERIALS

CEILING LOCATIONS

FINISH LEGEND		
CEILING	X ECP	EXTERIOR CEMENT PLASTER
	X GWB	GYPSUM WALL BOARD (GWB-P AS NOTED)
	X PLSTR	PLASTER FINISH
	ACP - 1	ALUMINUM COMPOSITE PANEL
	ACP - 2	ACP - 2
	ACP - 2A	ACP - 2A
	ACP - 2B	ACP - 2B
	ACP - 2C	ACP - 2C
	ACP - 2D	ACP - 2 D
	ACP - 4	ACP - 4
ACM - 1	ACM 1 WALL SYSTEM C	
ACT - WD	ACT WD PRF	
ACT - 1	ACT - 1	
ACT - 2	ACT - 2	
SS - 1	STAINLESS STEEL FINISH	

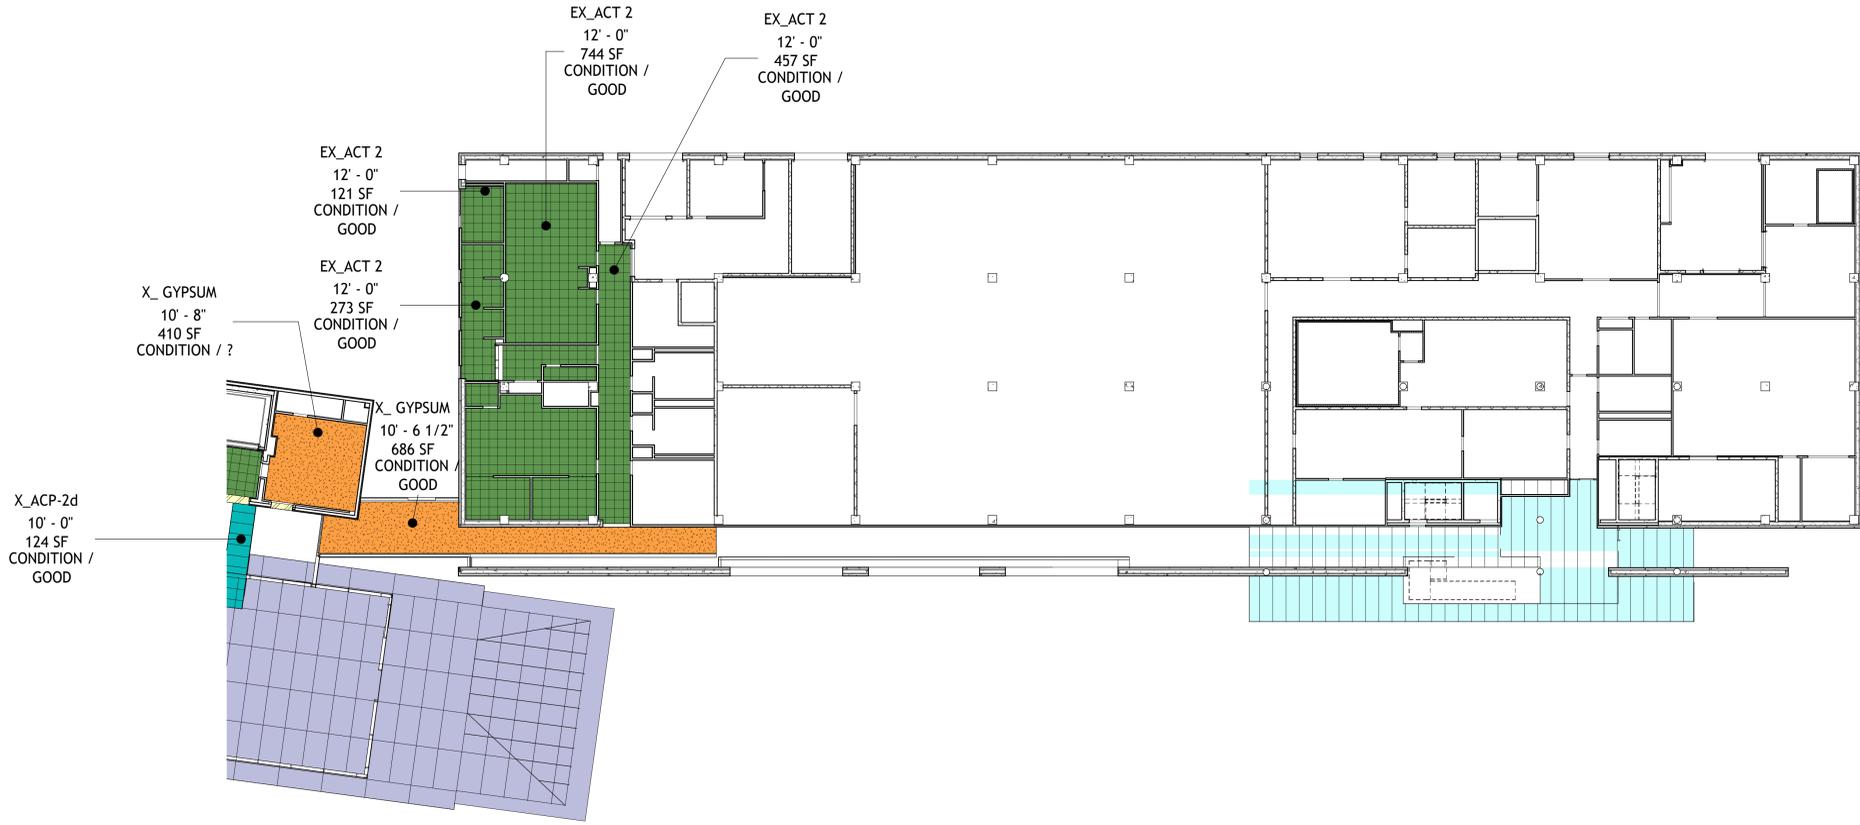


GROUND LEVEL

ARCHITECTURAL FINISHES & MATERIALS

CEILING LOCATIONS





FINISH LEGEND		
CEILING	X ECP	EXTERIOR CEMENT PLASTER
	X GWB	GYPSUM WALL BOARD (GWB-P AS NOTED)
	X PLSTR	PLASTER FINISH
ACP - 1	ALUMINUM COMPOSITE PANEL	
ACP - 2	ACP - 2	
ACP - 2A	ACP - 2A	
ACP - 2B	ACP - 2B	
ACP - 2C	ACP - 2C	
ACP - 2D	ACP - 2 D	
ACP - 4	ACP - 4	
ACM - 1	ACM 1 WALL SYSTEM C	
ACT - WD	ACT WD PRF	
ACT - 1	ACT - 1	
ACT - 2	ACT - 2	
SS - 1	STAINLESS STEEL FINISH	

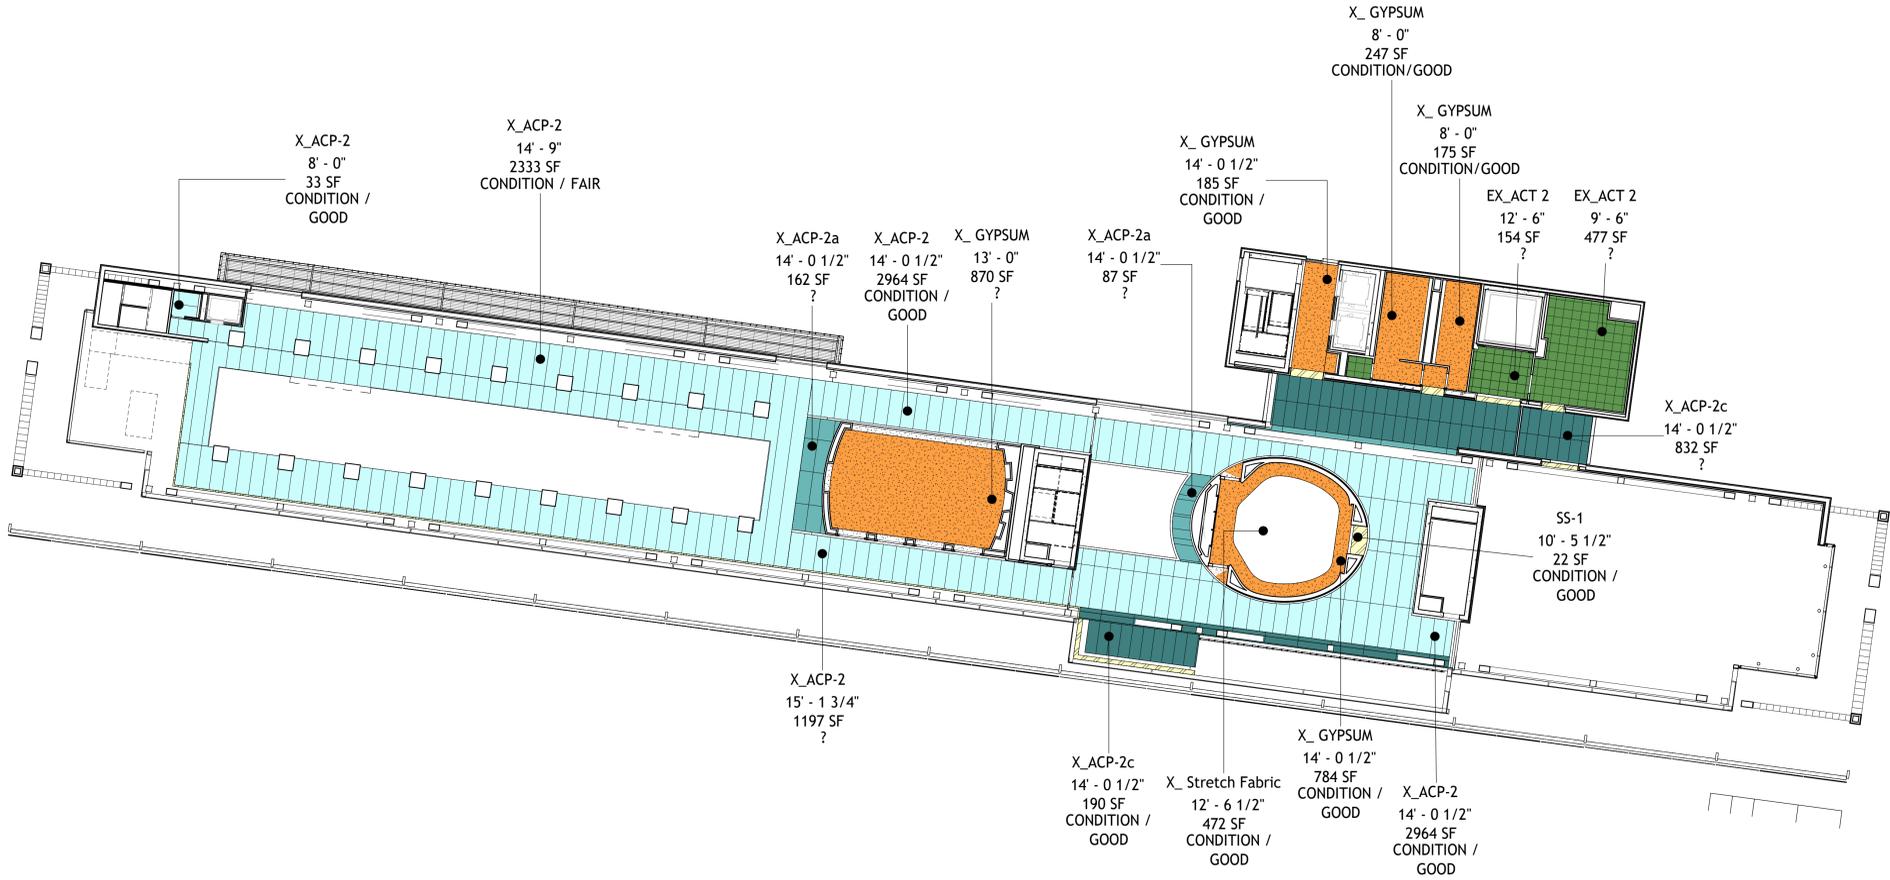

LOWER MUSEUM LEVEL


ARCHITECTURAL FINISHES & MATERIALS

CEILING ASSESSMENT

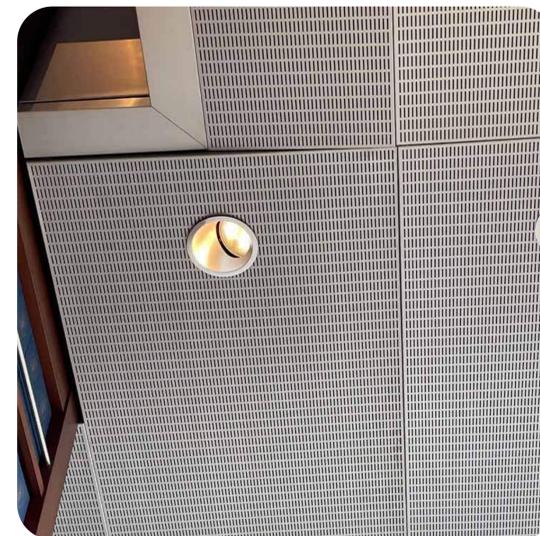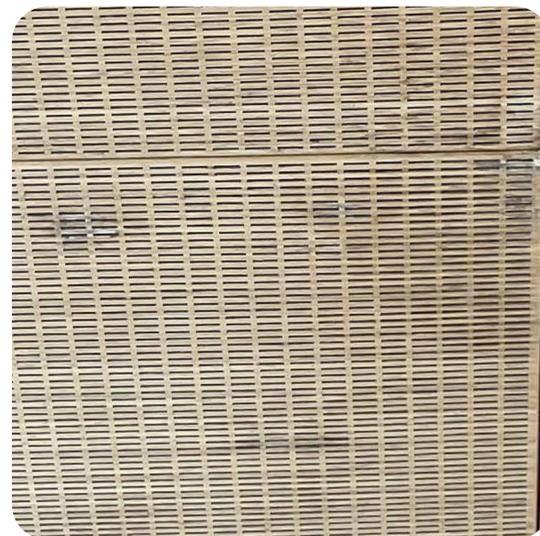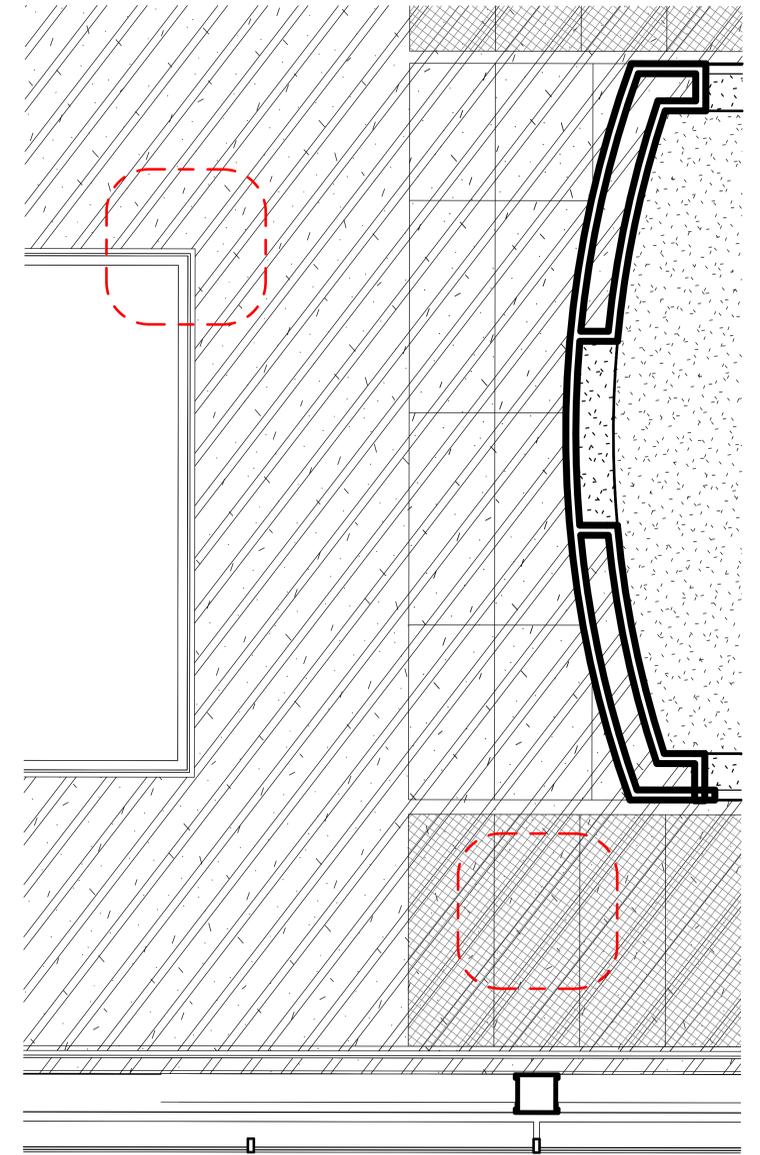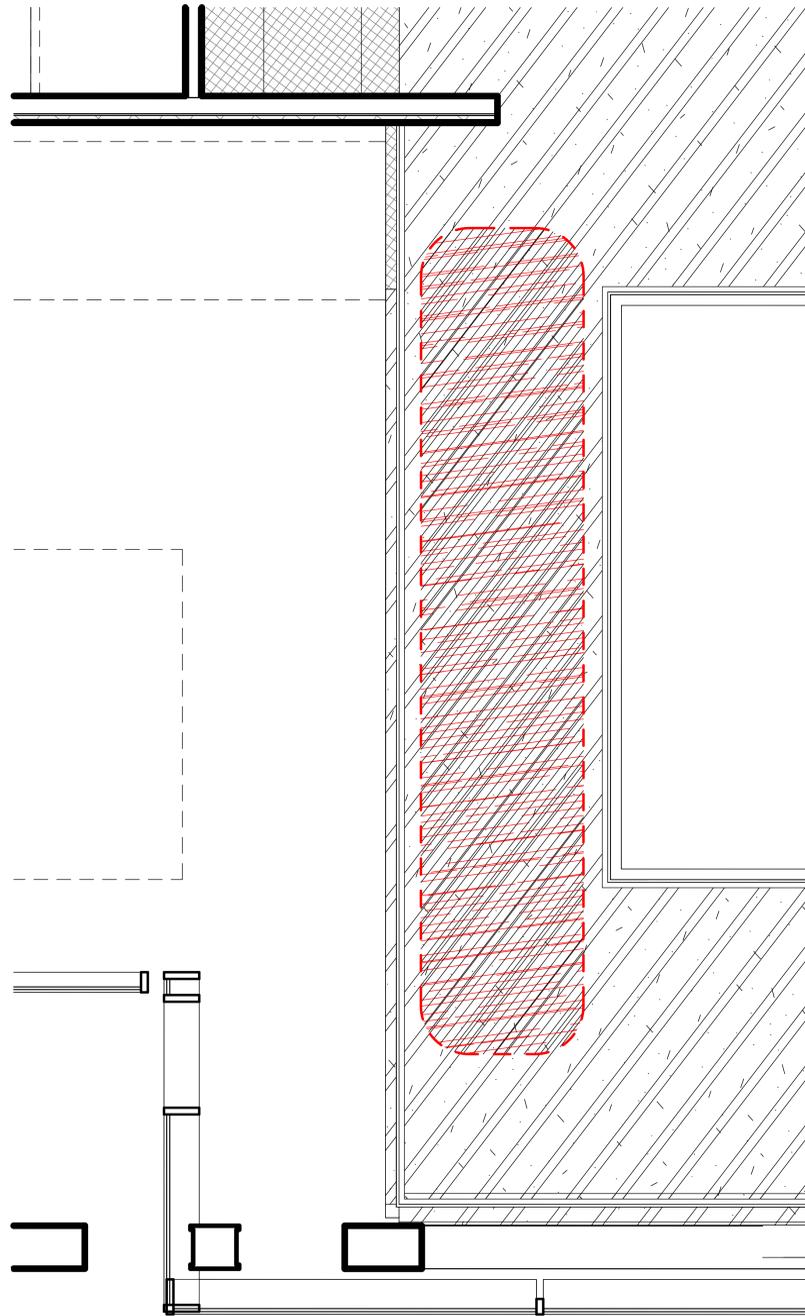

ARCHITECTURAL FINISHES & MATERIALS


CEILING ASSESSMENT

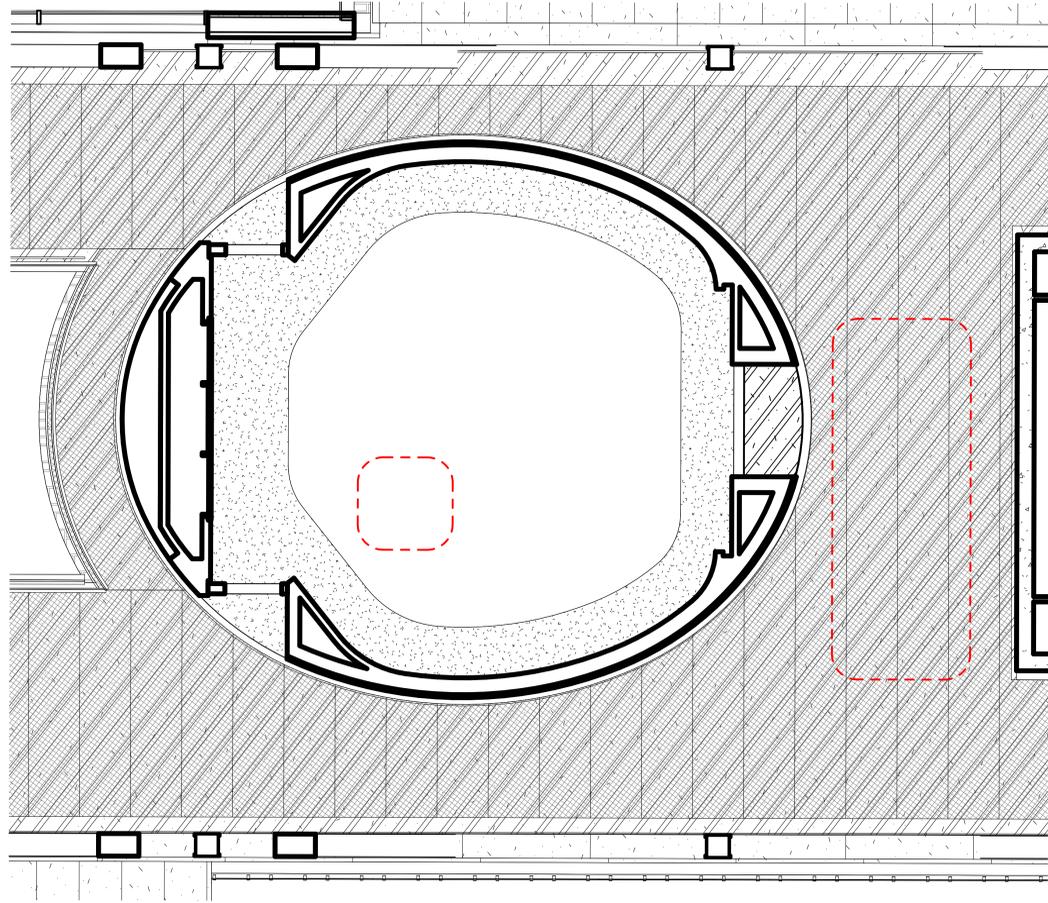

ARCHITECTURAL FINISHES & MATERIALS

CEILING LOCATIONS



FINISH LEGEND		
CEILING	X ECP	EXTERIOR CEMENT PLASTER
	X GWB	GYPSUM WALL BOARD (GWB-P AS NOTED)
	X PLSTR	PLASTER FINISH
	ACP - 1	ALUMINUM COMPOSITE PANEL
	ACP - 2	ACP - 2
	ACP - 2A	ACP - 2A
	ACP - 2B	ACP - 2B
	ACP - 2C	ACP - 2C
	ACP - 2D	ACP - 2 D
	ACP - 4	ACP - 4
ACM - 1	ACM 1 WALL SYSTEM C	
ACT - WD	ACT WD PRF	
ACT - 1	ACT - 1	
ACT - 2	ACT - 2	
SS - 1	STAINLESS STEEL FINISH	

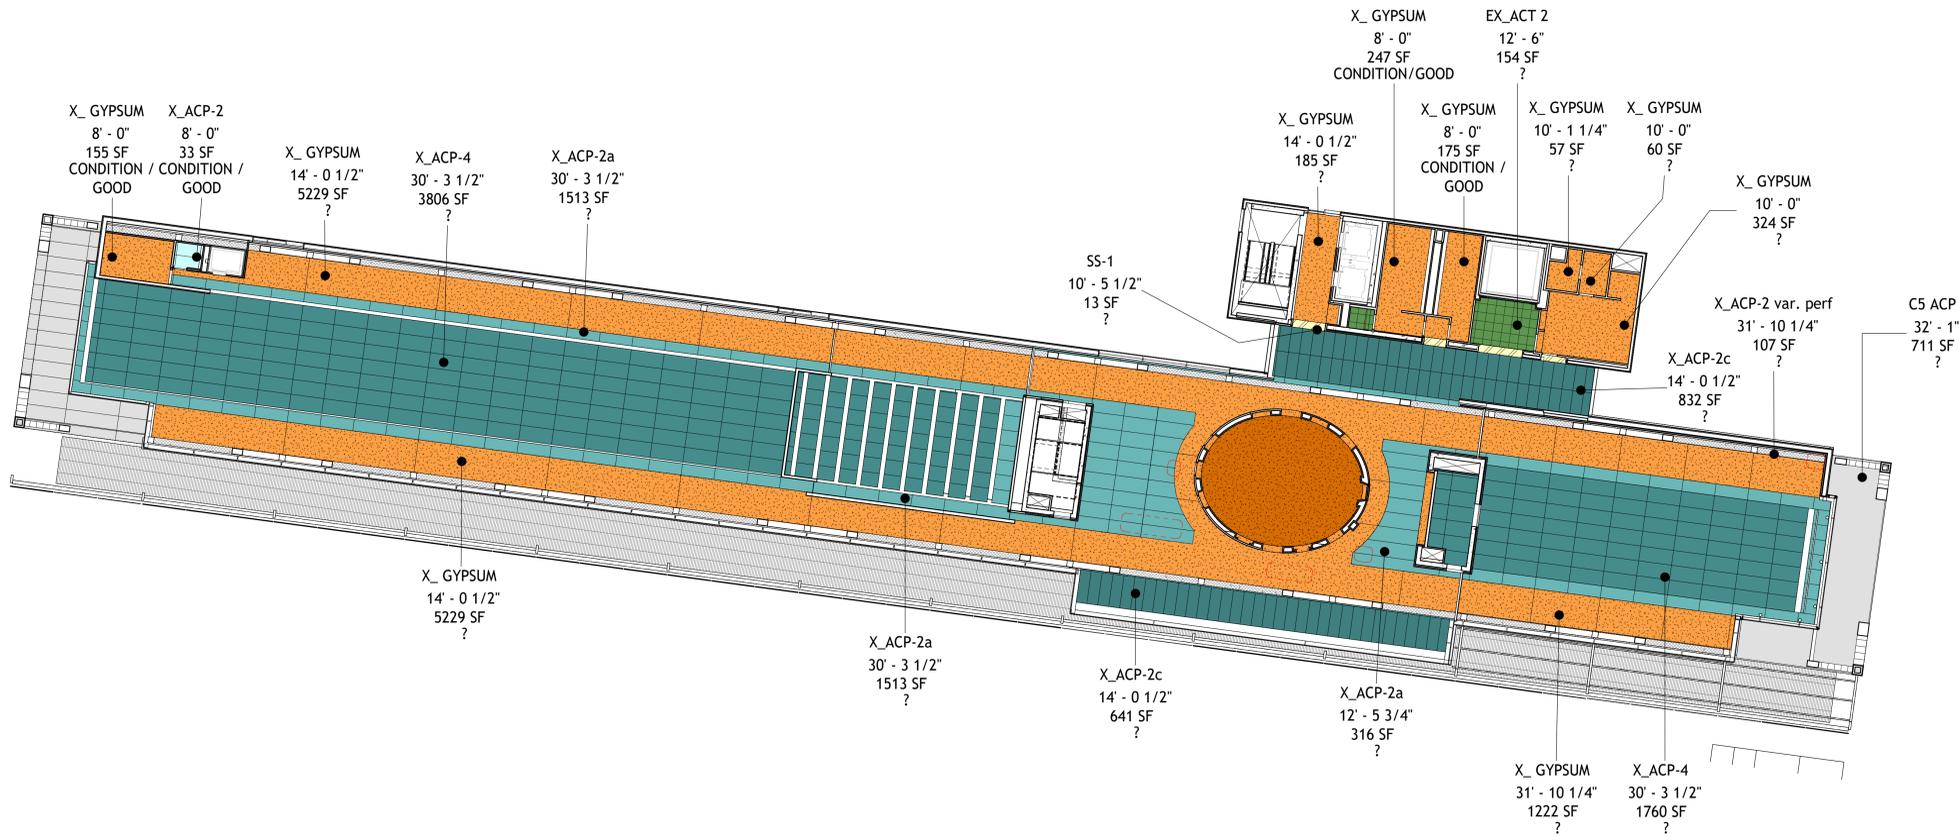

UPPER MUSEUM LEVEL

ARCHITECTURAL FINISHES & MATERIALS

CEILING ASSESSMENT

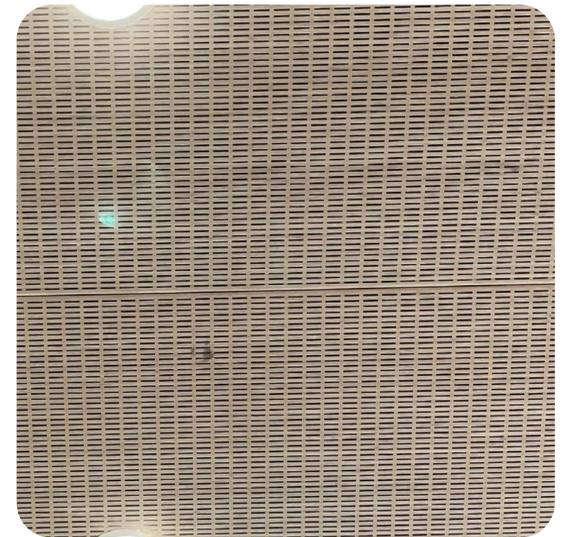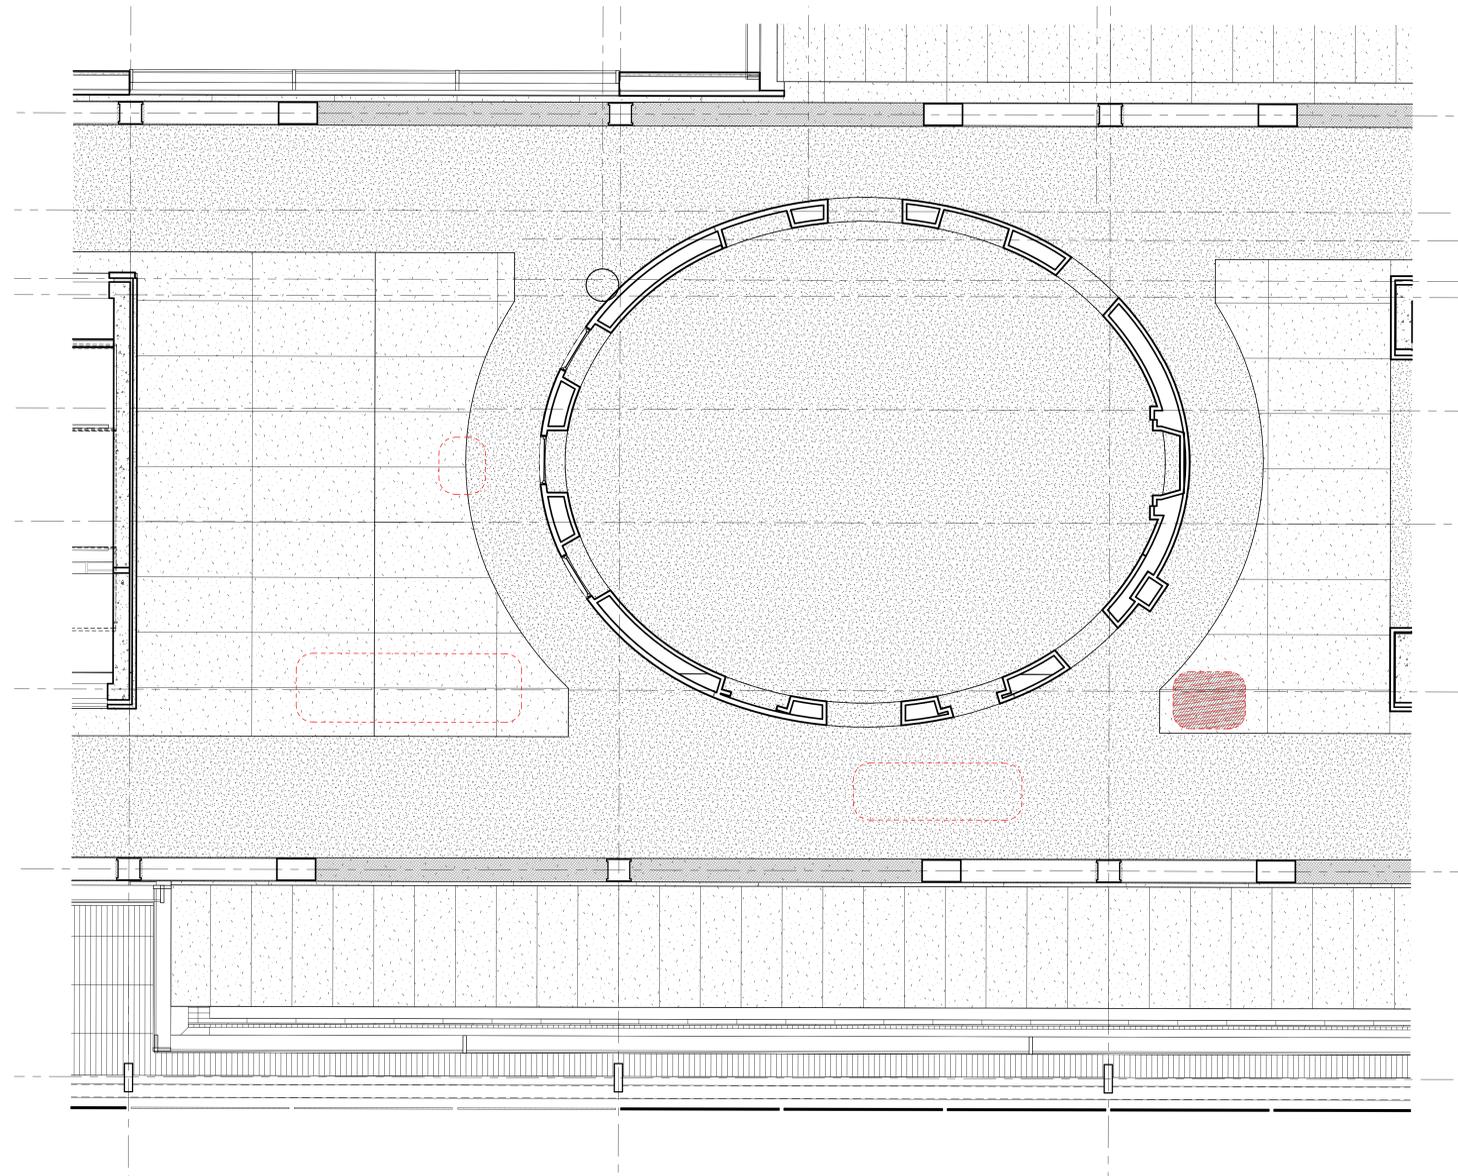

ARCHITECTURAL FINISHES & MATERIALS

WALL MATERIAL DIAGRAM

MATERIALS

-  STONE
-  METAL PANEL
-  GLAZING SYSTEM
-  TILE
-  UNLESS NOTED, GYPSUM WALL BD




BASEMENT LEVEL

ARCHITECTURAL FINISHES & MATERIALS

WALL MATERIAL DIAGRAM

MATERIALS

-  STONE
-  METAL PANEL
-  GLAZING SYSTEM
-  TILE
-  UNLESS NOTED, GYPSUM WALL BD

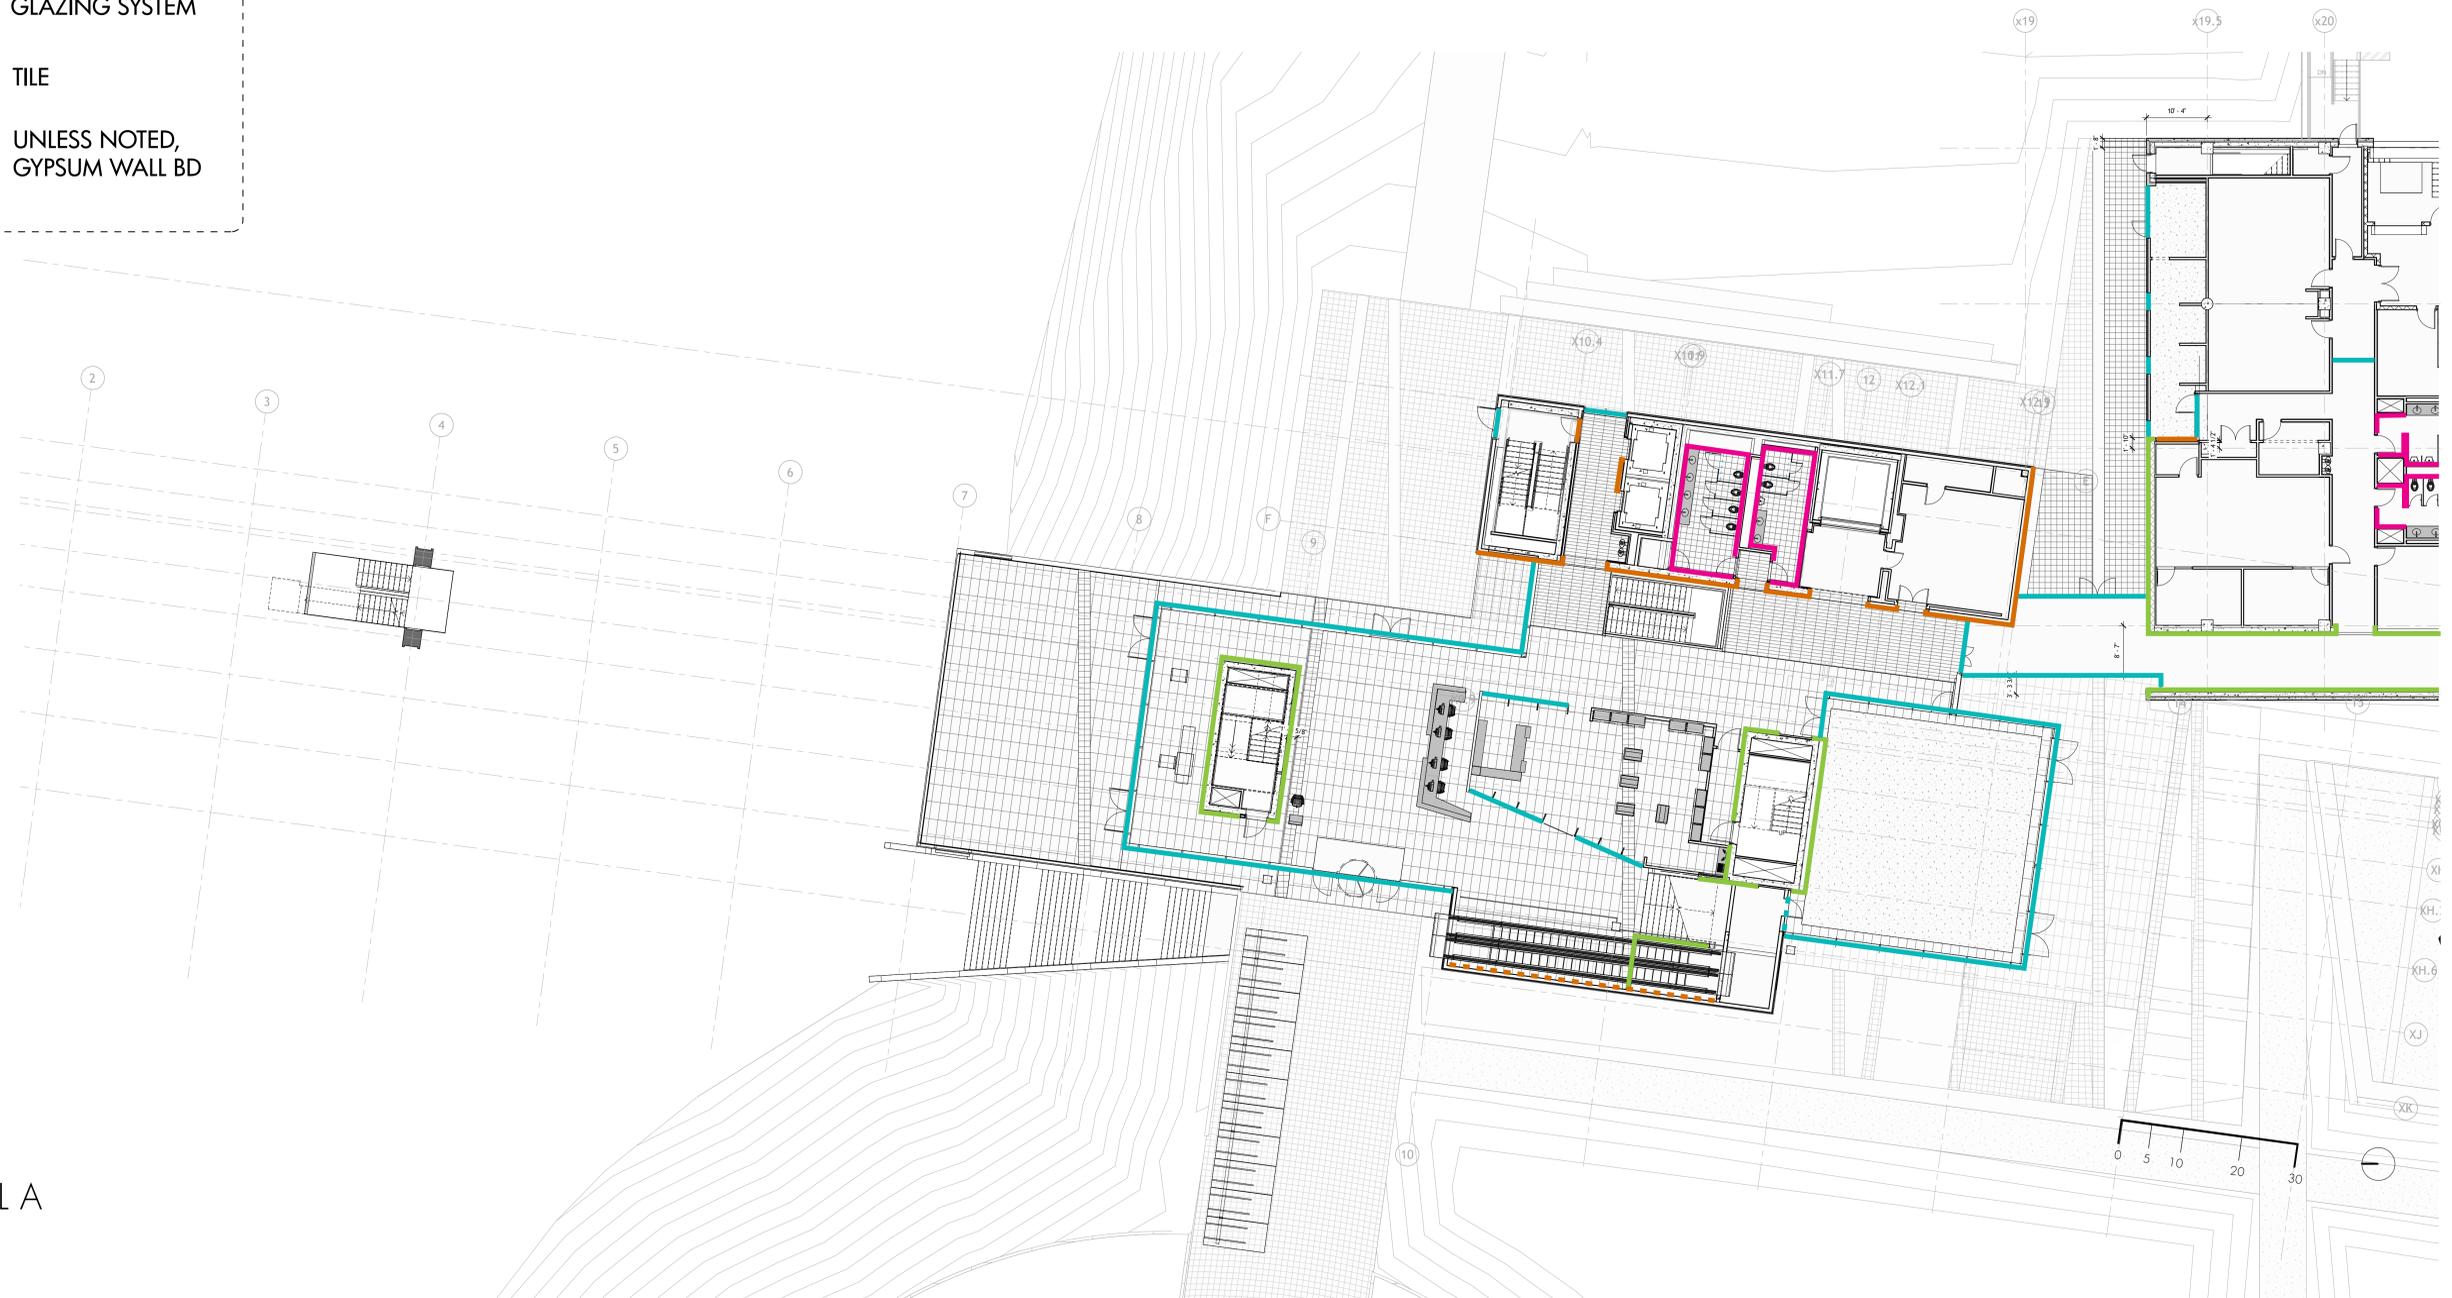


GROUND LEVEL A

ARCHITECTURAL FINISHES & MATERIALS

WALL MATERIAL DIAGRAM

MATERIALS

-  STONE
-  METAL PANEL
-  GLAZING SYSTEM
-  TILE
-  UNLESS NOTED, GYPSUM WALL BD

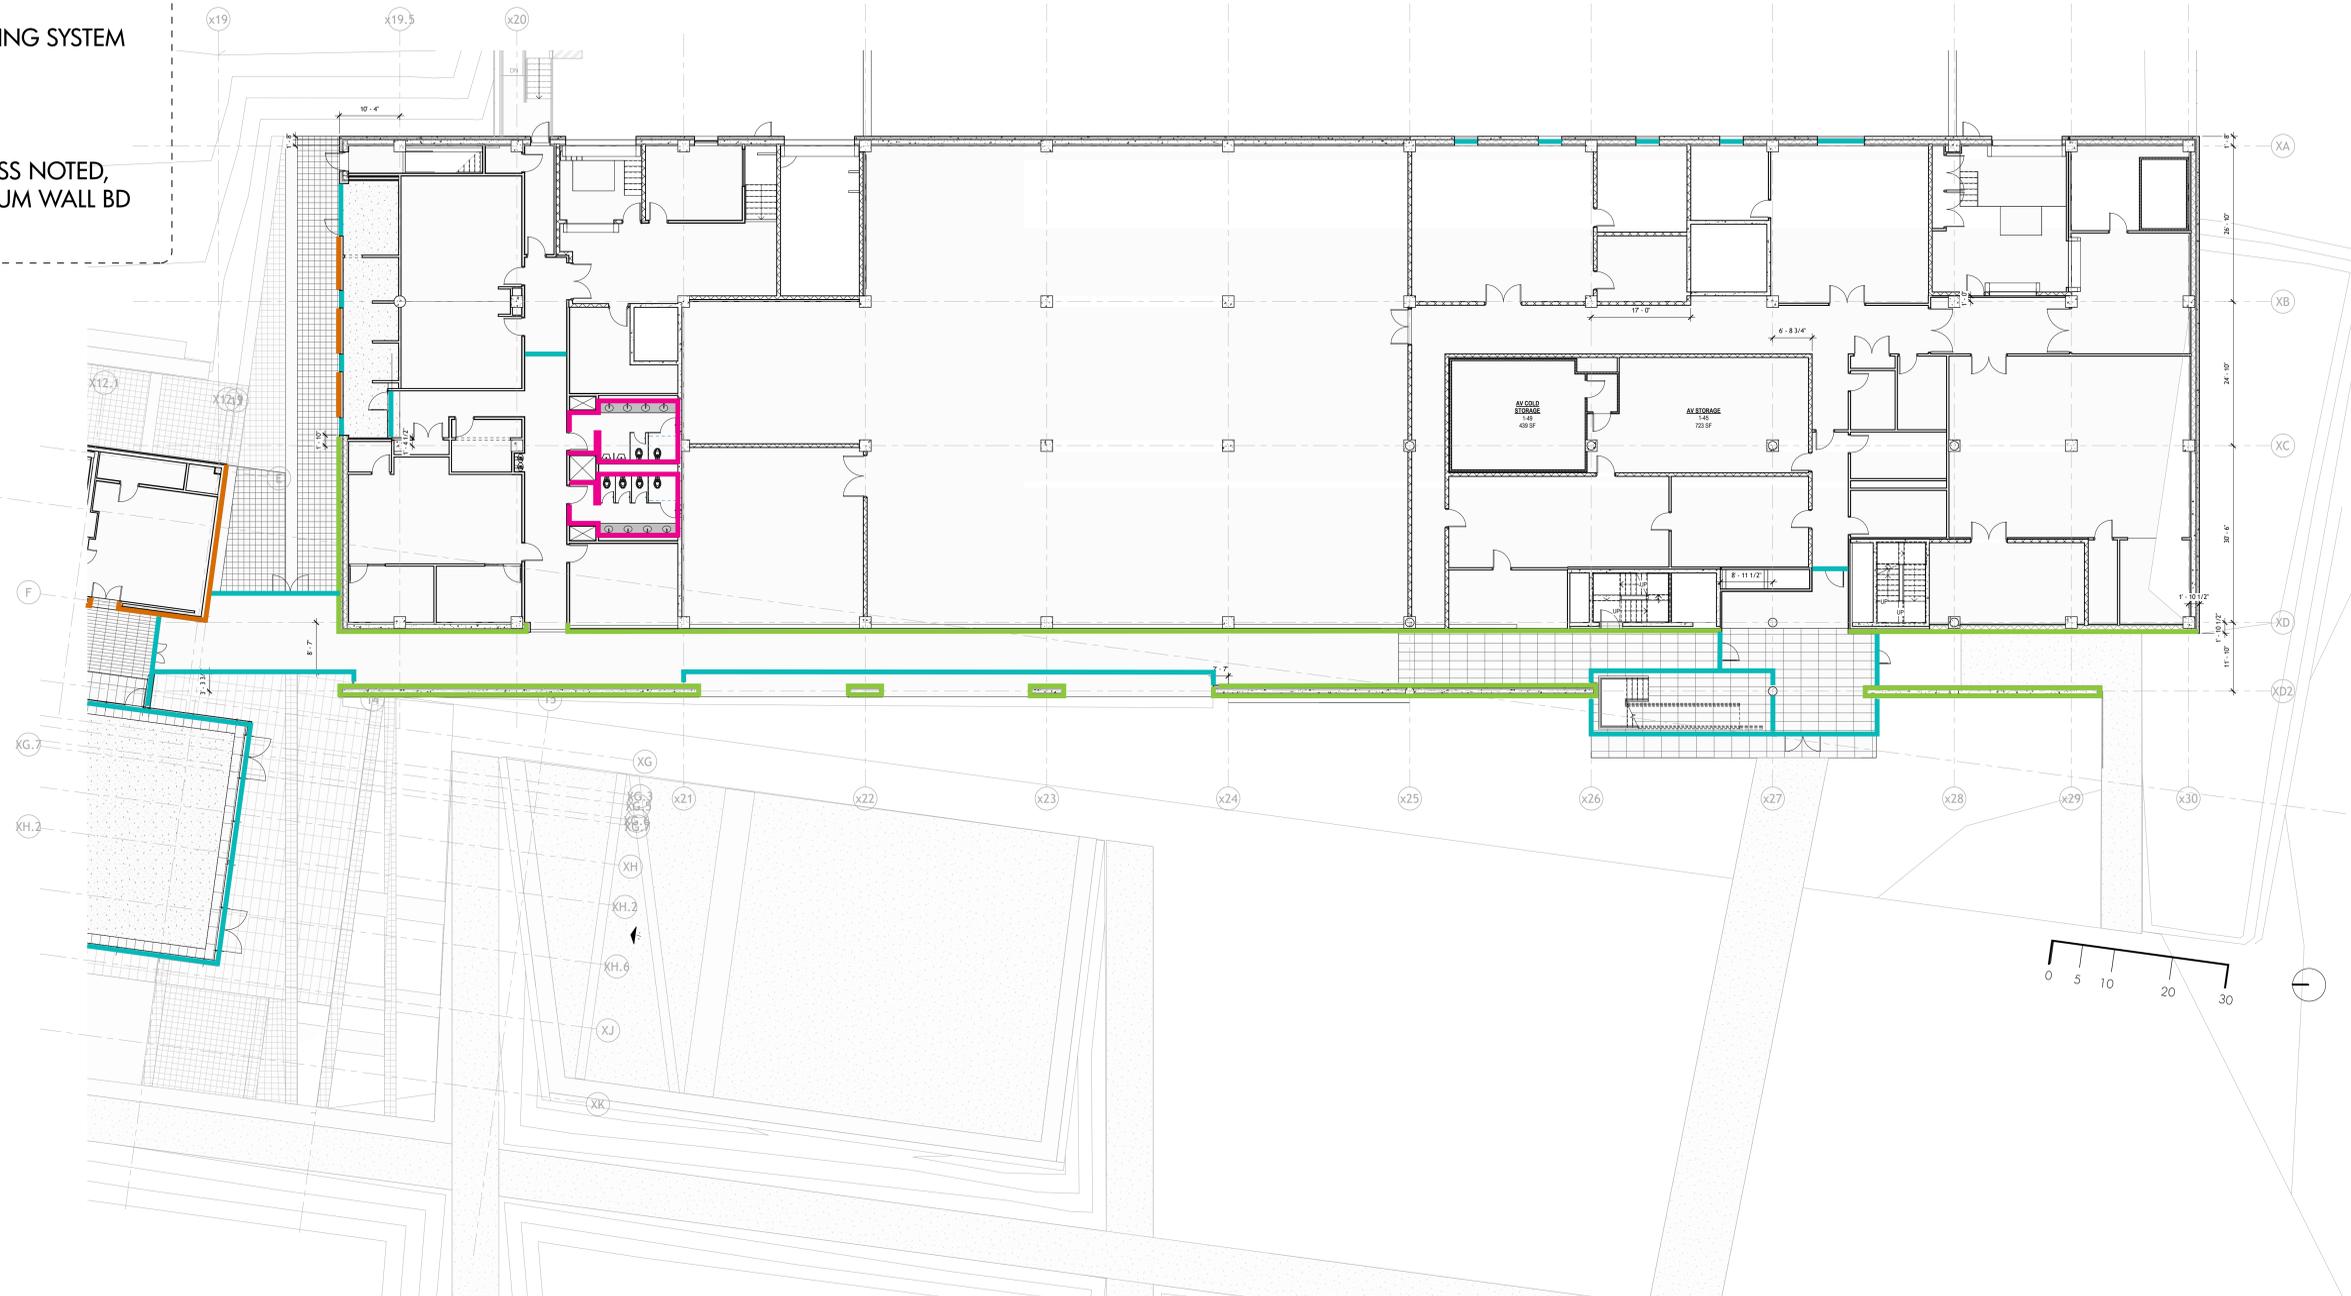


GROUND LEVEL B

ARCHITECTURAL FINISHES & MATERIALS

WALL MATERIAL DIAGRAM

MATERIALS

- STONE
- METAL PANEL
- GLAZING SYSTEM
- TILE
- WOOD
- UNLESS NOTED,
GYPSUM WALL BD

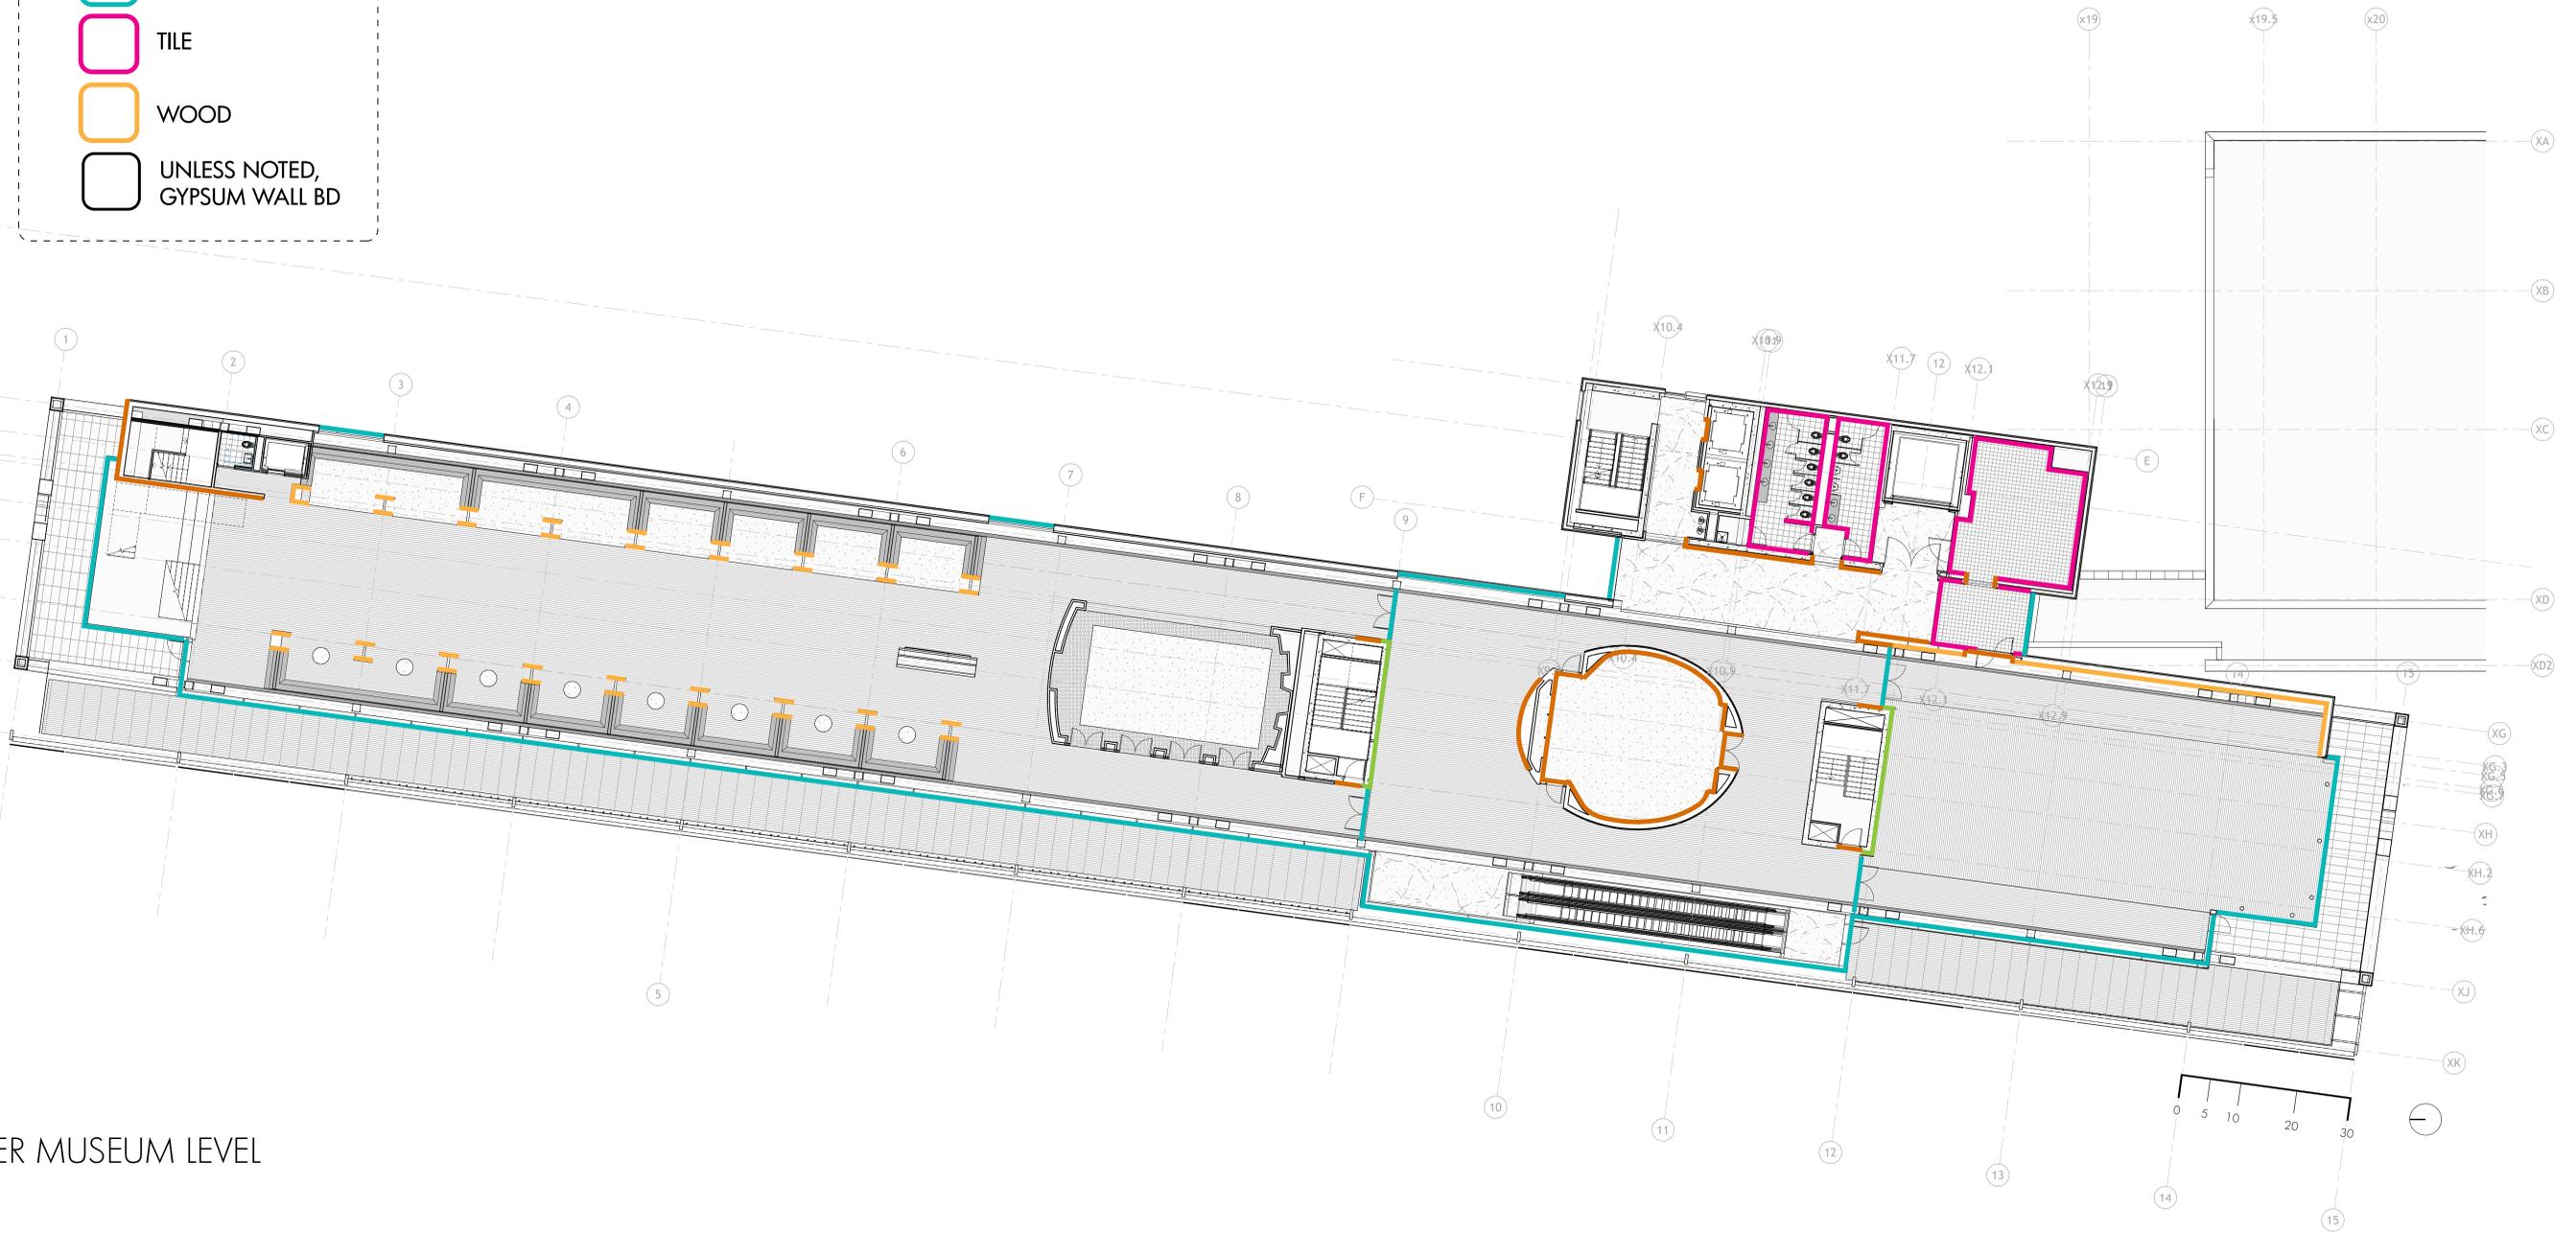


LOWER MUSEUM LEVEL

ARCHITECTURAL FINISHES & MATERIALS

WALL MATERIAL DIAGRAM

MATERIALS

- STONE
- METAL PANEL
- GLAZING SYSTEM
- TILE
- WOOD
- UNLESS NOTED, GYPSUM WALL BD

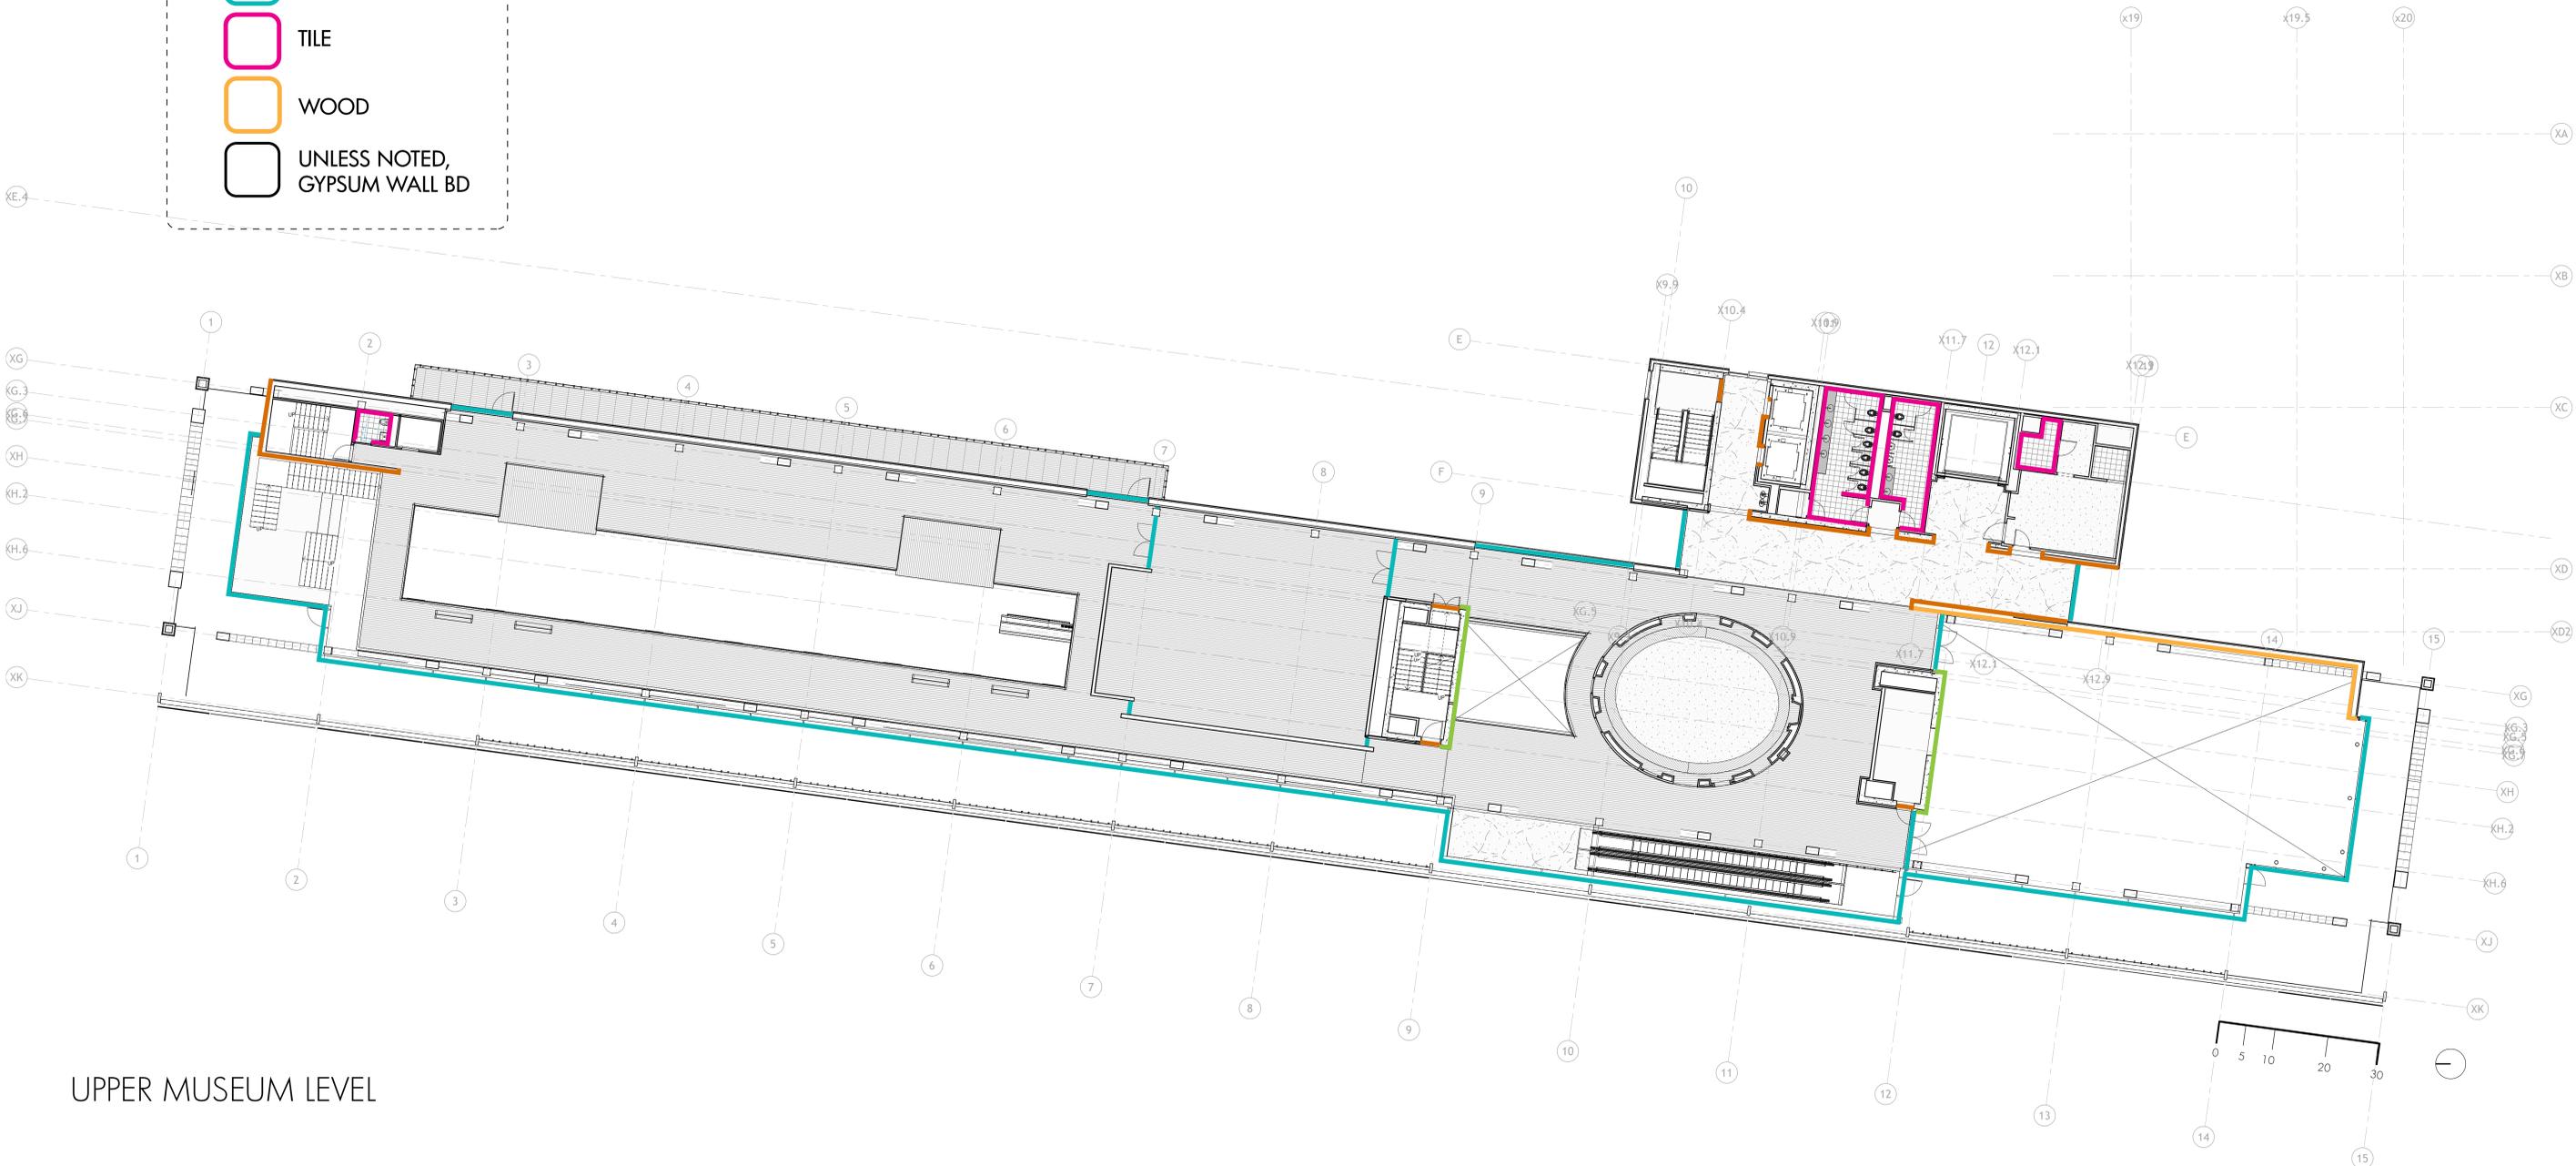

UPPER MUSEUM LEVEL