

PART ONE

ARCHITECTURAL DRAWINGS

Table listing architectural drawings including Cover Sheet, Drawing List, Abbreviations and Symbols, and various floor plans (A100a through A364).

Table listing architectural drawings including Wall System D - E Detail Sections, Wall System D Section Details, and various interior elevations and sections (A365 through A493).

Table listing architectural drawings including Museum Building Ornamental Store Plans and Sections, Museum Building Ornamental Store Details, and various interior elevations and sections (A500 through A593).

STRUCTURAL DRAWINGS

Table listing structural drawings including Foundation and Basement Level Plan, Foundation and Basement Level Plan, and various floor slabs and beams (S1000 through S2220).

PART TWO

MECHANICAL DRAWINGS

Table listing mechanical drawings including HVAC Symbols & Abbreviations, HVAC Symbols & Abbreviations, and various mechanical systems (M000 through M703).

PLUMBING DRAWINGS

Table listing plumbing drawings including Plumbing Notes, Plumbing Notes, and various plumbing fixtures and systems (P0001 through P402).

FIRE PROTECTION DRAWINGS

Table listing fire protection drawings including Fire Protection Notes Details & Schedules, Fire Protection Notes Details & Schedules, and various fire protection systems (F0001 through F1005).

TELECOM DRAWINGS

Table listing telecom drawings including Telecomm Legend & Symbols List, Telecomm Legend & Symbols List, and various telecom systems (T001 through T600).

ELECTRICAL DRAWINGS

Table listing electrical drawings including Electrical Symbols List & Abbreviations, Electrical Symbols List & Abbreviations, and various electrical systems (E001 through E200).

ACOUSTIC & AUDIOVISUAL DRAWINGS

Table listing acoustic and audiovisual drawings including Great Hall Facility Plan, Great Hall Facility Plan, and various acoustic systems (AV-101 through AV-204).

FOOD SERVICE DRAWINGS

Table listing food service drawings including Food Service Lower Level Equipment Plan, Food Service Lower Level Equipment Plan, and various food service systems (FS-1 through FS-FAB3).

SECURITY DRAWINGS

Table listing security drawings including Security Legend, Security Legend, and various security systems (SE-000 through SE-304).

WILLIAM J CLINTON PRESIDENTIAL CENTER

LITTLE ROCK, ARKANSAS

Architect: POLSHEK PARTNERSHIP LLP, 320 West 13th Street, New York, New York 10014, 212 807 7171

Coordinating Architects: POLK STANLEY YEARY ARCHITECTS Ltd, 700 South Schiller Street, Little Rock, Arkansas 72201, 501 378 0878

WITSELL EVANS RASCO, 801 West Third Street, Little Rock, Arkansas 72201, 501 374 5300

WOODS CARADINE ARCHITECTS, 2200 South Main Street, Little Rock, Arkansas 72206, 501 374 4060

Landscapes Architects: HARGREAVES ASSOCIATES, 118 Magazine Street, Cambridge Massachusetts 02139, 617 651 0070

LANDSCAPE ARCHITECTURE, Inc., 2300 Cottondale Lane Suite 202, Little Rock, Arkansas 72202, 501 374 5910

Structural Engineer

LESUE E ROBERTSON ASSOC., RLLP, 30 Broad Street, 47th Floor, New York, New York 10004, 212 750 9000

MEP Engineers

FLACK + KURTZ Inc, 475 Fifth Avenue, New York, New York 10017, 212 552 9600

CROMWELL ARCHITECTS ENGINEERS, 101 South Spring Street, Little Rock, Arkansas 72201, 501 372 2900

Curranwall Consultant

R. A. HEINTGES ARCHITECTS, 128 Fifth Avenue, 9th Floor, New York, New York 10011, 212 652 2666

Seal



Table with columns for Job No., Scale, Date, and Title, listing project milestones and dates.

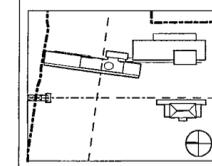


Table with columns for Job No., Scale, Date, and Title, listing project milestones and dates.

DRAWING LIST

Sheet No. A000

FOR OFFICIAL USE ONLY