


- GENERAL NOTES:**
1. THE LOCATION OF ALL SUBSURFACE STRUCTURES, PIPES, POWER, GAS, PHONE, ETC., SHOWN ON THE PLANS. THE CONTRACTOR SHALL BE RESPONSIBLE FOR OBTAINING INFORMATION AND VERIFYING HIMSELF AS TO THE LOCATION OF THE AFORESAID ITEMS. SHOWN AND NOT SHOWN ALL REPAIRS OR RELOCATIONS NECESSARY SHALL BE MADE AS REQUIRED BY THE OWNER OF THE UTILITY OR STRUCTURE. THE COST OF SUCH REPAIRS OR RELOCATIONS NECESSARY SHALL BE BORNE BY THE CONTRACTOR.
  2. ALL STREETS, WALKS, DRIVEWAYS, DRAINAGE STRUCTURES, FENCES, ETC. THAT ARE DISTURBED SHALL BE RESTORED TO THEIR ORIGINAL OR BETTER CONDITION USING LIKE MATERIALS. COST OF SUCH REPAIRS SHALL BE BORNE BY THE CONTRACTOR UNLESS PROVISIONAL PAYMENT IS MADE IN THE PROPOSAL.
  3. ALL CONCRETE SHALL DEVELOP 3000 PSI COMPRESSIVE STRENGTH IN 28 DAYS UNLESS OTHERWISE SPECIFIED.
  4. THE CONTRACTOR IS REQUIRED TO NOTIFY THE ONE CALL CENTER AT 1-800-482-8999 48 HOURS PRIOR TO DIGGING IN ORDER THAT UNDERGROUND UTILITIES IN THE AREA CAN BE LOCATED.
  5. ALL INLETS ON AND ADJACENT TO THE SITE SHALL BE PROTECTED FROM SEDIMENT.
  6. INSPECT ALL EROSION CONTROL DEVICES WEEKLY AND FOLLOWING RAINFALL EVENTS OF 0.5 INCHES.
  7. ALL EROSION CONTROL DEVICES ARE TO BE MAINTAINED IN GOOD WORKING CONDITION THROUGHOUT THE DURATION OF THE PROJECT AND UNTIL PERMANENT VEGETATION IS ESTABLISHED. ALL SEDIMENT TRAPS ARE TO BE CLEANED AS REQUIRED.
  8. ALL DISTURBED AREAS LEFT IDLE FOR A PERIOD OF 14 DAYS OR LONGER ARE TO RECEIVE TEMPORARY VEGETATION AND MULCHED.
  9. REMOVE EROSION CONTROL DEVICES AFTER PERMANENT VEGETATION IS ESTABLISHED.
  10. THIS EROSION CONTROL PLAN AND ALL EROSION CONTROL DEVICES MAY BE ADDED TO OR DELETED AS DIRECTED BY THE ENGINEER.
  11. THE LOCATIONS OF THESE EROSION CONTROL DEVICES MAY BE CHANGED IF SITE CONDITIONS WARRANT TO PREVENT EROSION.
  12. CONTRACTOR TO COMPLY WITH ARKANSAS TRENCH EXCAVATION AND SAFETY REQUIREMENTS.
  13. PROPOSED GRADE DATA SHOWN HERE TO ON THESE PLANS ARE FROM A DIGITAL FILE PROVIDED BY HARRIS ASSOCIATES, 118 MAGAZINE STREET, CAMBRIDGE, MA 02138.
  14. PROPOSED GRADES ARE SHOWN FOR REFERENCE AND MUST BE CONFIRMED WITH GRADING PLAN, SHEETS L102-L107 THIS DRAWING SET.
  15. EXTREME CARE MUST BE TAKEN FOR ALL WORK NEAR THE LITTLE ROCK WASTE WATER UTILITY 54" SANITARY SEWER MAIN EXCAVATION NEAR THE 54" MAIN SHALL NOT EXPOSE MORE THAN ONE JOINT (APPROX. 18') AT ONE TIME. COORDINATE ALL WORK WITH LITTLE ROCK WASTE WATER UTILITY.
  16. IF SLOPES STEEPER THAN 3H:1V ARE ESTABLISHED, THE CONTRACTOR SHALL STABILIZE THESE SLOPES WITH THE RECOMMENDATIONS LISTED WITHIN THE SOIL LOSS CALCULATIONS IN THE SWPPP.
  17. THE CONTRACTOR MAY REPLACE THE CRUSHED ROCK AND WOOD CHIPS SPECIFIED IN THE SOIL LOSS CALCULATIONS WITH THE SPECIFIED TEMPORARY MATTING.

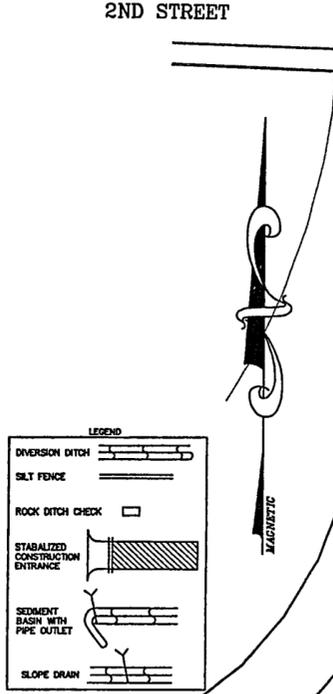

**WILLIAM J CLINTON  
PRESIDENTIAL  
CENTER & PARK**

LITTLE ROCK, ARKANSAS

Architect  
POLSHKEK PARTNERSHIP LLP  
320 West 13th Street  
New York, New York 10014  
212 607 7171

Landscape Architect  
Management  
Associates  
118 Magazine Street  
Cambridge, Massachusetts 02139  
617 651 0071  
617 681 0664

Coordinating Landscape Architect  
LANDSCAPE ARCHITECTURE, INC.  
2300 Cottondale Lane, Suite 202  
Little Rock, Arkansas 72202  
501 374 5810

Civil Engineer  
McLLELLAND CONSULTING ENGINEERS  
900 W Markham Street  
Little Rock, Arkansas 72201  
501 371 0272

Electrical Engineer  
CROMWELL ARCHITECTS ENGINEERS  
101 South Spring Street  
Little Rock, Arkansas 72201  
501 372 2500

Manne + Structural Engineers  
MOFFATT & NICHOL ENGINEERS  
1616 East Millbrook Road, Suite 160  
Raleigh, North Carolina 27609  
919 781 4625

Fountain  
DAN EUSER WATERARCHITECTURE INC  
58 Mackenzie Drive West  
Richmond Hill, Ontario L4C 3E2  
CANADA  
905 884 4176

Playground Design  
PLAY SITE ARCHITECTURE  
7 Farmway Road  
Acton, Massachusetts 01720  
978 263 1050

Signage Design  
POULIN + MORRIS  
286 Spring Street, Sixth Floor  
New York, New York 10013  
212 675 1332

Seal  
STATE OF ARKANSAS  
REGISTERED PROFESSIONAL ENGINEER  
No. 5412  
WILLIAM J. CLINTON  
9-17-2002

CERTIFICATE OF AUTHORITY  
McLLELLAND CONSULTING ENGINEERS  
No. 24  
ARKANSAS ENGINEER

Issue	Date
05 100% Site Package 2 CD	09/27/02
04 90% Site Package 2 CD	08/16/02
03 60% Site Package 2 CD	06/28/02
02 100% Design Development	04/01/02
01 100% Site Package 1 CD	02/15/02

Job No PPA 9908  
HA, CFC0101

Scale 1" = 30'-0"

Date SEPTEMBER 27, 2002

Title SITE PACKAGE 2  
100% CONSTRUCTION DOCUMENTS  
EROSION CONTROL  
PLAN  
AREA "C"

Sheet No C204

1" = 30'-0" 0 10 20 30 60FT

FOR OFFICIAL USE ONLY