
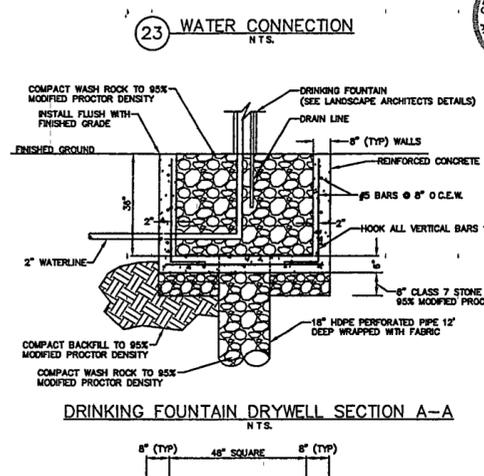
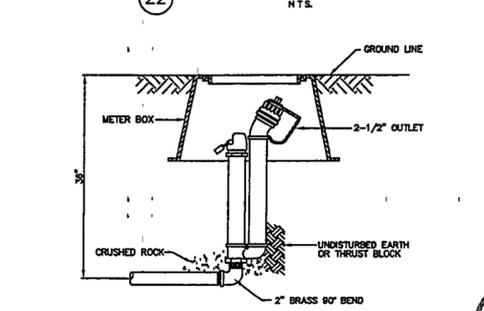
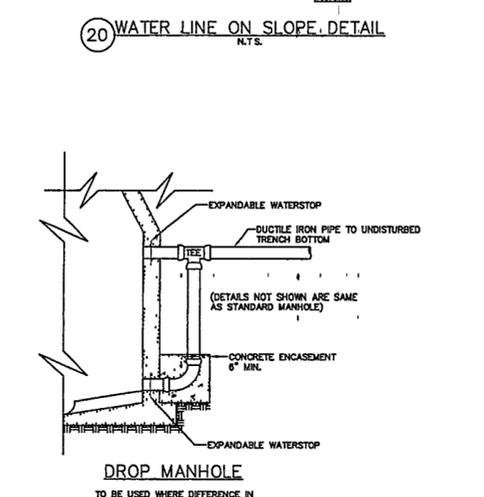
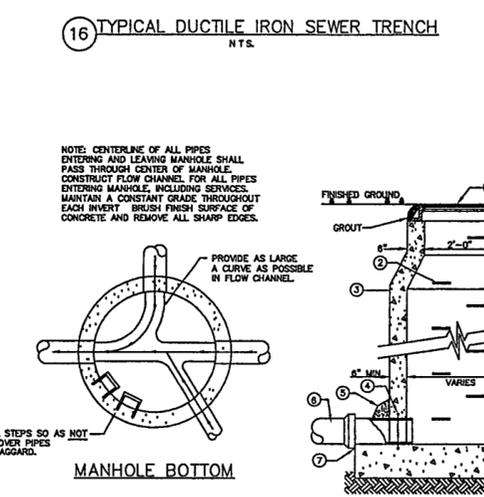
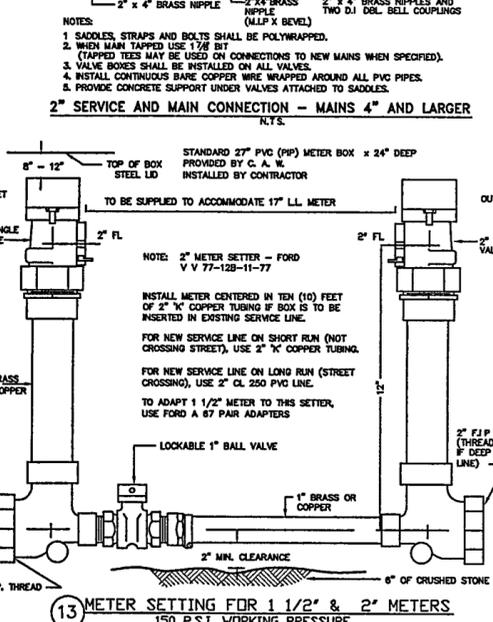
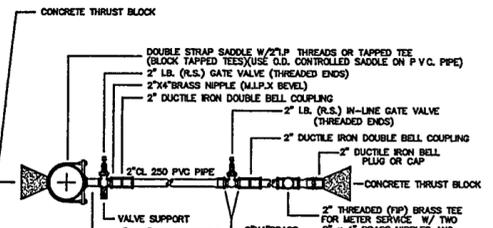
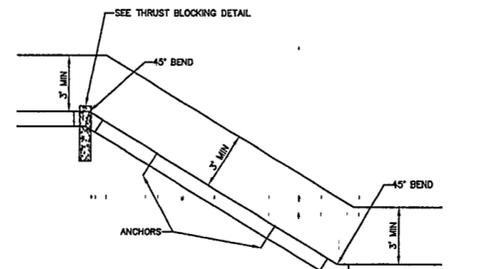
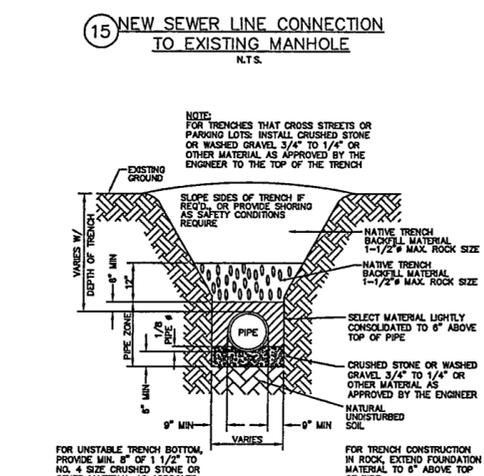


PIPE SIZE	ANCHOR COLLAR SCHEDULE DIMENSIONS			REINFORCING BARS	
	W	H	T	A	B
1 1/2"	1 1/2"	2 0"	1 0"	M.I. RETAINER GLAND	Ø 008"
2"	2 0"	4 0"	1 0"	M.I. RETAINER GLAND	Ø 008"
2 1/2"	2 1/2"	4 0"	1 0"	M.I. RETAINER GLAND	Ø 008"
3"	3 0"	4 0"	1 0"	M.I. RETAINER GLAND	Ø 008"
3 1/2"	3 1/2"	4 0"	1 0"	M.I. RETAINER GLAND	Ø 008"
4"	4 0"	4 0"	1 0"	M.I. RETAINER GLAND	Ø 008"
4 1/2"	4 1/2"	4 0"	1 0"	M.I. RETAINER GLAND	Ø 008"
5"	5 0"	4 0"	1 0"	M.I. RETAINER GLAND	Ø 008"
5 1/2"	5 1/2"	4 0"	1 0"	M.I. RETAINER GLAND	Ø 008"
6"	6 0"	4 0"	1 0"	M.I. RETAINER GLAND	Ø 008"
6 1/2"	6 1/2"	4 0"	1 0"	M.I. RETAINER GLAND	Ø 008"
7"	7 0"	4 0"	1 0"	M.I. RETAINER GLAND	Ø 008"
7 1/2"	7 1/2"	4 0"	1 0"	M.I. RETAINER GLAND	Ø 008"
8"	8 0"	4 0"	1 0"	M.I. RETAINER GLAND	Ø 008"
8 1/2"	8 1/2"	4 0"	1 0"	M.I. RETAINER GLAND	Ø 008"
9"	9 0"	4 0"	1 0"	M.I. RETAINER GLAND	Ø 008"
9 1/2"	9 1/2"	4 0"	1 0"	M.I. RETAINER GLAND	Ø 008"
10"	10 0"	4 0"	1 0"	M.I. RETAINER GLAND	Ø 008"
10 1/2"	10 1/2"	4 0"	1 0"	M.I. RETAINER GLAND	Ø 008"
11"	11 0"	4 0"	1 0"	M.I. RETAINER GLAND	Ø 008"
11 1/2"	11 1/2"	4 0"	1 0"	M.I. RETAINER GLAND	Ø 008"
12"	12 0"	4 0"	1 0"	M.I. RETAINER GLAND	Ø 008"

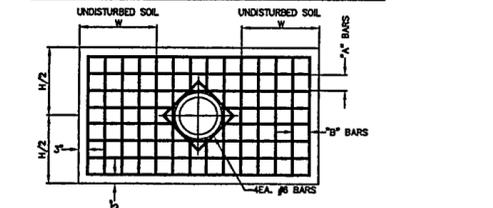

WILLIAM J. CLINTON
PRESIDENTIAL CENTER & PARK

LITTLE ROCK, ARKANSAS

Architect
POLSHEK PARTNERSHIP LLP
320 West 13th Street
New York, New York 10014
212 807 7171

Landscape Architect
118 Magazine Street
Cambridge, Massachusetts 02139
617 681 0070
617 681 0064

Coordinating Landscape Architect
LANDSCAPE ARCHITECTURE, INC.
2300 Cottondale Lane, Suite 202
Little Rock, Arkansas 72202
501 374 5810

Civil Engineer
MCLELLAND CONSULTING ENGINEERS
900 W. Markham Street
Little Rock, Arkansas 72201
501 371 0272

Electrical Engineer
CROMWELL ARCHITECTS ENGINEERS
101 South Spring Street
Little Rock, Arkansas 72201
501 372 2900

Manne + Structural Engineers
MOFFATT & NICHOL ENGINEERS
1616 East Millbrook Road, Suite 160
Raleigh, North Carolina 27609
919 781 4626

Fountain
DAN EUSER WATERARCHITECTURE INC.
58 Mackade Drive West
Richmond Hill, Ontario L4C 3S2
CANADA
905 884 4176

Playground Design
PLAY SITE ARCHITECTURE
7 Fairway Road
Acton, Massachusetts 01720
978 263 1090

Signage Design
POULIN + MORRIS
286 Spring Street, Sixth Floor
New York, New York 10013
212 675 1332

Issue	Date
05 100% Site Package 2 CD	08/27/02
04 90% Site Package 2 CD	08/16/02
03 60% Site Package 2 CD	06/29/02
02 100% Design Development	04/01/02
01 100% Site Package 1 CD	02/15/02

Job No: PPA 9908
Scale: HA CPC0101
Date: AS SHOWN
Title: **SITE PACKAGE 2**
100% CONSTRUCTION DOCUMENTS
SITE UTILITY DETAILS
Sheet No: **C308**