


→ ARKANSAS RIVER →

→ ARKANSAS RIVER →

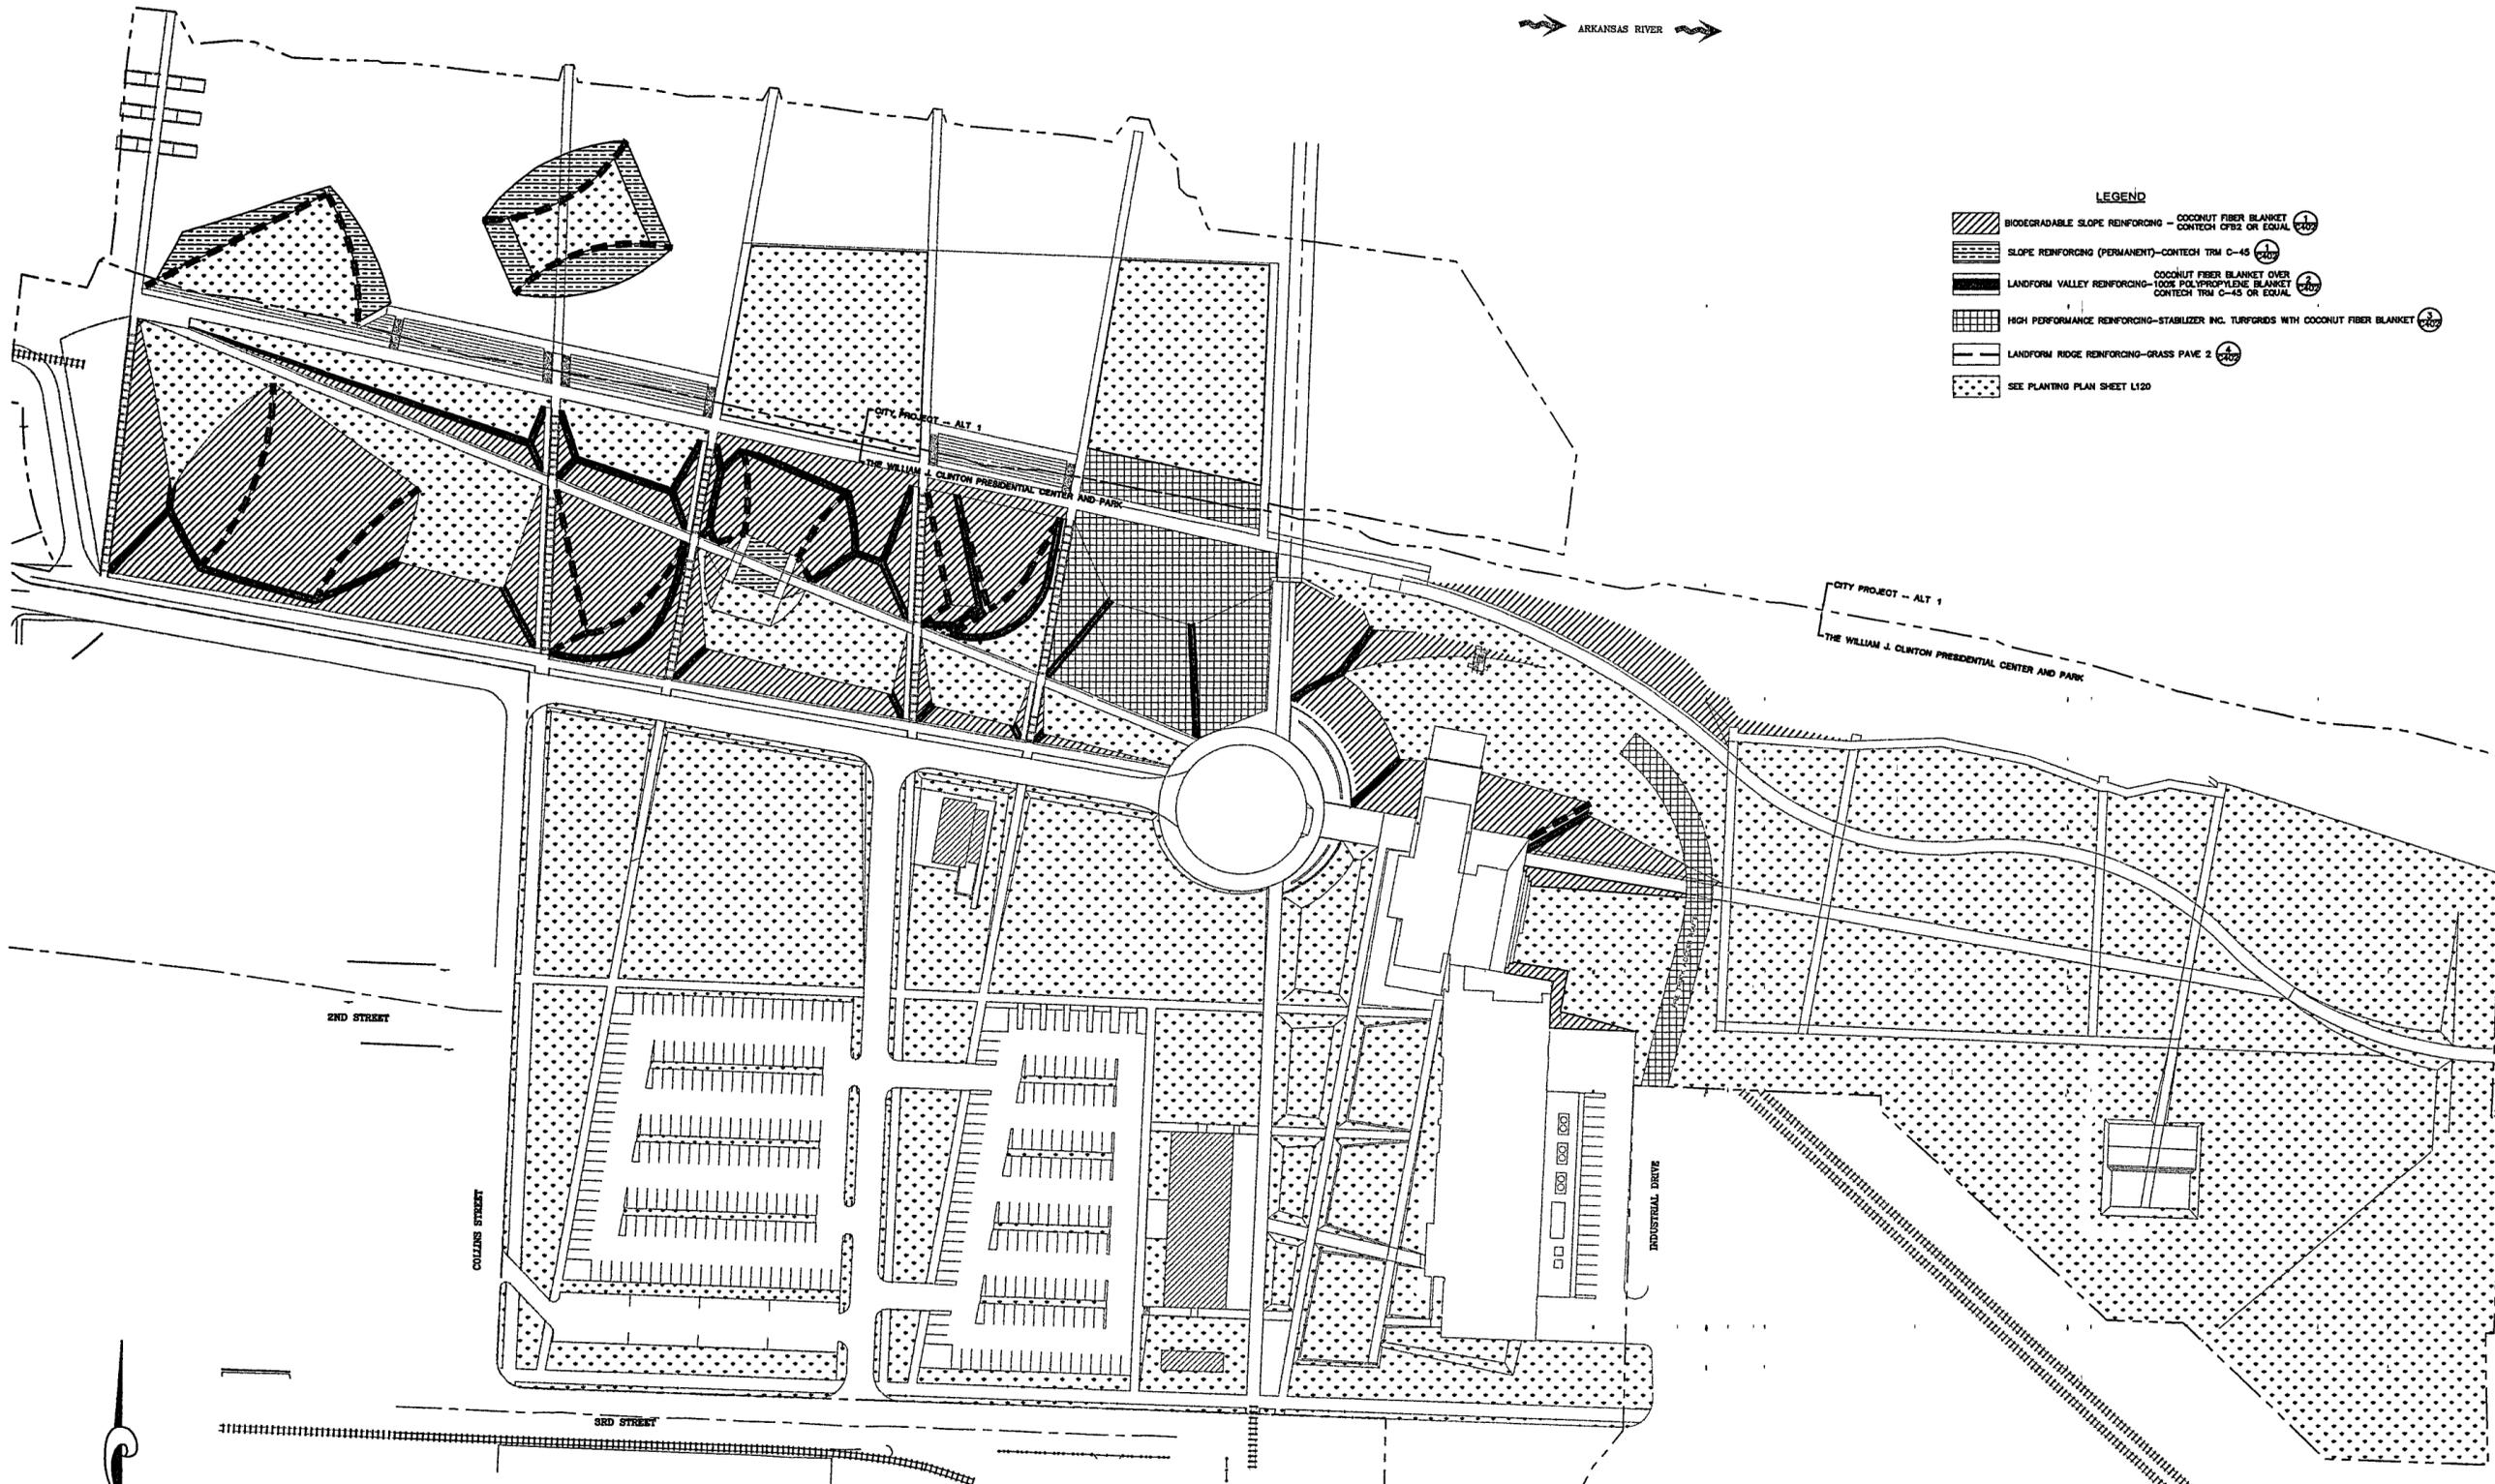

- LEGEND**
- BIODEGRADABLE SLOPE REINFORING - COCONUT FIBER BLANKET CONTECH CF82 OR EQUAL (1/200)
  - SLOPE REINFORING (PERMANENT)-CONTECH TRM C-45 (1/200)
  - COCONUT FIBER BLANKET OVER 100% POLYPROPYLENE BLANKET CONTECH TRM C-45 OR EQUAL (2/200)
  - HIGH PERFORMANCE REINFORING-STABILIZER INC. TURFGRIDS WITH COCONUT FIBER BLANKET (3/200)
  - LANDFORM RIDGE REINFORING-GRASS PAVE 2 (1/200)
  - SEE PLANTING PLAN SHEET L120


- GENERAL DRAINAGE NOTES:**
1. THE CONTRACTOR IS REQUIRED TO NOTIFY THE ONE CALL CENTER AT 1-800-482-8998 48 HOURS PRIOR TO DIGGING IN ORDER THAT UNDERGROUND UTILITIES IN THE AREA CAN BE LOCATED.
  2. THE LOCATION OF KNOWN SUBSURFACE STRUCTURES, PIPE, POWER, GAS, PHONE, ETC. ARE SHOWN ON THE PLANS. THE CONTRACTOR SHALL BE RESPONSIBLE FOR OBTAINING INFORMATION AND SATISFYING HIMSELF AS TO THE LOCATION OF THE AFORESAID STRUCTURES, SHOWN AND NOT SHOWN. ALL REPAIRS OR RELOCATION'S NECESSARY SHALL BE MADE AS REQUIRED BY THE OWNER OF THE UTILITY OR STRUCTURE. THE COST OF SUCH REPAIRS OR RELOCATION'S NECESSARY SHALL BE BORNE BY THE CONTRACTOR.
  3. CONTRACTOR TO COMPLY WITH ARKANSAS TRENCH EXCAVATION AND SAFETY REQUIREMENTS.
  4. PROPOSED GRADE DATA SHOWN HERE TO ON THESE PLANS ARE FROM A DIGITAL FILE PROVIDED BY HARGREAVES ASSOCIATES, 118 MAGAZINE STREET, CAMBRIDGE, MA 02138.
  5. PROPOSED GRADES ARE SHOWN FOR REFERENCE AND MUST BE CONFIRMED WITH GRADING PLAN, SHEETS L102-L107 THIS DRAWING SET.
  6. EXTREME CARE MUST BE TAKEN FOR ALL WORK NEAR THE LITTLE ROCK WASTE WATER UTILITY 54" SANITARY SEWER MAIN. EXCAVATION NEAR THE 54" MAIN SHALL NOT EXPOSE MORE THAN ONE JOINT (APPROX. 16') AT ONE TIME. COORDINATE ALL WORK WITH LITTLE ROCK WASTEWATER UTILITY.
  7. REFER TO TRENCHING DETAILS FOR VARIOUS EMBEDMENT TYPES.
  8. PERFORATED AND TURF SUBSURFACE DRAINAGE SHALL HAVE POSITIVE SLOPE AND CONNECT INLET BOX AS INDICATED ON PLANS.

1" = 60'-0" 0 20 40 60 120FT

**WILLIAM J CLINTON PRESIDENTIAL CENTER & PARK**

LITTLE ROCK, ARKANSAS

Architect  
POLSHEK PARTNERSHIP LLP  
320 West 13th Street  
New York, New York 10014  
212 607 7171

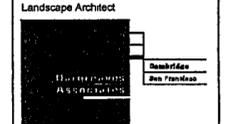

118 Magazine Street  
Cambridge, Massachusetts 02139  
617 661 0070  
617 661 0064

Coordinating Landscape Architect  
LANDSCAPE ARCHITECTURE, INC  
2300 Cotnam Lane, Suite 202  
Little Rock, Arkansas 72202  
501 374 5610

Civil Engineer  
McCLELLAND CONSULTING ENGINEERS  
900 W Markham Street  
Little Rock, Arkansas 72201  
501 371 0272


Electrical Engineer  
CROMWELL ARCHITECTS ENGINEERS  
101 South Spring Street  
Little Rock, Arkansas 72201  
501 372 2800

Manne + Structural Engineers  
MOFFATT & NICHOL ENGINEERS  
1019 East Hillbrook Road, Suite 150  
Raleigh, North Carolina 27609  
919 781 4626


Fountain  
DAN EUSER WATERARCHITECTURE INC.  
58 Mackenzie Drive West  
Richmond Hill, Ontario L4C 3E2  
CANADA  
905 884 4178

Playground Design  
PLAY SITE ARCHITECTURE  
7 Farway Road  
Acton, Massachusetts 01720  
978 263 1090

Signage Design  
POULIN + MORRIS  
280 Spring Street, Sixth Floor  
New York, New York 10013  
212 675 1332

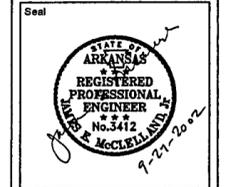

Issue	Date
04 100% Site Package 2 CD	08/27/02
03 90% Site Package 2 CD	08/16/02
02 80% Site Package 2 CD	08/29/02
01 100% Design Development	04/01/02

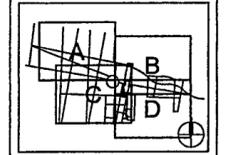

Job No PPA 9905  
HA\_CPC0101

Scale 1" = 60'-0"

Date SEPTEMBER 27, 2002

Title SITE PACKAGE 2  
100% CONSTRUCTION DOCUMENTS  
SLOPE STABILIZATION PLAN

Sheet No

**C401**

FOR OFFICIAL USE ONLY