



PLAN

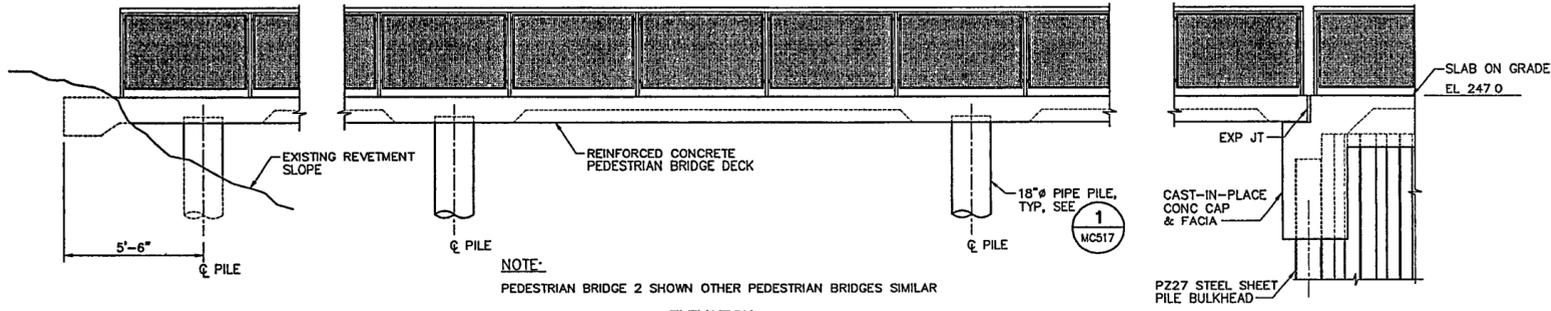


ELEVATION

1 TYPICAL PEDESTRIAN BRIDGE
3/8" = 1'-0"


NOTE:
PEDESTRIAN BRIDGE 2 SHOWN OTHER PEDESTRIAN BRIDGES SIMILAR

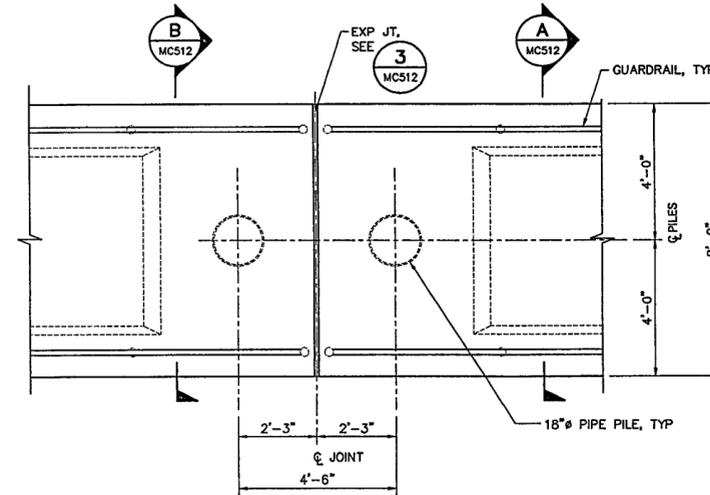

2 PEDESTRIAN BRIDGE 1 JOINT DETAIL
1/2" = 1'-0"

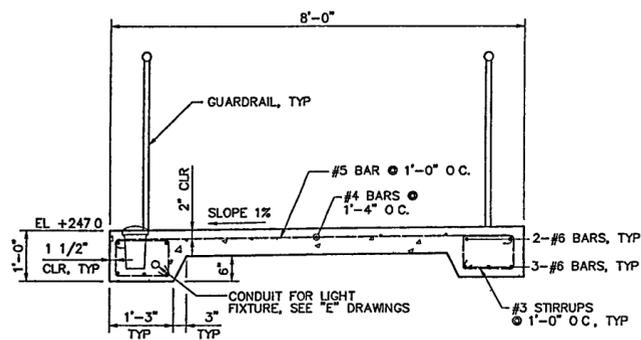


A SECTION
3/4" = 1'-0"

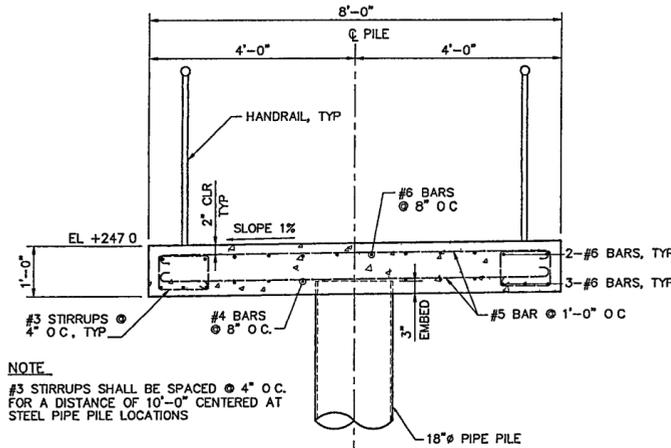


B SECTION
3/4" = 1'-0"


NOTE:
#3 STIRRUPS SHALL BE SPACED @ 4" O.C. FOR A DISTANCE OF 10'-0" CENTERED AT STEEL PIPE PILE LOCATIONS

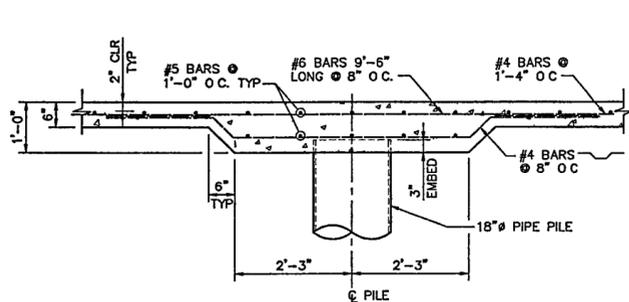


C SECTION
3/4" = 1'-0"

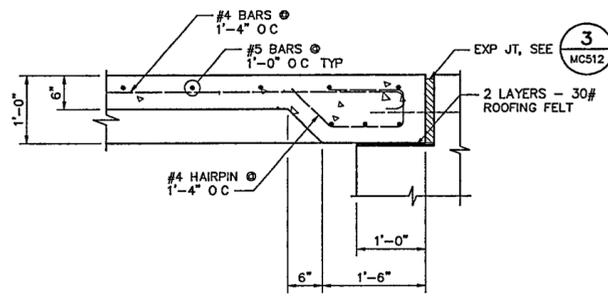

D SECTION
1" = 1'-0"

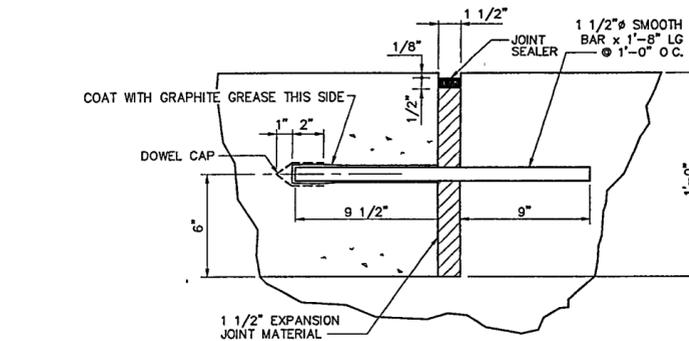

3 PEDESTRIAN BRIDGE EXPANSION JOINT DETAIL
NTS

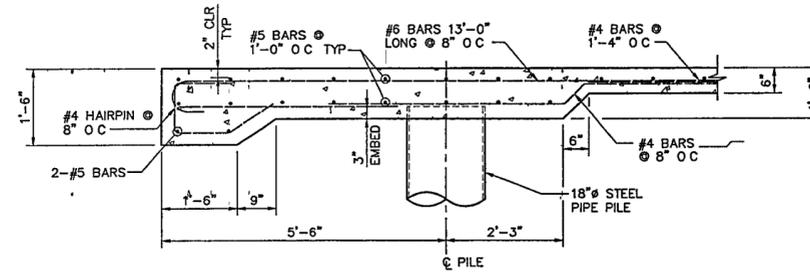

E SECTION
3/4" = 1'-0"

**WILLIAM J. CLINTON
PRESIDENTIAL
CENTER & PARK**

LITTLE ROCK, ARKANSAS

Architect
POLSHEK PARTNERSHIP LLP
320 West 13th Street
New York, New York 10014
212.607.7171

Landscape Architect



118 Magazine Street
Cambridge, Massachusetts 02139
617.661.0070
617.661.0084

Coordinating Landscape Architect
LANDSCAPE ARCHITECTURE, INC.
2300 Colsonville Lane, Suite 202
Little Rock, Arkansas 72202
501.374.5810

Civil Engineer
McCLELLAND CONSULTING ENGINEERS
900 W Markham Street
Little Rock, Arkansas 72201
501.371.0272


Electrical Engineer
CROMWELL ARCHITECTS ENGINEERS
101 South Spring Street
Little Rock, Arkansas 72201
501.372.2500

Marine + Structural Engineers
MOFFATT & NICHOL ENGINEERS
1616 East Millbrook Road, Suite 160
Raleigh, North Carolina 27609
919.781.4626


Fountain
DAN ELZER WATERARCHITECTURE INC
58 Mackenzie Drive West
Richmond Hill, Ontario L4C 3S2
CANADA
905.884.4176

Playground Design
PLAY SITE ARCHITECTURE
7 Fairway Road
Acton, Massachusetts 01720
978.263.1090

Signage Design
POULIN + MORRIS
288 Spring Street, Sixth Floor
New York, New York 10013
212.675.1332

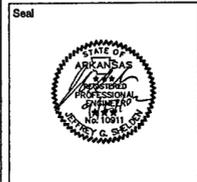

Issue	Date
04 100% Site Package 2 CD	09/27/02
03 90% Site Package 2 CD	08/16/02
02 80% Site Package 2 CD	08/29/02
01 100% Design Development	04/01/02

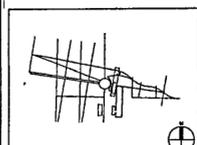

Job No. 4813

Scale AS SHOWN

Date SEPTEMBER 27, 2002

Title **SITE PACKAGE 2**
100% CONSTRUCTION DOCUMENTS
Pedestrian Bridges
Details

Sheet No.

MC512

FOR OFFICIAL USE ONLY