

4 1/2" DEEP POOL WITH 1/4" DEPTH OVERFLOW ON ALL SIDES

CONCRETE COLLECTION TRENCH WITH 6" WIDE STAINLESS STEEL GRATE AND FRAME (DEPTH OF TRENCH VARIES ALONG LENGTH)


QUARZITE PAVER SIDEWALK FOR DETAIL SEE L500 SERIES

12" THICK CONCRETE CEILING SLAB WITH CAST IN PLACE PVC PIPES TO FEED WATER FROM COLLECTION TRENCH TO RESERVOIR FOR LOCATION AND DETAILS OF PIPE SEE WF SERIES MECHANICAL AND ELECTRICAL DRAWINGS

12" THICK CONCRETE RESERVOIR WALLS WITH STEEL REINFORCING

LENGTH OF PIPE EXTENDS TO BELOW OPERATING WATER LEVEL FOR RESERVOIR

12" THICK CONCRETE FLOOR SLAB WITH STEEL REINFORCING

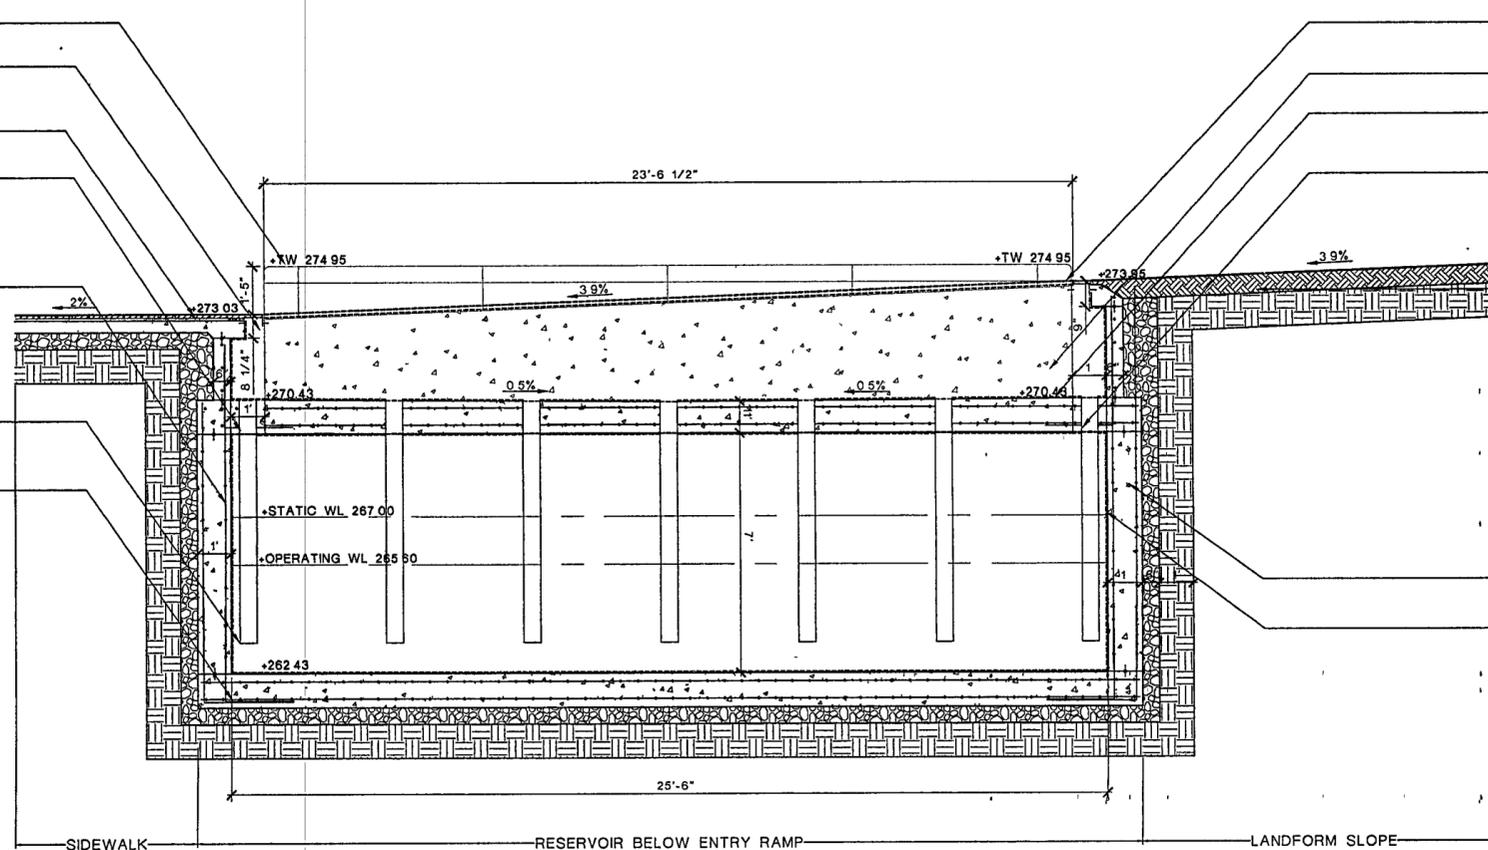

COLLECTION TRENCH WITH 6" WIDE STAINLESS STEEL TRENCH GRATE ABOVE RESERVOIR CEILING

CONCRETE WALL OF OVERFLOW POOL

0.5% SLOPE ON RESERVOIR CEILING WITH CENTRAL LOW POINT TO FEED WATER THROUGH PIPES

PVC PIPE CAST IN TO RESERVOIR CEILING AT INTERVALS ALONG LENGTH OF COLLECTION TRENCH FOR PIPING LOCATION AND DETAILS SEE WF SERIES MECHANICAL AND ELECTRICAL DRAWINGS

LANDFORM SLOPE WITH GROUND COVER ADJACENT TO TRENCH

ALL FOUNTAIN CONCRETE TO CONTAIN ZYPEX WATERPROOFING ADMIXTURE SEE SPECIFICATION FOR DETAILS


ALL FOUNTAIN CONCRETE HAVE SURFACE APPLIED BLACK ZYPEX CEMENTITIOUS CRYSTALLINE WATERPROOFING SEE SPECIFICATION FOR DETAILS

2 RESERVOIR AND COLLECTION TRENCH DETAIL
SCALE 1/2" = 1' - 0"

CONCRETE PAVERS ON CONCRETE SLAB WITH MORTAR SETTING BED FOR DETAIL SEE L500 SERIES

COMPACTED AGGREGATE SETTING BED DEPTH VARIES (MIN 24")

CONCRETE RESERVOIR CEILING WITH STEEL REINFORCING

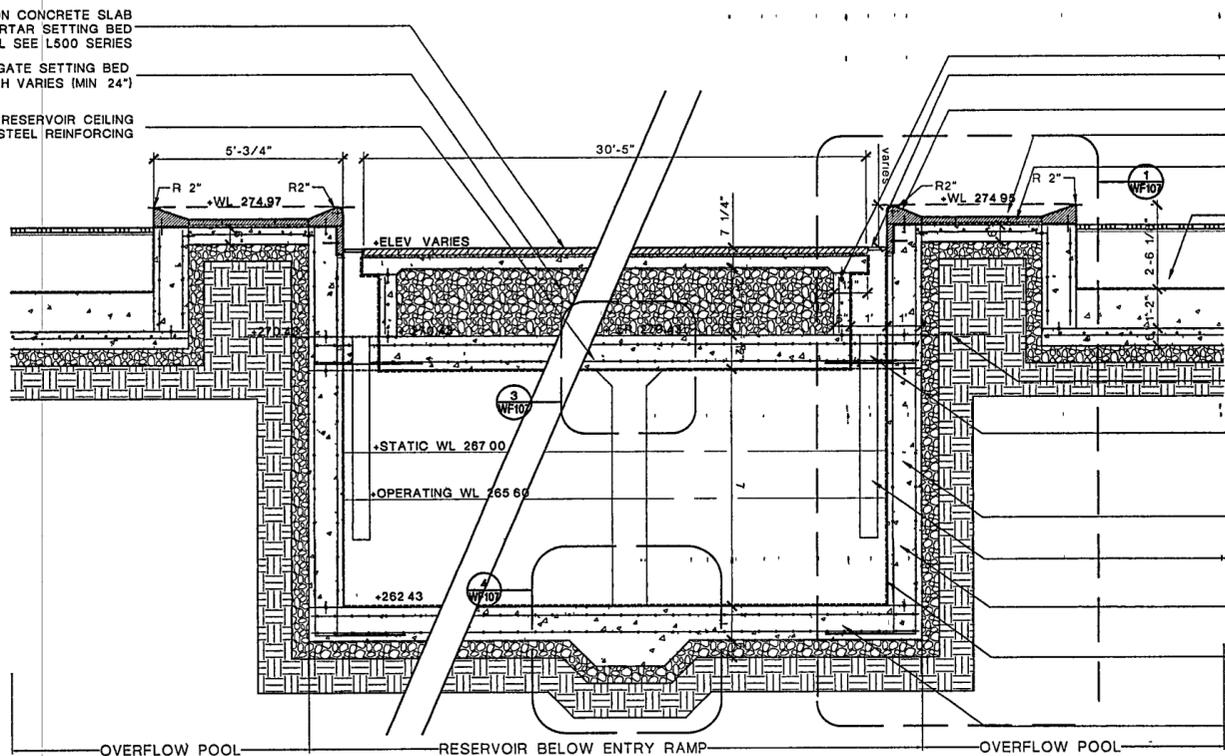

6" WIDE CONCRETE WALL TO TRENCH

6" WIDE STAINLESS STEEL TRENCH GRATE AND FRAME

GRANITE OVERFLOW WALL (HEIGHT VARIES)

4 1/2" DEEP POOL WITH 1/4" DEPTH OVERFLOW

18"X18"X2" BLACK GRANITE PAVERS ON PEDESTALS 1/2" OPEN JOINTS TO ALLOW WATER INTO POOL

18" WIDE TRENCH WITH OVERFLOW EDGE ONE ROW ANIMATED 1/2" FINGER JETS 9" ON CENTER AND SINGLE ROW OF LOW VOLTAGE LIGHTS. FOR LOCATIONS & DETAILS SEE WF SERIES MECHANICAL AND ELECTRICAL DRAWINGS

LEVEL OF ADJACENT WATER TRENCH AT CORNER OF RESERVOIR BEYOND

PVC PIPE CAST IN PLACE IN RESERVOIR CEILING TO FEED WATER FROM TRENCH INTO RESERVOIR FOR LOCATION AND DETAILS SEE WF SERIES MECHANICAL AND ELECTRICAL DRAWINGS

12" WIDE CONCRETE RESERVOIR WALL WITH STEEL REINFORCING

LENGTH OF PIPE EXTENDS TO BELOW OPERATING WATER LEVEL IN RESERVOIR

ALL FOUNTAIN CONCRETE TO CONTAIN ZYPEX WATERPROOFING ADMIXTURE SEE SPECIFICATION FOR DETAILS

ALL FOUNTAIN CONCRETE HAVE SURFACE APPLIED BLACK ZYPEX CEMENTITIOUS CRYSTALLINE WATERPROOFING SEE SPECIFICATION FOR DETAILS

12" THICK CONCRETE FLOOR SLAB WITH STEEL REINFORCING

1 RESERVOIR AND COLLECTION TRENCH DETAIL
SCALE 1/2" = 1' - 0"

WILLIAM J. CLINTON
PRESIDENTIAL
CENTER & PARK

LITTLE ROCK, ARKANSAS

Architect
POLSHEK PARTNERSHIP LLP
320 West 13th Street
New York, New York 10014
212 807 7171

Landscape Architect
HARGREAVES ASSOCIATES
Cambridge
San Francisco

HARGREAVES ASSOCIATES
118 Magazine Street
Cambridge, Massachusetts 02139
617 681 0070 t
617 681 0084 f

Coordinating Landscape Architect
LANDSCAPE ARCHITECTURE, INC
2300 Cottondale Lane, Suite 202
Little Rock, Arkansas 72202
501 374 5610

Civil Engineer
McLELLAND CONSULTING ENGINEERS
900 W Markham Street
Little Rock, Arkansas 72201
501 371 0272

Electrical Engineer
CROMWELL ARCHITECTS ENGINEERS
101 South Spring Street
Little Rock, Arkansas 72201
501 372-2900

Marine + Structural Engineers
MOFFATT & NICHOL ENGINEERS
1616 East Millbrook Road, Suite 160
Raleigh, North Carolina 27609
919 781 4628


Fountain
DAN EUSER WATERARCHITECTURE INC
58 Mackenzie Drive West
Richmond Hill, Ontario L4C 3S2
CANADA
905 884.4176

Playground Design
PLAY SITE ARCHITECTURE
7 Fairway Road
Acton, Massachusetts 01720
978.263 1090

Signage Design
POULIN + MORRIS
288 Spring Street, Sixth Floor
New York, New York 10013
212 675 1332



Issue	Date
03 100% Site Package 2 CD	09/27/02
02 90% Site Package 2 CD	08/16/02
01 80% Site Package 2 CD	08/29/02

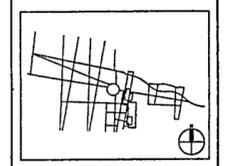

Job No PPA 8908
HA CPC0101

Scale AS NOTED

Date SEPTEMBER 27, 2002

Title SITE PACKAGE 2
100% CONSTRUCTION DOCUMENTS

POOL RESERVOIR
DETAILED SECTIONS

Sheet No
WF104

FOR OFFICIAL USE ONLY