


NOTES

- REFER TO THE STRUCTURAL DRAWING BOOK FOR GENERAL NOTES, TYPICAL DETAILS, SCHEDULES AND ALL REFERENCED DETAILS AND SECTIONS REFER TO S220 SERIES DRAWINGS FOR WALL ELEVATIONS AND REINFORCEMENT REFER TO EDGE OF SLAB DRAWINGS FOR SLAB EDGE LOCATIONS AND DIMENSIONS
- TOP OF CONCRETE IS AT REFERENCE ELEVATION -18'-0" (EL 258'), UNLESS OTHERWISE NOTED [XXX], WHERE XXX IS MEASURED WITH RESPECT TO REFERENCE ELEVATION
- TOP OF FOOTING/CAISSON CAP IS AT ELEVATION -20'-0" (EL 256'), UNLESS OTHERWISE NOTED AS [XXX], WHERE XXX IS MEASURED WITH RESPECT TO EL 0'
- FLOOR CONSTRUCTION IS 8" REINFORCED CONCRETE SLAB ON GROUND FOR THE ARCHIVE BUILDING AND 6" SLAB ON GROUND FOR THE MUSEUM BUILDING
- SEE CAISSON SCHEDULE FOR SIZE, REINFORCEMENT AND EMBEDMENT LENGTH
- TOP OF STRUCTURAL STEEL IS (-9") BELOW REFERENCE ELEVATION UNLESS OTHERWISE NOTED
- UNLESS OTHERWISE NOTED, CENTER OF SPREAD FOOTING/CAISSON CAP COINCIDES WITH THE CENTER OF COLUMN ABOVE
- CONCRETE STRENGTH AND WEIGHT
 CAISSONS & CAPS F'C = 4000 PSL NW
 FOOTINGS F'C = 3000 PSL NW
 SLABS ON GROUND F'C = 4000 PSL NW
 WALLS & COLUMNS F'C = 4000 PSL NW
- SB = ELEVATOR SEPARATOR BEAM, TS 6x4x5/16

REFERENCED NOTES

- SEE 7-2-18 FOR ADDITIONAL STEEL FRAMING IN CONCRETE CORES
- COORDINATE INSTALLATION OF TANKS/SUMPS WITH BACKFILLING AND CASTING OF SLAB OPERATIONS
- PROVIDE ELEVATOR RAIL SUPPORT SEE 7-1-32 FOR ELEVATIONS COORDINATE POSITIONS AND SPACING WITH ELEVATOR CONTRACTOR
- FOR STAIR DIMENSIONS, REFER TO ARCHITECTURAL DRAWINGS
- EXPOSED STEEL IS ARCHITECTURALLY EXPOSED STRUCTURAL STEEL (AESS)

A PART PLAN - PIER 4
STAIRS NOT SHOWN REFER TO S210 FOR INFORMATION

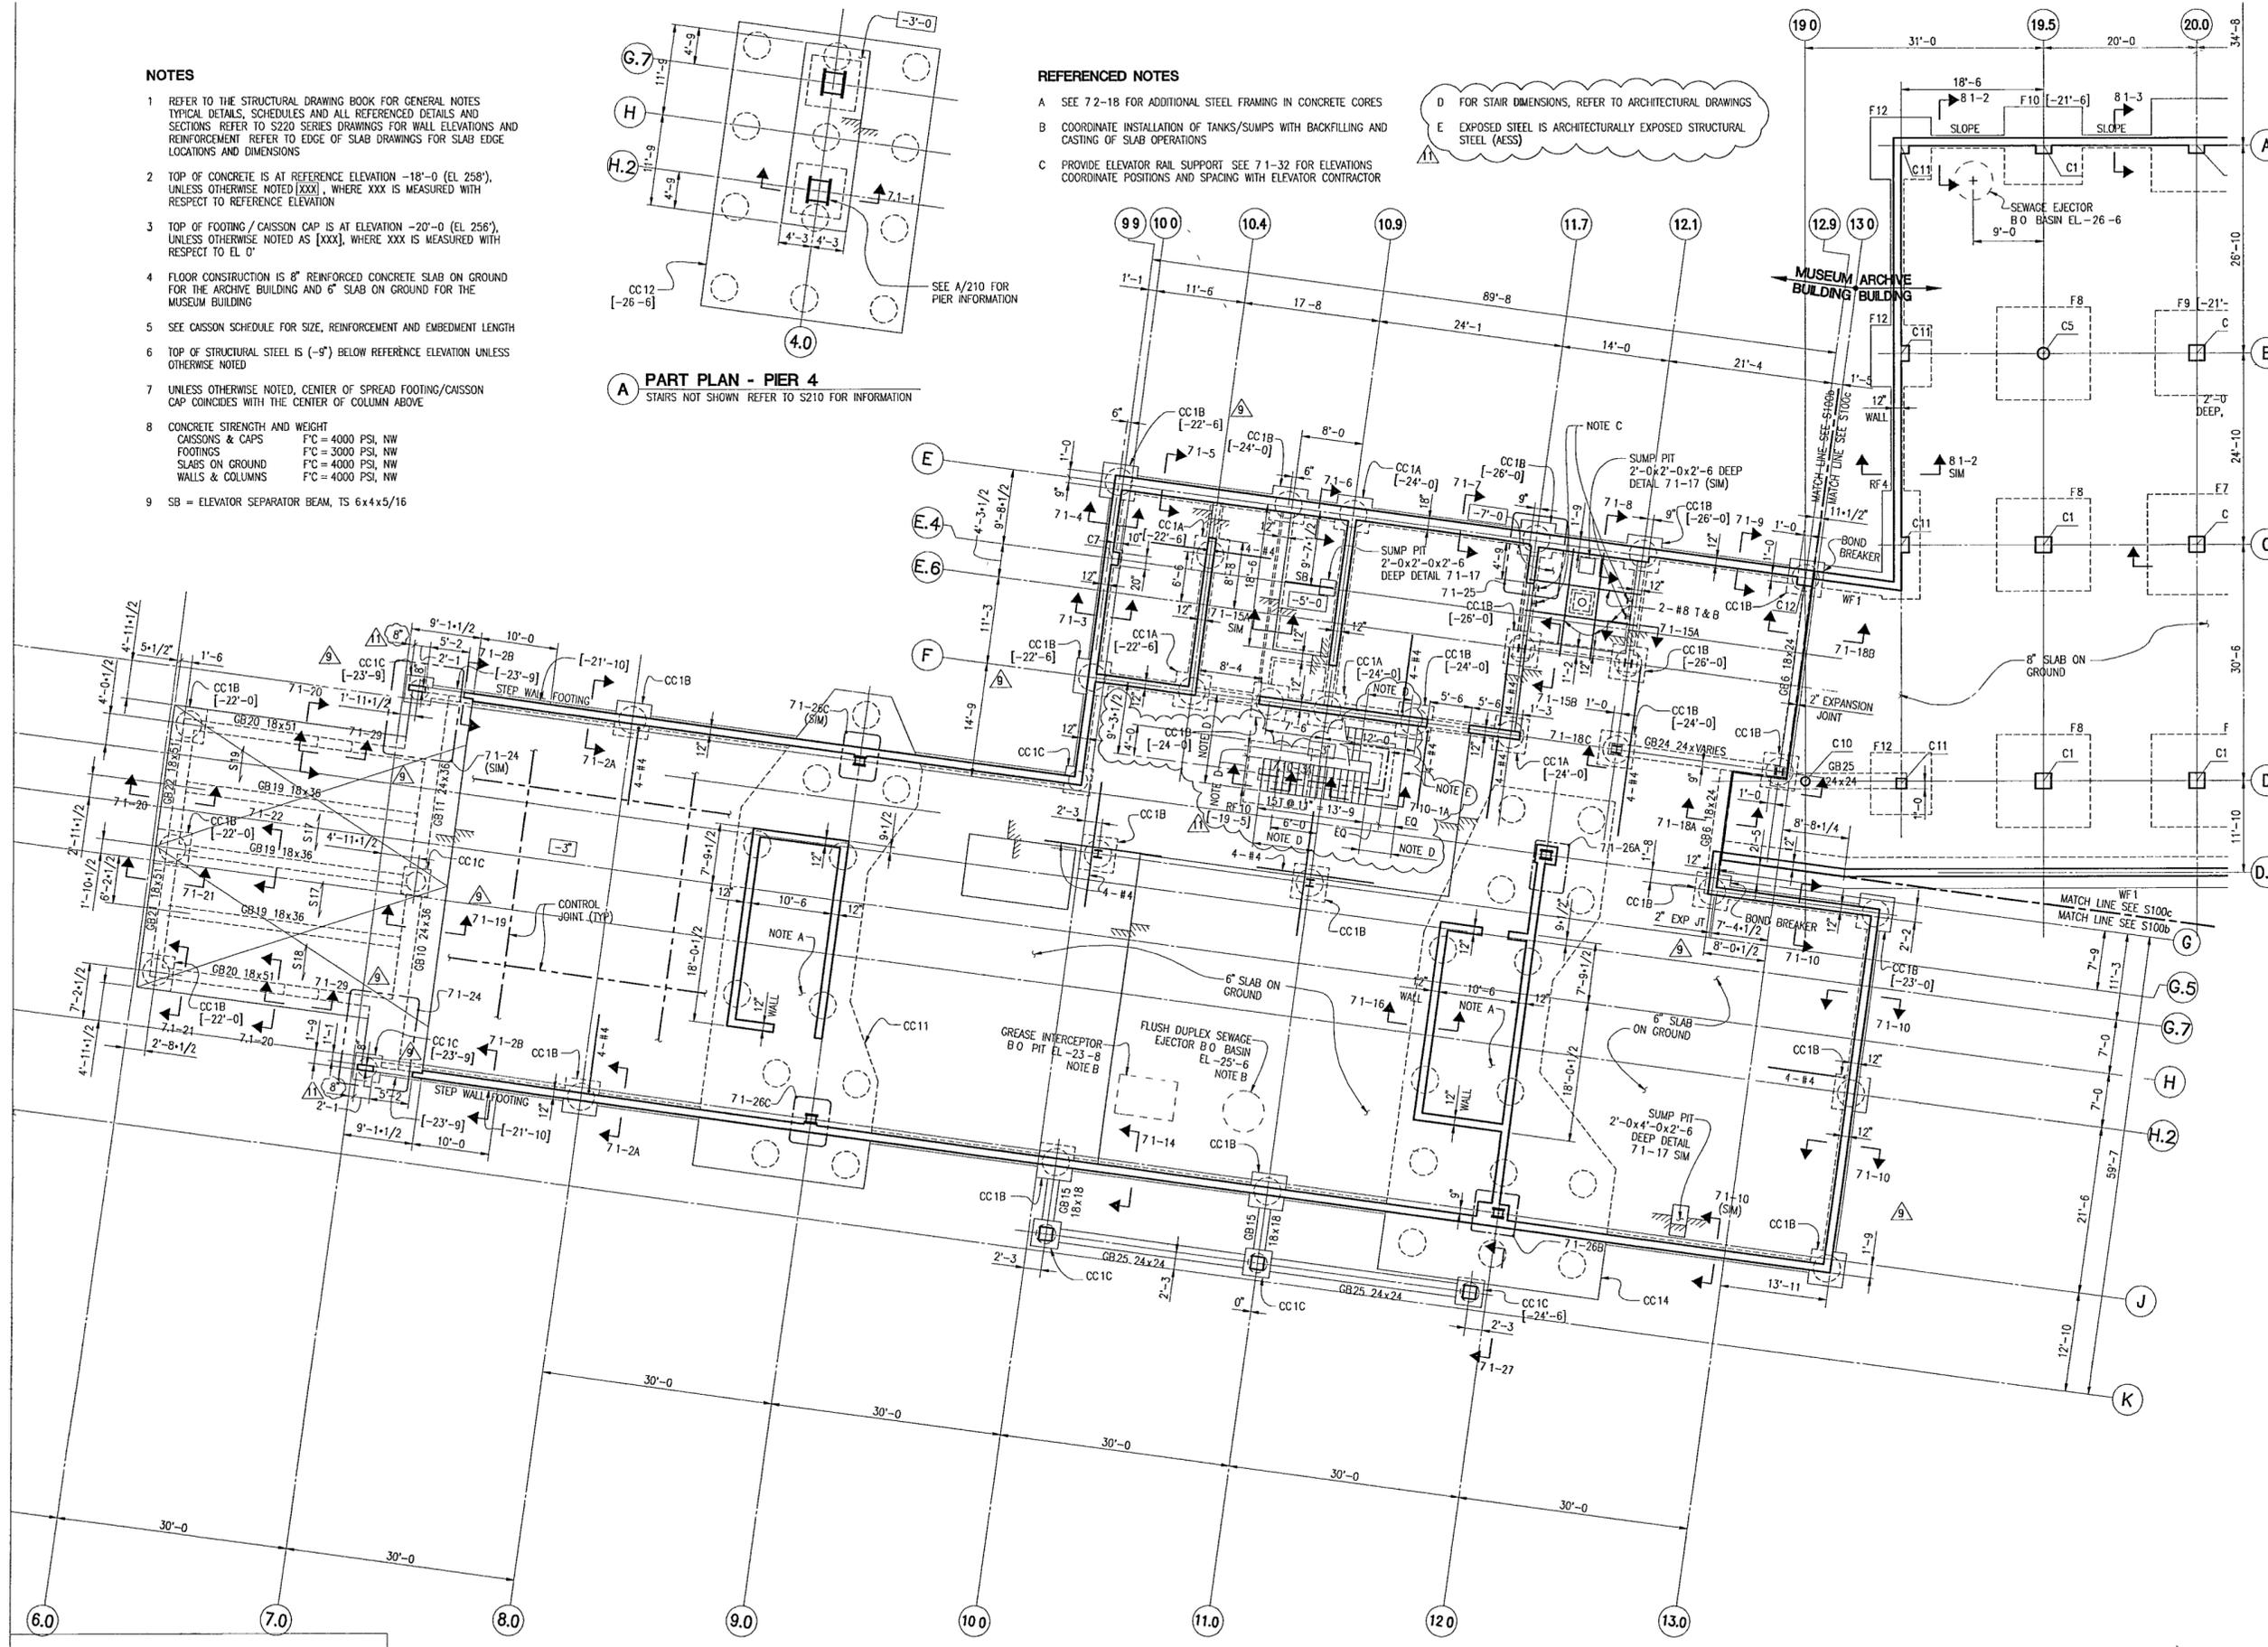

**WILLIAM J. CLINTON
PRESIDENTIAL
CENTER**

LITTLE ROCK, ARKANSAS

Architect
 POLSHEK PARTNERSHIP LLP
 320 West 13th Street
 New York, New York 10014
 212.697.7171

Coordinating Architects
 POLK STANLEY YEARY ARCHITECTS LTD
 700 South Schiller Street
 Little Rock, Arkansas 72201
 501.378.0878

WITSELL EVANS RASCO
 301 West Third Street
 Little Rock, Arkansas 72201
 501.374.6300

WOODS CARADINE ARCHITECTS
 2200 South Main Street
 Little Rock, Arkansas 72206
 501.374.4080

Landscape Architects
 HARGREAVES ASSOCIATES
 118 Magazine Street
 Cambridge, Massachusetts 02139
 617.661.0070

LANDSCAPE ARCHITECTURE, Inc.
 2300 Cottondale Lane Suite 202
 Little Rock, Arkansas 72202
 501.374.5610

Structural Engineer
 LESLIE E. ROBERTSON ASSOC., RLLP
 30 Broad Street, 47th Floor
 New York, New York 10004
 212.750.9200


MEP Engineers
 FLACK + KURTZ Inc.
 475 Fifth Avenue
 New York, New York 10017
 212.532.9500

CRONWELL ARCHITECTS ENGINEERS
 101 South Spring Street
 Little Rock, Arkansas 72201
 501.372.2900

Curtilwall Consultant
 R. A. HEINTGES ARCHITECTS
 126 Fifth Avenue, 9th Floor
 New York, New York 10011
 212.652.2968

Seal

11	100% CONSTRUCTION DOCS	09/27/02
10	90% PROGRESS PRINTING	08/30/02
9	SFS-10	08/20/02
8	100% STRUCTURAL CD	07/01/02
7	100% CD MUSEUM BLDG	06/14/02
SUBSTRUCTURE PACKAGE		
6	100% STL & CONC CD	05/15/02
5	CD PRE-RELEASE	05/01/02
4	BUILDING DEPT	03/18/02
3	BID ISSUE	03/01/02
2	75% DESIGN DEVEL	01/25/02
1	50% DESIGN DEVEL	12/19/01
Issue		Date

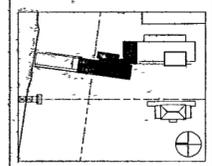

Job No. 1 8908
 Scale 1/8"=1'-0"
 Date DEC 11, 2001
 Title

**FOUNDATION AND
BASEMENT LEVEL
PLAN**

Sheet No. **S100b**

© Copyright LESLIE E. ROBERTSON ASSOCIATES, R.L.L.P.
WARNING IT IS A VIOLATION OF LAW FOR ANY PERSON UNLESS ACTING UNDER THE DIRECTION OF A PROFESSIONAL LICENSED IN THE STATE OF THIS PROJECT, TO ALTER IN ANY WAY THESE DRAWINGS WHERE ANY ITEM IS ALTERED, THE SUPERVISING PROFESSIONAL SHALL AFFIX TO THE ITEM HIS SEAL AND THE DESCRIPTION "ALTERED BY" FOLLOWED BY HIS SIGNATURE, THE DATE, AND A SPECIFIC DESCRIPTION OF THE ALTERATION

**WILLIAM J CLINTON
PRESIDENTIAL
CENTER**

LITTLE ROCK, ARKANSAS

Architect
POLSHAK PARTNERSHIP LLP
320 West 13th Street
New York, New York 10014
212.607.7171

Coordinating Architects
POLK STANLEY YEARY ARCHITECTS Ltd
700 South Schafer Street
Little Rock, Arkansas 72201
501.378.0878

WITSELL EVANS RASCO
901 West Third Street
Little Rock, Arkansas 72201
501.374.5300

WOODS CARADINE ARCHITECTS
2200 South Main Street
Little Rock, Arkansas 72206
501.374.4060

Landscape Architects
HARGREAVES ASSOCIATES
118 Magazine Street
Cambridge, Massachusetts 02139
617.681.0070

LANDSCAPE ARCHITECTURE Inc.
2300 Cottondale Lane Suite 202
Little Rock, Arkansas 72202
501.374.5810

Structural Engineer
LESLIE E. ROBERTSON ASSOC. RLLP
30 Broad Street, 47th Floor
New York, New York 10004
212.750.9000


MEP Engineers
FLACK + KURTZ Inc.
475 Fifth Avenue
New York, New York 10017
212.532.9600

CROMWELL ARCHITECTS ENGINEERS
161 South Spring Street
Little Rock, Arkansas 72201
501.372.2900

Curtainwall Consultant
R. A. HENTGES ARCHITECTS
128 Fifth Avenue, 9th Floor
New York, New York 10011
212.652.2968

Seal

Issue	Date
10 100% CONSTRUCTION DOCS	09/27/02
9 SFS-14	09/12/02
8 90% PROGRESS PRINTING	08/30/02
7 SFS-4 (RFI # 103)	07/30/02
6 100% STRUCTURAL CD	07/01/02
5 100% STL & CONC CD	05/15/02
4 BUILDING DEPT	03/18/02
3 BID ISSUE	03/01/02
2 75% DESIGN DEVEL.	01/25/02
1 50% DESIGN DEVEL.	12/19/01

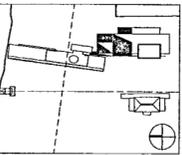

Job No 9908
Scale 1/8"=1'-0"
Date DEC 11, 2001
Title


**FOUNDATION AND
BASEMENT LEVEL
PLAN**

Sheet No
S100c

NOTES:

- REFER TO THE STRUCTURAL DRAWING BOOK FOR GENERAL NOTES TYPICAL DETAILS, SCHEDULES AND ALL REFERENCED DETAILS AND SECTIONS REFER TO S220 SERIES DRAWINGS FOR WALL ELEVATIONS AND REINFORCEMENT REFER TO SLAB EDGE DRAWINGS FOR SLAB EDGE LOCATIONS AND DIMENSIONS
- TOP OF CONCRETE IS AT REFERENCE ELEVATION -18'-0" (EL 258'), UNLESS OTHERWISE NOTED [XXX], WHERE XXX IS MEASURED WITH RESPECT TO REFERENCE ELEVATION
- TOP OF FOOTING IS AT ELEVATION -20'-0" (EL 256'), UNLESS OTHERWISE NOTED AS [XXX] WHERE XXX IS MEASURED WITH RESPECT TO EL 0'
- FLOOR CONSTRUCTION IS 8" REINFORCED CONCRETE SLAB ON GROUND
- UNLESS OTHERWISE NOTED, CENTER OF SPREAD FOOTING COINCIDES WITH THE CENTER OF COLUMN ABOVE

- CONCRETE STRENGTH AND WEIGHT
FOOTINGS F'C = 3000 PSL, NW
SLABS ON GROUND F'C = 4000 PSL, NW
WALLS & COLUMNS F'C = 4000 PSL, NW
- Ψ INDICATES INFORMATION TO BE PROVIDED BY OTHERS

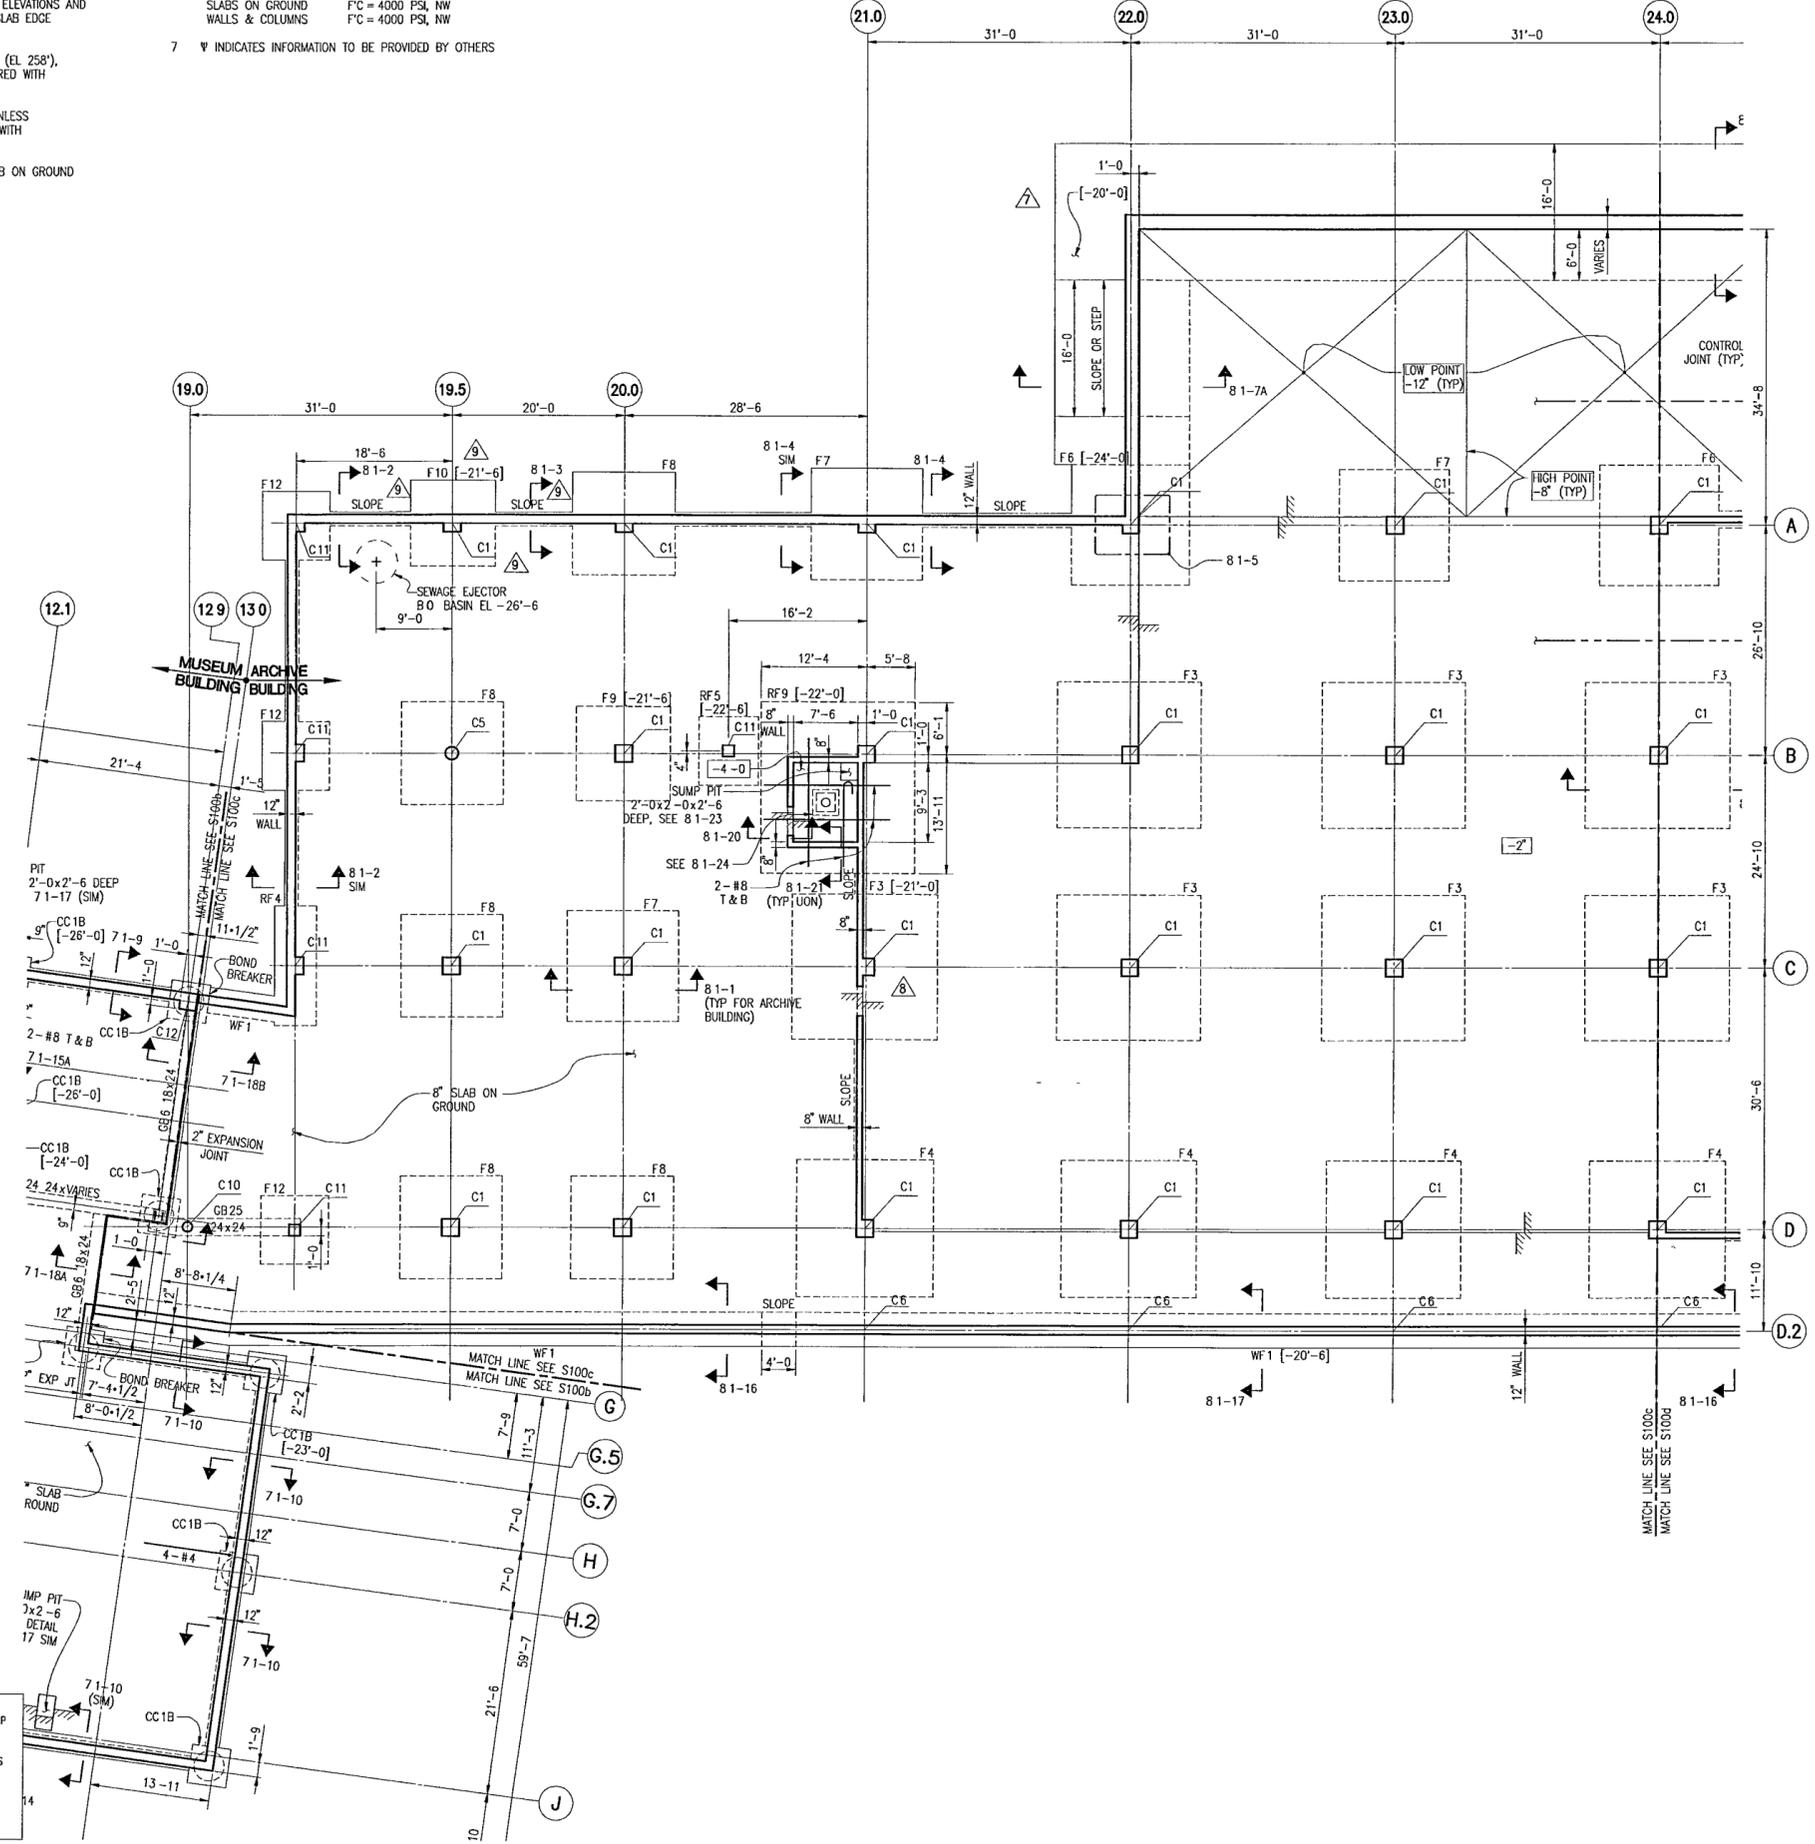

© Copyright LESLIE E. ROBERTSON ASSOCIATES, R.L.L.P.
WARNING IT IS A VIOLATION OF LAW FOR ANY PERSON, UNLESS ACTING UNDER THE DIRECTION OF A PROFESSIONAL LICENSED IN THE STATE OF THIS PROJECT TO ALTER IN ANY WAY THESE DRAWINGS WHERE ANY ITEM IS ALTERED THE SUPERVISING PROFESSIONAL SHALL AFFIX TO THE ITEM HIS SEAL AND THE INSCRIPTION ALTERED BY FOLLOWED BY HIS SIGNATURE, THE DATE, AND A SPECIFIC DESCRIPTION OF THE ALTERATION

**WILLIAM J CLINTON
PRESIDENTIAL
CENTER**

LITTLE ROCK, ARKANSAS

Architect
POLSHEK PARTNERSHIP LLP
320 West 13th Street
New York, New York 10014
212.607.7171

Coordinating Architects
POLK STANLEY YEARY ARCHITECTS LM
700 South Schiller Street
Little Rock, Arkansas 72201
501.378.0878

WITSELL EVANS RASCO
501 West Third Street
Little Rock, Arkansas 72201
501.374.6300

WOODS CARADINE ARCHITECTS
2200 South Main Street
Little Rock, Arkansas 72206
501.374.4060

Landscape Architects
HARGREAVES ASSOCIATES
118 Magazine Street
Cambridge, Massachusetts 02139
617.661.0070

LANDSCAPE ARCHITECTURE, Inc.
2300 Cottondale Lane Suite 202
Little Rock, Arkansas 72202
501.374.5610

Structural Engineer
LESLIE E. ROBERTSON ASSOC., RLLP
30 Broad Street, 47th Floor
New York, New York 10004
212.750.9000


MEP Engineers
FLACK + KURTZ Inc.
475 Fifth Avenue
New York, New York 10017
212.532.5600

CROMWELL ARCHITECTS ENGINEERS
101 South Spring Street
Little Rock, Arkansas 72201
501.372.2900

Curtilwall Consultant
R. A. HEINTGES ARCHITECTS
135 5th Avenue, 9th Floor
New York, New York 10011
212.652.2968

Seal



Issue	Date
9 100% CONSTRUCTION DOCS	09/27/02
8 SFS-14	09/12/02
7 90% PROGRESS PRINTING	08/30/02
6 100% STRUCTURAL CD	07/01/02
5 100% STA & CONC CD	05/15/02
4 BUILDING DEPT	03/18/02
3 BID ISSUE	03/01/02
2 75% DESIGN DEVEL.	01/25/02
1 50% DESIGN DEVEL.	12/19/01

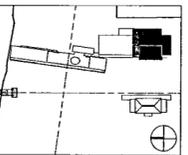

Job No 9908
Scale 1/8"=1'-0"
Date DEC 11, 2001
Title

**FOUNDATION AND
BASEMENT LEVEL
PLAN**

Sheet No **S100d**

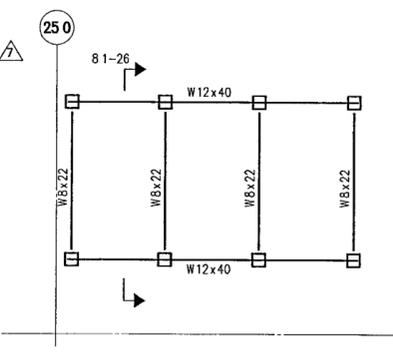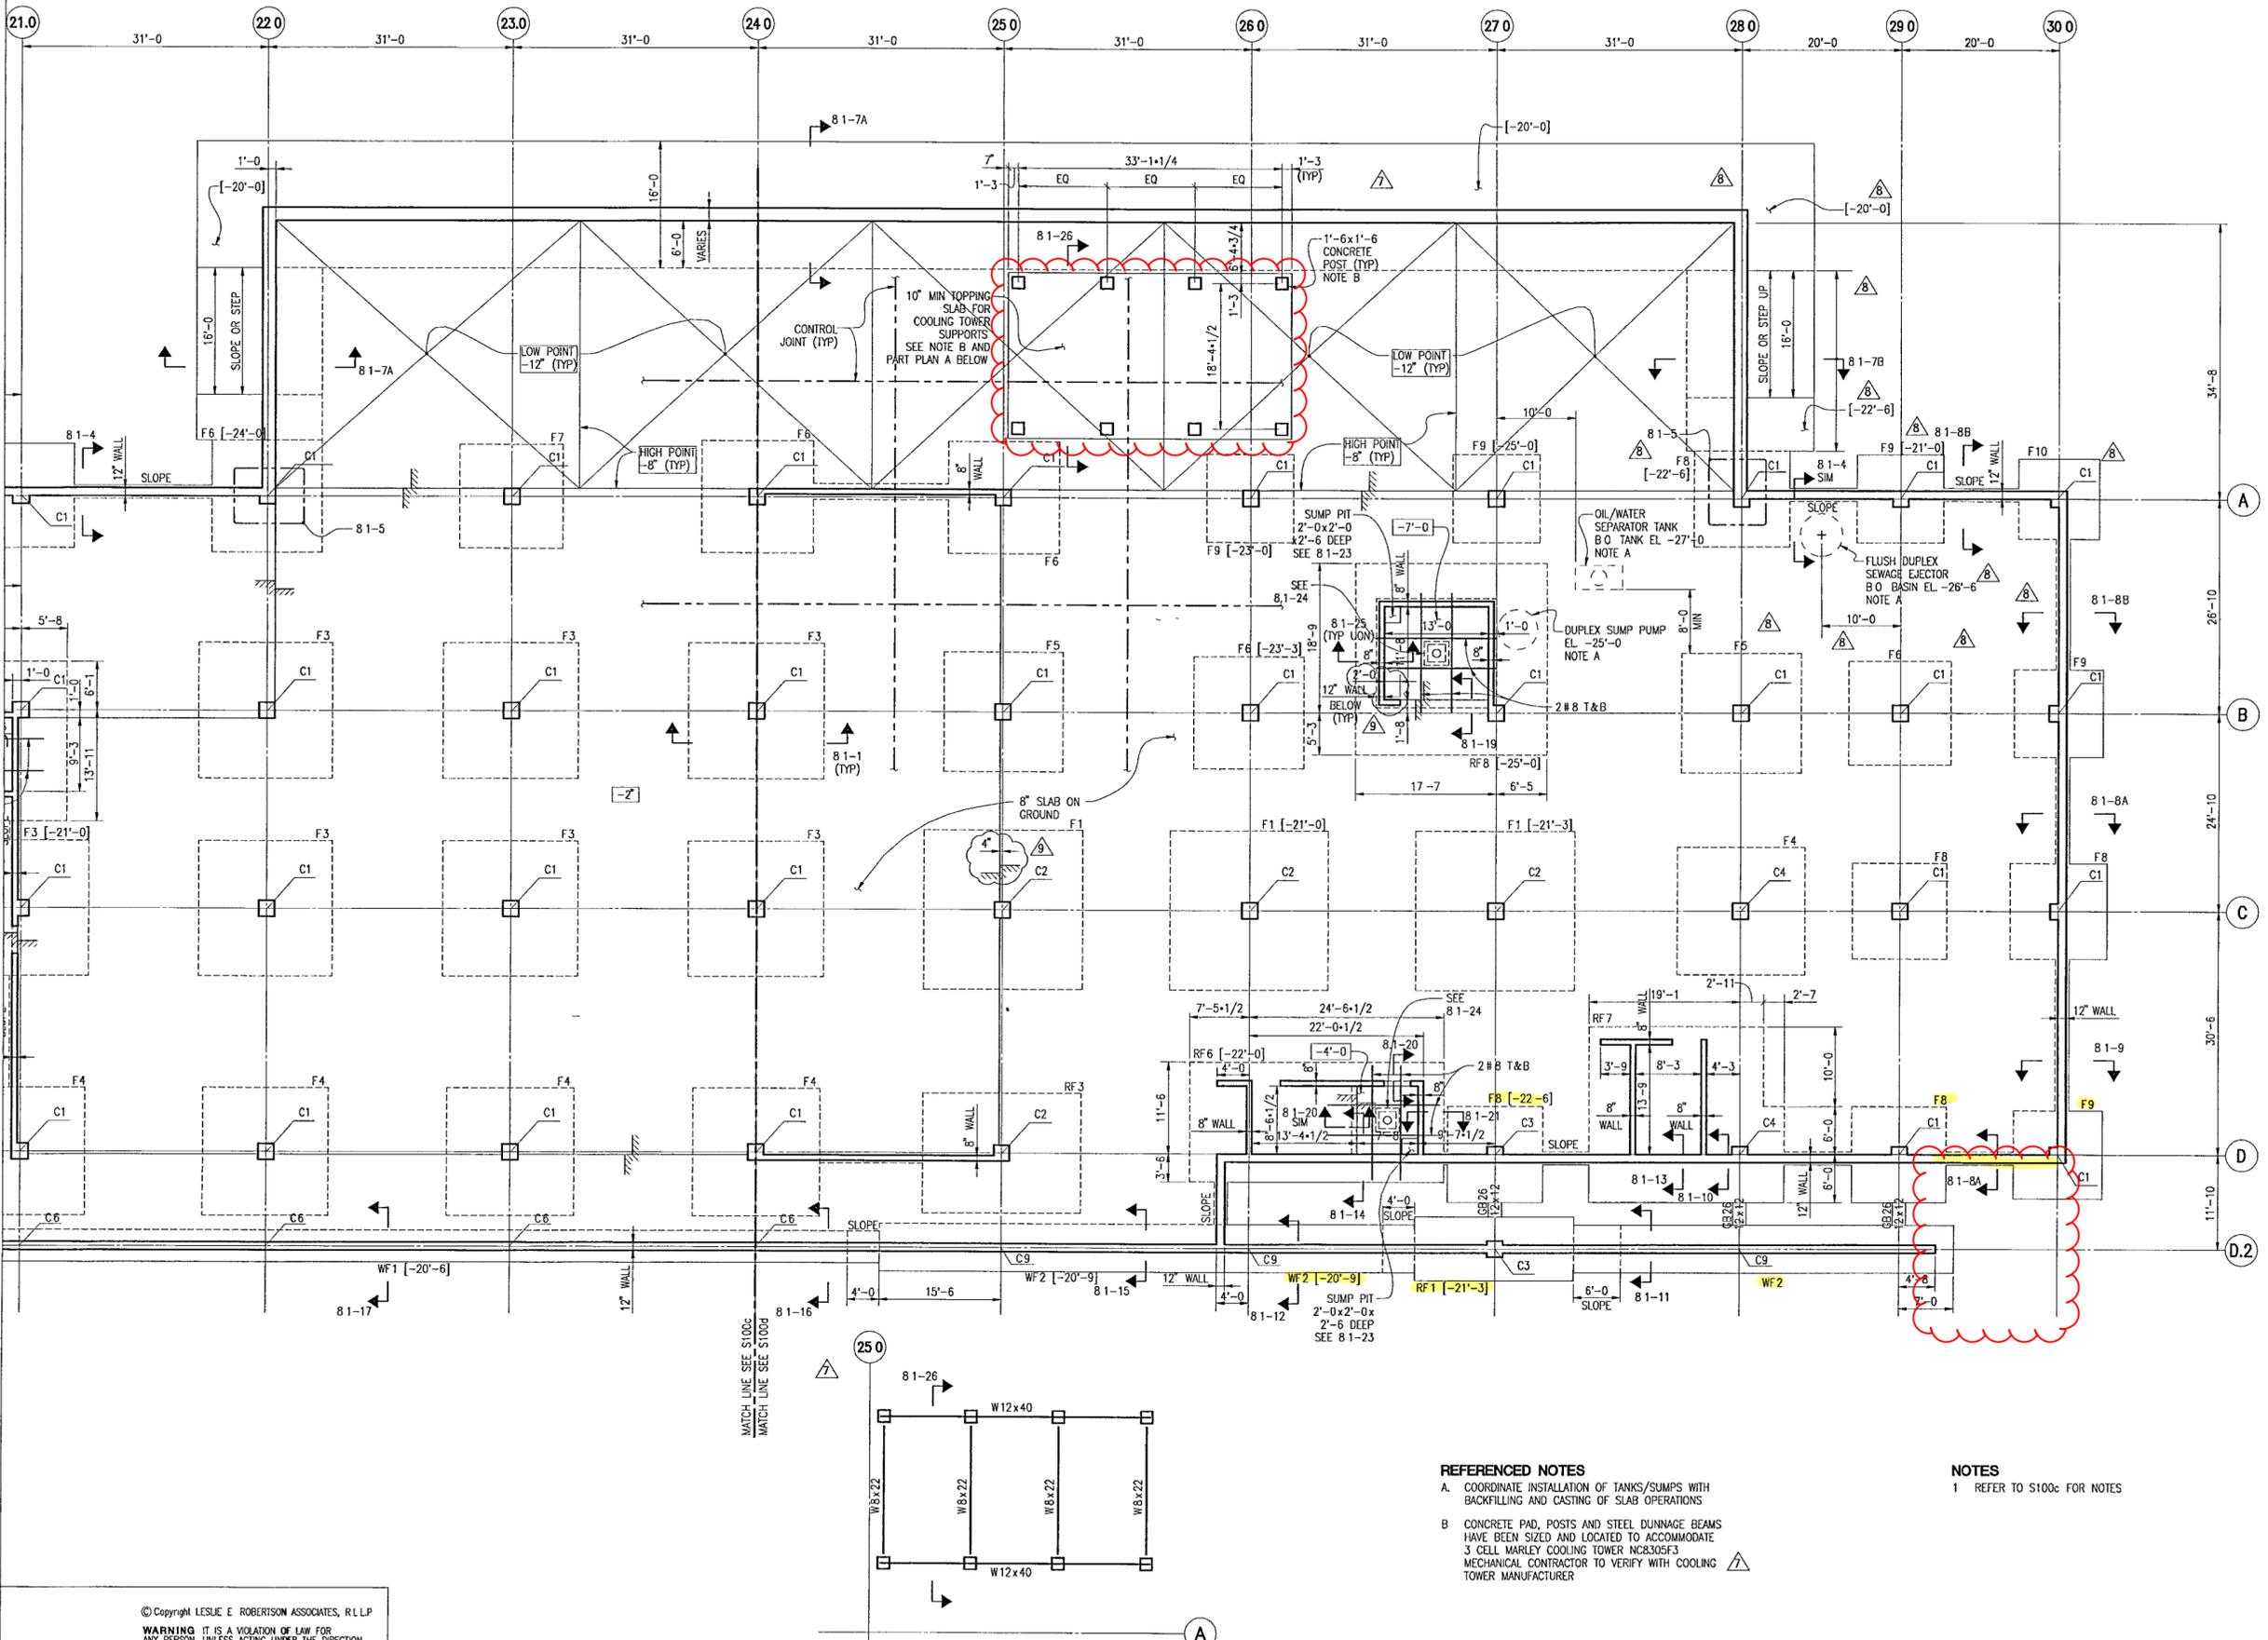

- REFERENCED NOTES**
- A. COORDINATE INSTALLATION OF TANKS/SUMPS WITH BACKFILLING AND CASTING OF SLAB OPERATIONS
 - B. CONCRETE PAD, POSTS AND STEEL DUNNAGE BEAMS HAVE BEEN SIZED AND LOCATED TO ACCOMMODATE 3 CELL MARLEY COOLING TOWER NC8305F3 MECHANICAL CONTRACTOR TO VERIFY WITH COOLING TOWER MANUFACTURER

- NOTES**
- 1 REFER TO S100c FOR NOTES

© Copyright LESLIE E. ROBERTSON ASSOCIATES, R.L.L.P.
WARNING IT IS A VIOLATION OF LAW FOR ANY PERSON UNLESS ACTING UNDER THE DIRECTION OF A PROFESSIONAL LICENSED IN THE STATE OF THIS PROJECT, TO ALTER IN ANY WAY THESE DRAWINGS WHERE ANY ITEM IS ALTERED THE SUPERVISING PROFESSIONAL SHALL AFFIX TO THE ITEM HIS SEAL AND THE INSCRIPTION ALTERED BY FOLLOWED BY HIS SIGNATURE THE DATE AND A SPECIFIC DESCRIPTION OF THE ALTERATION

A PART PLAN - STEEL DUNNAGE BEAMS
FOR COOLING TOWER SUPPORTS (SEE NOTE B)

**WILLIAM J CLINTON
PRESIDENTIAL
CENTER**

LITTLE ROCK, ARKANSAS

Architect
POLSHEK PARTNERSHIP LLP
520 West 13th Street
New York, New York 10014
212.807.7171

Coordinating Architects
POLK & STANLEY YEARY ARCHITECTS LM
700 South Scudder Street
Little Rock, Arkansas 72201
501.378.0878

WITSELL EVANS RASCO
501 West Third Street
Little Rock, Arkansas 72201
501.374.5300

WOODS CARADINE ARCHITECTS
2200 South Main Street
Little Rock, Arkansas 72208
501.374.4060

Landscape Architects
HARGREAVES ASSOCIATES
118 Magazine Street
Cambridge, Massachusetts 02139
617.661.0070

LANDSCAPE ARCHITECTURE, Inc
2300 Cottondale Lane Suite 202
Little Rock, Arkansas 72202
501.374.5810

Structural Engineer
LESLIE E. ROBERTSON ASSOC., RLLP
30 Broad Street, 4th Floor
New York, New York 10004
212.759.5000


MEP Engineers
FLACK + KURTZ, Inc
475 Fifth Avenue
New York, New York 10017
212.532.9600

CROWMELL ARCHITECTS ENGINEERS
101 South Spring Street
Little Rock, Arkansas 72201
501.372.2900

Curtilwall Consultant
R. A. HEINTGES ARCHITECTS
126 Fifth Avenue, 9th Floor
New York, New York 10011
212.652.2968

Seal

10	100% CONSTRUCTION DOCS	09/27/02
9	90% PROGRESS PRINTING	08/30/02
8	AS1 05	06/20/02
7	SFS-1 (RFI #5)	07/08/02
6	100% STRUCTURAL CD	07/01/02
5	100% STL & CONC CD	05/15/02
4	BUILDING DEPT	03/18/02
3	BID ISSUE	03/01/02
2	75% DESIGN DEVEL	01/25/02
1	50% DESIGN DEVEL	12/19/01
Issue		Date

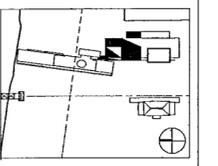


Job No. 9908
Scale 1/8"=1'-0"
Date DEC 11, 2001
Title

**GROUND LEVEL
PLAN**

Sheet No. **S101c**

NOTES

- REFER TO THE STRUCTURAL DRAWING BOOK FOR GENERAL NOTES, TYPICAL DETAILS, SCHEDULES AND ALL REFERENCED DETAILS AND SECTIONS REFER TO S220 SERIES DRAWINGS FOR WALL ELEVATIONS AND REINFORCEMENT REFER TO EDGE OF SLAB DRAWINGS FOR CURBS, SLAB EDGE LOCATIONS AND DIMENSIONS
- TOP OF CONCRETE IS AT REFERENCE ELEVATION +0'-0. (EL 276') UNLESS OTHERWISE NOTED [XXX], WHERE XXX IS MEASURED WITH RESPECT TO REFERENCE ELEVATION
- FLOOR CONSTRUCTION IS WAFFLE SLAB WITH 30"x30"x20" DOMES, 7" JOISTS @ 37" O.C. AND 4-1/2" NORMAL WEIGHT CONCRETE TOP SLAB, UNLESS OTHERWISE NOTED
- TOP OF STRUCTURAL STEEL IS (-0') BELOW REFERENCE ELEVATION UNLESS OTHERWISE NOTED
- CONCRETE STRENGTH AND WEIGHT
SLABS F'C = 4000 PSI, NW
WALLS & COLUMNS F'C = 4000 PSI, NW
- CONCRETE BEAMS ARE DESIGNATED BxD WHERE B IS THE WIDTH IN INCHES AND D IS THE DEPTH (INCLUDING THE SLAB) IN INCHES
- PLACE REINFORCING BARS FOR WAFFLE SLAB IN THE FOLLOWING SEQUENCE UPON
NORTH-SOUTH BOTTOM BARS
EAST-WEST BOTTOM BARS
EAST-WEST TOP BARS
NORTH-SOUTH TOP BARS
- MT=MINIMUM TUBE, TS6x4x5/16 FY 46
MB=MINIMUM BEAM, W12x22 FY 50
- ▽ INDICATES INFORMATION TO BE PROVIDED BY ARCHITECT

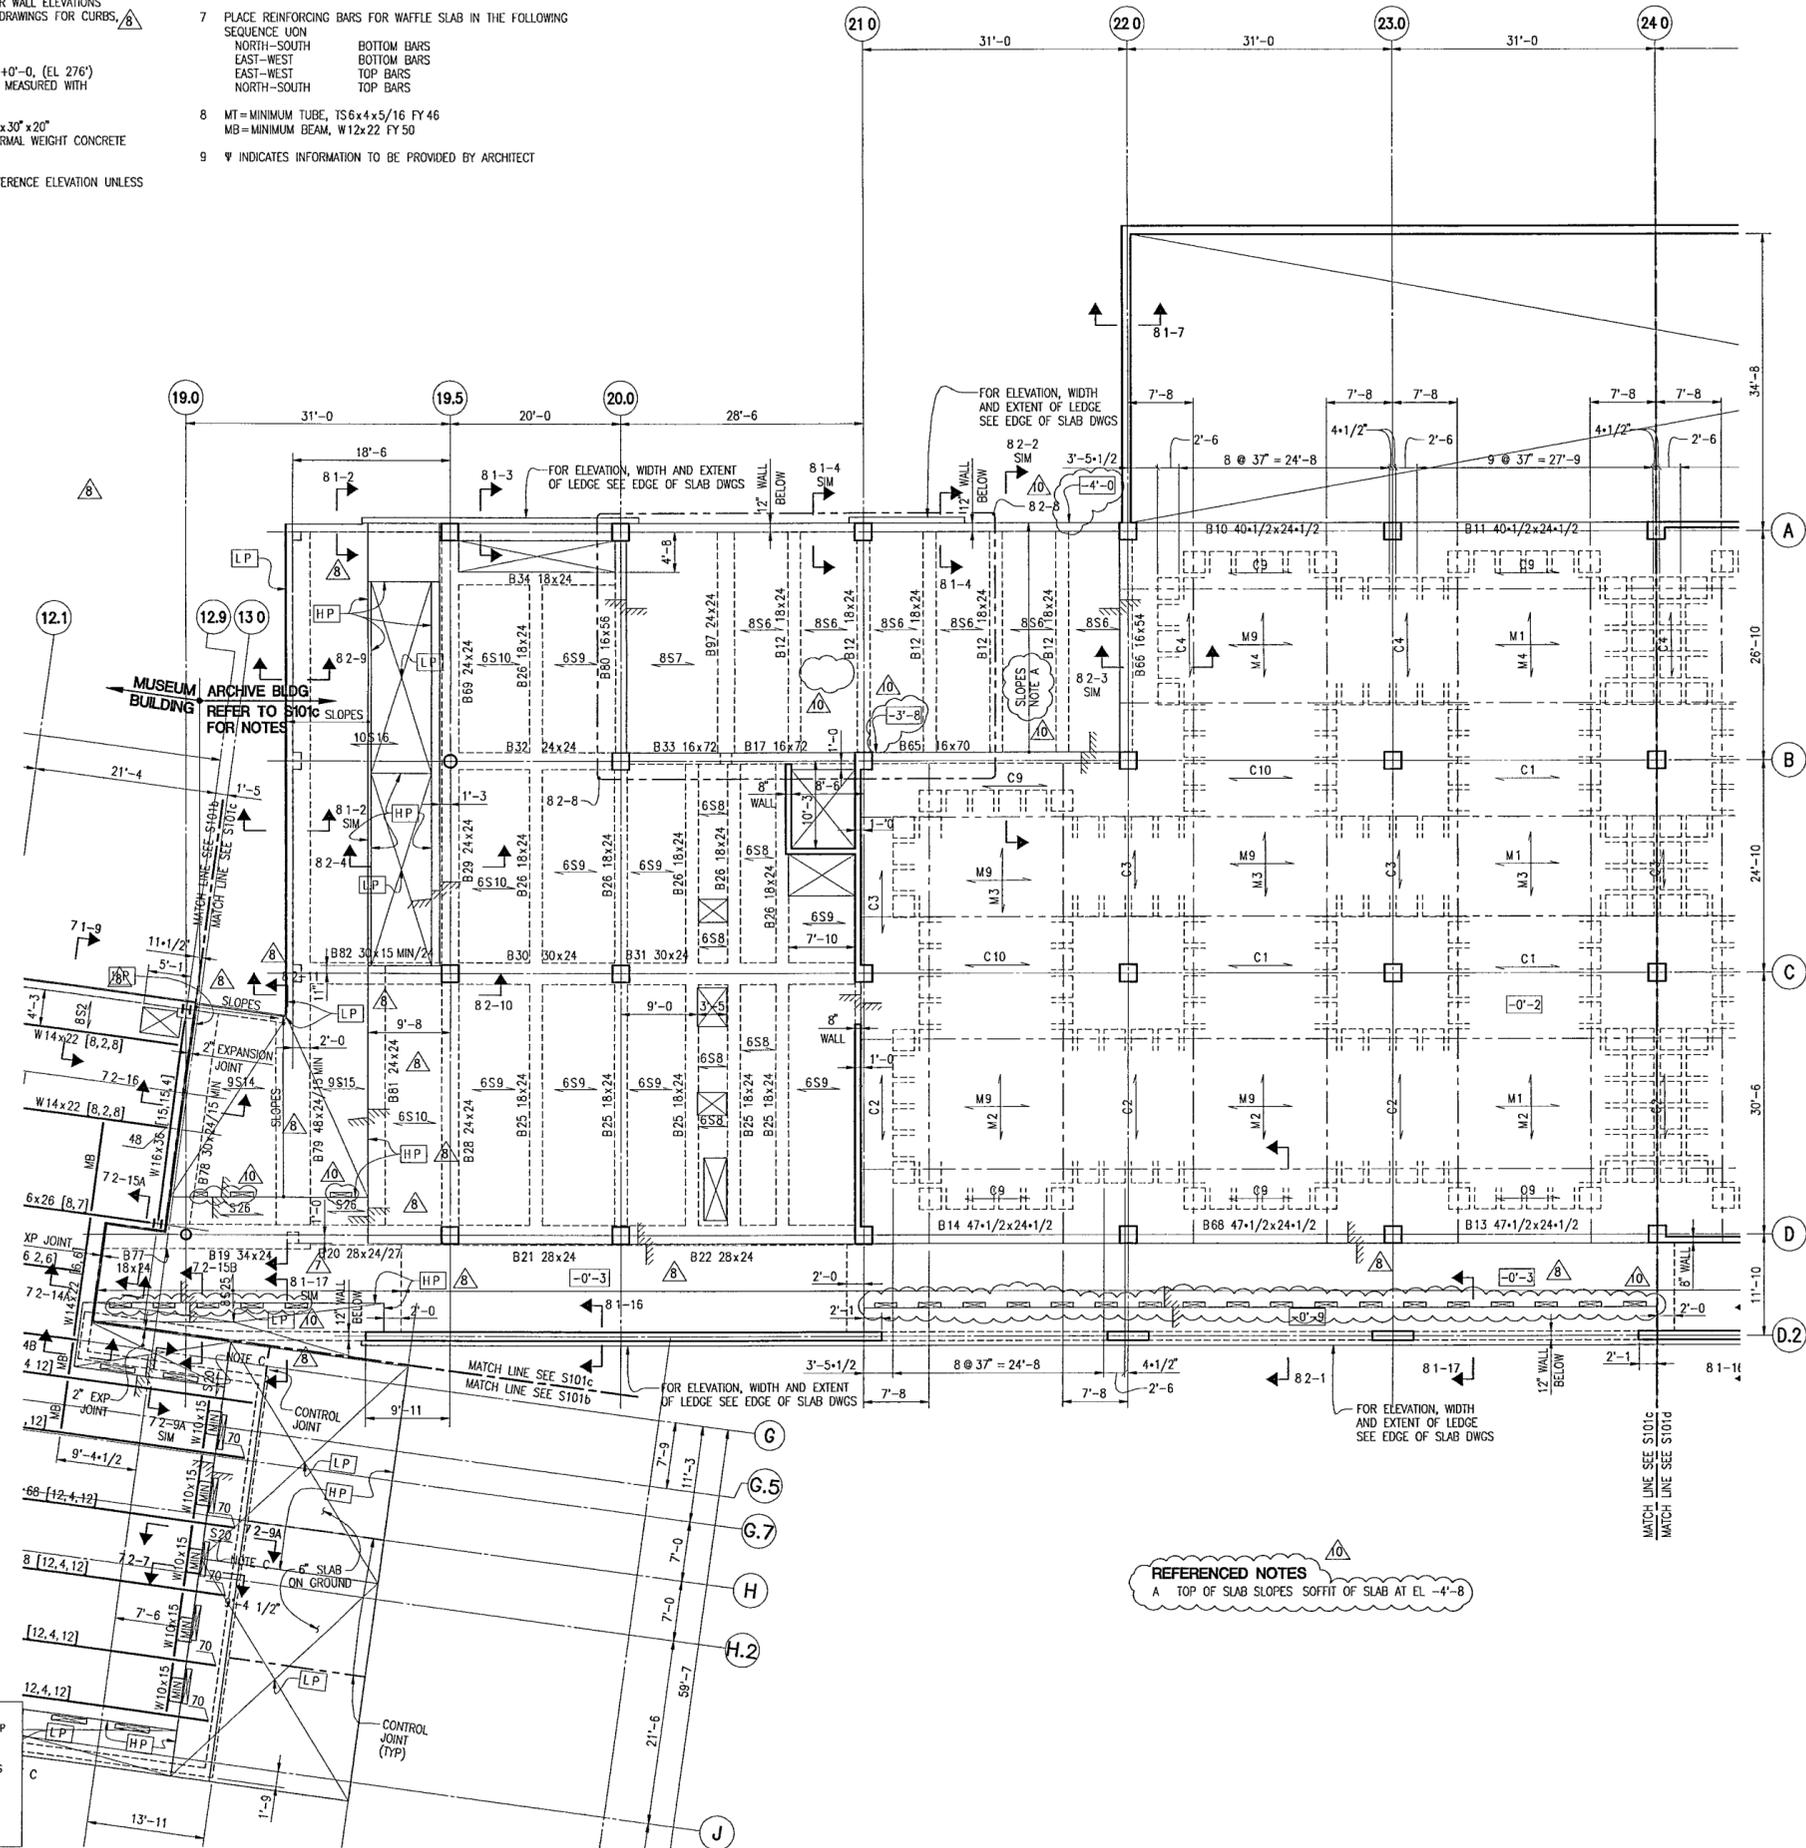

© Copyright LESLIE E. ROBERTSON ASSOCIATES R.L.L.P.
WARNING IT IS A VIOLATION OF LAW FOR ANY PERSON, UNLESS ACTING UNDER THE DIRECTION OF A PROFESSIONAL LICENSED IN THE STATE OF THIS PROJECT TO ALTER IN ANY WAY THESE DRAWINGS WHERE ANY ITEM IS ALTERED, THE SUPERVISING PROFESSIONAL SHALL AFFIX TO THIS ITEM HIS SEAL AND THE DESCRIPTION ALTERED BY FOLLOWED BY HIS SIGNATURE, THE DATE, AND A SPECIFIC DESCRIPTION OF THE ALTERATION

**WILLIAM J CLINTON
PRESIDENTIAL
CENTER**

LITTLE ROCK, ARKANSAS

Architect
POLSHEK PARTNERSHIP LLP
320 West 13th Street
New York, New York 10014
212.667.7171

Coordinating Architects
POLK STANLEY YEARY ARCHITECTS LM
700 South Schaller Street
Little Rock, Arkansas 72201
501.378.0878

WITSELL EVANS RASCO
501 West Third Street
Little Rock, Arkansas 72201
501.374.5300

WOODS CARADINE ARCHITECTS
2200 South Main Street
Little Rock, Arkansas 72206
501.374.4060

Landscape Architects
HARGREAVES ASSOCIATES
118 Magazine Street
Cambridge, Massachusetts 02139
617.861.0070

LANDSCAPE ARCHITECTURE, Inc.
2300 Cottondale Lane Suite 202
Little Rock, Arkansas 72202
501.374.5610

Structural Engineer
LESLIE E. ROBERTSON ASSOC., RLLP
30 Broad Street, 4th Floor
New York, New York 10004
212.750.9000


MEP Engineers
FLACK + KURTZ Inc
475 Fifth Avenue
New York, New York 10017
212.532.9600

CROWMELL ARCHITECTS ENGINEERS
101 South Spring Street
Little Rock, Arkansas 72201
501.372.2900

Curtainwall Consultant
R. A. HEINTGES ARCHITECTS
125 Fifth Avenue, 9th Floor
New York, New York 10011
212.652-2966

Seal


9	100% CONSTRUCTION DOCS	09/27/02
8	90% PROGRESS PRINTING	08/30/02
7	AS IS	08/20/02
6	100% STRUCTURAL CD	07/01/02
5	100% STL & CONC CD	05/15/02
4	BUILDING DEPT	03/18/02
3	BID ISSUE	03/01/02
2	75% DESIGN LEVEL	01/25/02
1	50% DESIGN LEVEL	12/19/01
Issue		Date

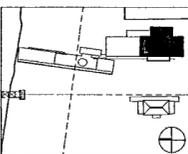

Job No. 9908
Scale 1/8"=1'-0"
Date DEC 11, 2001
Title

**GROUND LEVEL
PLAN**

Sheet No. **S101d**

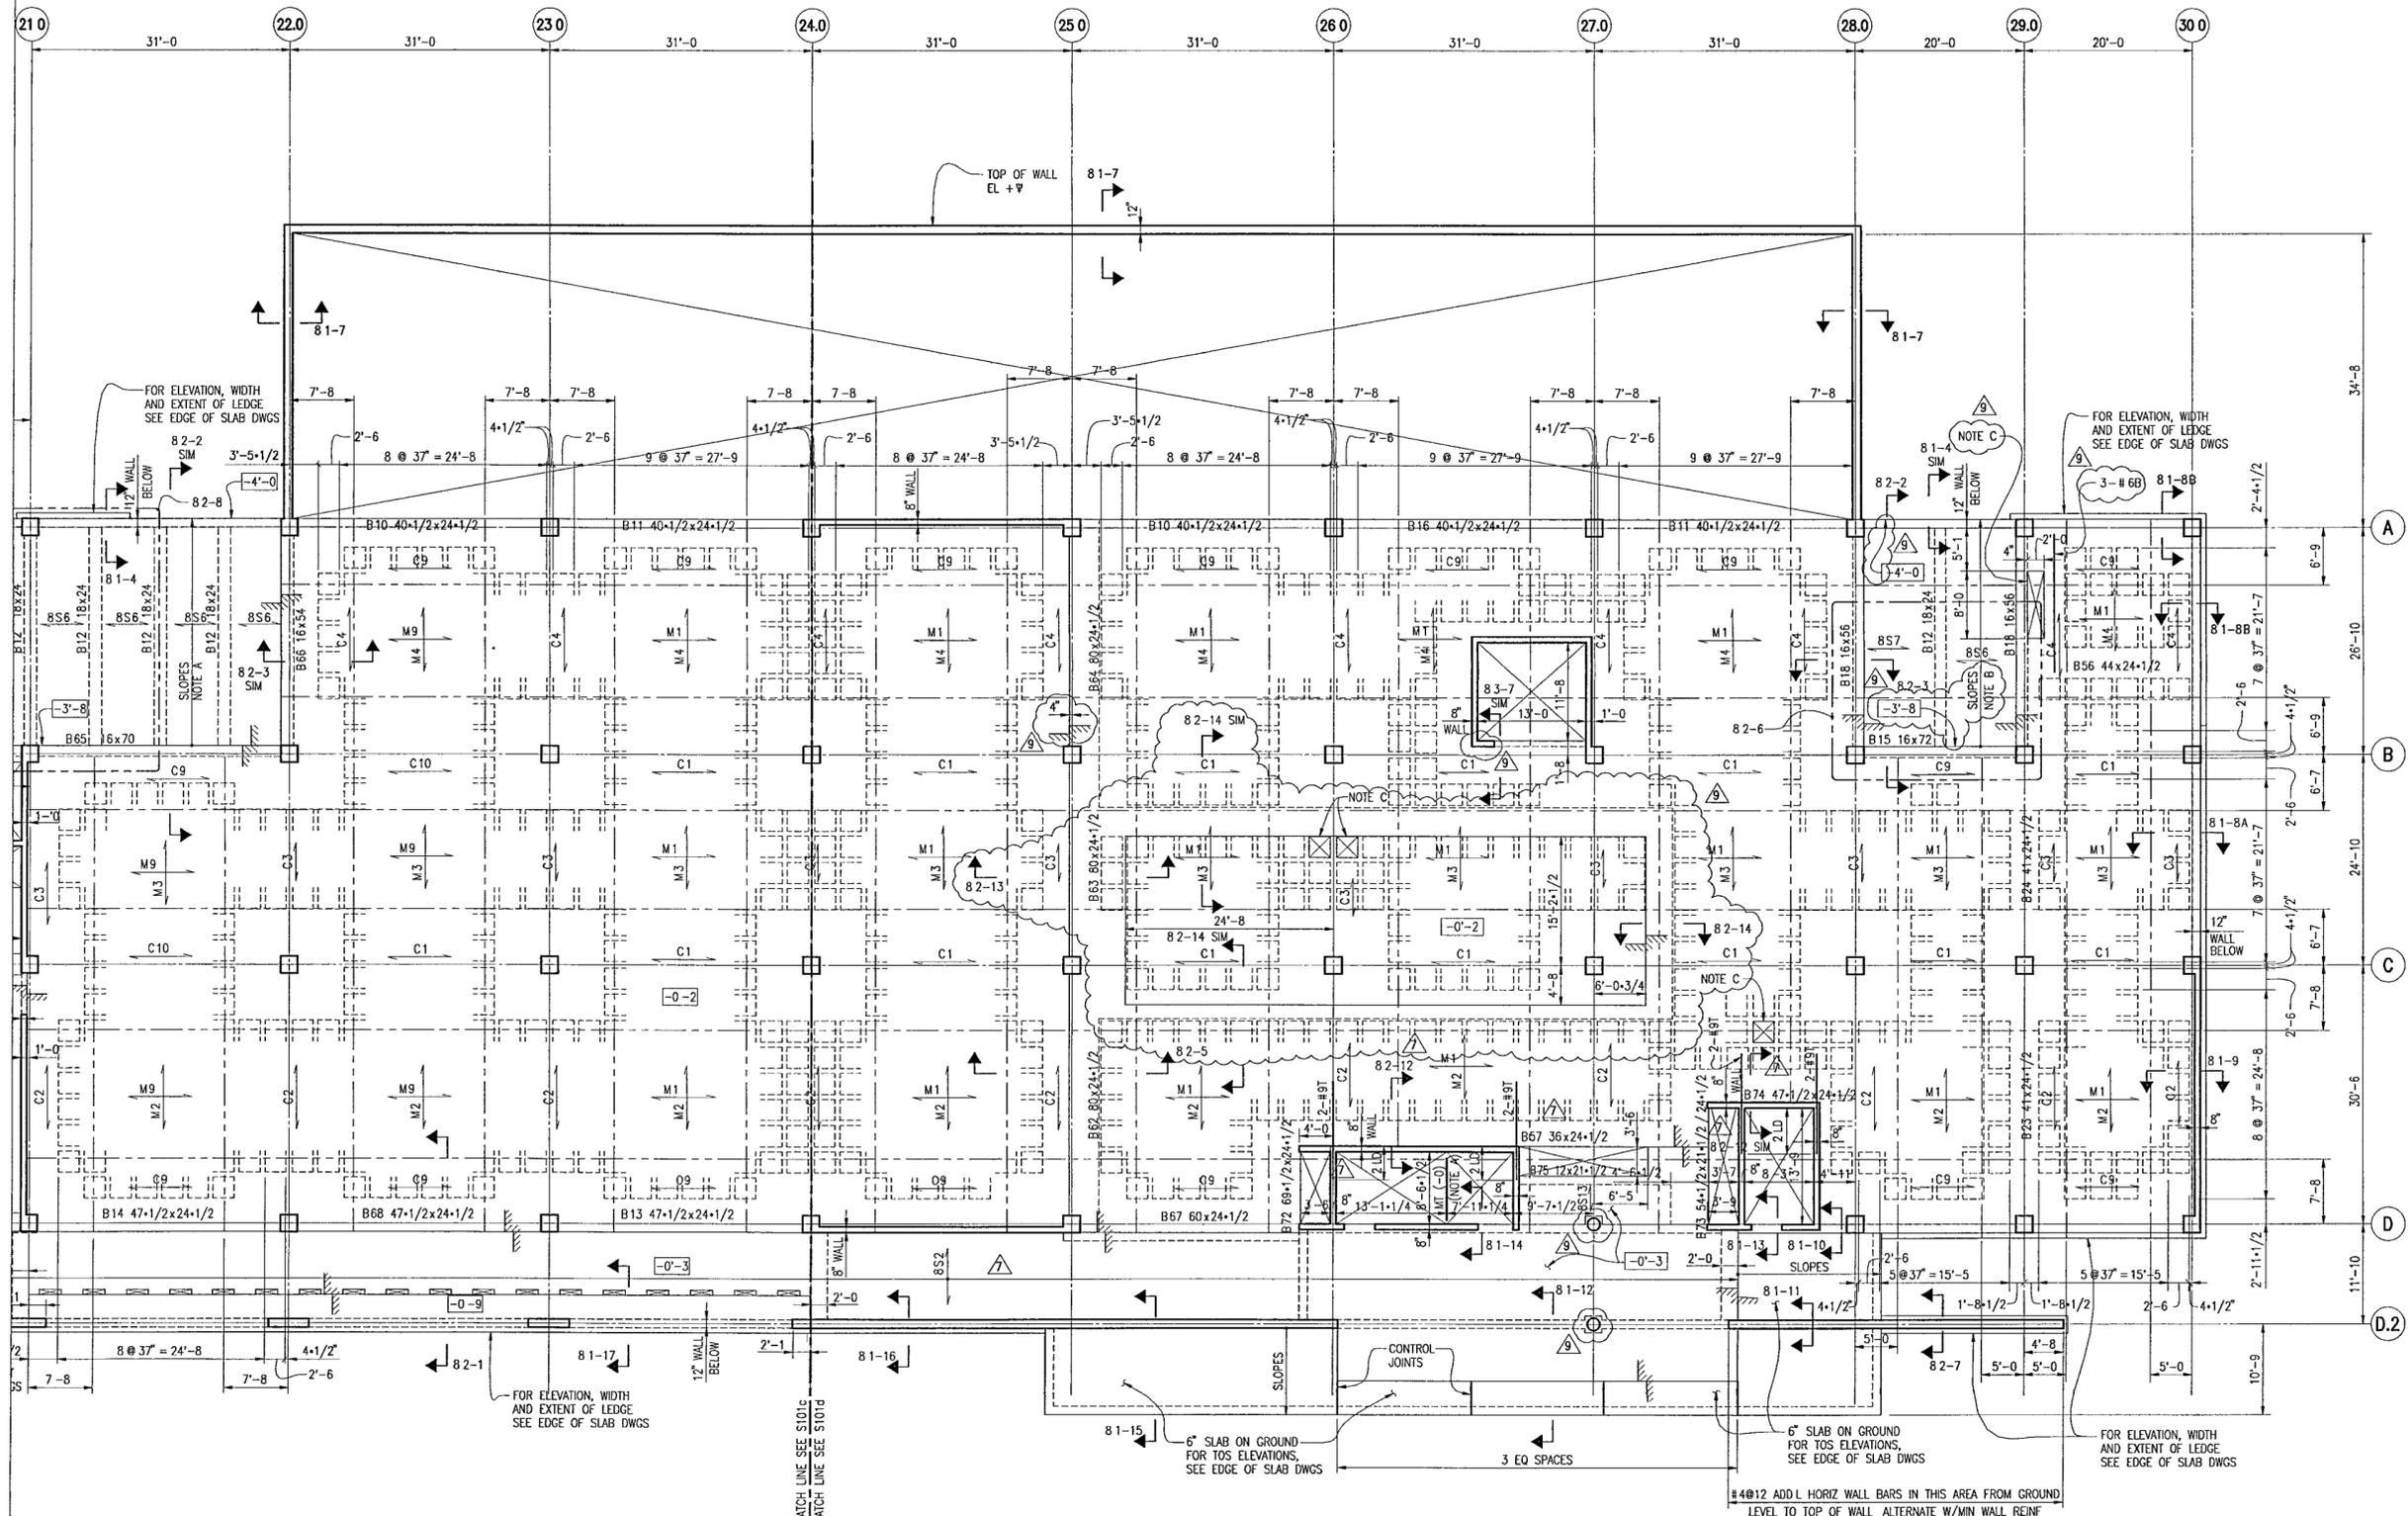

NOTES.
1 REFER TO S101c FOR NOTES

REFERENCED NOTES:
A. PROVIDE ADDITIONAL MT (NOT SHOWN IN PLAN) AT ELEVATIONS -8'-0" AND +8'-0"
B. TOP OF SLAB SLOPES SOFFIT OF SLAB AT EL -4'-8"
C. DETAIL TOP REINFORCEMENT AT OPENING PER TYPICAL DETAIL FOR ONE-WAY SLAB OPENING

© Copyright LESLIE E. ROBERTSON ASSOCIATES, RLLP
WARNING IT IS A VIOLATION OF LAW FOR ANY PERSON, UNLESS ACTING UNDER THE DIRECTION OF A PROFESSIONAL LICENSED IN THE STATE OF THIS PROJECT, TO ALTER IN ANY WAY THESE DRAWINGS WHERE ANY ITEM IS ALTERED, THE SUPERVISING PROFESSIONAL SHALL AFFIX TO THE ITEM HIS SEAL AND THE DESCRIPTION ALTERED BY FOLLOWED BY HIS SIGNATURE, THE DATE, AND A SPECIFIC DESCRIPTION OF THE ALTERATION

FOR OFFICIAL USE ONLY

**WILLIAM J CLINTON
PRESIDENTIAL
CENTER**

LITTLE ROCK, ARKANSAS

Architect

POLSHEK PARTNERSHIP LLP
320 West 13th Street
New York, New York 10014
212.607.7171

Coordinating Architects

POLK STANLEY YEARY ARCHITECTS LPA
700 South Schiller Street
Little Rock, Arkansas 72201
501.378.0878

WITSELL EVANS RASCO
501 West Third Street
Little Rock, Arkansas 72201
501.374.5300

WOODS CARADINE ARCHITECTS
2200 South Main Street
Little Rock, Arkansas 72206
501.374.4060

Landscape Architects

HARGREAVES ASSOCIATES
118 Magazine Street
Cambridge, Massachusetts 02139
617.661.0070

LANDSCAPE ARCHITECTURE, Inc.
2300 Cottondale Lane Suite 202
Little Rock, Arkansas 72202
501.374.5610

Structural Engineer

LESLIE E. ROBERTSON ASSOC., RLLP
30 Broad Street, 4th Floor
New York, New York 10004
212.750.9000

MEP Engineers

FLACK + KURTZ Inc.
475 Fifth Avenue
New York, New York 10017
212.532.9600


CROMWELL ARCHITECTS ENGINEERS
101 South Spring Street
Little Rock, Arkansas 72201
501.372.2900

Curriculum Consultant

R. A. HENTGES ARCHITECTS
126 Fifth Avenue, 9th Floor
New York, New York 10011
212.652.2968

Seal

8	100% CONSTRUCTION DOCS	09/27/02
7	90% PROGRESS PRINTING	08/30/02
6	100% STRUCTURAL CD	07/01/02
5	100% STL & CONC CD	05/15/02
4	BUILDING DEPT	03/18/02
3	BID ISSUE	03/01/02
2	75% DESIGN DEVEL.	01/25/02
1	50% DESIGN DEVEL.	12/19/01
	Issue	Date

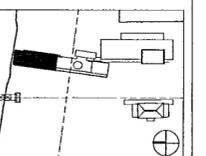

Job No 0908

Scale 1/8"=1'-0"

Date DEC 11, 2001

Title

**SECOND LEVEL
PLAN**

Sheet No

S102a


NOTES:

- REFER TO THE STRUCTURAL DRAWING BOOK FOR GENERAL NOTES, TYPICAL DETAILS, SCHEDULES AND ALL REFERENCED DETAILS AND SECTIONS REFER TO S110 SERIES DRAWINGS FOR ADDITIONAL SLAB REINFORCEMENT AND S220 SERIES DRAWINGS FOR WALL ELEVATIONS AND REINFORCEMENT REFER TO EDGE OF SLAB DRAWINGS FOR SLAB EDGE LOCATIONS AND DIMENSIONS
- TOP OF CONCRETE IS AT REFERENCE ELEVATION +13'-10", UNLESS OTHERWISE NOTED [XXX], WHERE XXX IS MEASURED WITH RESPECT TO REFERENCE ELEVATION
- TOP OF STRUCTURAL STEEL IS (-6'-1/2") BELOW REFERENCE ELEVATION UNLESS OTHERWISE NOTED
- FLOOR CONSTRUCTION IS 3-1/2" LIGHTWEIGHT CONCRETE (F'C=3 KSI) OVER 3" COMPOSITE DECK, TYPE D2, UNLESS OTHERWISE NOTED
- STEEL DECK SPANS IN THE SHORT DIRECTION UNLESS NOTED PROVIDE PERMANENT DECK SUPPORTS AT COLUMNS AND WALLS UNLESS OTHERWISE NOTED
- SOLID CONCRETE SLAB IS INDICATED $\overline{\text{SL}}$ THIS IS A FORMED SLAB, THERE IS NO STEEL DECK

- CONCRETE STRENGTH AND WEIGHT
SLAB ON DECK F'C=3000 PSI, LW
FORMED SLABS F'C=4000 PSI, NW
WALLS F'C=4000 PSI, NW
COLUMNS F'C=4000 PSI, NW
- STRUCTURAL STEEL SHAPES SHALL BE FY50 UNLESS OTHERWISE NOTED CONNECTION PLATES SHALL BE FY36 U O M
PIPES SHALL BE FY36
TUBES SHALL BE FY46
ANGLES SHALL BE FY36
- INTERIOR WALLS ARE 12" CONCRETE WALLS UNLESS OTHERWISE NOTED
- NUMBER OF 3/4" x 5-1/2" LONG STUD SHEAR CONNECTORS APPLIED TO THE TOP FLANGE OF BEAM IS NOTED THUS []
- SB=ELEVATOR SEPARATOR BEAM, T56x4x5/16
SC=STAIR HEADER CHANNEL, C12x20 7 FY36
MB=MINIMUM BEAM, W12x22 [MIN]
LA=L-3x3x5/16 DECK SUPPORT ANGLE
- INDICATES MOMENT CONNECTION
- CAMBER IN INCHES IS GIVEN THUS, C
- INDICATES INFORMATION TO BE PROVIDED BY OTHERS

REFERENCED NOTES.


- WHERE NOTED, NUMBER OF 3/4" x 5-1/2" LONG STUD SHEAR CONNECTORS APPLIED TO THE TOP FLANGE OF BEAM IS NOTED THUS []
- SEE 7-2-18 FOR ADDITIONAL STEEL FRAMING IN CONCRETE CORES
- PROVIDE ELEVATOR RAIL SUPPORT SEE 7-1-32 FOR ELEVATION

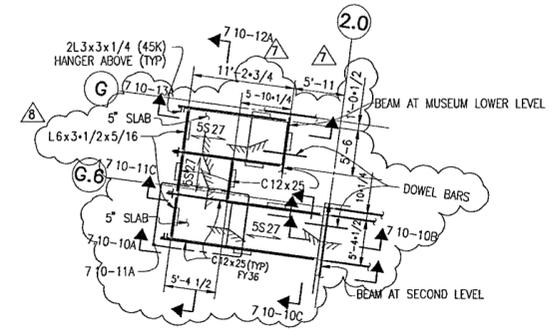

A PART PLAN EGRESS STAIR
FOR INFORMATION NOT SHOWN SEE ARCH DWGS

PART PLAN NOTES

- STAIR SLABS AND CURBS ARE F'C=4000 PSI, NW
- PAINT STEEL OF STAIR WITH ZINC RICH PRIMER

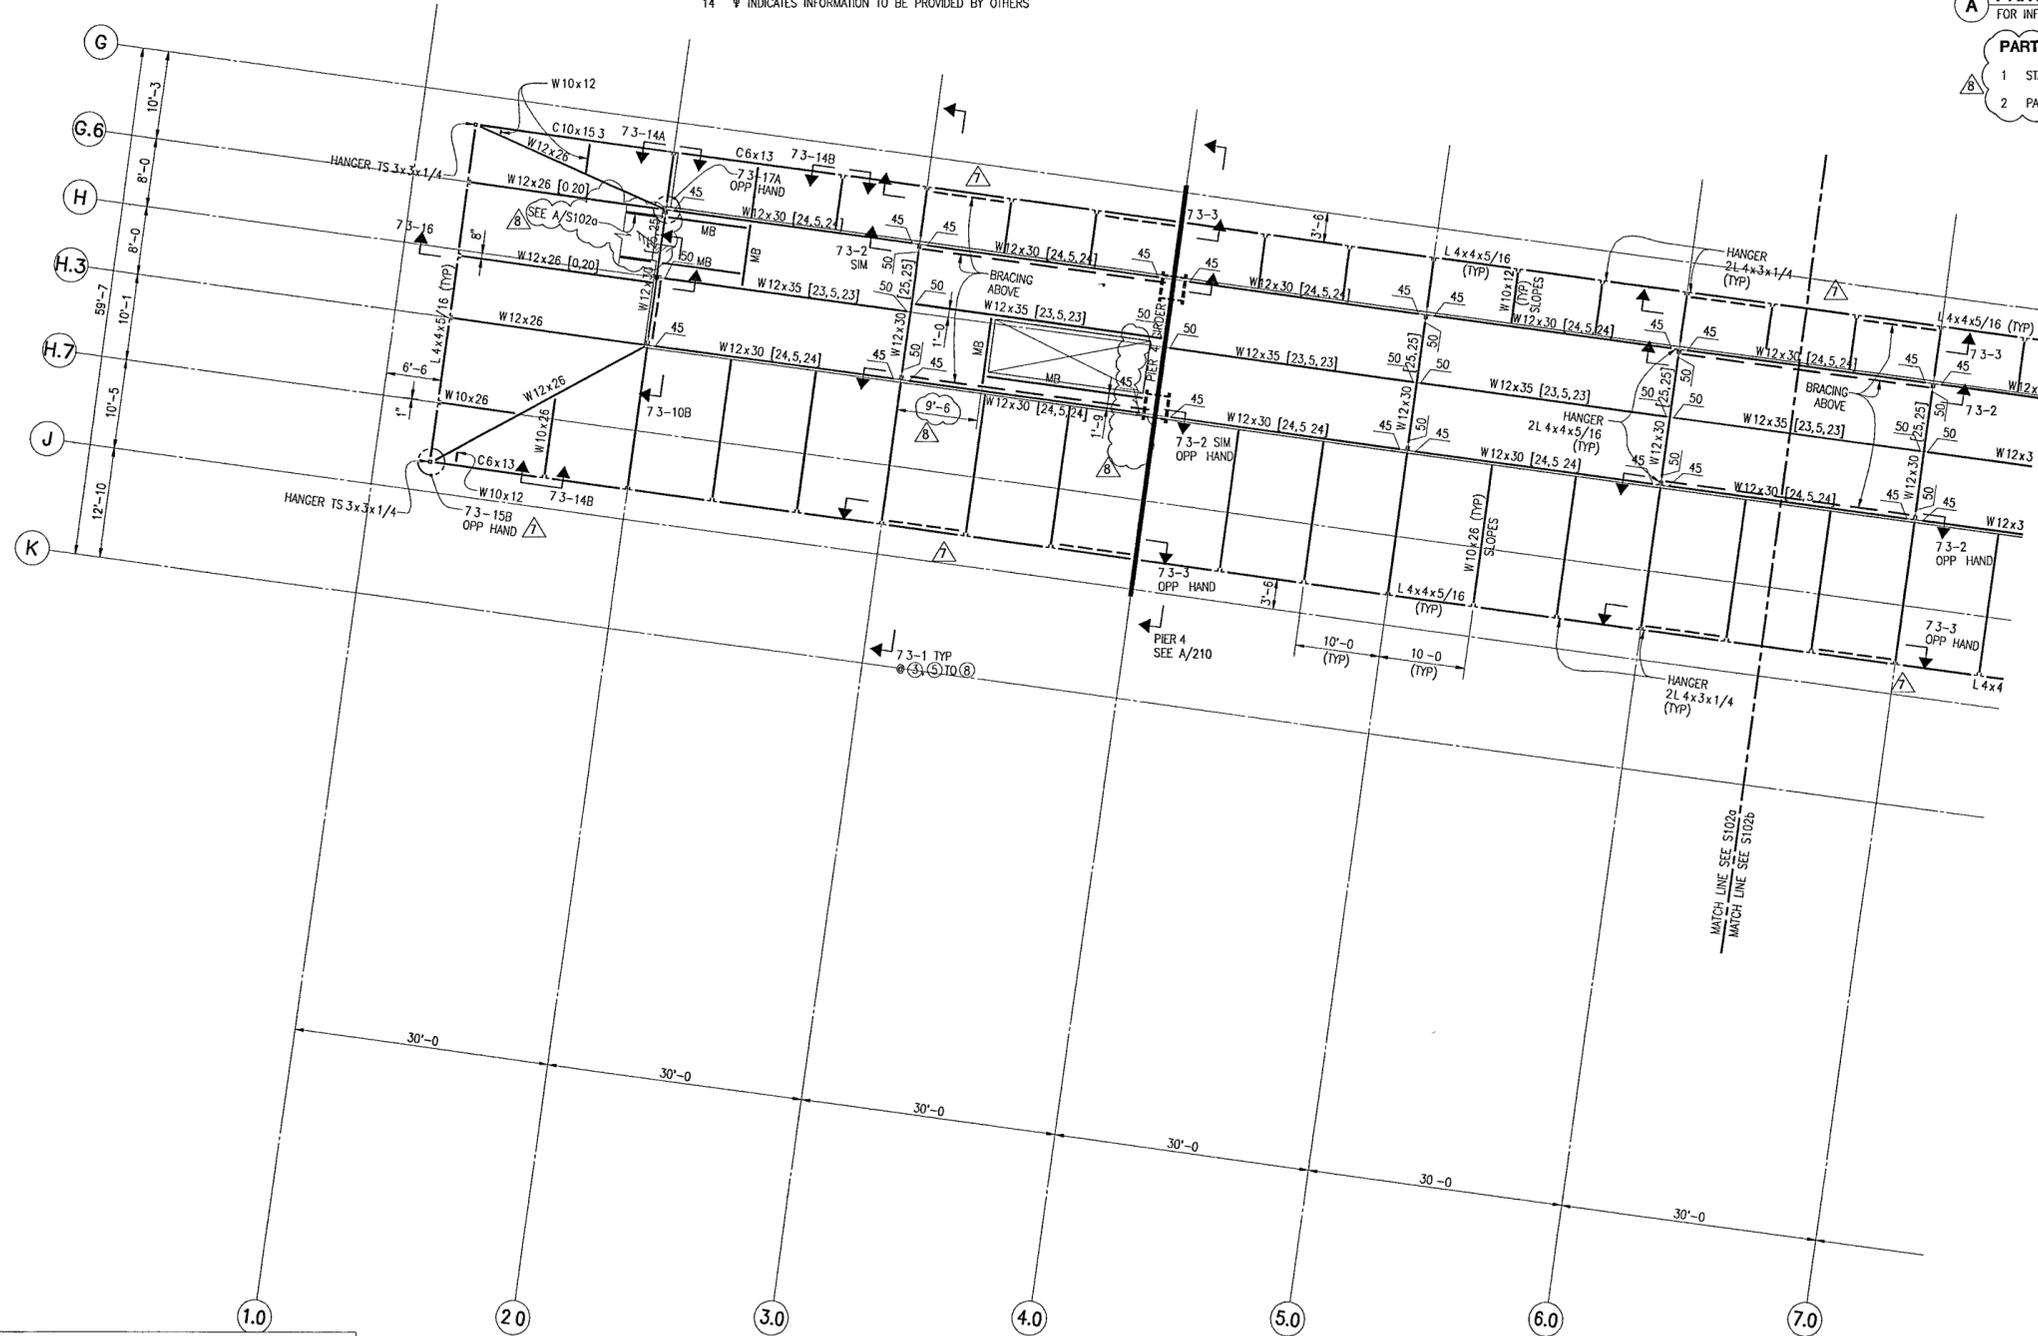

© Copyright LESLIE E. ROBERTSON ASSOCIATES, RLLP

WARNING IT IS A VIOLATION OF LAW FOR ANY PERSON, UNLESS ACTING UNDER THE DIRECTION OF A PROFESSIONAL LICENSED IN THE STATE OF THIS PROJECT, TO ALTER IN ANY WAY THESE DRAWINGS WHERE ANY ITEM IS ALTERED THE SUPERVISING PROFESSIONAL SHALL AFFIX TO THE ITEM HIS SEAL AND THE INSCRIPTION ALTERED BY FOLLOWED BY HIS SIGNATURE, THE DATE AND A SPECIFIC DESCRIPTION OF THE ALTERATION


NOTES:

- REFER TO THE STRUCTURAL DRAWING BOOK FOR GENERAL NOTES, TYPICAL DETAILS, SCHEDULES AND ALL REFERENCED DETAILS AND SECTIONS REFER TO S220 SERIES DRAWINGS FOR WALL ELEVATIONS AND REINFORCEMENT REFER TO SLAB EDGE DRAWINGS FOR SLAB EDGE LOCATIONS AND DIMENSIONS
- TOP OF CONCRETE IS AT REFERENCE ELEVATION +16'-0", UNLESS OTHERWISE NOTED [XXX], WHERE XXX IS MEASURED WITH RESPECT TO REFERENCE ELEVATION
- ROOF CONSTRUCTION IS WAFFLE SLAB WITH 30" x 30" x 16" DOMES, 7" JOISTS @ 37" O.C. AND 4-1/2" NORMAL WEIGHT CONCRETE TOP SLAB, UNLESS OTHERWISE NOTED
- FLOOR CONSTRUCTION AT OFFICE IS 9" NORMAL WEIGHT CONCRETE FLAT SLAB WITH 8" DROP PANELS UNLESS OTHERWISE NOTED
- TOP OF STRUCTURAL STEEL IS (-0') BELOW REFERENCE ELEVATION UNLESS OTHERWISE NOTED

- CONCRETE STRENGTH AND WEIGHT
SLABS F'C = 4000 PSL, NW
WALLS & COLUMNS F'C = 4000 PSL, NW
- CONCRETE BEAMS ARE DESIGNATED BxD WHERE B IS THE WIDTH IN INCHES AND D IS THE DEPTH (INCLUDING THE SLAB) IN INCHES
- PLACE REINFORCING BARS FOR WAFFLE SLAB IN THE FOLLOWING SEQUENCE UON
NORTH-SOUTH BOTTOM BARS
EAST-WEST BOTTOM BARS
EAST-WEST TOP BARS
NORTH-SOUTH TOP BARS
- FOR FLAT SLAB REINFORCEMENT AT OFFICE SEE S102e
- MT=MINIMUM TUBE, TS6x4x5/16 FY 46
MB=MINIMUM BEAM, W12x22 FY 50
- ▽ INDICATES INFORMATION TO BE PROVIDED BY ARCHITECT

REFERENCED NOTES

- A. PAINT BEAM
COORDINATE BEAM ELEVATION AND BOTTOM FLANGE BOLT HOLES WITH MOVEABLE PANEL MANUFACTURER LOCATE TOP OF BEAM A MINIMUM OF 2" BELOW SOFFIT OF WAFFLE SLAB

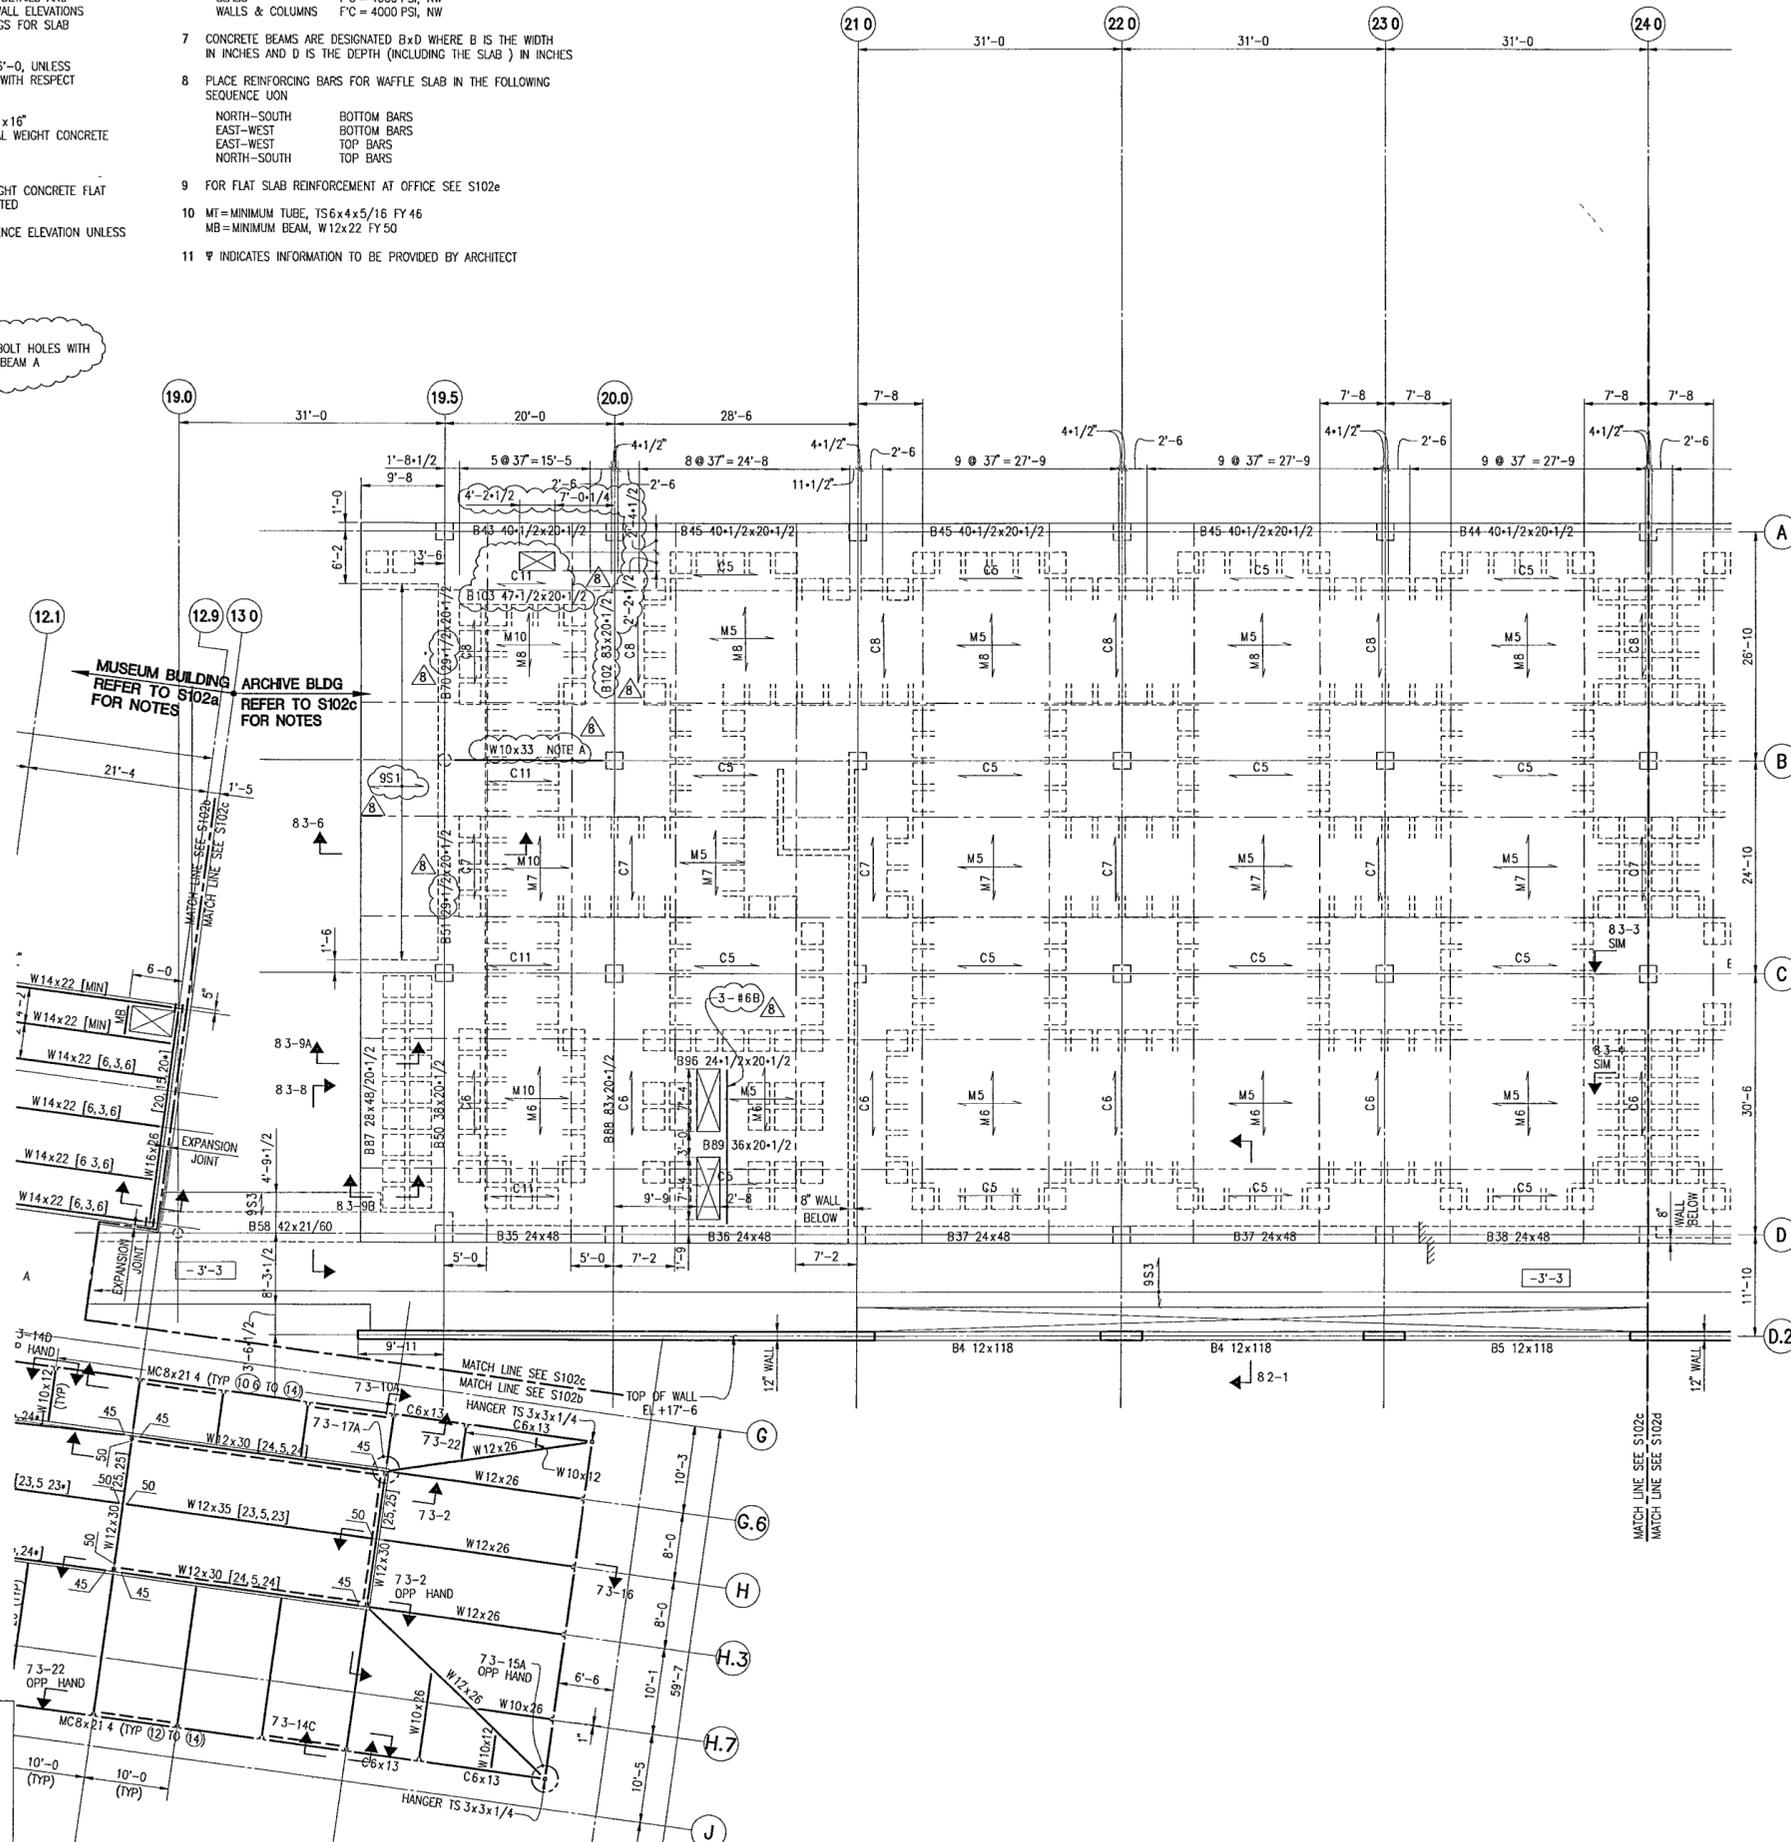

© Copyright LESLIE E. ROBERTSON ASSOCIATES, R.L.P.
WARNING IT IS A VIOLATION OF LAW FOR ANY PERSON, UNLESS ACTING UNDER THE DIRECTION OF A PROFESSIONAL LICENSED UNDER THE STATE OF THIS PROJECT, TO ALTER IN ANY WAY THESE DRAWINGS WHERE ANY ITEM IS ALTERED THE SUPERVISING PROFESSIONAL SHALL AFFIX TO THE ITEM HIS SEAL AND THE INSCRIPTION ALTERED BY FOLLOWED BY HIS SIGNATURE, THE DATE, AND A SPECIFIC DESCRIPTION OF THE ALTERATION

**WILLIAM J CLINTON
PRESIDENTIAL
CENTER**

LITTLE ROCK, ARKANSAS

Architect
POLSHAK PARTNERSHIP LLP
 320 West 13th Street
 New York, New York 10014
 212.637.7171

Coordinating Architects
POLK STANLEY YEARY ARCHITECTS Ltd
 700 South Schiller Street
 Little Rock, Arkansas 72201
 501.378.0878

WITSELL EVANS RASCO
 901 West Third Street
 Little Rock, Arkansas 72201
 501.374.5300

WOODS CARADINE ARCHITECTS
 2200 South Main Street
 Little Rock, Arkansas 72206
 501.374.4060

Landscape Architects
HARGREAVES ASSOCIATES
 118 Magazine Street
 Cambridge, Massachusetts 02139
 617.661.0070

LANDSCAPE ARCHITECTURE, Inc.
 2300 Cotontdale Lane Suite 202
 Little Rock, Arkansas 72202
 501.374.5610

Structural Engineer
LESLIE E. ROBERTSON ASSOC., R.L.P.
 30 Broad Street, 47th Floor
 New York, New York 10004
 212.750.9000


MEP Engineers
FLACK + KURTZ Inc.
 475 Fifth Avenue
 New York, New York 10017
 212.532.9600

CROMWELL ARCHITECTS ENGINEERS
 101 South Spring Street
 Little Rock, Arkansas 72201
 501.372.2900

Curtainwall Consultant
R.A. HEINTGES ARCHITECTS
 126 Fifth Avenue, 9th Floor
 New York, New York 10011
 212.652.2565

Seal

Issue	Date
8 100% CONSTRUCTION DOCS	09/27/02
7 90% PROGRESS PRINTING	08/30/02
6 100% STRUCTURAL CD	07/01/02
5 100% STL & CONC CD	05/15/02
4 BUILDING DEPT	03/18/02
3 BID ISSUE	03/01/02
2 75% DESIGN DEVEL.	01/25/02
1 50% DESIGN DEVEL.	12/19/01

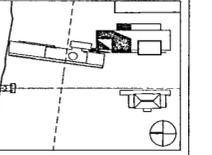

Job No 9908
 Scale 1/8"=1'-0"
 Date DEC 11, 2001
 Title

**SECOND LEVEL
PLAN**

Sheet No
S102c

FOR OFFICIAL USE ONLY

**WILLIAM J CLINTON
PRESIDENTIAL
CENTER**

LITTLE ROCK, ARKANSAS

Architect
POLSHEK PARTNERSHIP LLP
320 West 13th Street
New York, New York 10014
212.507.7171

Coordinating Architects
POLK STANLEY YEARY ARCHITECTS Ltd
700 South Schlar Street
Little Rock, Arkansas 72201
501.378.0878

WITSELL EVANS RASCO
501 West Third Street
Little Rock, Arkansas 72201
501.374.5300

WOODS CARADINE ARCHITECTS
2200 South Main Street
Little Rock, Arkansas 72208
501.374.4060

Landscape Architects
HARGREAVES ASSOCIATES
118 Magazine Street
Cambridge, Massachusetts 02139
617.661.0070

LANDSCAPE ARCHITECTURE, Inc.
2300 Cottondale Lane Suite 202
Little Rock, Arkansas 72202
501.374.5610

Structural Engineer
LESLIE E. ROBERTSON ASSOC. RLLP
30 Broad Street, 4th Floor
New York, New York 10004
212.750.9000


MEP Engineers
FLACK + KURTZ Inc.
475 Fifth Avenue
New York, New York 10017
212.532.9600

CRAMWELL ARCHITECTS ENGINEERS
151 South Spang Street
Little Rock, Arkansas 72201
501.372.2900

Curtilwall Consultant
R. A. HEINTGES ARCHITECTS
126 Fifth Avenue, 9th Floor
New York, New York 10011
212.652.2966

Seal

8	100% CONSTRUCTION DOCS	09/27/02
7	90% PROGRESS PRINTING	08/30/02
6	100% STRUCTURAL CD	07/01/02
5	100% STL & CONC CD	05/15/02
4	BUILDING DEPT	03/18/02
3	BID ISSUE	03/01/02
2	75% DESIGN DEVEL	01/25/02
1	50% DESIGN DEVEL	12/19/01
Issue		Date

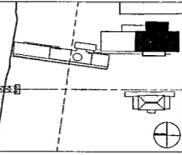


Job No 9908
Scale 1/8"=1'-0"
Date DEC 11, 2001
Title

SECOND LEVEL PLAN

Sheet No

S102d

FOR OFFICIAL USE ONLY

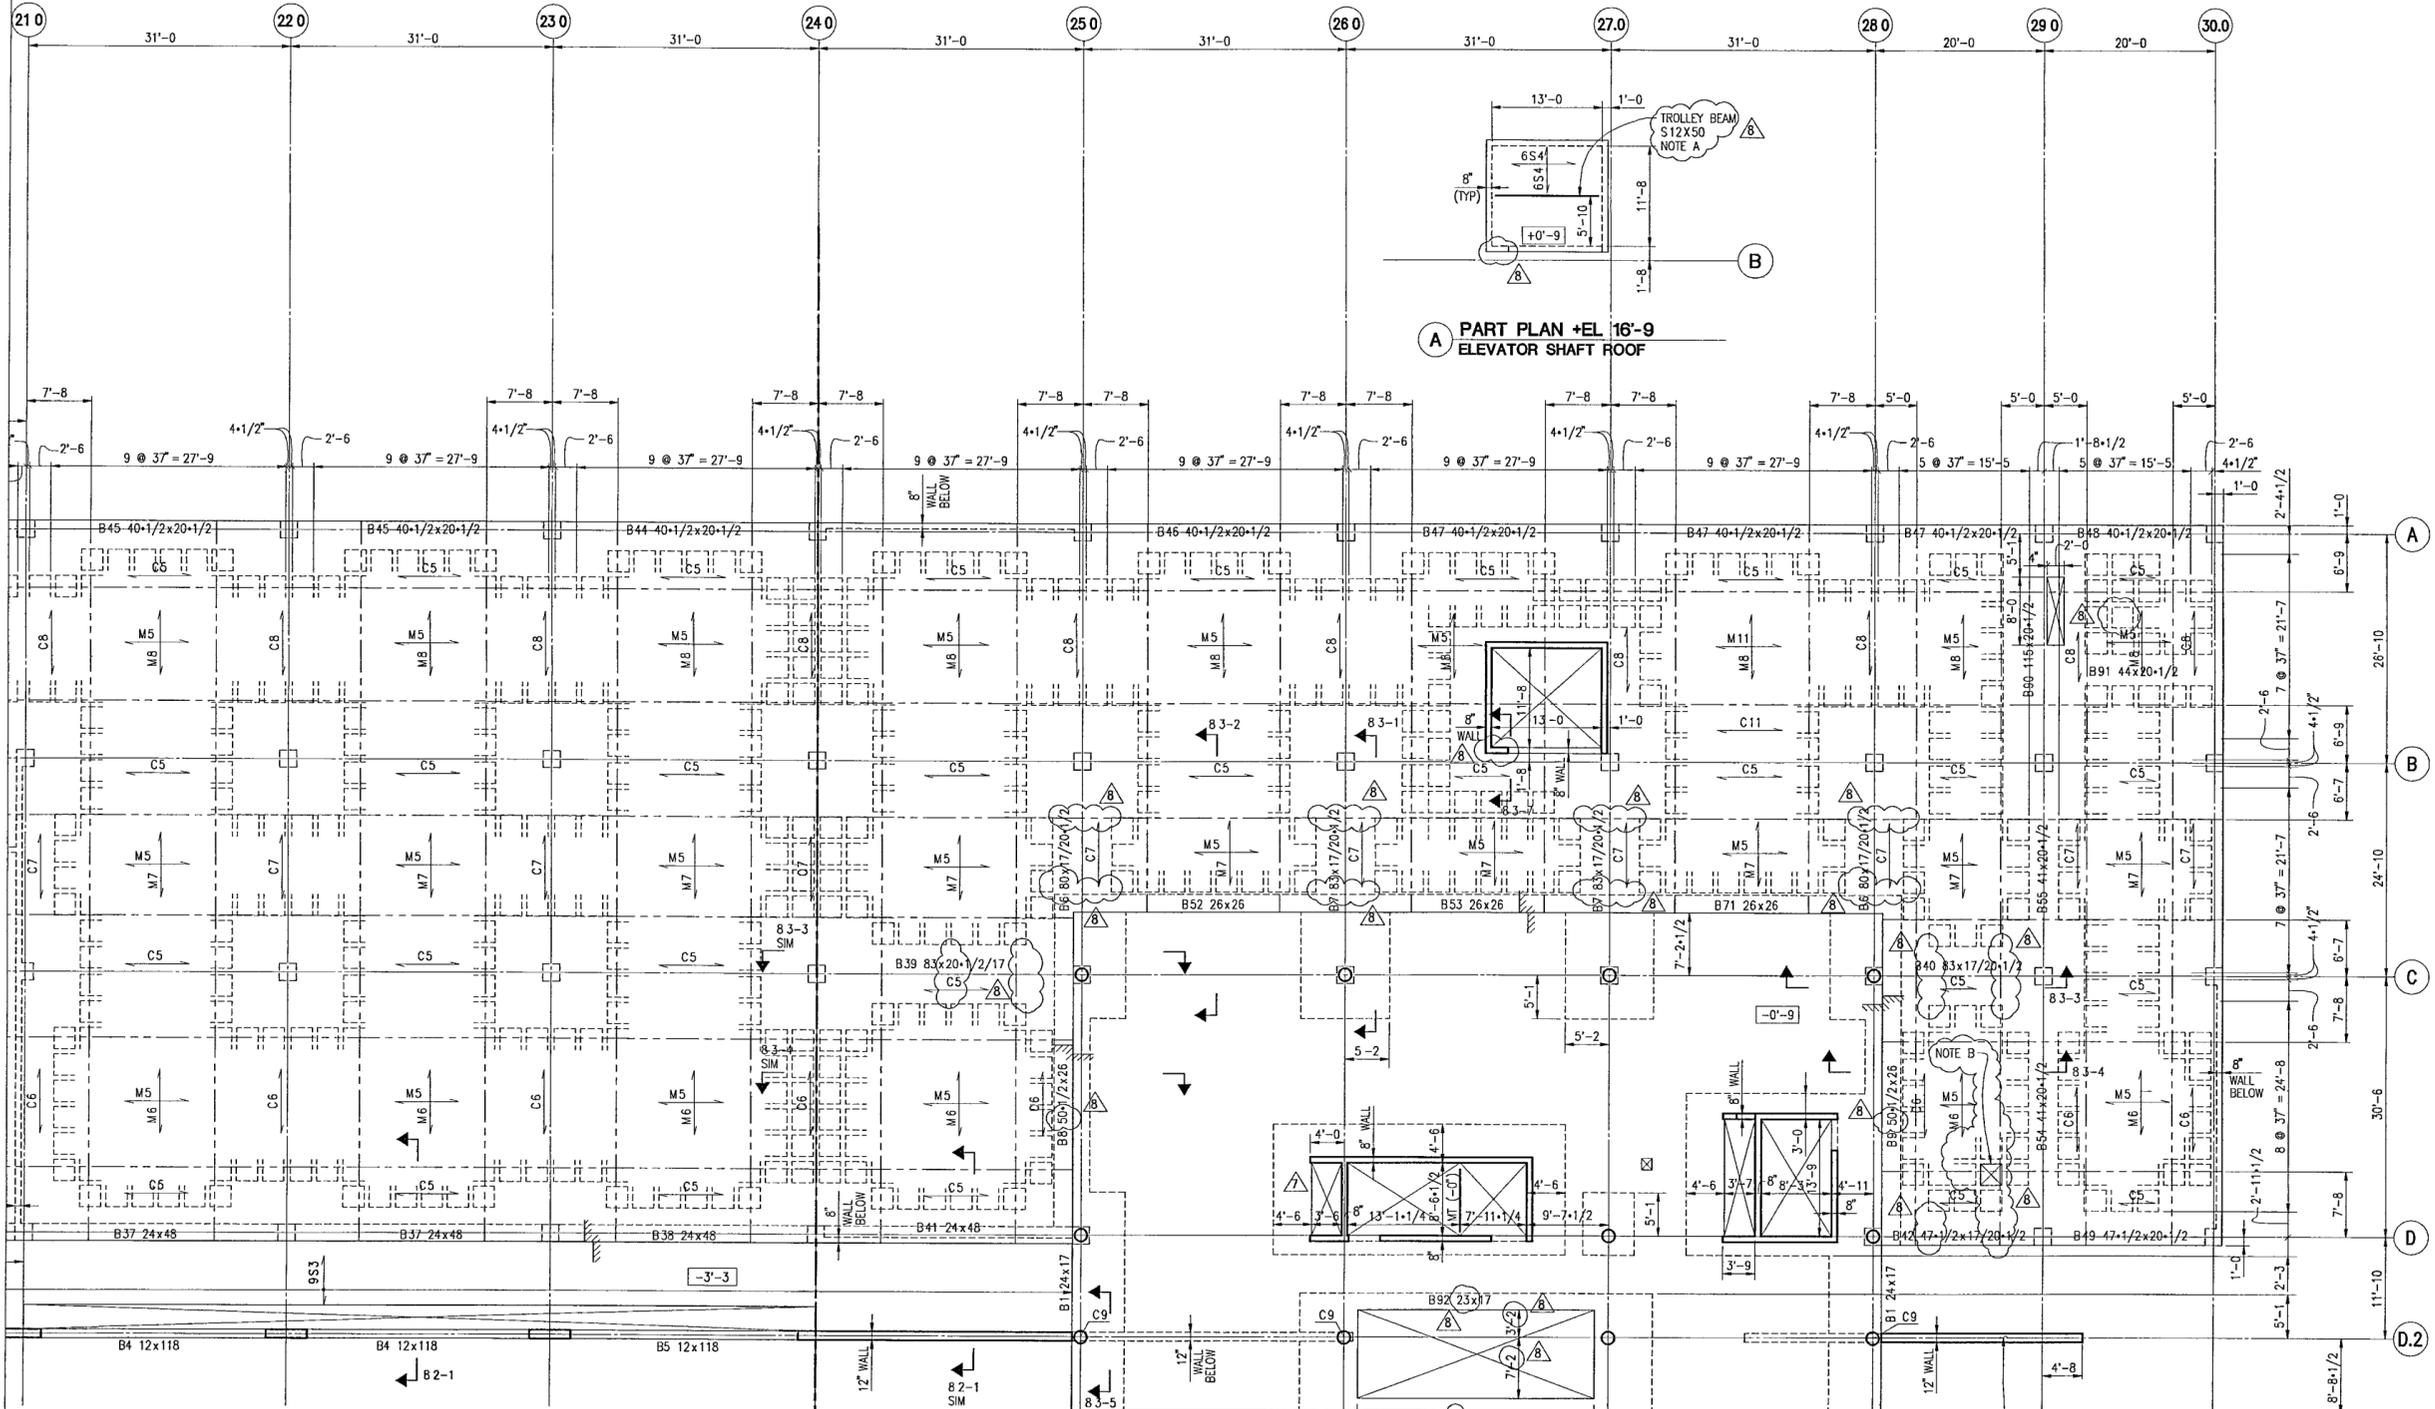

**A PART PLAN +EL 16'-9
ELEVATOR SHAFT ROOF**

- NOTES:**
- REFER TO S102C FOR NOTES
- REFERENCED NOTES**
- A PAINT BEAM
LOCATE TOP OF BEAM 2" BELOW SOFFIT OF SLAB
 - B DETAIL TOP REINFORCEMENT AT OPENING PER TYPICAL DETAIL
FOR ONE-WAY SLAB OPENING

© Copyright LESLIE E. ROBERTSON ASSOCIATES RLLP
WARNING IT IS A VIOLATION OF LAW FOR ANY PERSON UNLESS ACTING UNDER THE DIRECTION OF A PROFESSIONAL LICENSED IN THE STATE OF THIS PROJECT, TO ALTER IN ANY WAY THESE DRAWINGS WHERE ANY ITEM IS ALTERED THE SUPERVISING PROFESSIONAL SHALL AFFIX TO THE ITEM HIS SEAL AND THE INSCRIPTION "ALTERED BY" FOLLOWED BY HIS SIGNATURE, THE DATE, AND A SPECIFIC DESCRIPTION OF THE ALTERATION

**WILLIAM J. CLINTON
PRESIDENTIAL
CENTER**

LITTLE ROCK, ARKANSAS

Architect
POLSHEK PARTNERSHIP LLP
320 West 13th Street
New York, New York 10014
212.607.7171

Coordinating Architects
POLK STANLEY YEARY ARCHITECTS LTD
700 South Schiller Street
Little Rock, Arkansas 72201
501.378.0878

WITSELL EVANS RASCO
901 West Third Street
Little Rock, Arkansas 72201
501.374.5300

WOODS CARADINE ARCHITECTS
2200 South Main Street
Little Rock, Arkansas 72206
501.374.4060

Landscape Architects
HARGREAVES ASSOCIATES
118 Magazine Street
Cambridge, Massachusetts 02139
617.661.0070

LANDSCAPE ARCHITECTURE, Inc.
2300 Cottondale Lane Suite 202
Little Rock, Arkansas 72202
501.374.5610

Structural Engineer
LESLIE E. ROBERTSON ASSOC, RLLP
30 Broad Street, 4th Floor
New York, New York 10004
212.750.9000


MEP Engineers
FLACK + KURTZ Inc.
475 Fifth Avenue
New York, New York 10017
212.532.9600

CROWHILL ARCHITECTS ENGINEERS
101 South Spring Street
Little Rock, Arkansas 72201
501.372.2900

Curtainwall Consultant
R. A. HEINTGES ARCHITECTS
126 Fifth Avenue 9th Floor
New York, New York 10011
212.652.2966

Seal


Issue	Date
8	10% CONSTRUCTION DOCS 09/27/02
7	90% PROGRESS PRINTING 08/30/02
6	100% STRUCTURAL CD 07/01/02
5	100% STL & CONC CD 06/15/02
4	BUILDING DEPT 03/18/02
3	BID ISSUE 03/01/02
2	75% DESIGN DEVEL 01/25/02
1	50% DESIGN DEVEL 12/19/01

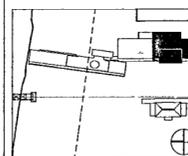

Job No 9908
Scale 1/8"=1'-0"
Date DEC 11, 2001
Title

**SECOND LEVEL
PLAN**


Sheet No. **S102e**

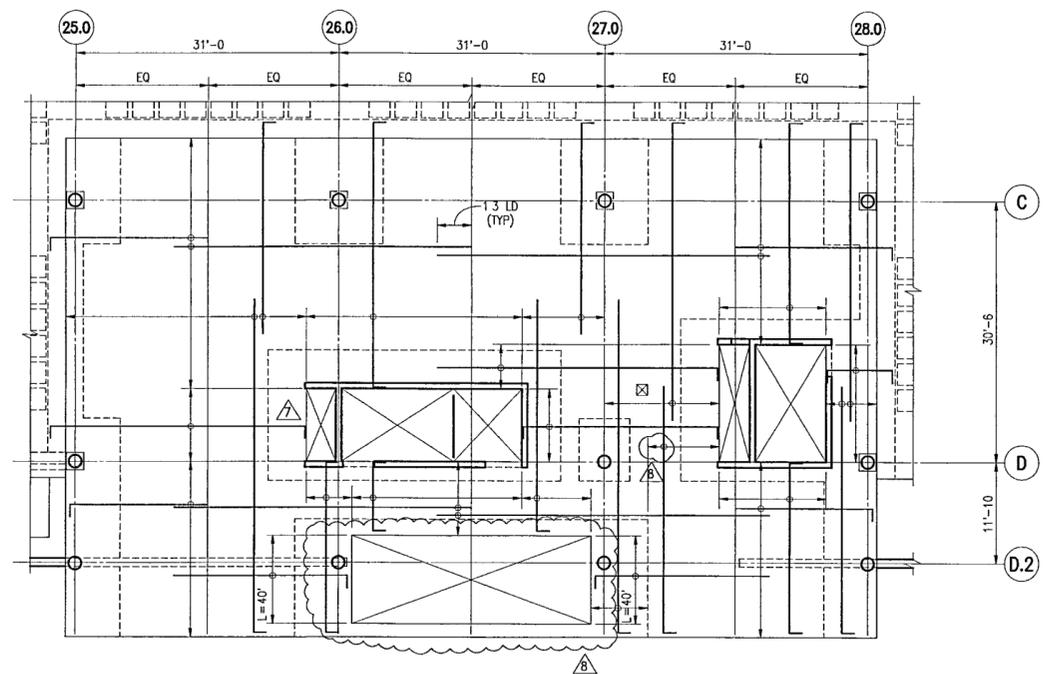

NOTES

- 1 PROVIDE #6@12 EACH WAY PLACE BARS PER LAYOUT SHOWN


B BASIC TOP REINFORCEMENT

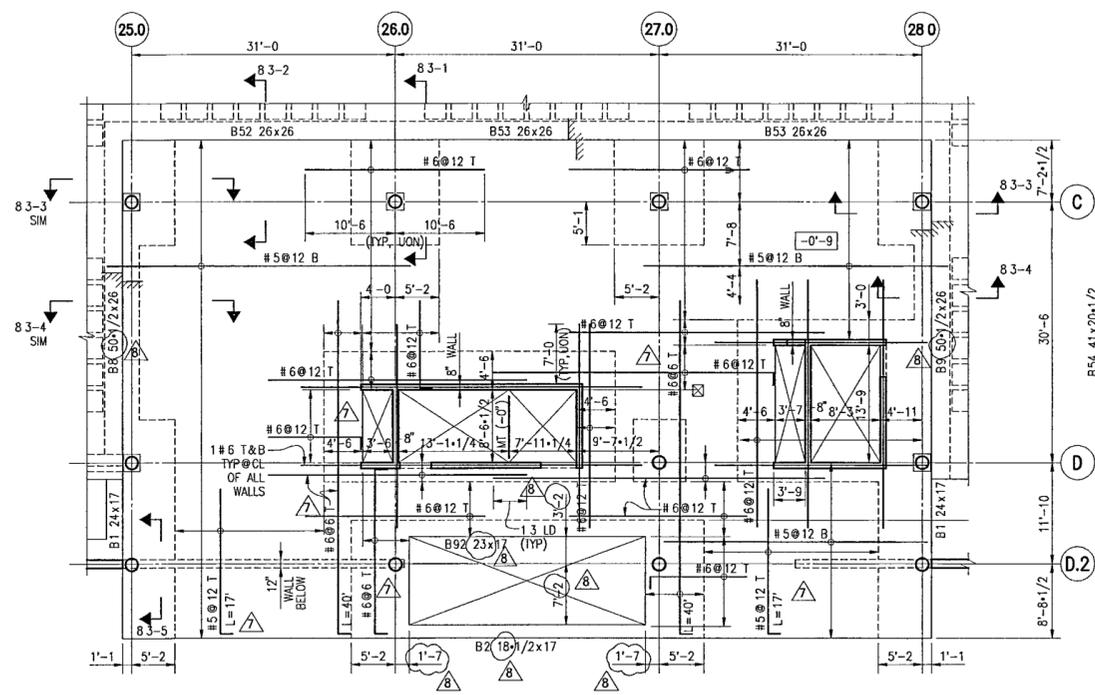

NOTES

- 1 PROVIDE ADDITIONAL TOP AND BOTTOM BARS SHOWN IN PLAN SEE B AND C FOR BASIC TOP AND BOTTOM REINFORCEMENT

A PLAN

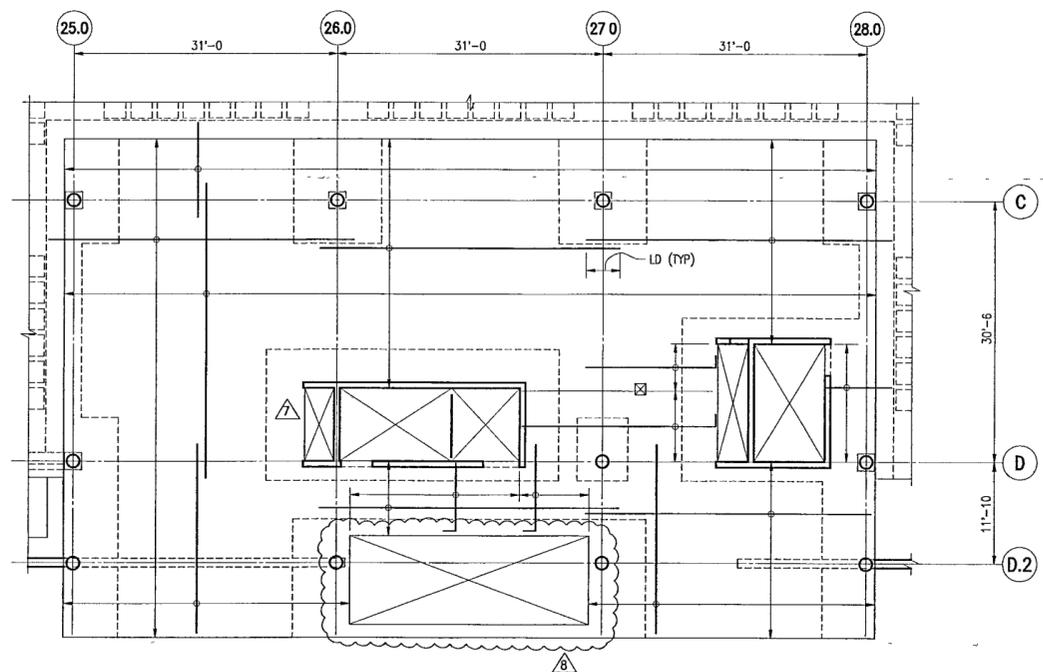

NOTES

- 1 PROVIDE #5@12 EACH WAY PLACE BARS PER LAYOUT SHOWN
- 2 EXTEND ALL BOTTOM BARS TO FAR FACE OF SUPPORT WHERE EXTENSION IS NOT 6" OR MORE, PROVIDE STANDARD HOOKS (EXTENSION NEED NOT EXCEED LDC UNLESS OTHERWISE NOTED)
- 3 AT LEAST TWO OF THE BOTTOM BARS AT SUPPORTS IN EACH DIRECTION SHALL PASS WITHIN THE COLUMN/WALL CORE AND SHALL BE ANCHORED AT EXTERIOR SUPPORTS

C BASIC BOTTOM REINFORCEMENT

NOTES

- 1 FOR NOTES SEE S102c
- 2 FLAT SLAB REINFORCEMENT IS AS SHOWN IN PLANS A, B AND C ABOVE. PROVIDE REINFORCEMENT SHOWN IN PLAN A IN ADDITION TO BASIC REINFORCEMENT SHOWN IN B AND C
- 3 PLACE REINFORCING BARS FOR FLAT SLAB IN THE FOLLOWING SEQUENCE UON

NORTH-SOUTH	BOTTOM BARS
EAST-WEST	BOTTOM BARS
EAST-WEST	TOP BARS
NORTH-SOUTH	TOP BARS

© Copyright LESLIE E. ROBERTSON ASSOCIATES R.L.L.P.
WARNING IT IS A VIOLATION OF LAW FOR ANY PERSON, UNLESS ACTING UNDER THE DIRECTION OF A PROFESSIONAL LICENSED IN THE STATE OF THIS PROJECT TO ALTER IN ANY WAY THESE DRAWINGS WHERE ANY ITEM IS ALTERED THE SUPERVISING PROFESSIONAL SHALL AFFIX TO THE ITEM HIS SEAL AND THE INSCRIPTION ALTERED BY FOLLOWED BY HIS SIGNATURE THE DATE AND A SPECIFIC DESCRIPTION OF THE ALTERATION

**WILLIAM J. CLINTON
PRESIDENTIAL
CENTER**

LITTLE ROCK, ARKANSAS

Architect
POLSHKE PARTNERSHIP LLP
320 West 13th Street
New York, New York 10014
212.607.7171

Coordinating Architects
POLK STANLEY YEARY ARCHITECTS Ltd
700 South Schiller Street
Little Rock, Arkansas 72201
501.378.0878

WITSELL EVANS RASCO
901 West Third Street
Little Rock, Arkansas 72201
501.374.5300

WOODS CARADINE ARCHITECTS
2200 South Main Street
Little Rock, Arkansas 72206
501.374.4060

Landscape Architects
HARGREAVES ASSOCIATES
118 Magazine Street
Cambridge, Massachusetts 02139
617.861.0070

LANDSCAPE ARCHITECTURE, Inc.
2300 Cottondale Lane Suite 202
Little Rock, Arkansas 72202
501.374.5610

Structural Engineer
LESLIE E. ROBERTSON ASSOC., RLLP
30 Broad Street, 47th Floor
New York, New York 10004
212.750.9000


MEP Engineers
FLACK + KURTZ Inc.
475 Fifth Avenue
New York, New York 10017
212.532.9600

CROWMELL ARCHITECTS ENGINEERS
101 South Spring Street
Little Rock, Arkansas 72201
501.372.2900

Curtainwall Consultant
R. A. HEINTGES ARCHITECTS
128 Fifth Avenue, 9th Floor
New York, New York 10011
212.652.2968

Seal

Issue	Date
10	100% CONSTRUCTION DOCS 06/27/02
9	90% PROGRESS PRINTING 06/30/02
8	SFS-8 06/07/02
7	SFS-6 06/02/02
6	100% STRUCTURAL CD 07/01/02
5	100% STL & CONC CD 05/15/02
4	BUILDING DEPT 03/18/02
3	BID ISSUE 03/01/02
2	75% DESIGN LEVEL 01/25/02
1	50% DESIGN LEVEL 12/19/01

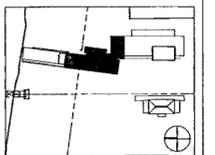


Job No 6908
Scale 1/8"=1'-0"
Date DEC 11, 2001
Title

MUSEUM LOWER
LEVEL PLAN

Sheet No
S103b

FOR OFFICIAL USE ONLY

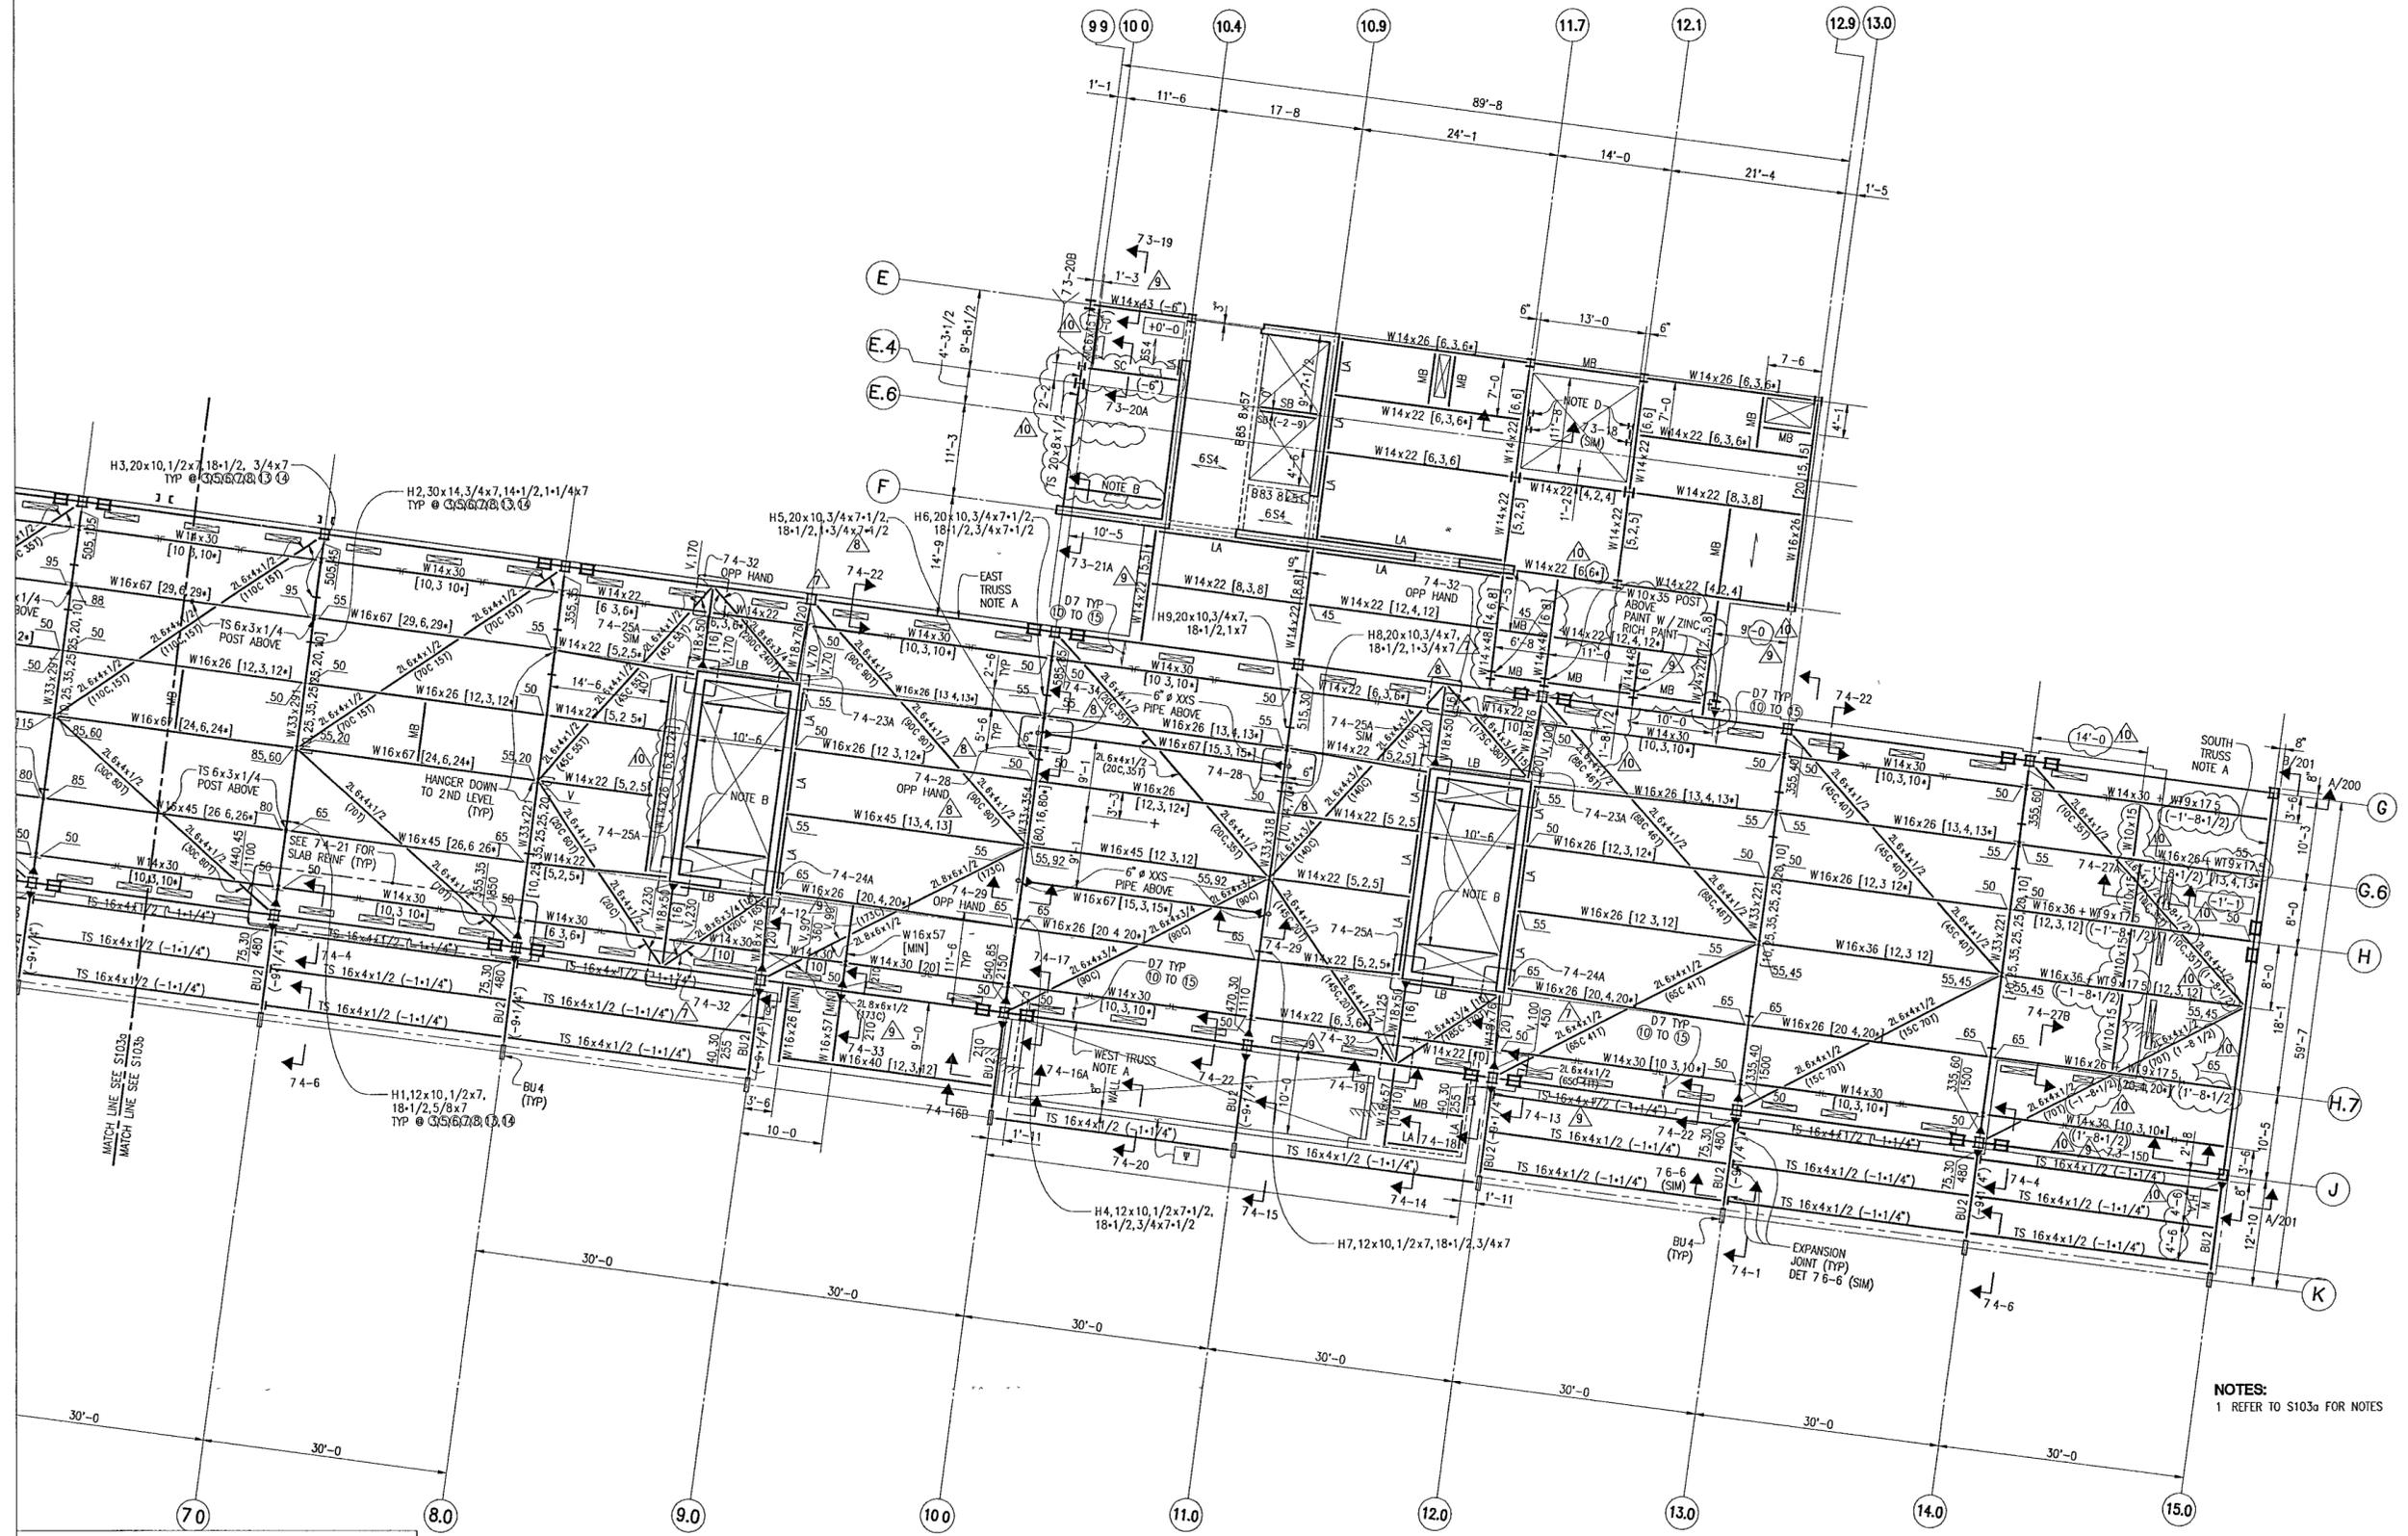

NOTES:
1 REFER TO S103a FOR NOTES

© Copyright LESLIE E. ROBERTSON ASSOCIATES, RLLP
WARNING IT IS A VIOLATION OF LAW FOR ANY PERSON UNLESS ACTING UNDER THE DIRECTION OF A PROFESSIONAL LICENSED IN THE STATE OF THIS PROJECT TO ALTER IN ANY WAY THESE DRAWINGS WHERE ANY ITEM IS ALTERED, THE SUPERVISING PROFESSIONAL SHALL AFFIX TO THE ITEM HIS SEAL AND THE INSCRIPTION ALTERED BY FOLLOWED BY HIS SIGNATURE, THE DATE, AND A SPECIFIC DESCRIPTION OF THE ALTERATION

**WILLIAM J CLINTON
PRESIDENTIAL
CENTER**

LITTLE ROCK, ARKANSAS

Architect
POLSHEK PARTNERSHIP LLP
323 West 53rd Street
New York, New York 10014
212 807 7171

Coordinating Architects
POLK STANLEY YEARY ARCHITECTS Ltd
700 South Schiller Street
Little Rock, Arkansas 72201
501 378 0878

WITSELL EVANS RASCO
901 West Third Street
Little Rock, Arkansas 72201
501 374.5300

WOODS CARADINE ARCHITECTS
2200 South Main Street
Little Rock, Arkansas 72206
501 374.4060

Landscape Architects
HARGREAVES ASSOCIATES
118 Magazine Street
Cambridge, Massachusetts 02139
617 661 0070

LANDSCAPE ARCHITECTURE, Inc.
2300 Cottondale Lane Suite 202
Little Rock, Arkansas 72202
501 374.5510

Structural Engineer
LESLIE E ROBERTSON ASSOC., RLLP
30 Broad Street, 47th Floor
New York, New York 10004
212 750 9000


MEP Engineers
FLACK + KURTZ Inc
475 Fifth Avenue
New York, New York 10017
212.532.9600

CROMWELL ARCHITECTS ENGINEERS
101 South Spring Street
Little Rock, Arkansas 72201
501.372.2900

Curtainwall Consultant
R. A. HEINTGES ARCHITECTS
126 Fifth Avenue, 9th Floor
New York, New York 10011
212 662-2966

Seal

Issue	Date
11	100% CONSTRUCTION DOCS 09/27/02
7	90% PROGRESS PRINTING 08/30/02
6	100% STRUCTURAL CD 07/01/02
5	100% STL & CONC CD 05/15/02
4	BUILDING DEPT 03/18/02
3	BID ISSUE 03/01/02
2	75% DESIGN DEVEL. 01/25/02
1	50% DESIGN DEVEL. 12/19/01

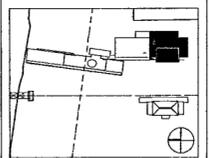

Job No 9908

Scale 1/8"=1'-0"

Date DEC 11, 2001


Title

**THIRD LEVEL
PLAN**

Sheet No

S103c


FOR OFFICIAL USE ONLY

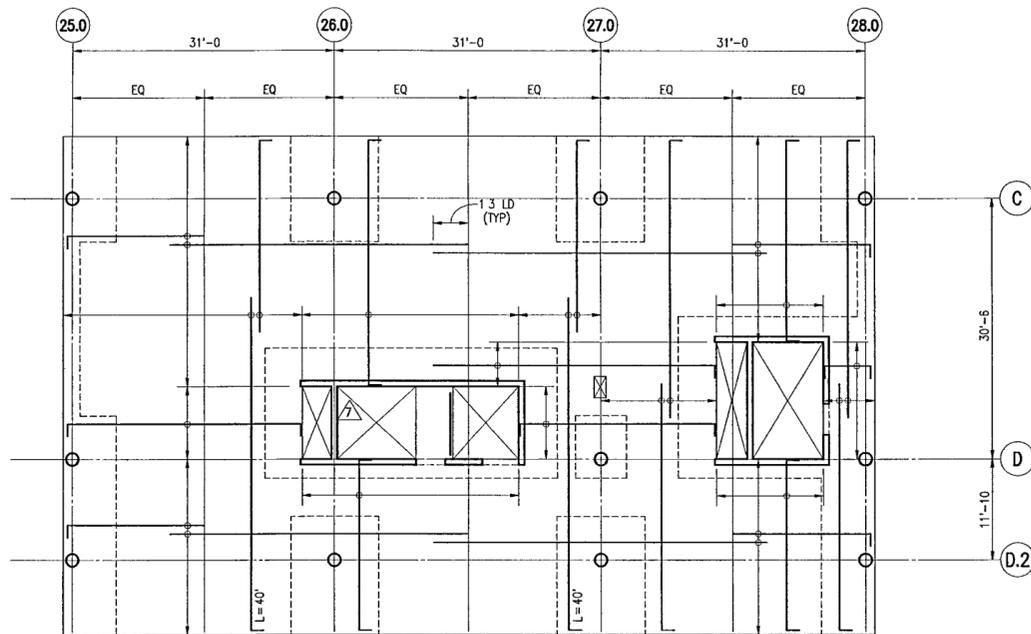

NOTES:

- 1 PROVIDE #6@12 EACH WAY PLACE BARS PER LAYOUT SHOWN


B BASIC TOP REINFORCEMENT

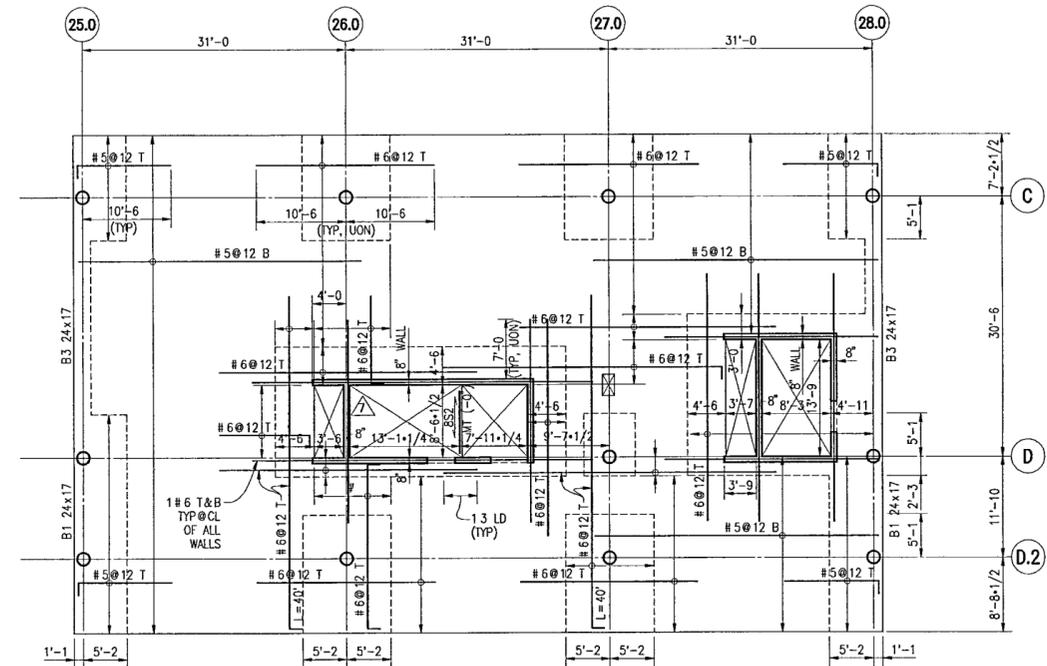

NOTES:

- 1 PROVIDE ADDITIONAL TOP AND BOTTOM BARS SHOWN IN PLAN SEE B AND C FOR BASIC TOP AND BOTTOM REINFORCEMENT

A PLAN

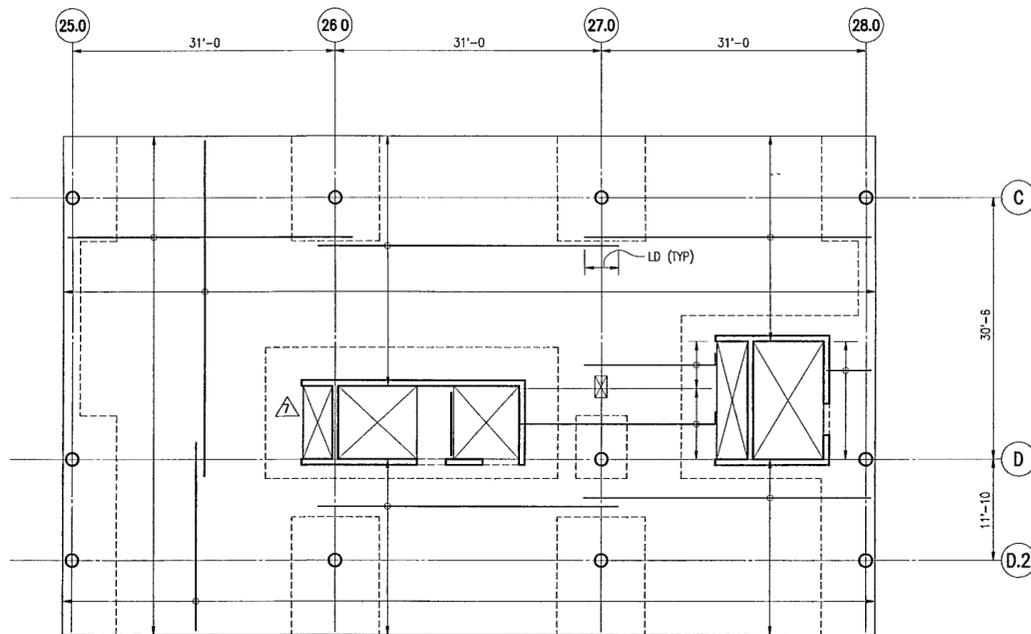

NOTES:

- 1 PROVIDE #5@12 EACH WAY PLACE BARS PER LAYOUT SHOWN
- 2 EXTEND ALL BOTTOM BARS TO FAR FACE OF SUPPORT WHERE EXTENSION IS NOT 6" OR MORE, PROVIDE STANDARD HOOKS (EXTENSION NEED NOT EXCEED LDC UNLESS OTHERWISE NOTED)
- 3 AT LEAST TWO OF THE BOTTOM BARS AT SUPPORTS IN EACH DIRECTION SHALL PASS WITHIN THE COLUMN/WALL CORE AND SHALL BE ANCHORED AT EXTERIOR SUPPORTS

C BASIC BOTTOM REINFORCEMENT

NOTES:

- 1 REFER TO THE STRUCTURAL DRAWING BOOK FOR GENERAL NOTES, TYPICAL DETAILS, SCHEDULES AND ALL REFERENCED DETAILS AND SECTIONS REFER TO S220 SERIES DRAWINGS FOR WALL ELEVATIONS AND REINFORCEMENT REFER TO SLAB EDGE DRAWINGS FOR SLAB EDGE LOCATIONS AND DIMENSIONS
- 2 TOP OF CONCRETE IS AT REFERENCE ELEVATION +27'-3, UNLESS OTHERWISE NOTED (XXX), WHERE XXX IS MEASURED WITH RESPECT TO REFERENCE ELEVATION
- 3 FLOOR CONSTRUCTION IS 9" NORMAL WEIGHT CONCRETE FLAT SLAB WITH 8" DROP PANELS, UNLESS OTHERWISE NOTED
- 4 TOP OF STRUCTURAL STEEL IS (-0') BELOW REFERENCE ELEVATION UNLESS OTHERWISE NOTED
- 5 CONCRETE STRENGTH AND WEIGHT
SLABS F'C = 4000 PSI, NW
WALLS & COLUMNS F'C = 4000 PSI, NW
- 6 CONCRETE BEAMS ARE DESIGNATED BxD WHERE B IS THE WIDTH IN INCHES AND D IS THE DEPTH (INCLUDING THE SLAB) IN INCHES
- 7 PLACE REINFORCING BARS FOR FLAT SLAB IN THE FOLLOWING SEQUENCE UON
NORTH-SOUTH BOTTOM BARS
EAST-WEST TOP BARS
EAST-WEST TOP BARS
NORTH-SOUTH TOP BARS
- 8 SLAB REINFORCEMENT IS AS SHOWN IN PLANS A, B AND C ABOVE PROVIDE REINFORCEMENT SHOWN IN PLAN A IN ADDITION TO BASIC REINFORCEMENT SHOWN IN B AND C
- 9 MT=MINIMUM TUBE, TS6x4x5/16 FY46
MB=MINIMUM BEAM W12x22 FY50
- 10 ▽ INDICATES INFORMATION TO BE PROVIDED BY ARCHITECT

© Copyright LESLIE E. ROBERTSON ASSOCIATES, R.L.L.P.
WARNING IT IS A VIOLATION OF LAW FOR ANY PERSON UNLESS ACTING UNDER THE DIRECTION OF A PROFESSIONAL LICENSED IN THE STATE OF THIS PROJECT, TO ALTER IN ANY WAY THESE DRAWINGS WHERE ANY ITEM IS ALTERED, THE SUPERVISING PROFESSIONAL SHALL AFFIX TO THE ITEM HIS SEAL AND THE INSCRIPTION ALTERED BY FOLLOWED BY HIS SIGNATURE, THE DATE AND A SPECIFIC DESCRIPTION OF THE ALTERATION

**WILLIAM J CLINTON
PRESIDENTIAL
CENTER**

LITTLE ROCK, ARKANSAS

Architect

POLSHEK PARTNERSHIP LLP
320 West 13th Street
New York, New York 10014
212 607 7171

Coordinating Architects

POLK STANLEY YEARY ARCHITECTS Ltd
700 South Schaller Street
Little Rock, Arkansas 72201
501.378.0878

WITSELL EVANS RASCO
901 West Third Street
Little Rock, Arkansas 72201
501.374.5300

WOODS CARADINE ARCHITECTS
2200 South Main Street
Little Rock, Arkansas 72206
501.374.4060

Landscape Architects

HARGREAVES ASSOCIATES
118 Magazine Street
Cambridge, Massachusetts 02139
617.861.0070

LANDSCAPE ARCHITECTURE, Inc
2300 Cottondale Lane Suite 202
Little Rock, Arkansas 72202
501.374.5610

Structural Engineer

LESLIE E. ROBERTSON ASSOC., RLLP
30 Broad Street, 4th Floor
New York, New York 10004
212.750.9000

MEP Engineers

FLACK + KURTZ Inc.
475 Fifth Avenue
New York, New York 10017
212.532.9600


CROMWELL ARCHITECTS ENGINEERS
101 South Spring Street
Little Rock, Arkansas 72201
501.372.2900

Curriculum Consultant

R. A. HEINTGES ARCHITECTS
128 Fifth Avenue, 9th Floor
New York, New York 10011
212.652.2968

Seal


9	100% CONSTRUCTION DOCS	09/27/02
8	80% PROGRESS PRINTING	08/30/02
7	SFS-9	08/15/02
6	100% STRUCTURAL CD	07/01/02
5	100% STL & CONC CD	05/15/02
4	BUILDING DEPT	03/18/02
3	BID ISSUE	03/01/02
2	75% DESIGN DEVEL	01/25/02
1	50% DESIGN DEVEL	12/19/01
Issue		Date

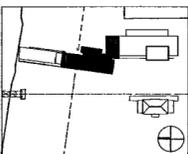

Job No. 9908
Scale 1/8"=1'-0"
Date DEC 11, 2001
Title

**MUSEUM UPPER
LEVEL PLAN**

Sheet No. **S104b**

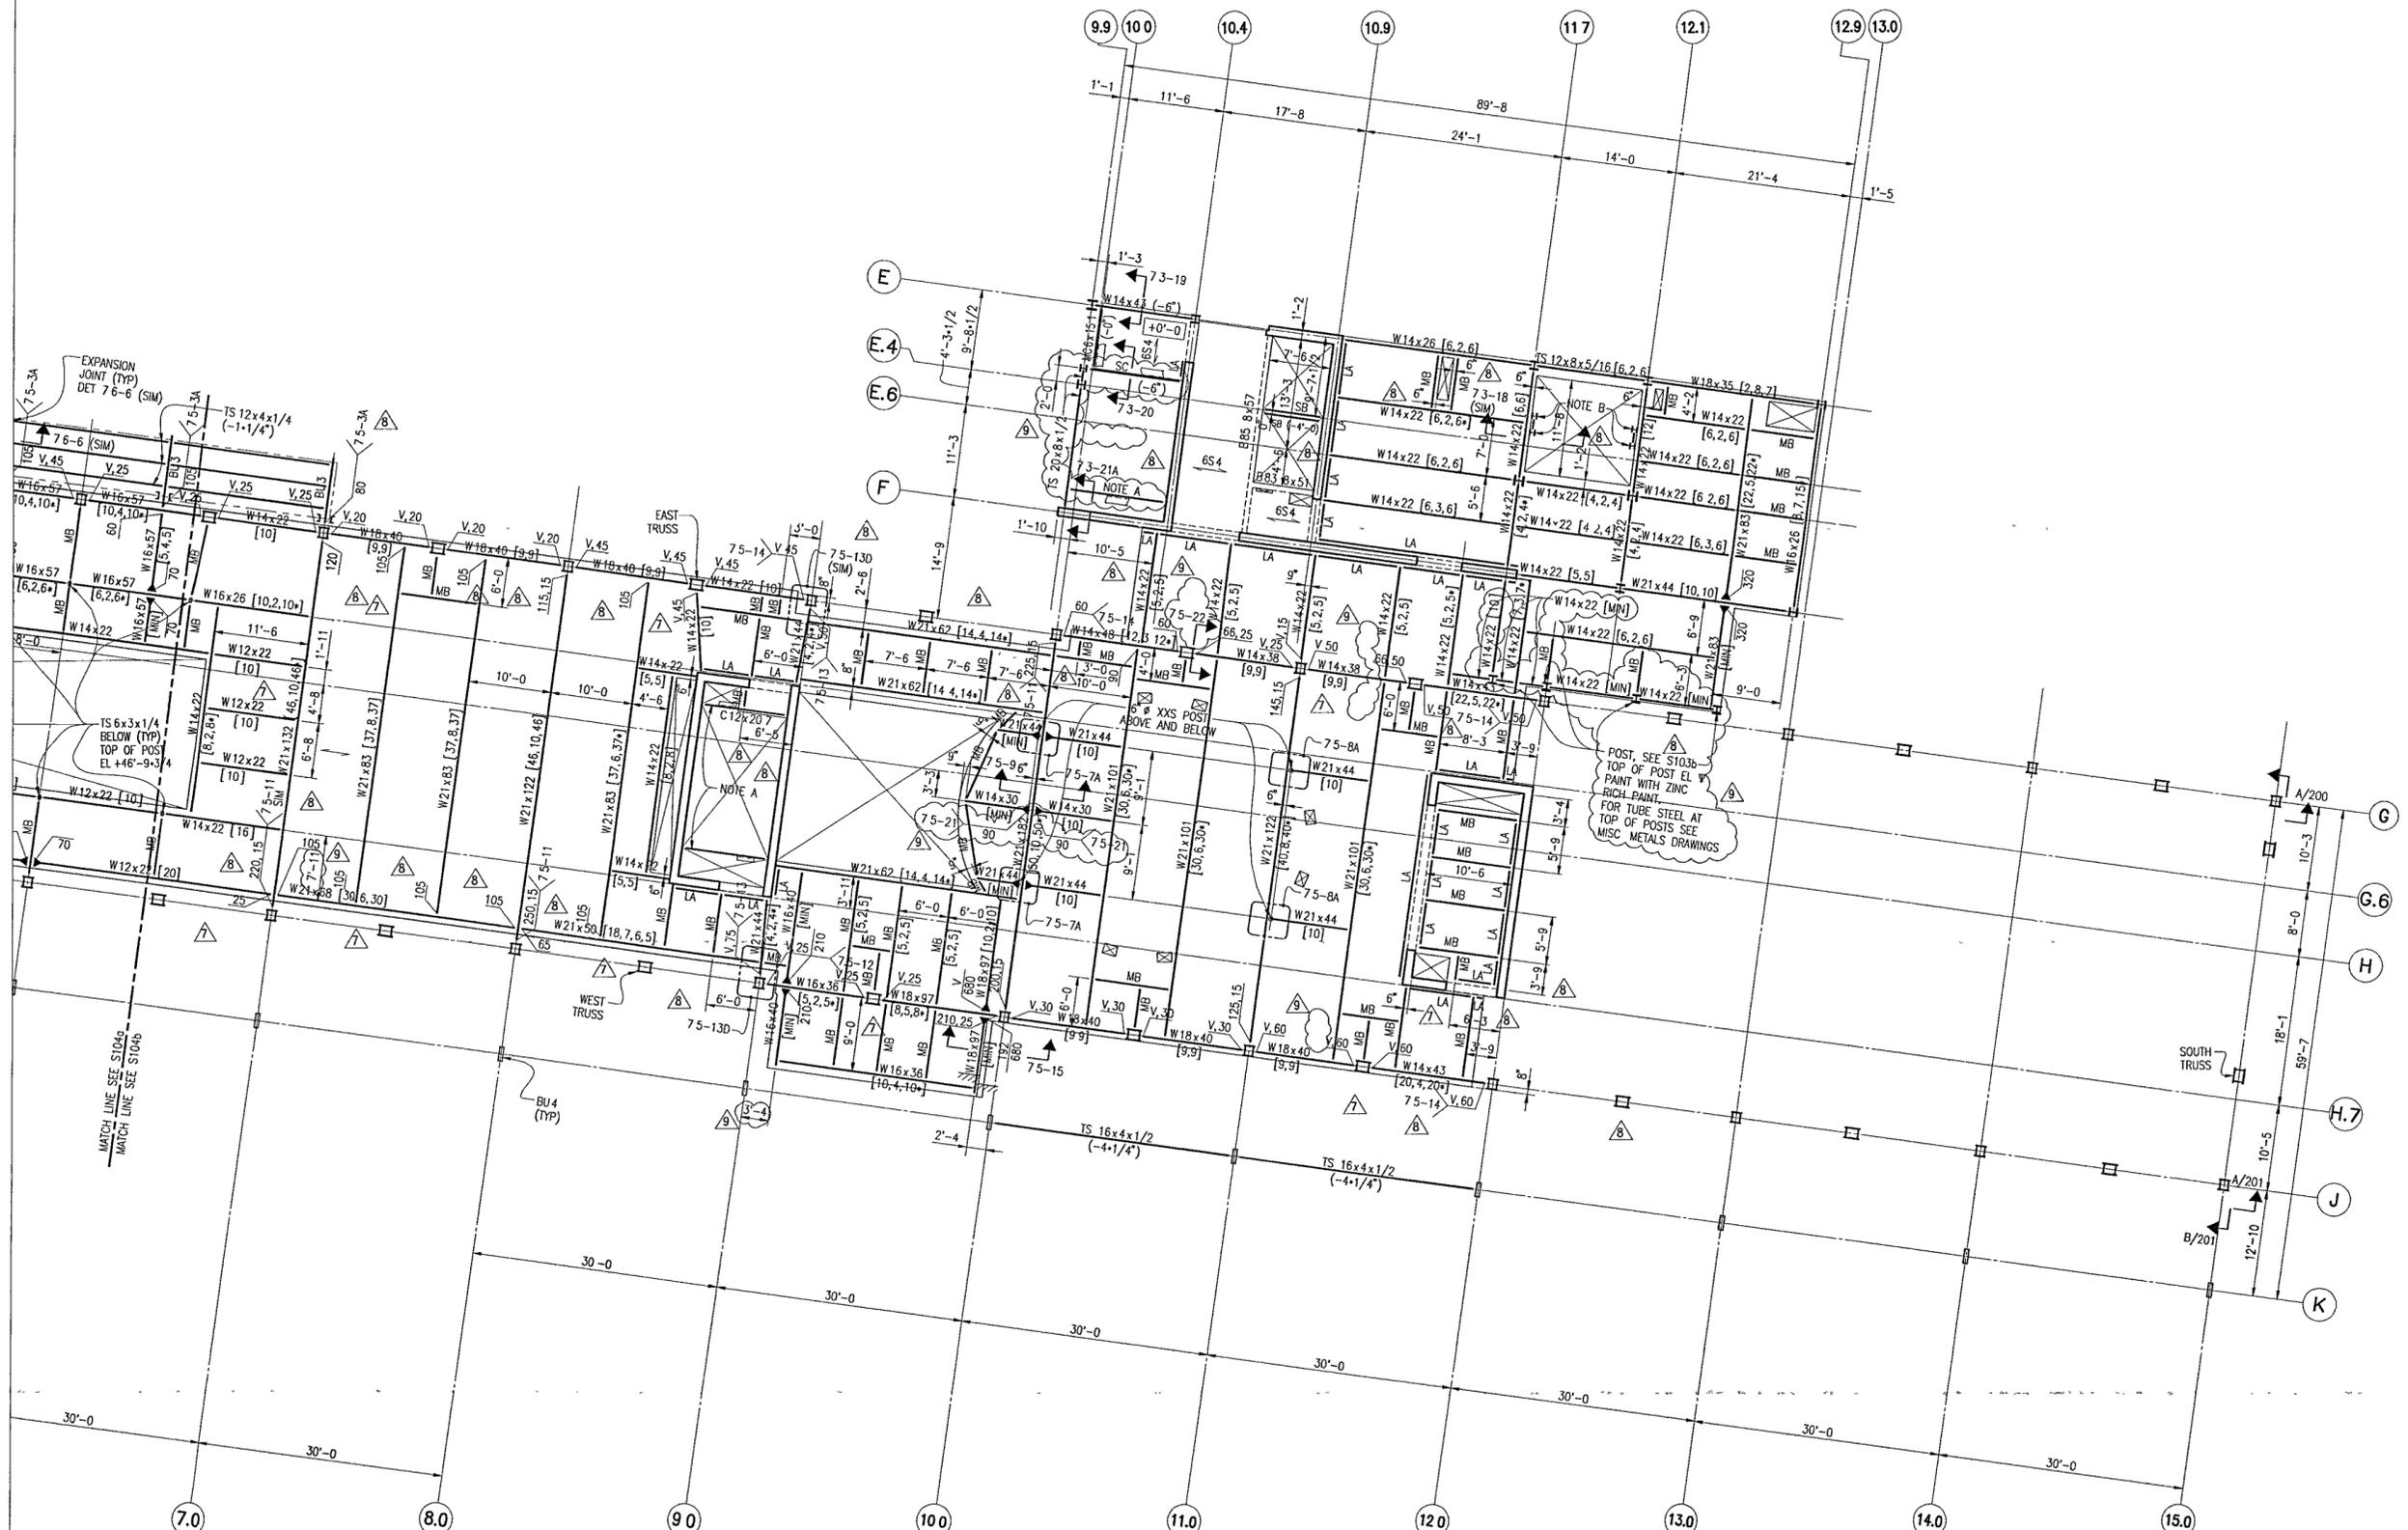

**WILLIAM J CLINTON
PRESIDENTIAL
CENTER**

LITTLE ROCK, ARKANSAS

Architect
POLSHAK PARTNERSHIP LLP
320 West 13th Street
New York, New York 10014
212.697.7171

Coordinating Architects
POLK STANLEY YEARY ARCHITECTS LTD
700 South Schiller Street
Little Rock, Arkansas 72201
501.378.0878

WITSELL EVANS RASCO
801 West Third Street
Little Rock, Arkansas 72201
501.374.5300

WOODS CARADINE ARCHITECTS
2200 South Main Street
Little Rock, Arkansas 72206
501.374.4060

Landscape Architects
HARGREAVES ASSOCIATES
118 Magazine Street
Cambridge, Massachusetts 02139
617.661.0070

LANDSCAPE ARCHITECTURE, Inc.
2300 Cottondale Lane Suite 202
Little Rock, Arkansas 72202
501.374.5610

Structural Engineer
LESLIE E. ROBERTSON ASSOC. RLLP
30 Broad Street, 47th Floor
New York, New York 10004
212.750.9000


MEP Engineers
FLACK + KURTZ Inc
475 Fifth Avenue
New York, New York 10017
212.632.9600

CROMWELL ARCHITECTS ENGINEERS
101 South Spring Street
Little Rock, Arkansas 72201
501.372.2900

Curtainwall Consultant
R. A. HEINTGES ARCHITECTS
126 Fifth Avenue, 9th Floor
New York, New York 10011
212.652.2966

Seal

8	100% CONSTRUCTION DOCS	09/27/02
7	50% PROGRESS PRINTING	08/30/02
6	100% STRUCTURAL CD	07/01/02
5	100% STL & CONC CD	05/15/02
4	BUILDING DEPT	03/18/02
3	BID ISSUE	03/01/02
2	75% DESIGN DEVEL	01/25/02
1	50% DESIGN DEVEL	12/19/01

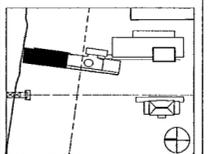

Job No 9908
Scale 1/8"=1'-0"
Date DEC 11, 2001
Title

EXECUTIVE
LEVEL PLAN

Sheet No
S105a

NOTES:


- REFER TO THE STRUCTURAL DRAWING BOOK FOR GENERAL NOTES TYPICAL DETAILS, SCHEDULES AND ALL REFERENCED DETAILS AND SECTIONS REFER TO S110 SERIES DRAWINGS FOR ADDITIONAL SLAB REINFORCEMENT AND S220 SERIES DRAWINGS FOR WALL ELEVATIONS AND REINFORCEMENT REFER TO EDGE OF SLAB DRAWINGS FOR SLAB EDGE LOCATIONS AND DIMENSIONS
- TOP OF CONCRETE IS 1'-3" BELOW REFERENCE ELEVATION +62'-1" UNLESS OTHERWISE NOTED [XXX], WHERE XXX IS MEASURED WITH RESPECT TO REFERENCE ELEVATION
- TOP OF STRUCTURAL STEEL IS (-1'-9+1/2") BELOW REFERENCE ELEVATION UNLESS OTHERWISE NOTED
- FLOOR CONSTRUCTION IS 3+1/2" LIGHTWEIGHT CONCRETE (F'C=3 KSI) OVER 3" COMPOSITE DECK, TYPE D5, UNLESS OTHERWISE NOTED
- STEEL DECK SPANS THE SHORT SPAN DIRECTION UNLESS NOTED PROVIDE PERMANENT DECK SUPPORTS AT COLUMNS
- SOLID CONCRETE SLAB IS INDICATED THIS IS A FORMED SLAB, THERE IS NO STEEL DECK

- CONCRETE STRENGTH AND WEIGHT
SLAB ON DECK F'C = 3000 PSI, LW
WALLS F'C = 4000 PSI, NW
COLUMNS F'C = 4000 PSI, NW
SLAB ON DECK BETWEEN GRIDS (8) AND (12) AND WEST OF (8) (IN AREA OF RESIDENCE) F'C = 4000 PSI, LW, UON
- STRUCTURAL STEEL SHAPES SHALL BE FY50 UNLESS OTHERWISE NOTED CONNECTION PLATES SHALL BE FY36 U O N
PIPES SHALL BE FY36
TUBES SHALL BE FY46
- INTERIOR WALLS ARE 12" CONCRETE WALLS UNLESS OTHERWISE NOTED
- NUMBER OF 3/4" x 5+1/2" LONG STUD SHEAR CONNECTORS APPLIED TO THE TOP FLANGE OF BEAM IS NOTED THIS []
- SB=ELEVATOR SEPARATOR BEAM, TS6x4x5/16
SC=STAIR HEADER CHANNEL, C12x20.7 FY36
MB=MINIMUM BEAM, W12x22 [MIN]
LA=L3x3x5/16 DECK SUPPORT ANGLE
CO=C10x15.3 [MIN]
TB=TROLLEY BEAM = (S12x50) PAINTED
LOCATE TOP OF BEAM 2" BELOW SOFFIT OF NEAREST SLAB

- INDICATES MOMENT CONNECTION
- CAMBER IN INCHES IS GIVEN THUS, C
- INDICATES INFORMATION TO BE PROVIDED BY ARCHITECT

REFERENCED NOTES:

- WHERE NOTED, SLABS AND BEAMS SHALL BE F'C=4000 PSI, NW
- PROVIDE 3/4" x 6" LONG STUD SHEAR CONNECTORS @ 2'-0" O C APPLIED TO THE TOP FLANGE OF TRUSS CHORDS
- SEE 7-2-18 FOR ADDITIONAL STEEL FRAMING IN CONCRETE CORES

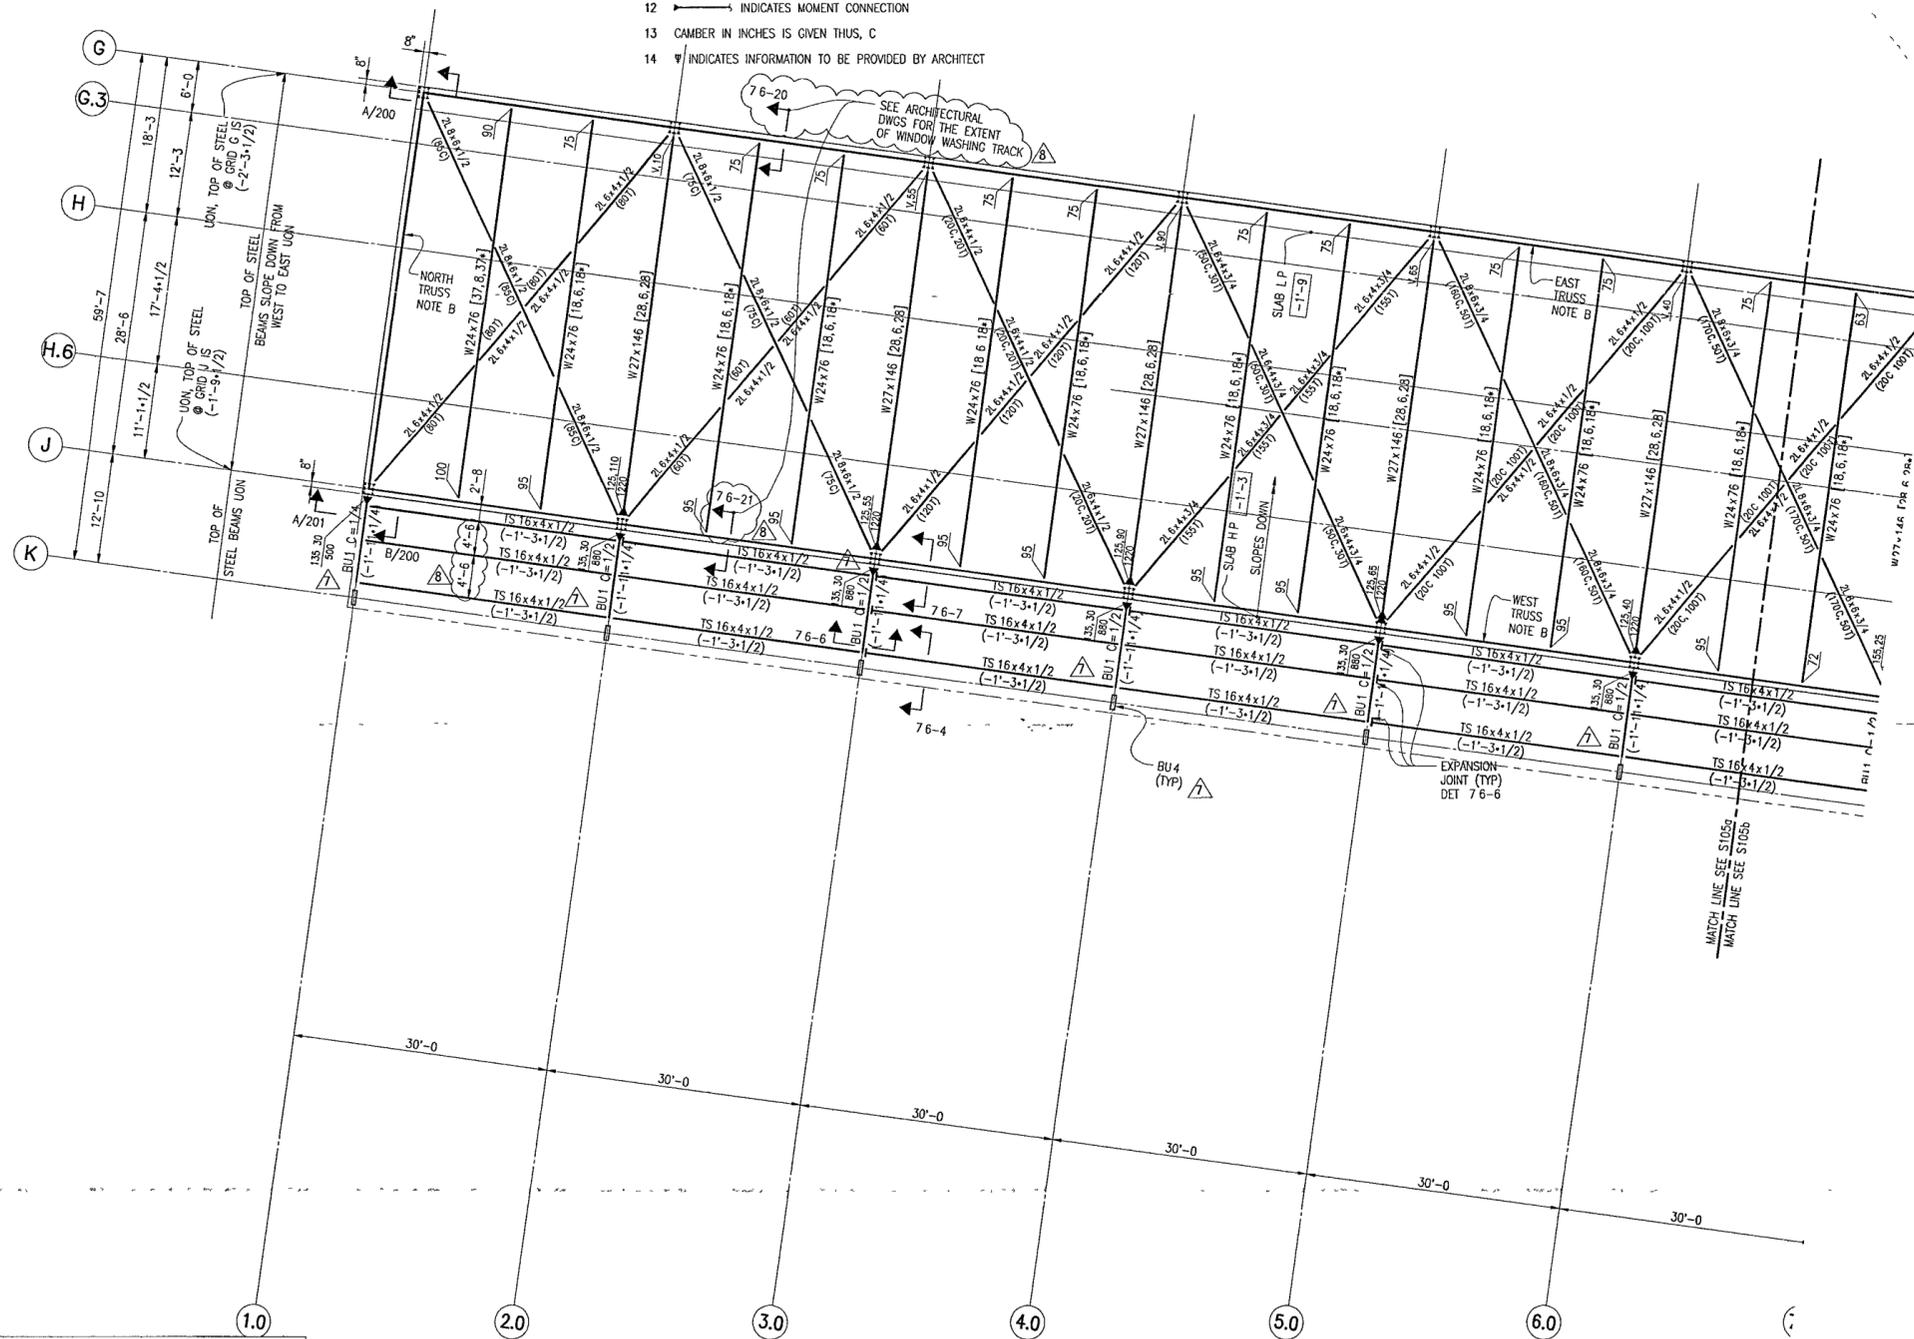

© Copyright LESLIE E. ROBERTSON ASSOCIATES R.L.L.P.
WARNING IT IS A VIOLATION OF LAW FOR ANY PERSON UNLESS ACTING UNDER THE DIRECTION OF A PROFESSIONAL LICENSED IN THE STATE OF THIS PROJECT, TO ALTER IN ANY WAY THESE DRAWINGS WHERE ANY ITEM IS ALTERED THE SUPERVISING PROFESSIONAL SHALL AFFIX TO THE ITEM HIS SEAL AND THE INSCRIPTION "ALTERED BY FOLLOWED BY HIS SIGNATURE, THE DATE, AND A SPECIFIC DESCRIPTION OF THE ALTERATION"

**WILLIAM J. CLINTON
PRESIDENTIAL
CENTER**

LITTLE ROCK, ARKANSAS

Architect

POLSHAK PARTNERSHIP LLP
320 West 13th Street
New York, New York 10014
212.607.7171

Coordinating Architects

POLK STANLEY YEARY ARCHITECTS LTD
700 South Schiller Street
Little Rock, Arkansas 72201
501.378.0878

WITSELL EVANS RASCO

901 West Third Street
Little Rock, Arkansas 72201
501.374.5300

WOODS CARADINE ARCHITECTS

2200 South Main Street
Little Rock, Arkansas 72206
501.374.4060

Landscape Architects

HARGREAVES ASSOCIATES
118 Magazine Street
Cambridge, Massachusetts 02139
617.661.0070

Structural Engineer

LESLIE E. ROBERTSON ASSOC, RLLP
30 Broad Street, 4th Floor
New York, New York 10004
212.750.9000

MEP Engineers

FLACK + KURTZ Inc.
475 Fifth Avenue
New York, New York 10017
212.532.9600

CROWMELL ARCHITECTS ENGINEERS


101 South Spring Street
Little Rock, Arkansas 72201
501.372.2900

Curtainwall Consultant

R.A. HEINTGES ARCHITECTS
126 Fifth Avenue 9th Floor
New York, New York 10011
212.652.2966

Seal

9	100% CONSTRUCTION DOCS	09/22/02
8	SFS-15	09/18/02
7	90% PROGRESS PRINTING	08/30/02
6	100% STRUCTURAL CD	07/01/02
5	100% STL & CONC CD	05/15/02
4	BUILDING DEPT	03/18/02
3	BID ISSUE	03/01/02
2	75% DESIGN DEVEL.	01/25/02
1	50% DESIGN DEVEL.	12/19/01
	Issue	Date

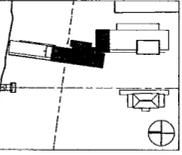

Job No. 9908

Scale 1/8"=1'-0"

Date DEC 11, 2001


Title

EXECUTIVE LEVEL PLAN

Sheet No.

S105b

FOR OFFICIAL USE ONLY

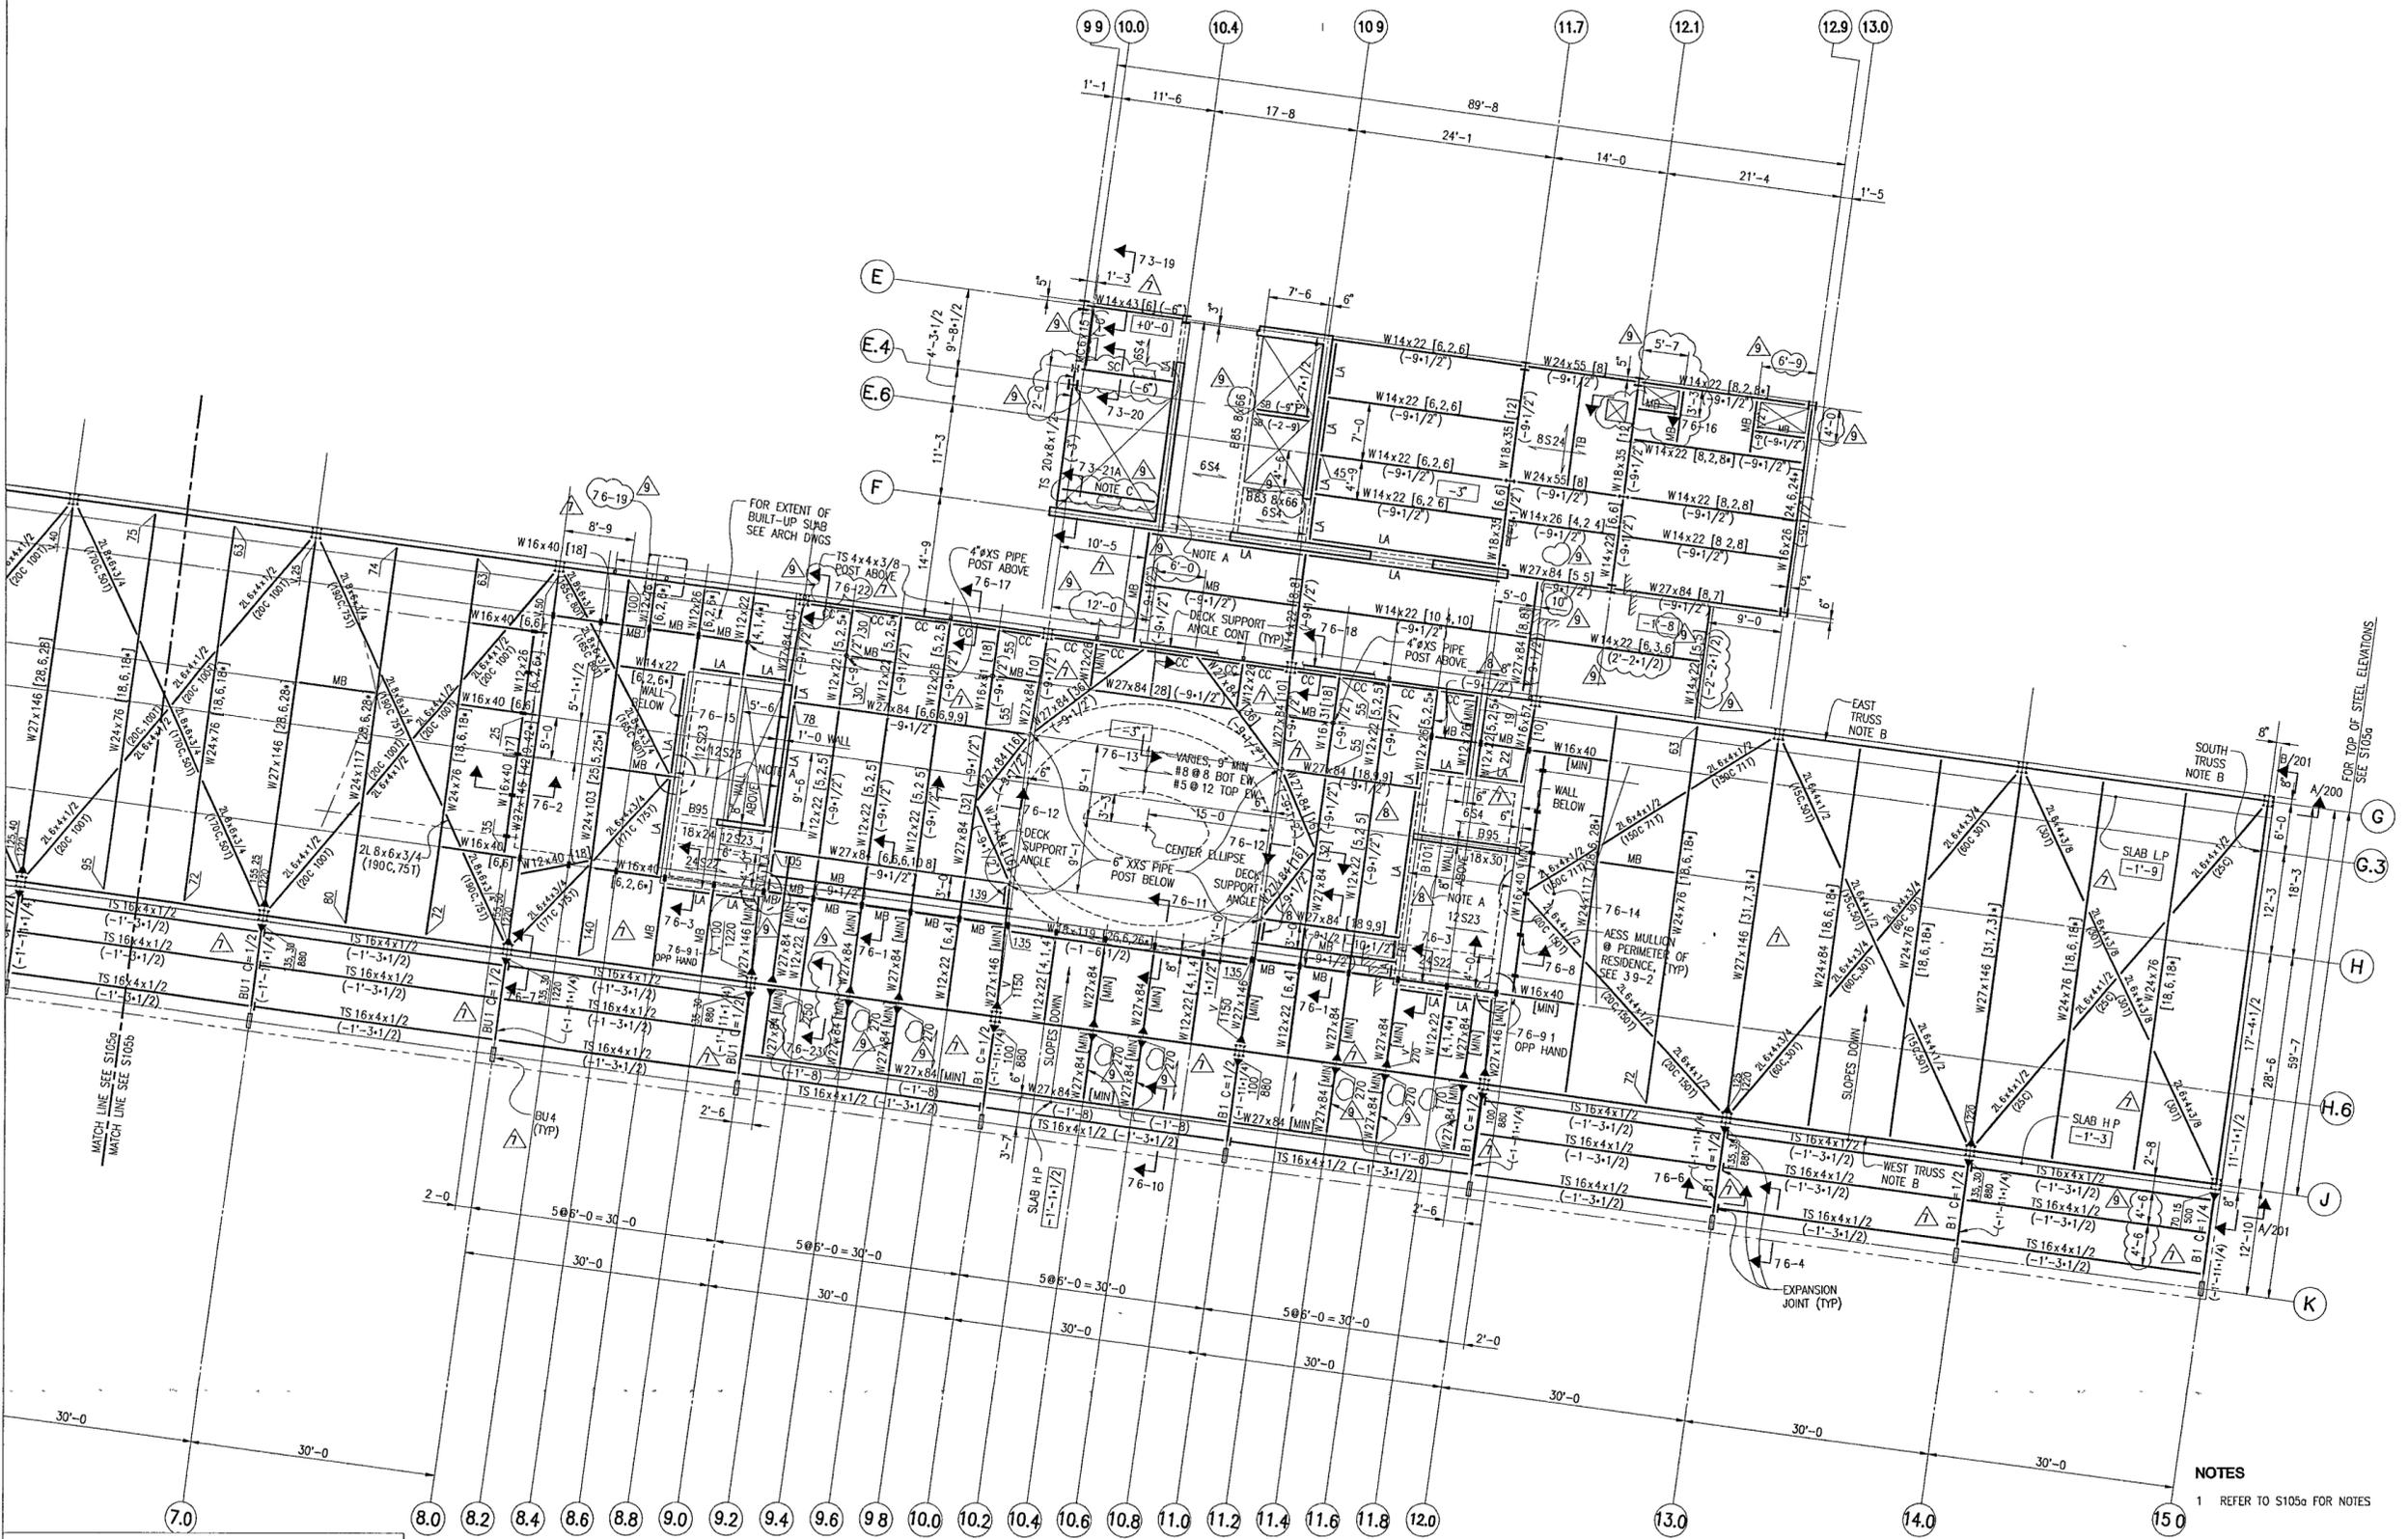

NOTES

1 REFER TO S105a FOR NOTES

© Copyright LESLIE E. ROBERTSON ASSOCIATES, RLLP
WARNING IT IS A VIOLATION OF LAW FOR ANY PERSON, UNLESS ACTING UNDER THE DIRECTION OF A PROFESSIONAL, LICENSED UNDER THE STATE OF THIS PROJECT, TO ALTER IN ANY WAY THESE DRAWINGS WHERE ANY ITEM IS ALTERED THE SUPERVISING PROFESSIONAL SHALL AFFIX TO THE ITEM HIS SEAL AND THE INSCRIPTION "ALTERED BY" FOLLOWED BY HIS SIGNATURE, THE DATE AND A SPECIFIC DESCRIPTION OF THE ALTERATION



NOTES

- REFER TO THE STRUCTURAL DRAWING BOOK FOR GENERAL NOTES, TYPICAL DETAILS, SCHEDULES AND ALL REFERENCED DETAILS AND SECTIONS REFER TO S110 SERIES DRAWINGS FOR ADDITIONAL SLAB REINFORCEMENT AND S220 SERIES DRAWINGS FOR WALL ELEVATIONS AND REINFORCEMENT REFER TO EDGE OF SLAB DRAWINGS FOR SLAB EDGE LOCATIONS AND DIMENSIONS NOT SHOWN
- TOP OF CONCRETE IS AT REFERENCE ELEVATION +75'-1, UNLESS OTHERWISE NOTED [XXX], WHERE XXX IS MEASURED WITH RESPECT TO REFERENCE ELEVATION
- TOP OF STRUCTURAL STEEL IS (-5'-1/2') BELOW REFERENCE ELEVATION UNLESS OTHERWISE NOTED
TOP OF STRUCTURAL STEEL AT GRID G 3 IS (-1'-4), UON
TOP OF STRUCTURAL STEEL AT GRID H 6 VARIES AND IS GIVEN THUS, [XXX], AT CENTERLINE OF MULLION WHERE XXX IS MEASURED WITH RESPECT TO REFERENCE ELEVATION
FOR STEEL BEAMS LOCATED BETWEEN GRIDS G 3 AND H 6, LOCATE TOP OF STRUCTURAL STEEL TO MATCH SLOPE BETWEEN GRIDS G 3 AND H 6, UON
- FLOOR CONSTRUCTION IS 3-1/2" LIGHTWEIGHT CONCRETE (FC=3 KSI) OVER 2" COMPOSITE DECK, TYPE D6, UNLESS OTHERWISE NOTED
- STEEL DECK SPANS THE SHORT SPAN DIRECTION UNLESS NOTED PROVIDE PERMANENT DECK SUPPORTS AT COLUMNS
- SOLID CONCRETE SLAB IS INDICATED THIS IS A FORMED SLAB, THERE IS NO STEEL DECK

- CONCRETE STRENGTH AND WEIGHT
SLAB ON DECK FC = 3000 PSI, LW
COLUMNS FC = 4000 PSI, NW
WALLS FC = 4000 PSI, NW
FORMED SLAB FC = 4000 PSI, NW
- STRUCTURAL STEEL SHAPES SHALL BE FY50 UNLESS OTHERWISE NOTED CONNECTION PLATES SHALL BE FY36 U O N
PIPES SHALL BE FY36
TUBES SHALL BE FY46
- NUMBER OF 3/4"x4+1/2" LONG STUD SHEAR CONNECTORS APPLIED TO THE TOP FLANGE OF BEAM IS NOTED THUS []
- SB=ELEVATOR SEPARATOR BEAM, TS6x4x5/16
SC=STAIR HEADER CHANNEL, C12x20 7 FY36
MB=MINIMUM BEAM, W12x22 [MIN]
MBR=W8x18 [8]
LA=L3x3x5/16 DECK SUPPORT ANGLE
TB=TROLLEY BEAM=(S12x50) PAINTED
LOCATE TOP OF BEAM 2' BELOW SOFFIT OF NEAREST SLAB
- INDICATES MOMENT CONNECTION
- CAMBER IN INCHES IS GIVEN THUS, C
- INDICATES INFORMATION TO BE PROVIDED BY ARCHITECT

REFERENCED NOTES

A SEE 7.2-18 FOR ADDITIONAL STEEL FRAMING IN CONCRETE CORE

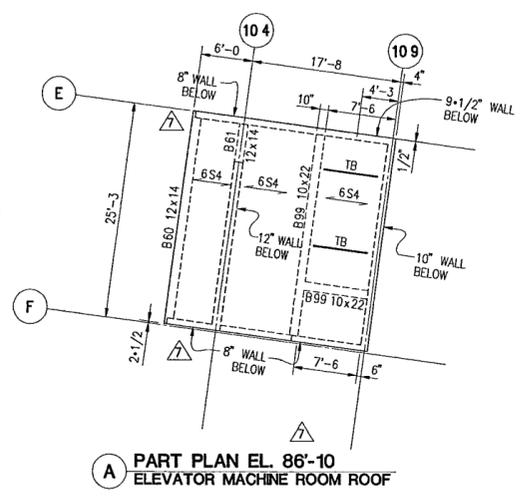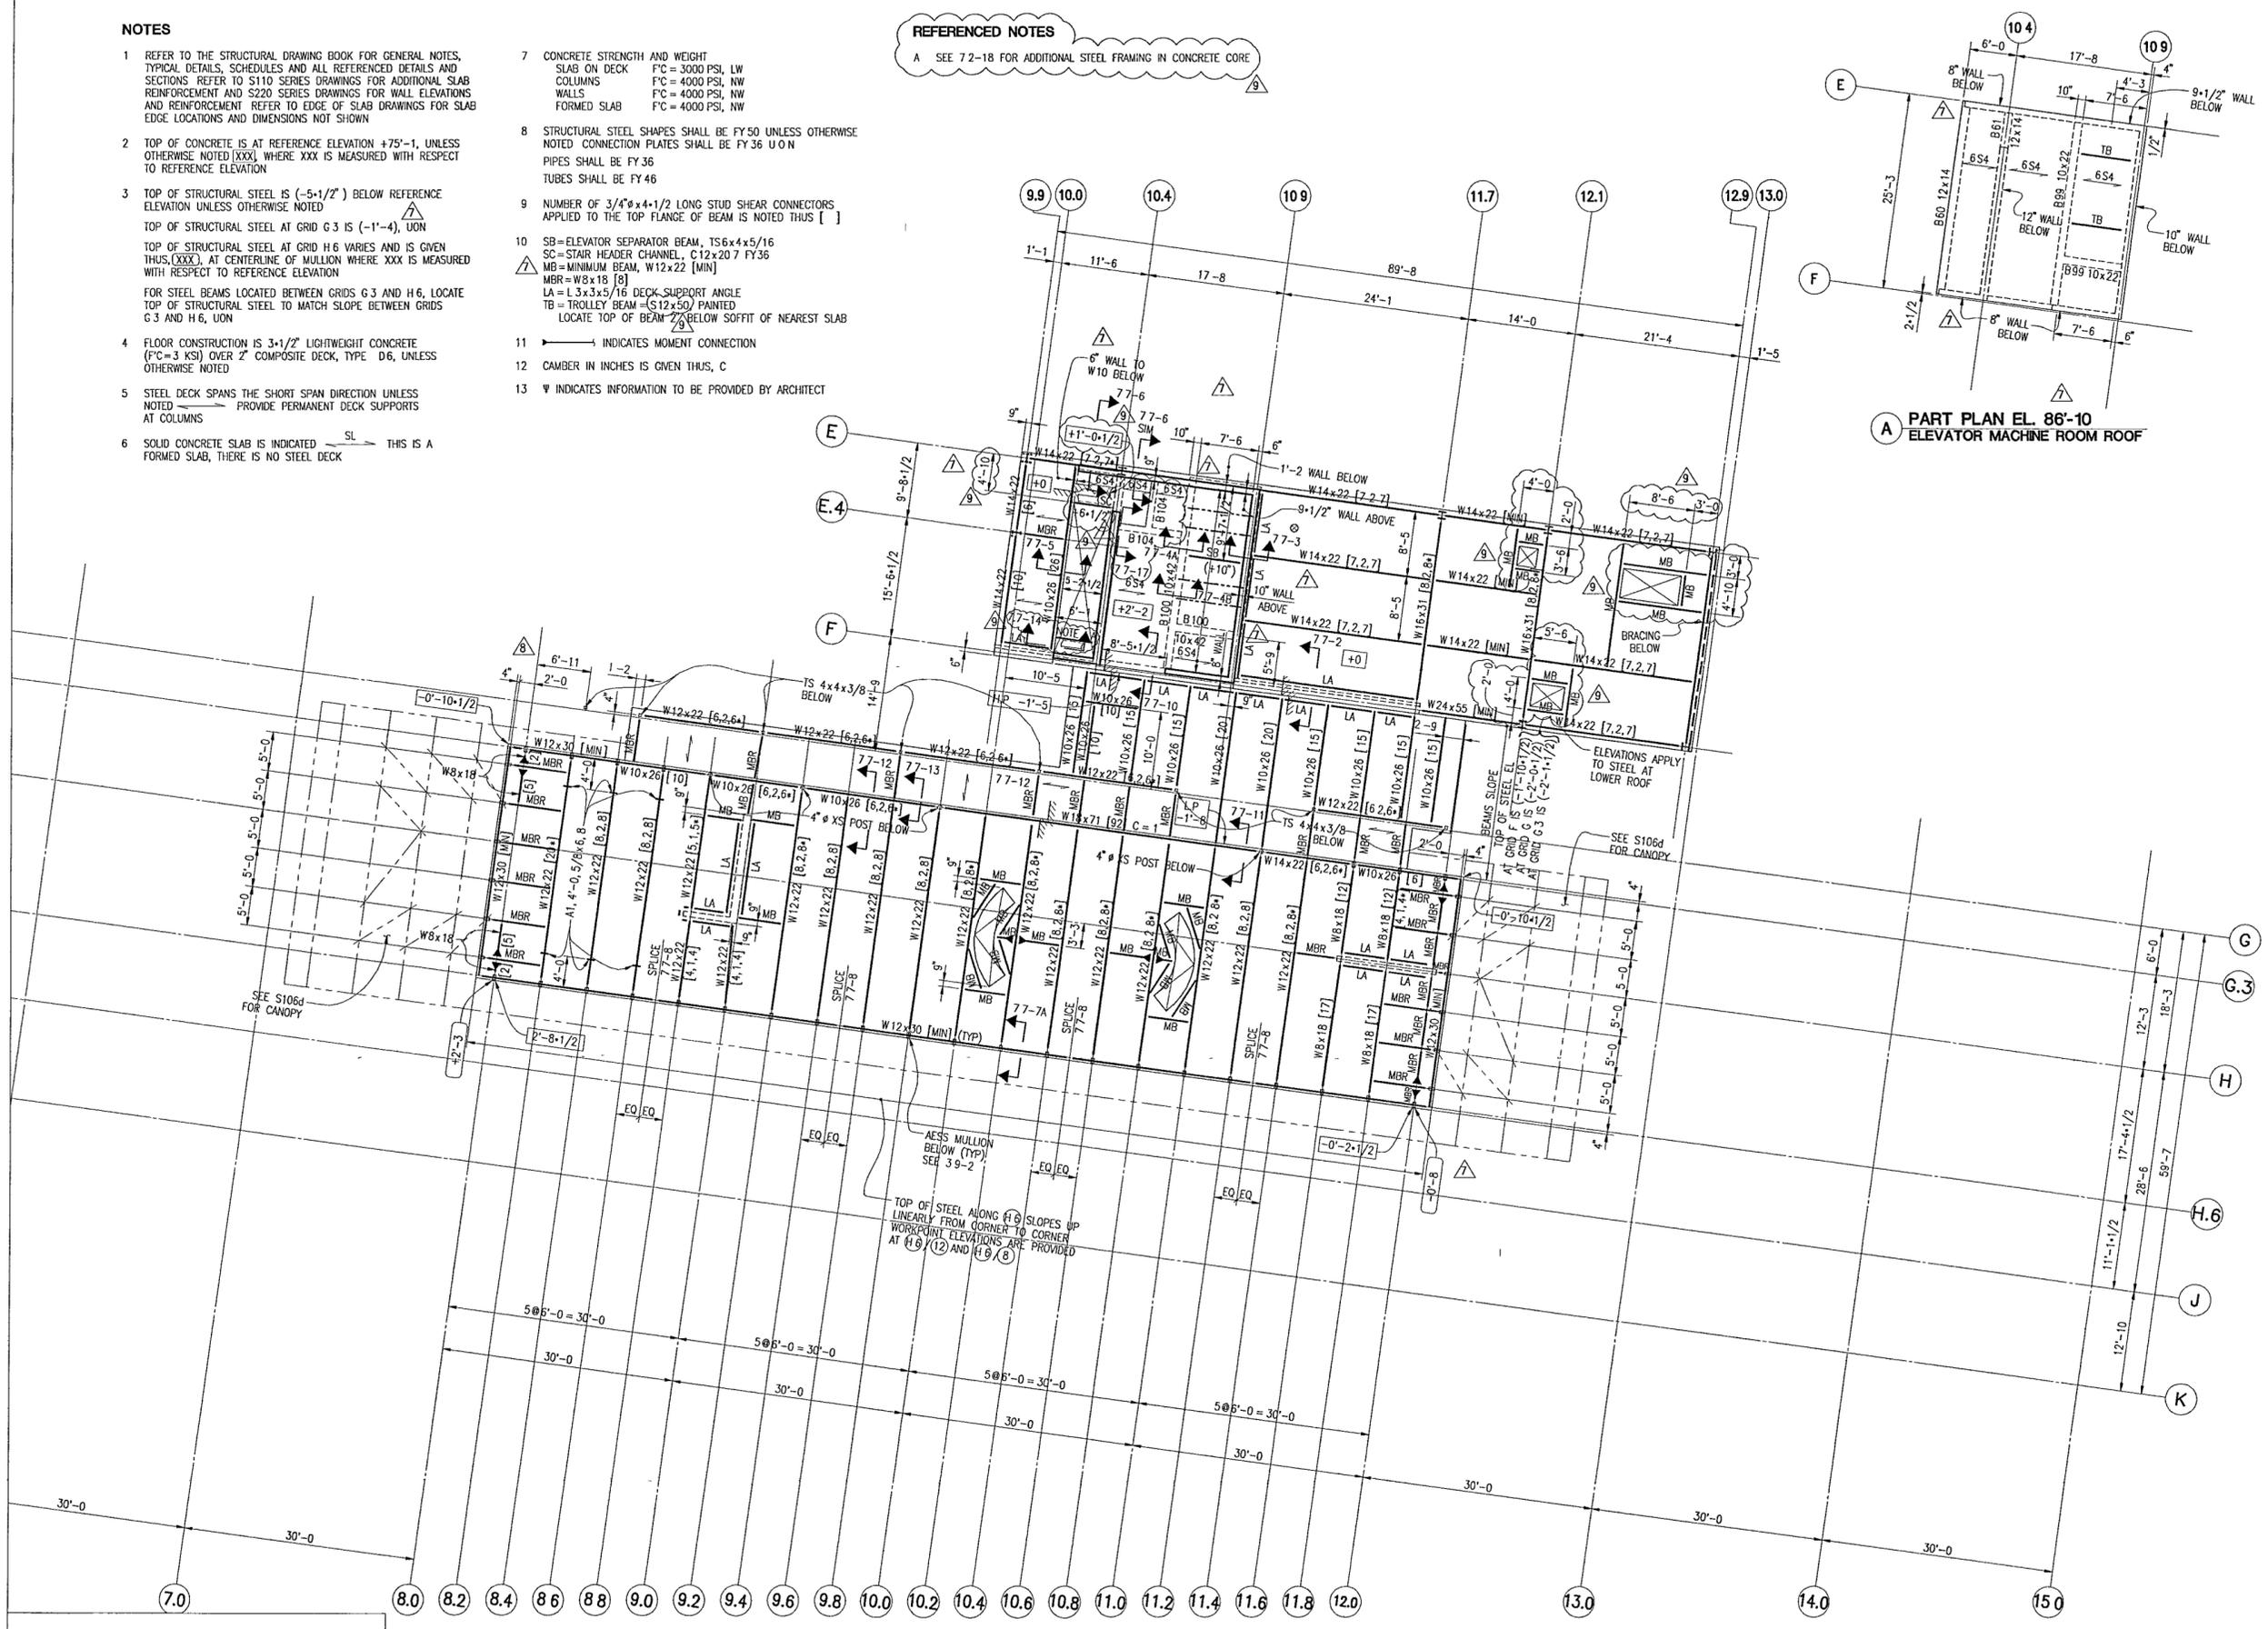

© Copyright LESLIE E ROBERTSON ASSOCIATES, R.L.L.P.
WARNING IT IS A VIOLATION OF LAW FOR ANY PERSON, UNLESS ACTING UNDER THE DIRECTION OF A PROFESSIONAL LICENSED IN THE STATE OF THIS PROJECT TO ALTER IN ANY WAY THESE DRAWINGS WHERE ANY ITEM IS ALTERED THE SUPERVISING PROFESSIONAL SHALL AFFIX TO THIS ITEM HIS SEAL AND THE INSCRIPTION "ALTERED BY" FOLLOWED BY HIS SIGNATURE, THE DATE, AND A SPECIFIC DESCRIPTION OF THE ALTERATION

WILLIAM J. CLINTON PRESIDENTIAL CENTER
 LITTLE ROCK, ARKANSAS

Architect
 POLSHEK PARTNERSHIP LLP
 320 South Scholar Street
 New York, New York 10014
 212.807.7171

Coordinating Architects
 POLK STANLEY YEARY ARCHITECTS Ltd
 700 South Scholar Street
 Little Rock, Arkansas 72201
 501.378.0878

WITSELL EVANS RASCO
 501 West Third Street
 Little Rock, Arkansas 72201
 501.374.5300

WOODS GARADINE ARCHITECTS
 2200 South Main Street
 Little Rock, Arkansas 72206
 501.374.4060

Landscape Architects
 HARGREAVES ASSOCIATES
 118 Magazine Street
 Cambridge, Massachusetts 02139
 617.661.0070

LANDSCAPE ARCHITECTURE, Inc.
 2300 Cottondale Lane Suite 202
 Little Rock, Arkansas 72202
 501.374.5610

Structural Engineer
 LESLIE E ROBERTSON ASSOC RLLP
 30 Broad Street, 47th Floor
 New York, New York 10004
 212.750.9000

MEP Engineers
 FLACK + KURTZ Inc.
 475 Fifth Avenue
 New York, New York 10017
 212.532.9600


CROWMELL ARCHITECTS ENGINEERS
 101 South Spring Street
 Little Rock, Arkansas 72201
 501.372.2500

Curtainwall Consultant
 R. A. HEINTGES ARCHITECTS
 126 Fifth Avenue 9th Floor
 New York, New York 10011
 212.652.2968

Issue	Date
9	100% CONSTRUCTION DOCS 09/27/02
8	SFS-13 09/11/02
7	90% PROGRESS PRINTING 08/30/02
6	100% STRUCTURAL CD 07/01/02
5	100% STL & CONC CD 05/15/02
4	BUILDING DEPT 03/18/02
3	BID ISSUE 03/01/02
2	75% DESIGN DEVEL 01/25/02
1	50% DESIGN DEVEL 12/19/01

Job No 8908
 Scale 1/8"=1'-0
 Date DEC 11, 2001
 Title EXECUTIVE ROOF PLAN
 Sheet No **S106b**


FOR OFFICIAL USE ONLY

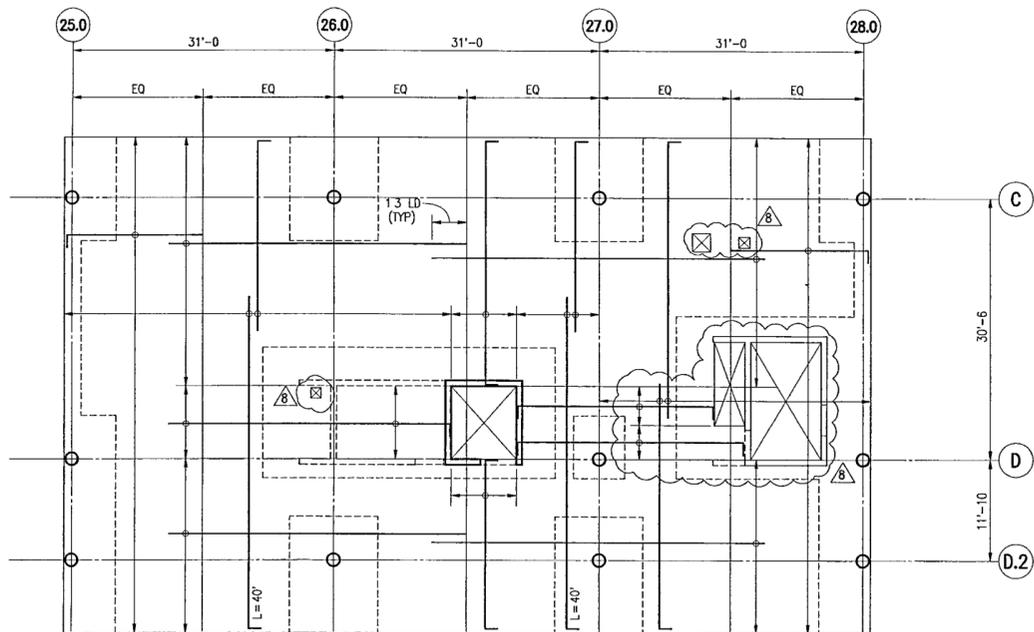

NOTES:

- 1 PROVIDE #6 @ 10 EACH WAY PLACE BARS PER LAYOUT SHOWN


B BASIC TOP REINFORCEMENT

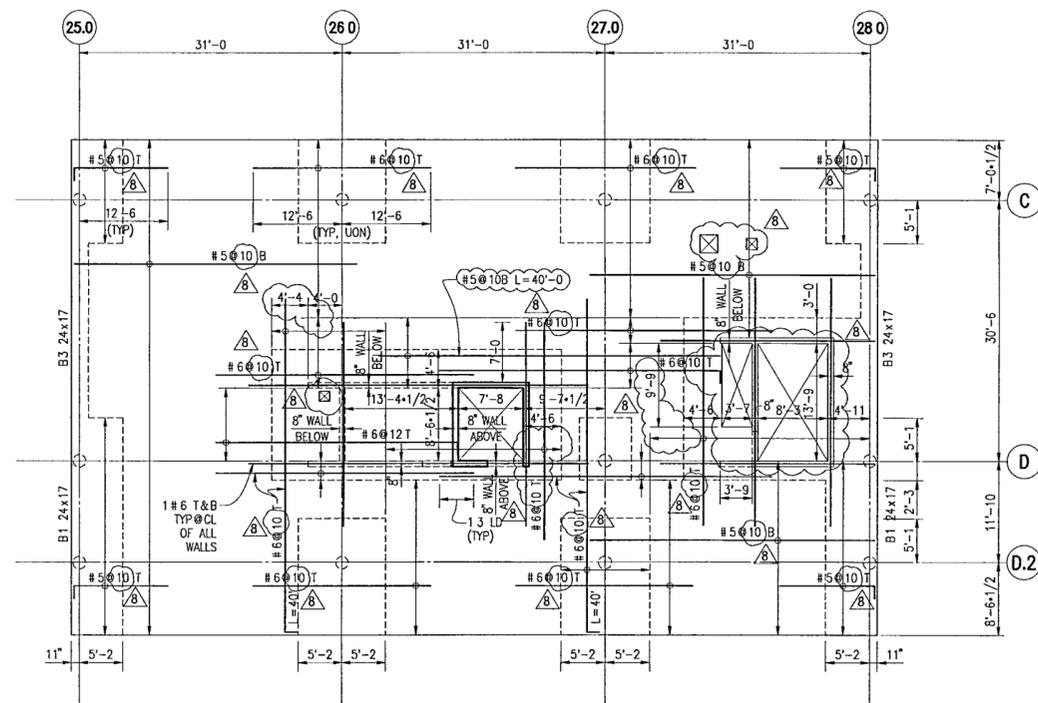

NOTES:

- 1 PROVIDE ADDITIONAL TOP AND BOTTOM BARS SHOWN IN PLAN SEE B AND C FOR BASIC TOP AND BOTTOM REINFORCEMENT


A PLAN

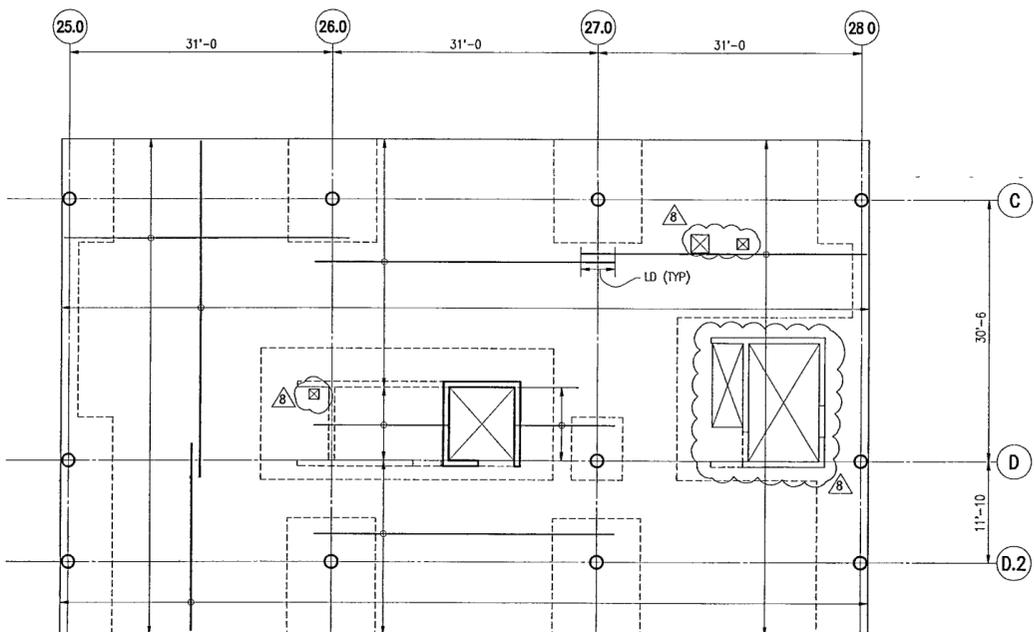

NOTES:

- 1 PROVIDE #5 @ 10 EACH WAY PLACE BARS PER LAYOUT SHOWN
- 2 EXTEND ALL BOTTOM BARS TO FAR FACE OF SUPPORT WHERE EXTENSION IS NOT 6" OR MORE, PROVIDE STANDARD HOOKS (EXTENSION NEED NOT EXCEED LDC UNLESS OTHERWISE NOTED)
- 3 AT LEAST TWO OF THE BOTTOM BARS AT SUPPORTS IN EACH DIRECTION SHALL PASS WITHIN THE COLUMN/WALL CORE AND SHALL BE ANCHORED AT EXTERIOR SUPPORTS

C BASIC BOTTOM REINFORCEMENT

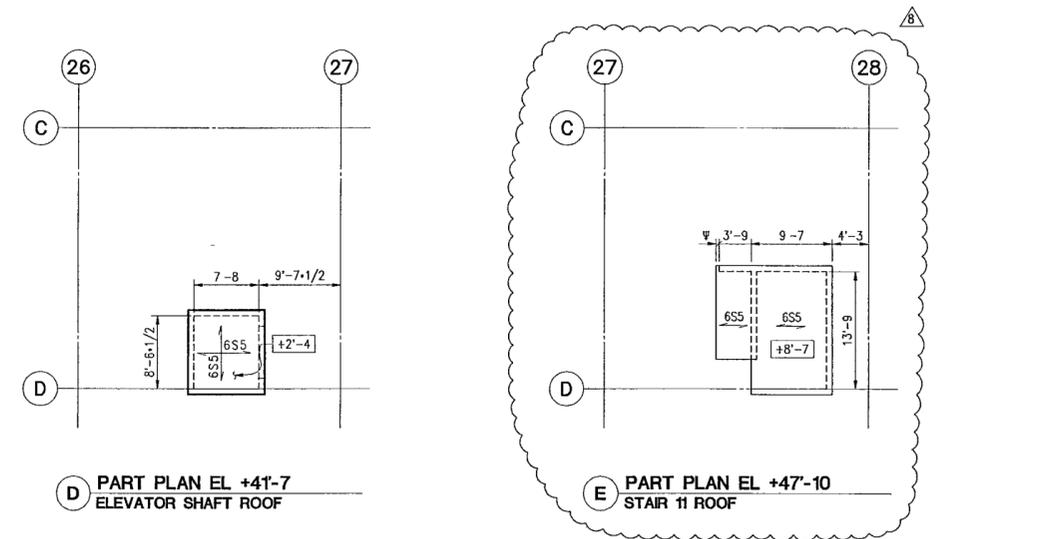

NOTES:

- 1 REFER TO THE STRUCTURAL DRAWING BOOK FOR GENERAL NOTES, TYPICAL DETAILS, SCHEDULES AND ALL REFERENCED DETAILS AND SECTIONS REFER TO S220 SERIES DRAWINGS FOR WALL ELEVATIONS AND REINFORCEMENT REFER TO SLAB EDGE DRAWINGS FOR SLAB EDGE LOCATIONS AND DIMENSIONS
- 2 TOP OF CONCRETE IS AT REFERENCE ELEVATION +39'-3, UNLESS OTHERWISE NOTED [XXX], WHERE XXX IS MEASURED WITH RESPECT TO REFERENCE ELEVATION
- 3 FLOOR CONSTRUCTION IS 9" NORMAL WEIGHT CONCRETE FLAT SLAB WITH 8" DROP PANELS UNLESS OTHERWISE NOTED
- 4 INTERIOR WALLS ARE 8" CONCRETE WALLS UNLESS OTHERWISE NOTED PROVIDE MINIMUM WALL REINFORCEMENT AT INTERIOR WALLS UNLESS OTHERWISE NOTED
- 5 CONCRETE STRENGTH AND WEIGHT
SLABS F'C = 4000 PSI, NW
WALLS & COLUMNS F'C = 4000 PSI, NW
- 6 CONCRETE BEAMS ARE DESIGNATED BxD WHERE B IS THE WIDTH IN INCHES AND D IS THE DEPTH (INCLUDING THE SLAB) IN INCHES
- 7 PLACE REINFORCING BARS FOR FLAT SLAB IN THE FOLLOWING SEQUENCE UNON
NORTH-SOUTH BOTTOM BARS
EAST-WEST BOTTOM BARS
EAST-WEST TOP BARS
NORTH-SOUTH TOP BARS
- 8 SLAB REINFORCEMENT IS AS SHOWN IN PLANS A, B AND C ABOVE PROVIDE REINFORCEMENT SHOWN IN PLAN A IN ADDITION TO BASIC REINFORCEMENT SHOWN IN B AND C
- 9 ¶ INDICATES INFORMATION TO BE PROVIDED BY ARCHITECT

**WILLIAM J CLINTON
PRESIDENTIAL
CENTER**

LITTLE ROCK, ARKANSAS

Architect
POLSHAK PARTNERSHIP LLP
320 West 13th Street
New York, New York 10014
212.607.7171

Coordinating Architects
POLK STANLEY YEARY ARCHITECTS Ltd
700 South Schiller Street
Little Rock, Arkansas 72201
501.378.0878
WITSELL EVANS RASCO
901 West Third Street
Little Rock, Arkansas 72201
501.374.6300

WOODS CARADINE ARCHITECTS
2200 South Main Street
Little Rock, Arkansas 72206
501.374.4060

Landscape Architects
HARGREAVES ASSOCIATES
118 Magazine Street
Cambridge, Massachusetts 02139
617.661.0070

LANDSCAPE ARCHITECTURE, Inc.
2300 Cottondale Lane Suite 202
Little Rock, Arkansas 72202
501.374.9810

Structural Engineer
LESLIE E. ROBERTSON ASSOC., RLLP
30 Broad Street, 47th Floor
New York, New York 10004
212.750.9000


MEP Engineers
FLACK + KURTZ Inc.
475 Fifth Avenue
New York, New York 10017
212.532.9600

CROMWELL ARCHITECTS ENGINEERS
101 South Spring Street
Little Rock, Arkansas 72201
501.372.2900

Curtainwall Consultant
R. A. HEINTGES ARCHITECTS
126 Fifth Avenue, 9th Floor
New York, New York 10011
212.652.2966

Seal

Issue	Date
8 100% CONSTRUCTION DOCS	09/27/02
7 90% PROGRESS PRINTING	08/30/02
6 100% STRUCTURAL CD	07/01/02
5 100% STL & CONC CD	06/15/02
4 BUILDING DEPT	03/18/02
3 BID ISSUE	03/01/02
2 75% DESIGN DEVEL.	01/25/02
1 50% DESIGN DEVEL.	12/19/01

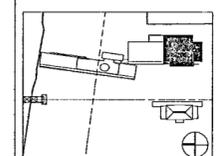

Job No 9908
Scale 1/8"=1'-0"
Date DEC 11, 2001
Title

**ROOF LEVEL
PLAN**

Sheet No
S106c

FOR OFFICIAL USE ONLY

© Copyright LESLIE E. ROBERTSON ASSOCIATES, R.L.L.P.
WARNING IT IS A VIOLATION OF LAW FOR ANY PERSON, UNLESS ACTING UNDER THE DIRECTION OF A PROFESSIONAL LICENSED IN THE STATE OF THIS PROJECT, TO ALTER IN ANY WAY THESE DRAWINGS WHERE ANY ITEM IS ALTERED, THE SUPERVISING PROFESSIONAL SHALL AFFIX TO THE ITEM HIS SEAL AND THE INSCRIPTION "ALTERED BY" FOLLOWED BY HIS SIGNATURE, THE DATE AND A SPECIFIC DESCRIPTION OF THE ALTERATION

**WILLIAM J CLINTON
PRESIDENTIAL
CENTER**

LITTLE ROCK, ARKANSAS

Architect
POLSHKE PARTNERSHIP LLP
320 West 13th Street
New York, New York 10014
212.507.7171

Coordinating Architects
POLK STANLEY YEARY ARCHITECTS Ltd
700 South Schiller Street
Little Rock, Arkansas 72201
501.378.0878

WITSELL EVANS RASCO
901 West Third Street
Little Rock, Arkansas 72201
501.374.6300

WOODS GARADINE ARCHITECTS
2300 South Main Street
Little Rock, Arkansas 72206
501.374.4060

Landscape Architects
HARGREAVES ASSOCIATES
118 Magazine Street
Cambridge, Massachusetts 02139
617.861.0070

LANDSCAPE ARCHITECTURE, Inc.
2300 Cottondale Lane Suite 202
Little Rock, Arkansas 72202
501.374.5610

Structural Engineer
LESLIE E. ROBERTSON ASSOC., RLLP
30 Broad Street, 47th Floor
New York, New York 10004
212.750.9000


MEP Engineers
FLACK + KURTZ Inc.
475 Fifth Avenue
New York, New York 10017
212.532.9600

CRUMWELL ARCHITECTS ENGINEERS
101 South Spring Street
Little Rock, Arkansas 72201
501.372.2900

Curtainwall Consultant
R. A. HENTGES ARCHITECTS
126 Fifth Avenue 9th Floor
New York, New York 10011
212.652.2966

Seal

Issue	Date
3	100% CONSTRUCTION DOCS 09/27/02
2	90% PROGRESS PRINTING 08/30/02
1	100% STRUCTURAL CD 07/01/02

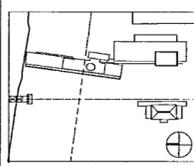


Job No. 9908
Scale 1/8"=1'-0"
Date JUN 15, 2002
Title

**EXECUTIVE
ROOF CANOPY**

Sheet No
S106d


NOTES

- REFER TO THE STRUCTURAL DRAWING BOOK FOR GENERAL NOTES, TYPICAL DETAILS, SCHEDULES AND ALL REFERENCED DETAILS AND SECTIONS
- MEMBERS SHOWN IN THIS DRAWING ARE ARCHITECTURALLY EXPOSED STEEL, UON
- MEMBERS SHOWN IN THIS DRAWING ARE FY50 STEEL THERMAL SPRAYED FOR CORROSION PROTECTION AND PAINTED PER ARCHITECTURAL REQUIREMENTS, UNLESS OTHERWISE NOTED

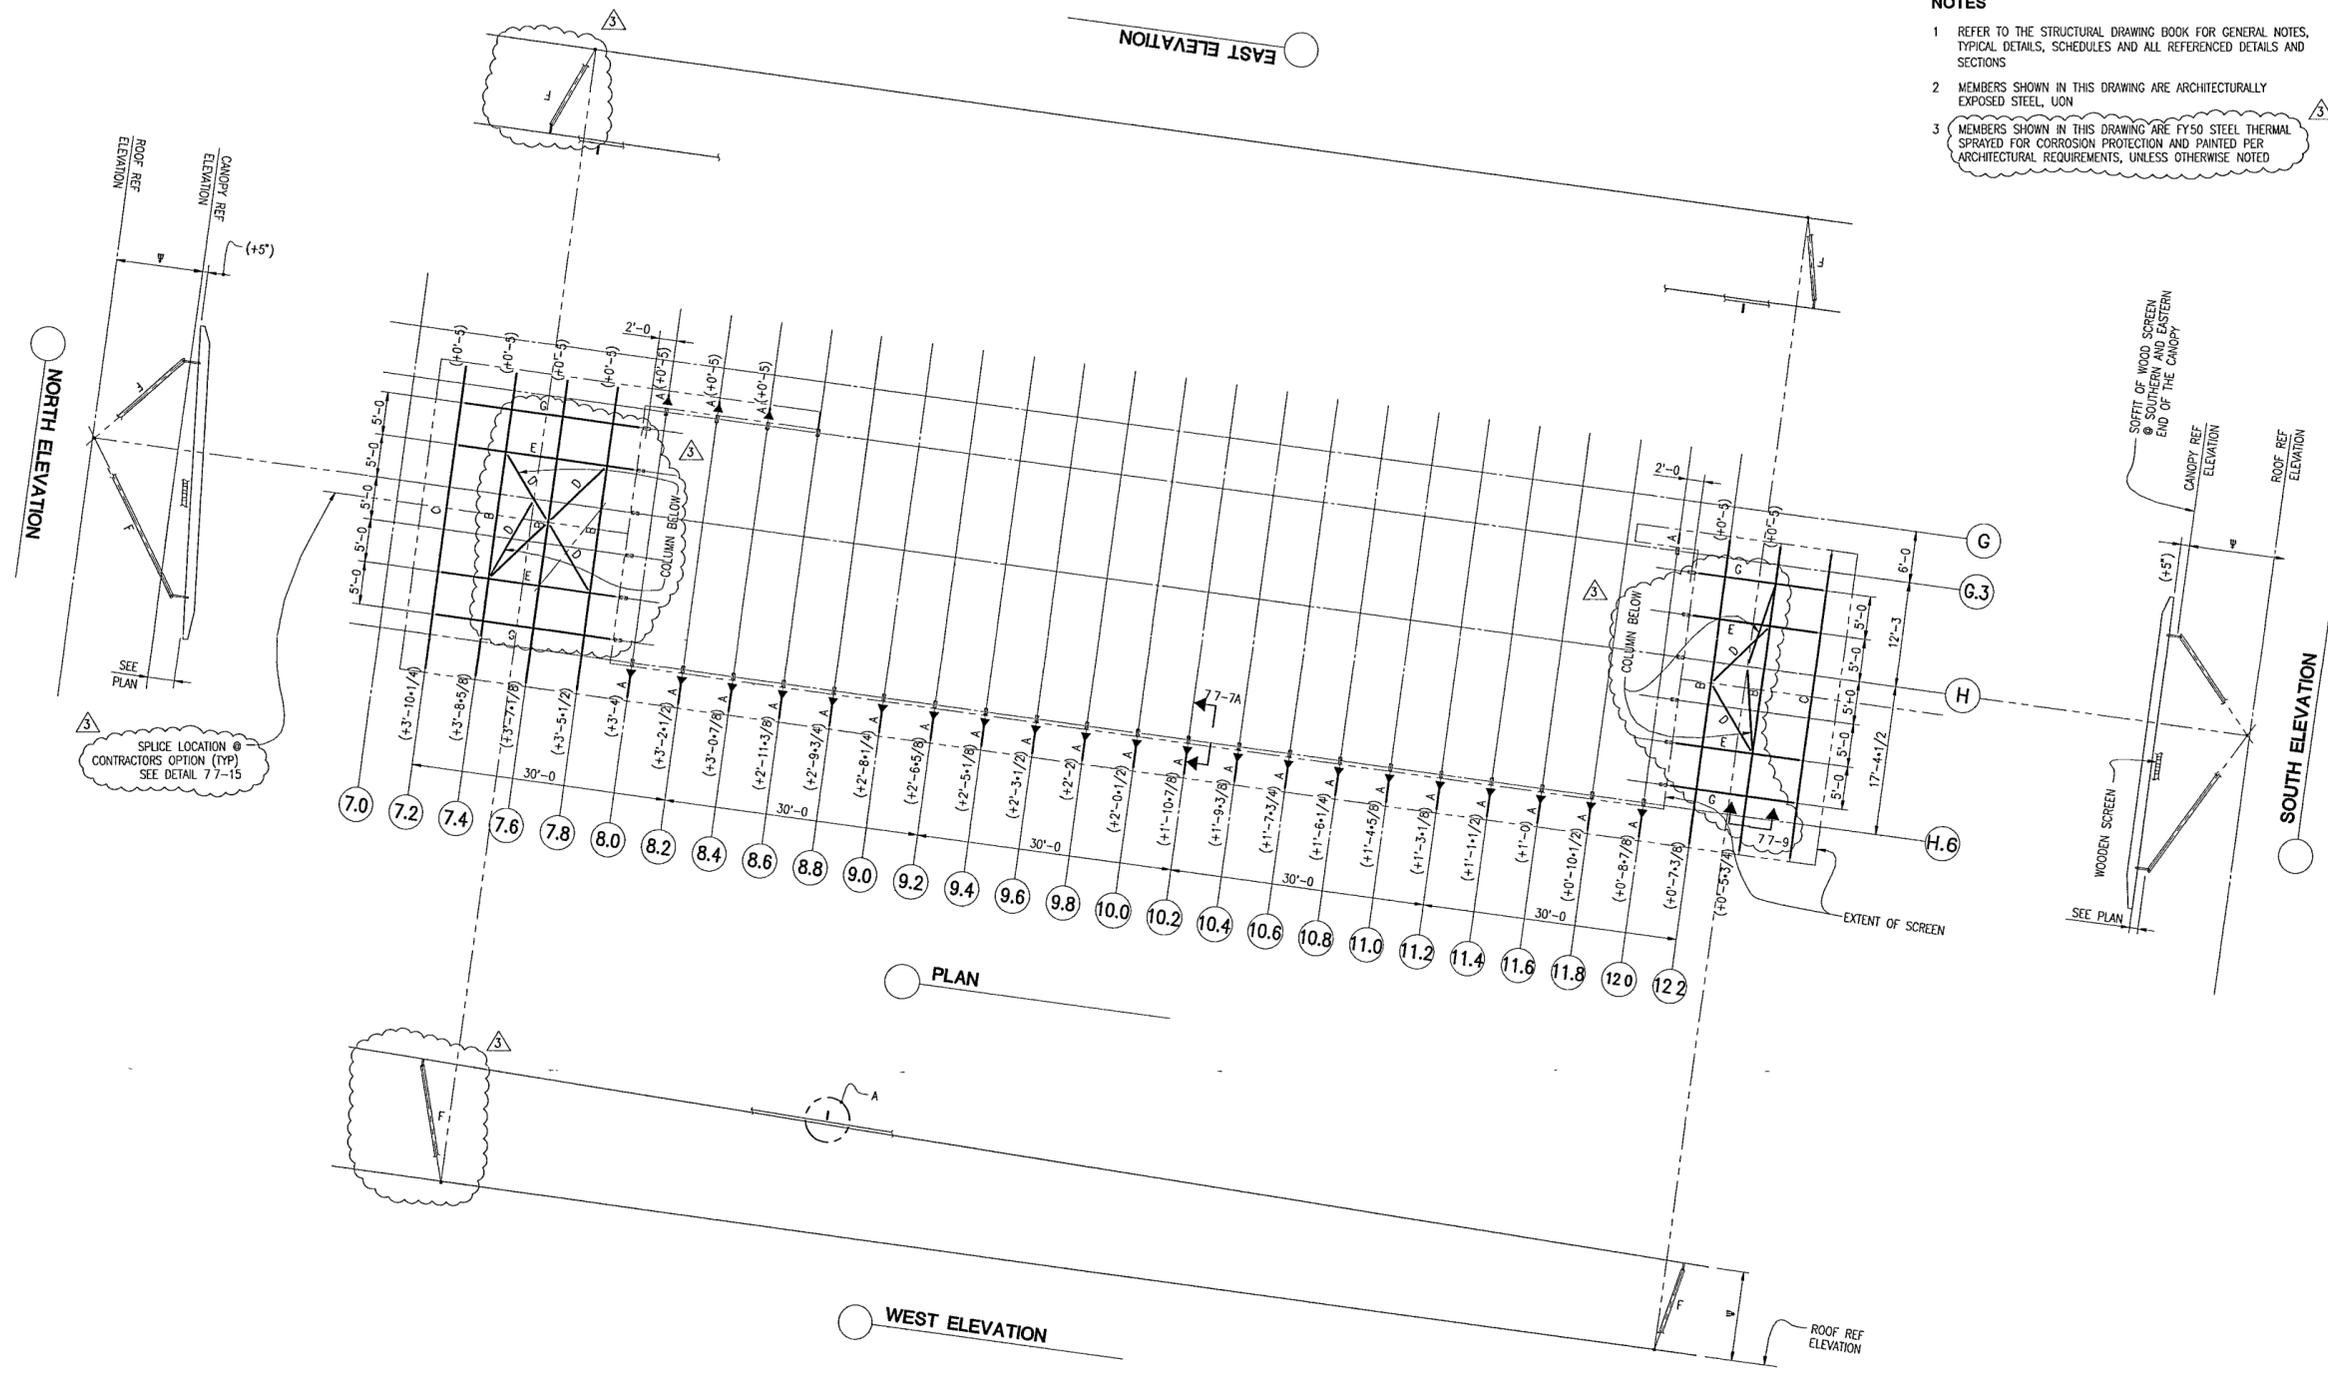

KEY:

- MEMBER SIZES ARE AS FOLLOWS
- A = PL 1, TAPERED - SEE DETAIL
 - B = PL 1x12, W/ TAPERED ENDS - SEE DETAIL
 - C = PL 2x12, W/ TAPERED ENDS - SEE DETAIL
 - D = 1" DIAMETER SOLID BAR - STAINLESS STEEL
 - E = PL 1-1/2x9, SLOTTED THROUGH TYPE B MEMBERS
 - F = INCLINED COLUMNS, BUILT-UP FROM STAINLESS STEEL PLATE
 - G = 2x9, SLOTTED THROUGH TYPE B AND TYPE C MEMBERS

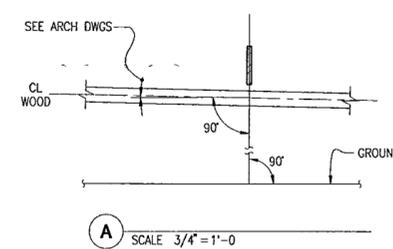

© Copyright LESLIE E. ROBERTSON ASSOCIATES, RLLP
WARNING IT IS A VIOLATION OF LAW FOR ANY PERSON, UNLESS ACTING UNDER THE DIRECTION OF A PROFESSIONAL, LICENSED IN THE STATE OF THIS PROJECT, TO ALTER IN ANY WAY THESE DRAWINGS WHERE ANY ITEM IS ALTERED. THE SUPERVISING PROFESSIONAL SHALL AFFIX TO THE ITEM HIS SEAL AND THE INSCRIPTION "ALTERED BY" FOLLOWED BY HIS SIGNATURE, THE DATE, AND A SPECIFIC DESCRIPTION OF THE ALTERATION.

FOR OFFICIAL USE ONLY

**WILLIAM J CLINTON
PRESIDENTIAL
CENTER**

LITTLE ROCK, ARKANSAS

Architect
POLSHEK PARTNERSHIP LLP
320 West 13th Street
New York, New York 10014
212.807.7171

Coordinating Architects
POLK STANLEY YEARY ARCHITECTS Ltd
700 South Schuler Street
Little Rock, Arkansas 72201
501.378.6878

WITSELL EVANS RASCO
901 West Third Street
Little Rock, Arkansas 72201
501.374.5300

WOODS CARADINE ARCHITECTS
2200 South Main Street
Little Rock, Arkansas 72206
501.374.4060

Landscape Architects
HARGREAVES ASSOCIATES
118 Magazine Street
Cambridge, Massachusetts 02139
617.661.0070

LANDSCAPE ARCHITECTURE, Inc.
2300 Cottondale Lane Suite 202
Little Rock, Arkansas 72202
501.374.5810

Structural Engineer
LESLIE E. ROBERTSON ASSOC., RLLP
30 Broad Street, 47th Floor
New York, New York 10004
212.750.9000

MEP Engineers
FLACK + KURTZ Inc.
475 Fifth Avenue
New York, New York 10017
212.532.9600


CROMWELL ARCHITECTS ENGINEERS
101 South Spring Street
Little Rock, Arkansas 72201
501.372.2300

Curtainwall Consultant
R. A. HEINTGES ARCHITECTS
128 Fifth Avenue, 9th Floor
New York, New York 10011
212.652.2966

Seal



100% Construction Documents	06/27/02
90% Progress Printing	06/30/02
ASI #05 (Issued as Sk-183)	06/20/02
100% Struct./ CD Progress	07/01/02
Bridge Bldg Substructure	06/14/02
100% Steel & Concrete CD	05/15/02
& Architectural CD Progress	
Issue	Date
*Issued originally as A700a	

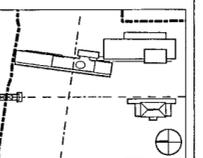


Job No. 9908

Scale 1/8" = 1'-0"

Date September 27, 2002

Title
**BASEMENT LEVEL
PARTIAL SLAB PLAN**

Sheet No.
S100a.1

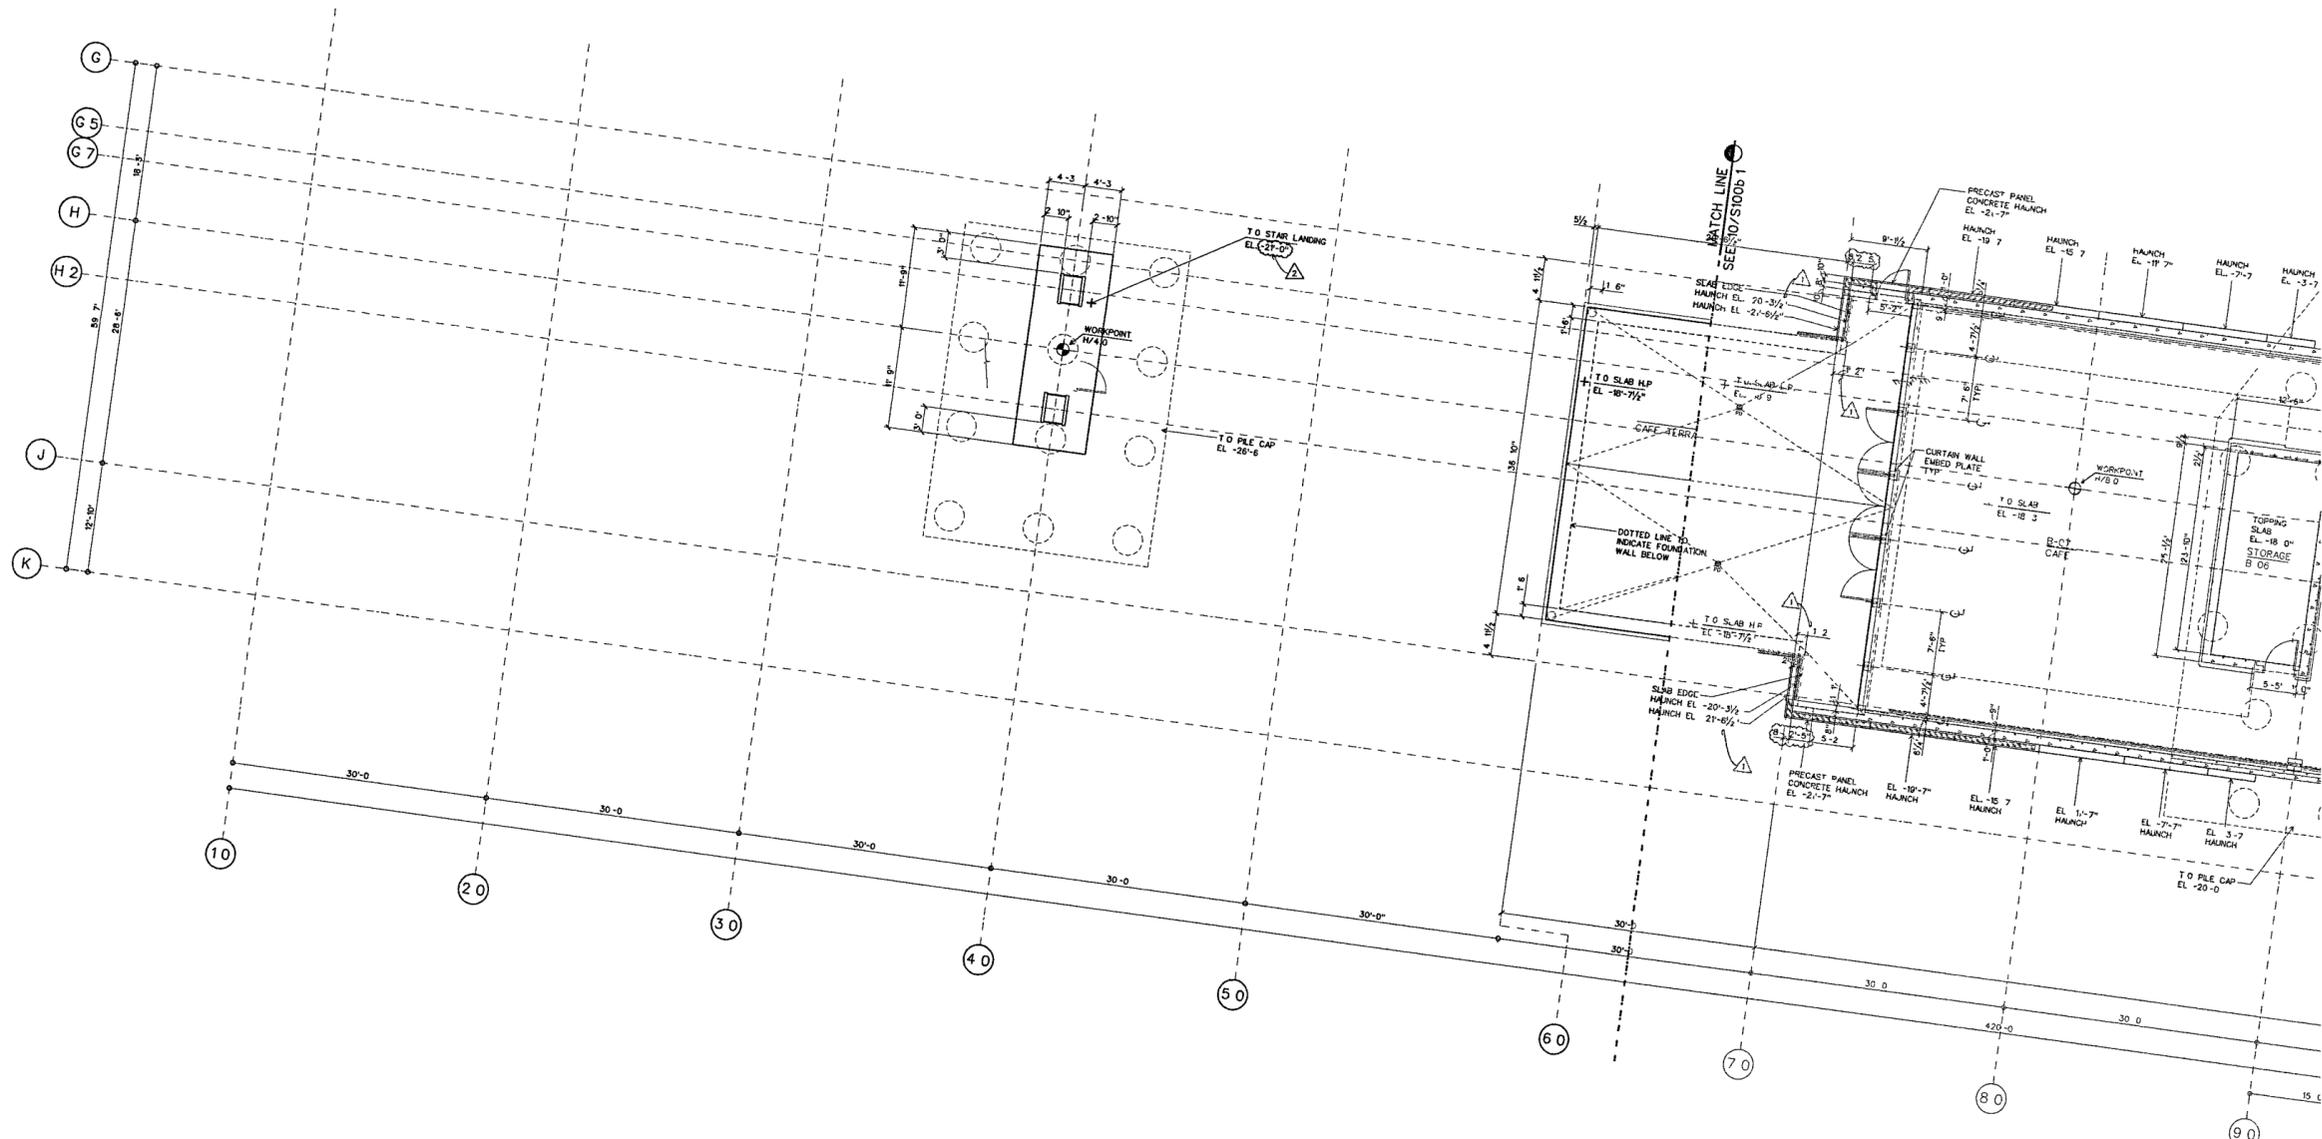

WORKPOINT	NORTHING (Y)	EASTING (X)
H/4 0	150.627 127270	1,234 743 833746
H/8 0	150,508 948833	1,234 723 007298
H/12 0	150,390 770381	1,234 702 852841
C/20 0	150 301 414924	1,234 756 87845
C/25 0	150 148 032475	1,234 750 845291
C/30 0	150,076 134955	1,234 745 836439

BASEMENT LEVEL SLAB PLAN A
SCALE 1/8" = 1'-0"

SLAB-00B DGN 10

**WILLIAM J CLINTON
PRESIDENTIAL
CENTER**

LITTLE ROCK, ARKANSAS

Architect
POLSHEK PARTNERSHIP LLP
320 West 13th Street
New York, New York 10014
212.607.7171

Coordinating Architects
POLK STANLEY YEARY ARCHITECTS LTD
700 South Schiller Street
Little Rock, Arkansas 72201
501.378.0878

WITSELL EVANS RASCO
901 West Third Street
Little Rock, Arkansas 72201
501.374.6300

WOODS CARADINE ARCHITECTS
2200 South Main Street
Little Rock, Arkansas 72206
501.374.4060

Landscape Architects
HARGREAVES ASSOCIATES
118 Magazine Street
Cambridge, Massachusetts 02139
617.661.0070


LANDSCAPE ARCHITECTURE, Inc
2300 Cottondale Lane Suite 202
Little Rock, Arkansas 72202
501.374.5810

Structural Engineer
LESLIE E. ROBERTSON ASSOC RLLP
30 Broad Street, 47th Floor
New York, New York 10004
212.759.9000


MEP Engineers
FLACK + KURTZ Inc.
475 Fifth Avenue
New York, New York 10017
212.532.9600

CROMWELL ARCHITECTS ENGINEERS
101 South Spring Street
Little Rock, Arkansas 72201
501.372.2900

Curianwall Consultant
R. A. HEINTGES ARCHITECTS
126 Fifth Avenue 9th Floor
New York, New York 10011
212.652.2965

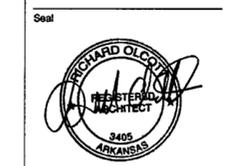

100% Construction Documents	09/27/02
90% Progress Printing	08/30/02
ASI #05 (Issued as Sk-188)	08/20/02
100% Struct/CD Progress	07/01/02
Bridge Bldg Substructure	06/14/02
100% Steel & Concrete CD	05/15/02
& Architectural CD Progress	
Issue	Date
*Issued originally as A700b	

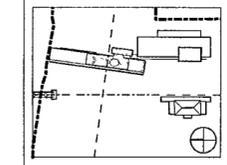


Job No: 9908
Scale: 1/8" = 1'-0"
Date: September 27, 2002
Title: BASEMENT LEVEL PARTIAL SLAB PLAN

Sheet No: **S100b.1**

BUILDING WORKPOINT COORDINATES

WORKPOINT	NORTHING (Y)	EASTING (X)
H/4 0	150 627 127270	1,234 743 833746
H/8 0	150,508 948830	1,234 723 007298
H/12 0	150,390 770381	1,234 702 358841
C/20 0	150,301 414924	1,234 756 817845
C/25 0	150 149 032475	1,234 750 845291
C/30 0	150 016 134955	1,234 745 636439

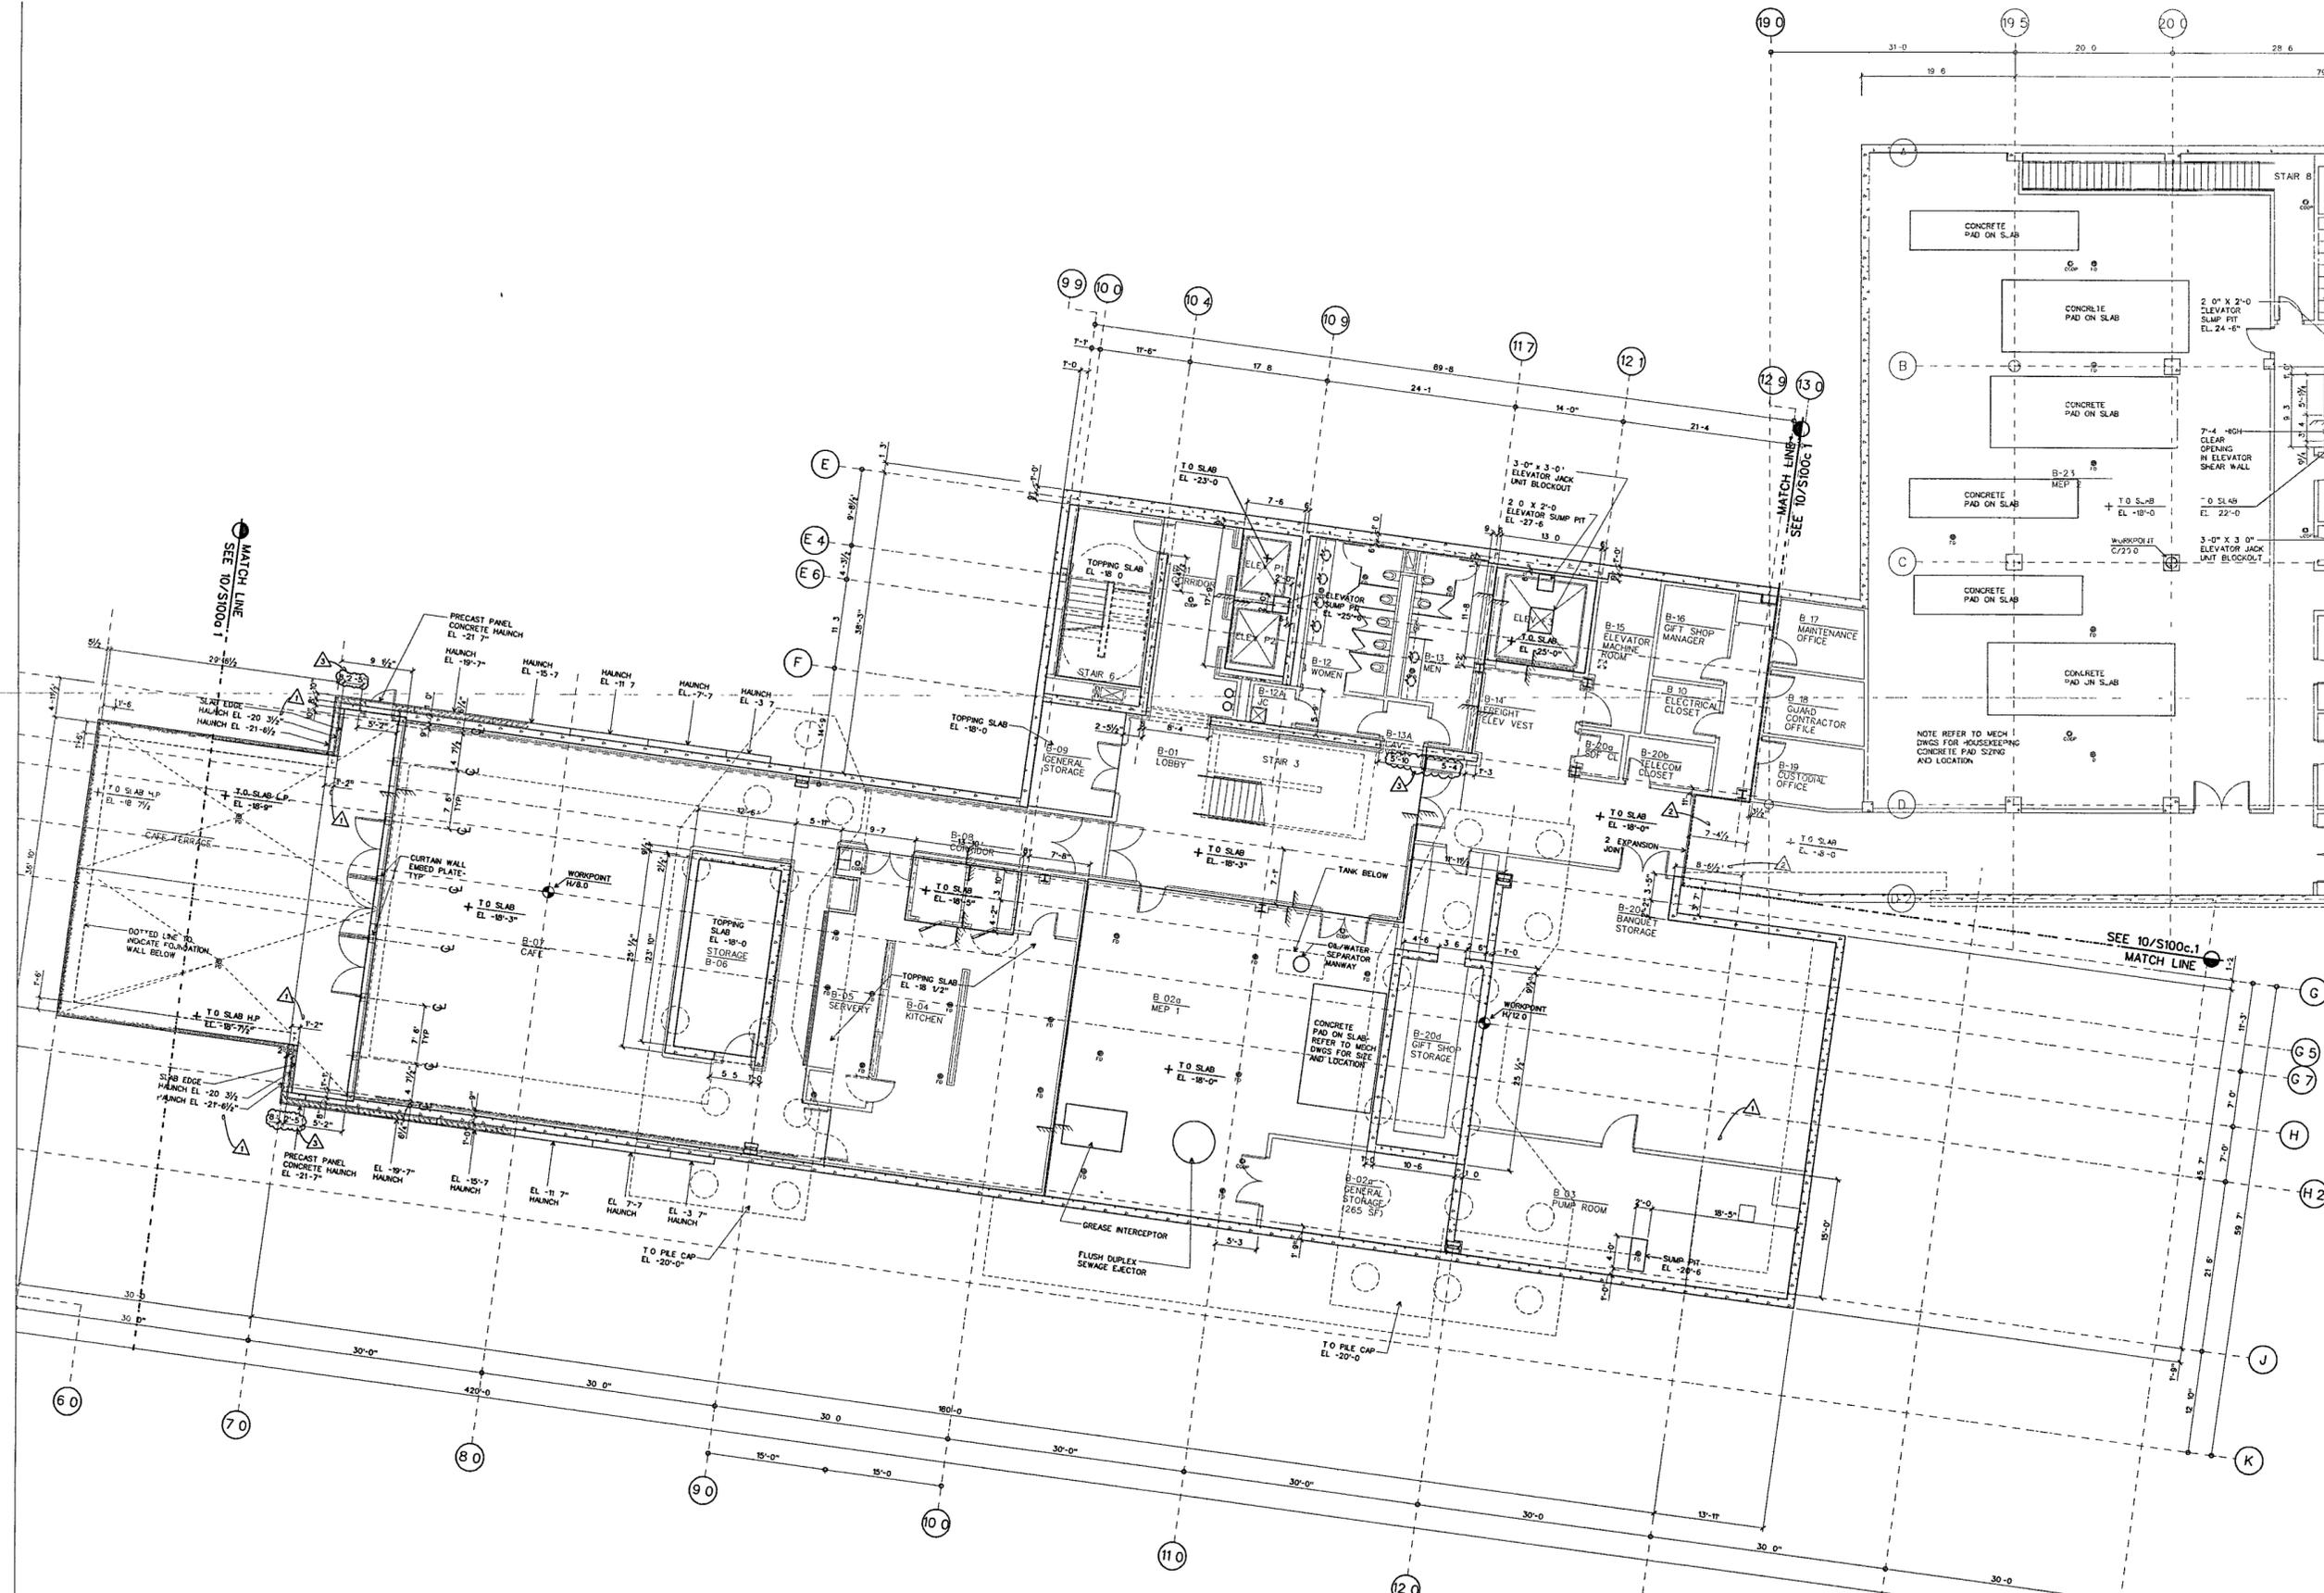

BASEMENT SLAB PLAN B
SCALE 1/8" = 1'-0"

SLAB-00B DGN 10

FOR OFFICIAL USE ONLY

**WILLIAM J CLINTON
PRESIDENTIAL
CENTER**

LITTLE ROCK ARKANSAS

Architect
POLSHEK PARTNERSHIP LLP
320 West 13th Street
New York, New York 10014
212 607 7171

Coordinating Architects
POLK STANLEY YEARY ARCHITECTS Ltd
700 South Schiller Street
Little Rock, Arkansas 72201
501 378 0878

WITSELL EVANS RASCO
901 West Third Street
Little Rock, Arkansas 72201
501 374 5300

WOODS CARADINE ARCHITECTS
2200 South Main Street
Little Rock, Arkansas 72206
501 374 4060

Landscape Architects
HARGREAVES ASSOCIATES
118 Magazine Street
Cambridge Massachusetts 02139
617 661 0070


LANDSCAPE ARCHITECTURE, Inc
2300 Cottondale Lane Suite 202
Little Rock, Arkansas 72202
501 374 5610

Structural Engineer
LESLIE E ROBERTSON ASSOC., RLLP
30 Broad Street, 47th Floor
New York, New York 10004
212 750 9000


MEP Engineers
FLACK + KURTZ Inc
475 Fifth Avenue
New York, New York 10017
212 532 9600

CROMWELL ARCHITECTS ENGINEERS
101 South Spring Street
Little Rock, Arkansas 72201
501 372 2900

Curtilwall Consultant
R. A. HEINTGES ARCHITECTS
126 Fifth Avenue 9th Floor
New York, New York 10011
212 652-2966

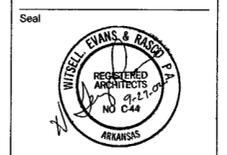

100% Construction Documents	09/27/02
90% Progress Printing	08/30/02
100% Struct/CD Progress	07/01/02
Bridge Building Substructure	06/14/02
100% Steel & Concrete CD	05/15/02
& Architectural CD Progress	
100% Design Development	03/01/02
Issue	Date

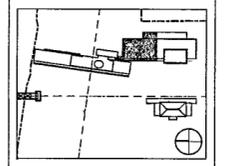


Job No: 9908
Scale: 1/8" = 1'-0"
Date: September 27, 2002
Title:

**BASEMENT LEVEL
PARTIAL SLAB PLAN**

Sheet No
S100c.1

FOR OFFICIAL USE ONLY

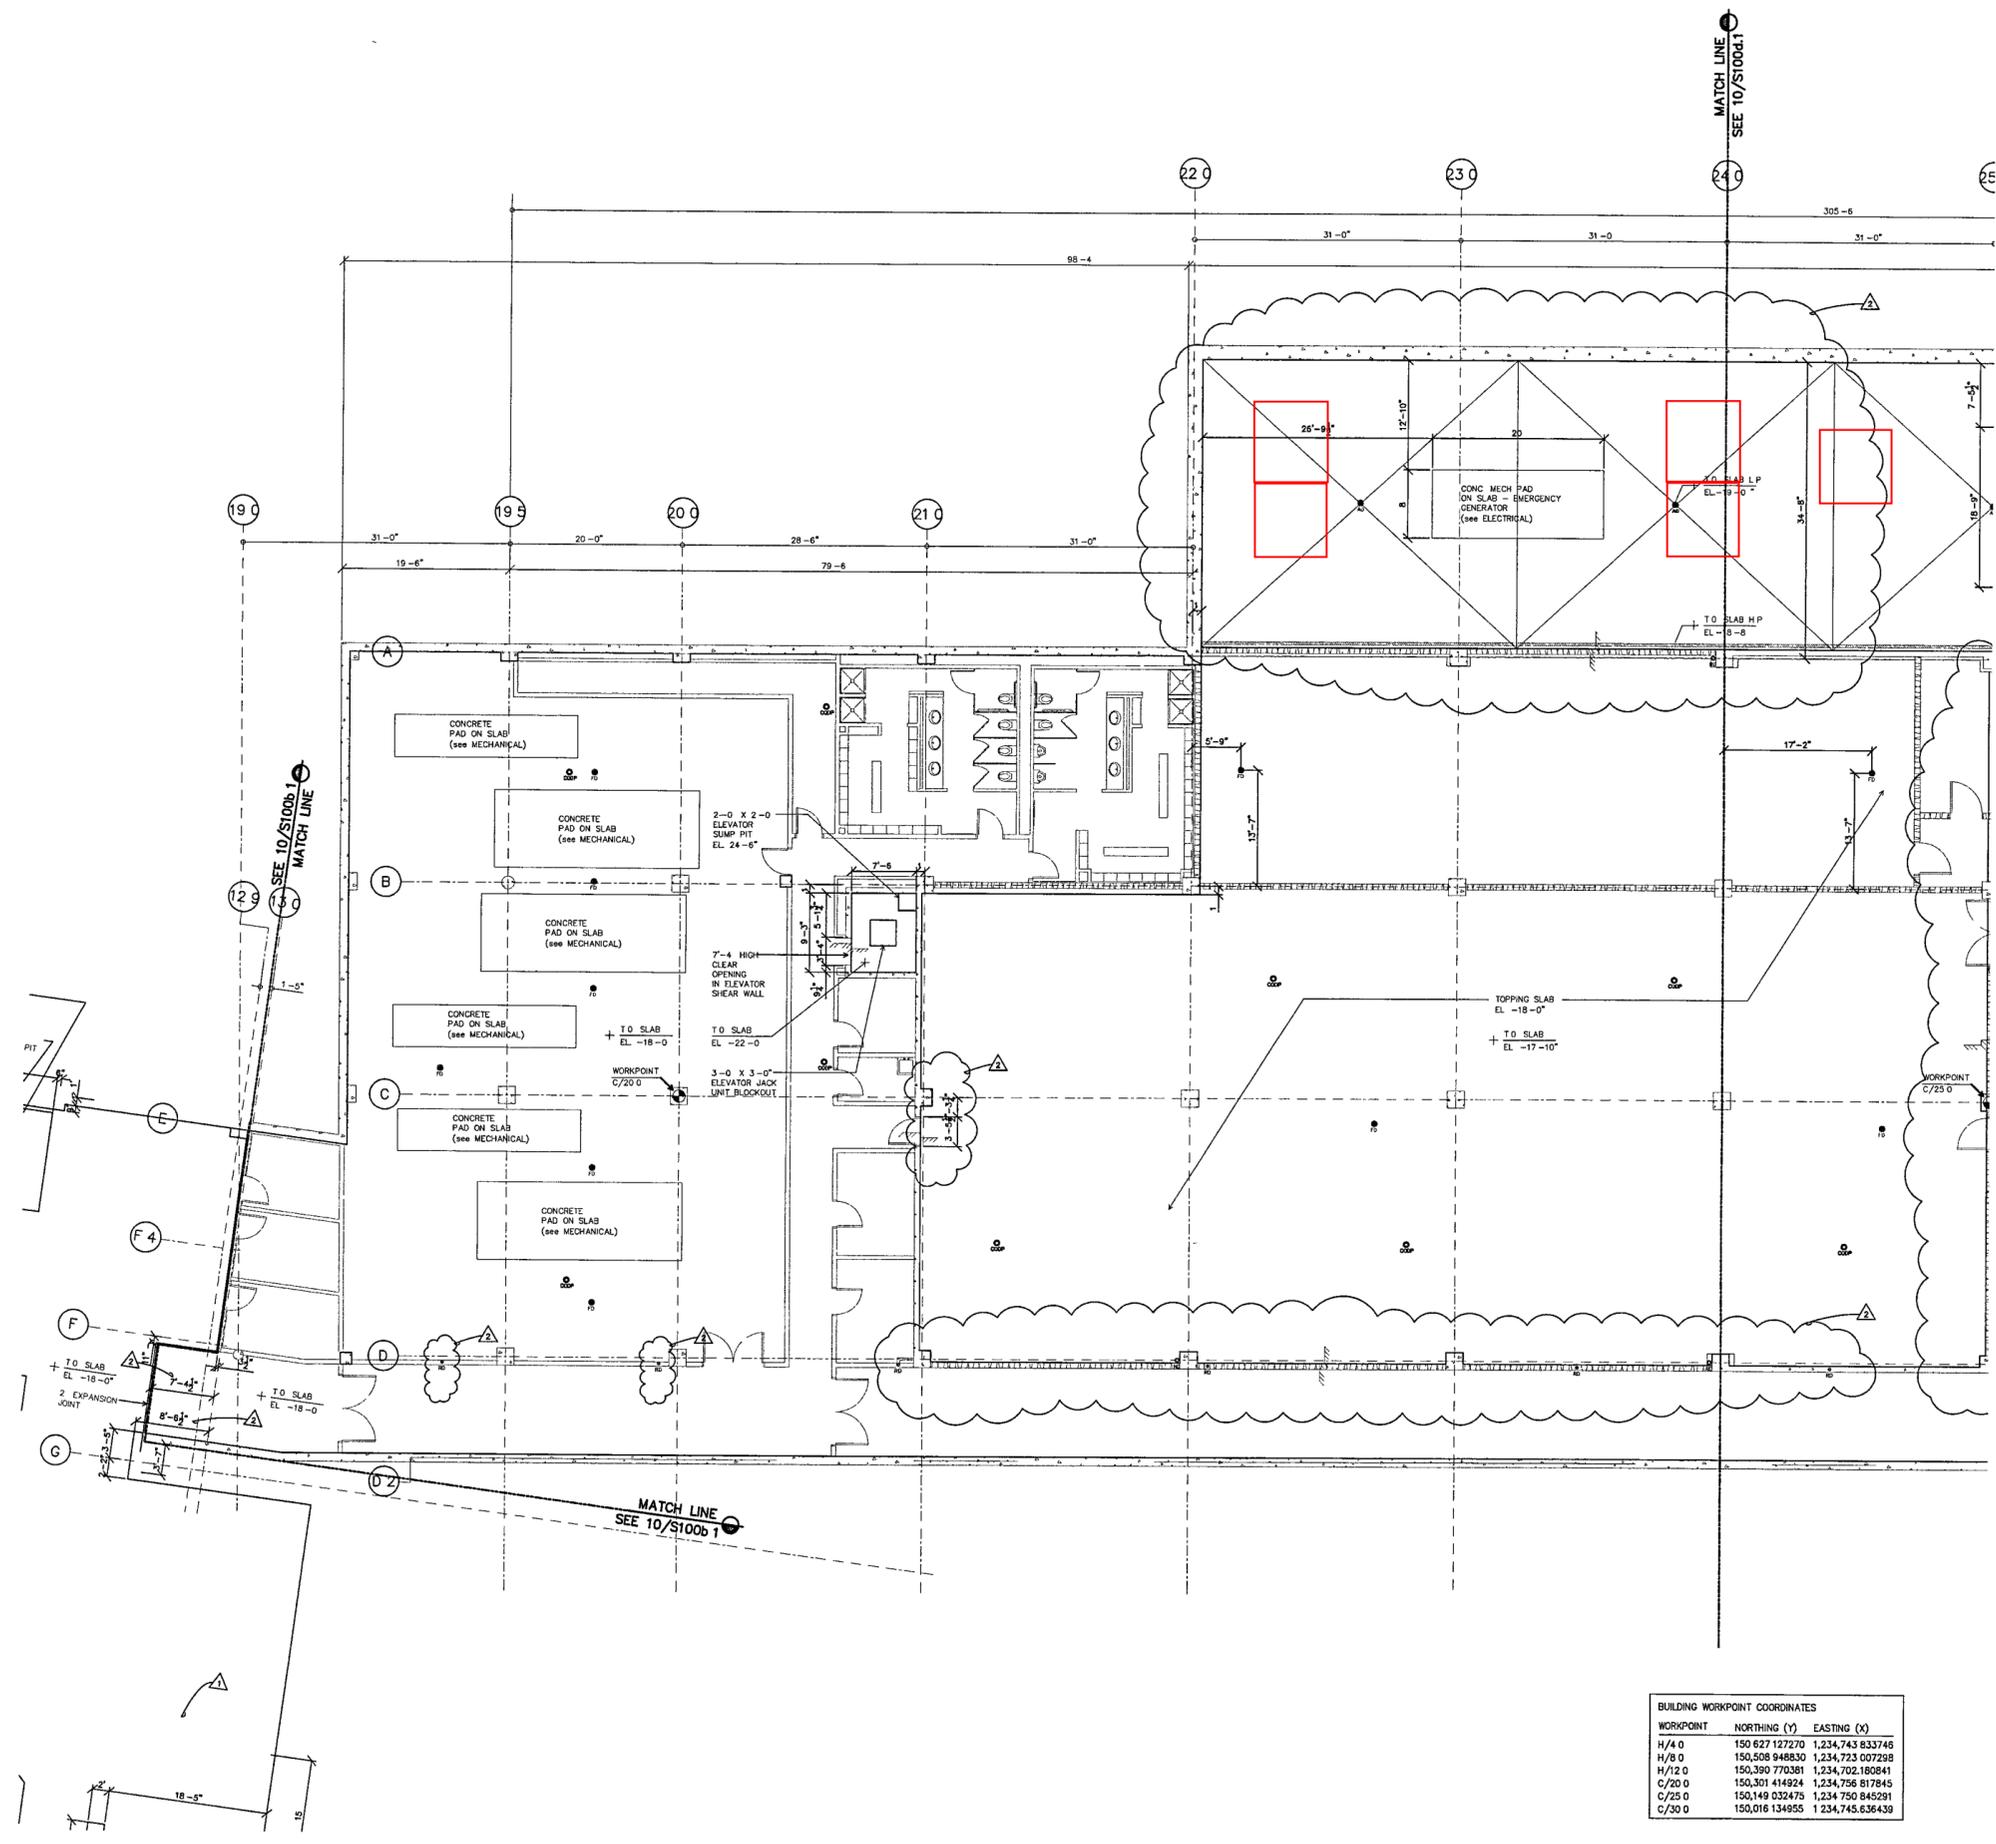

BUILDING WORKPOINT COORDINATES

WORKPOINT	NORTHING (Y)	EASTING (X)
H/4 0	150,627,127270	1,234,743,833746
H/8 0	150,508,948830	1,234,723,007298
H/12 0	150,390,770381	1,234,702,180841
C/20 0	150,301,414924	1,234,756,817845
C/25 0	150,149,032475	1,234,750,845591
C/30 0	150,016,134955	1,234,745,836439

BASEMENT SLAB PLAN C
SCALE 1/8" = 1'-0"

**WILLIAM J CLINTON
PRESIDENTIAL
CENTER**

LITTLE ROCK, ARKANSAS

Architect
POLSHEK PARTNERSHIP LLP
320 West 13th Street
New York, New York 10014
212 807 7171

Coordinating Architects
POLK STANLEY YEARY ARCHITECTS Ltd
700 South Schiller Street
Little Rock, Arkansas 72201
501 378 0878

WITSELL EVANS RASCO
901 West Third Street
Little Rock, Arkansas 72201
501 374 5300

WOODS CARADINE ARCHITECTS
2200 South Main Street
Little Rock, Arkansas 72208
501 374 4060

Landscape Architects
HARGREAVES ASSOCIATES
118 Magazine Street
Cambridge, Massachusetts 02139
617 681 0070


LANDSCAPE ARCHITECTURE, Inc.
2300 Cottondale Lane Suite 202
Little Rock, Arkansas 72202
501 374 8510

Structural Engineer
LESLIE E ROBERTSON ASSOC, RLLP
30 Broad Street, 47th Floor
New York, New York 10004
212 550 9000


MEP Engineers
FLACK + KURTZ Inc.
475 Fifth Avenue
New York, New York 10017
212 532 9600

CROMMELL ARCHITECTS ENGINEERS
101 South Spring Street
Little Rock, Arkansas 72201
501 372 2900

Curtainwall Consultant
R. A. HEINTGES ARCHITECTS
126 Fifth Avenue, 9th Floor
New York, New York 10011
212 552-2965

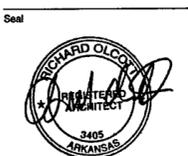

100% Construction Documents	09/27/02
90% Progress Printing	09/30/02
AS1 #05	08/20/02
100% Struct/CD Progress	07/01/02
Bridge Bldg Substructure	09/14/02
100% Steel & Concrete CD	05/15/02
& Architectural CD Progress	
Issue	Date
*Issued originally as A701b	

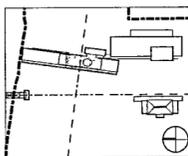

Job No 9908

Scale 1/8" = 1'-0"

Date September 27, 2002


Title

GROUND LEVEL
PARTIAL SLAB PLAN

Sheet No

S101b.1

WORKPOINT	NORTHING (Y)	EASTING (X)
H/4 0	150 627 127270	1234 743 833746
H/8 0	150,508 948830	1234 723 007298
H/12 0	150,390 770381	1234 702 80841
C/20 0	150 301 414924	1234 756 87845
C/25 0	150 149 032475	1234 750 845591
C/30 0	150,016 154555	1234 745 836439

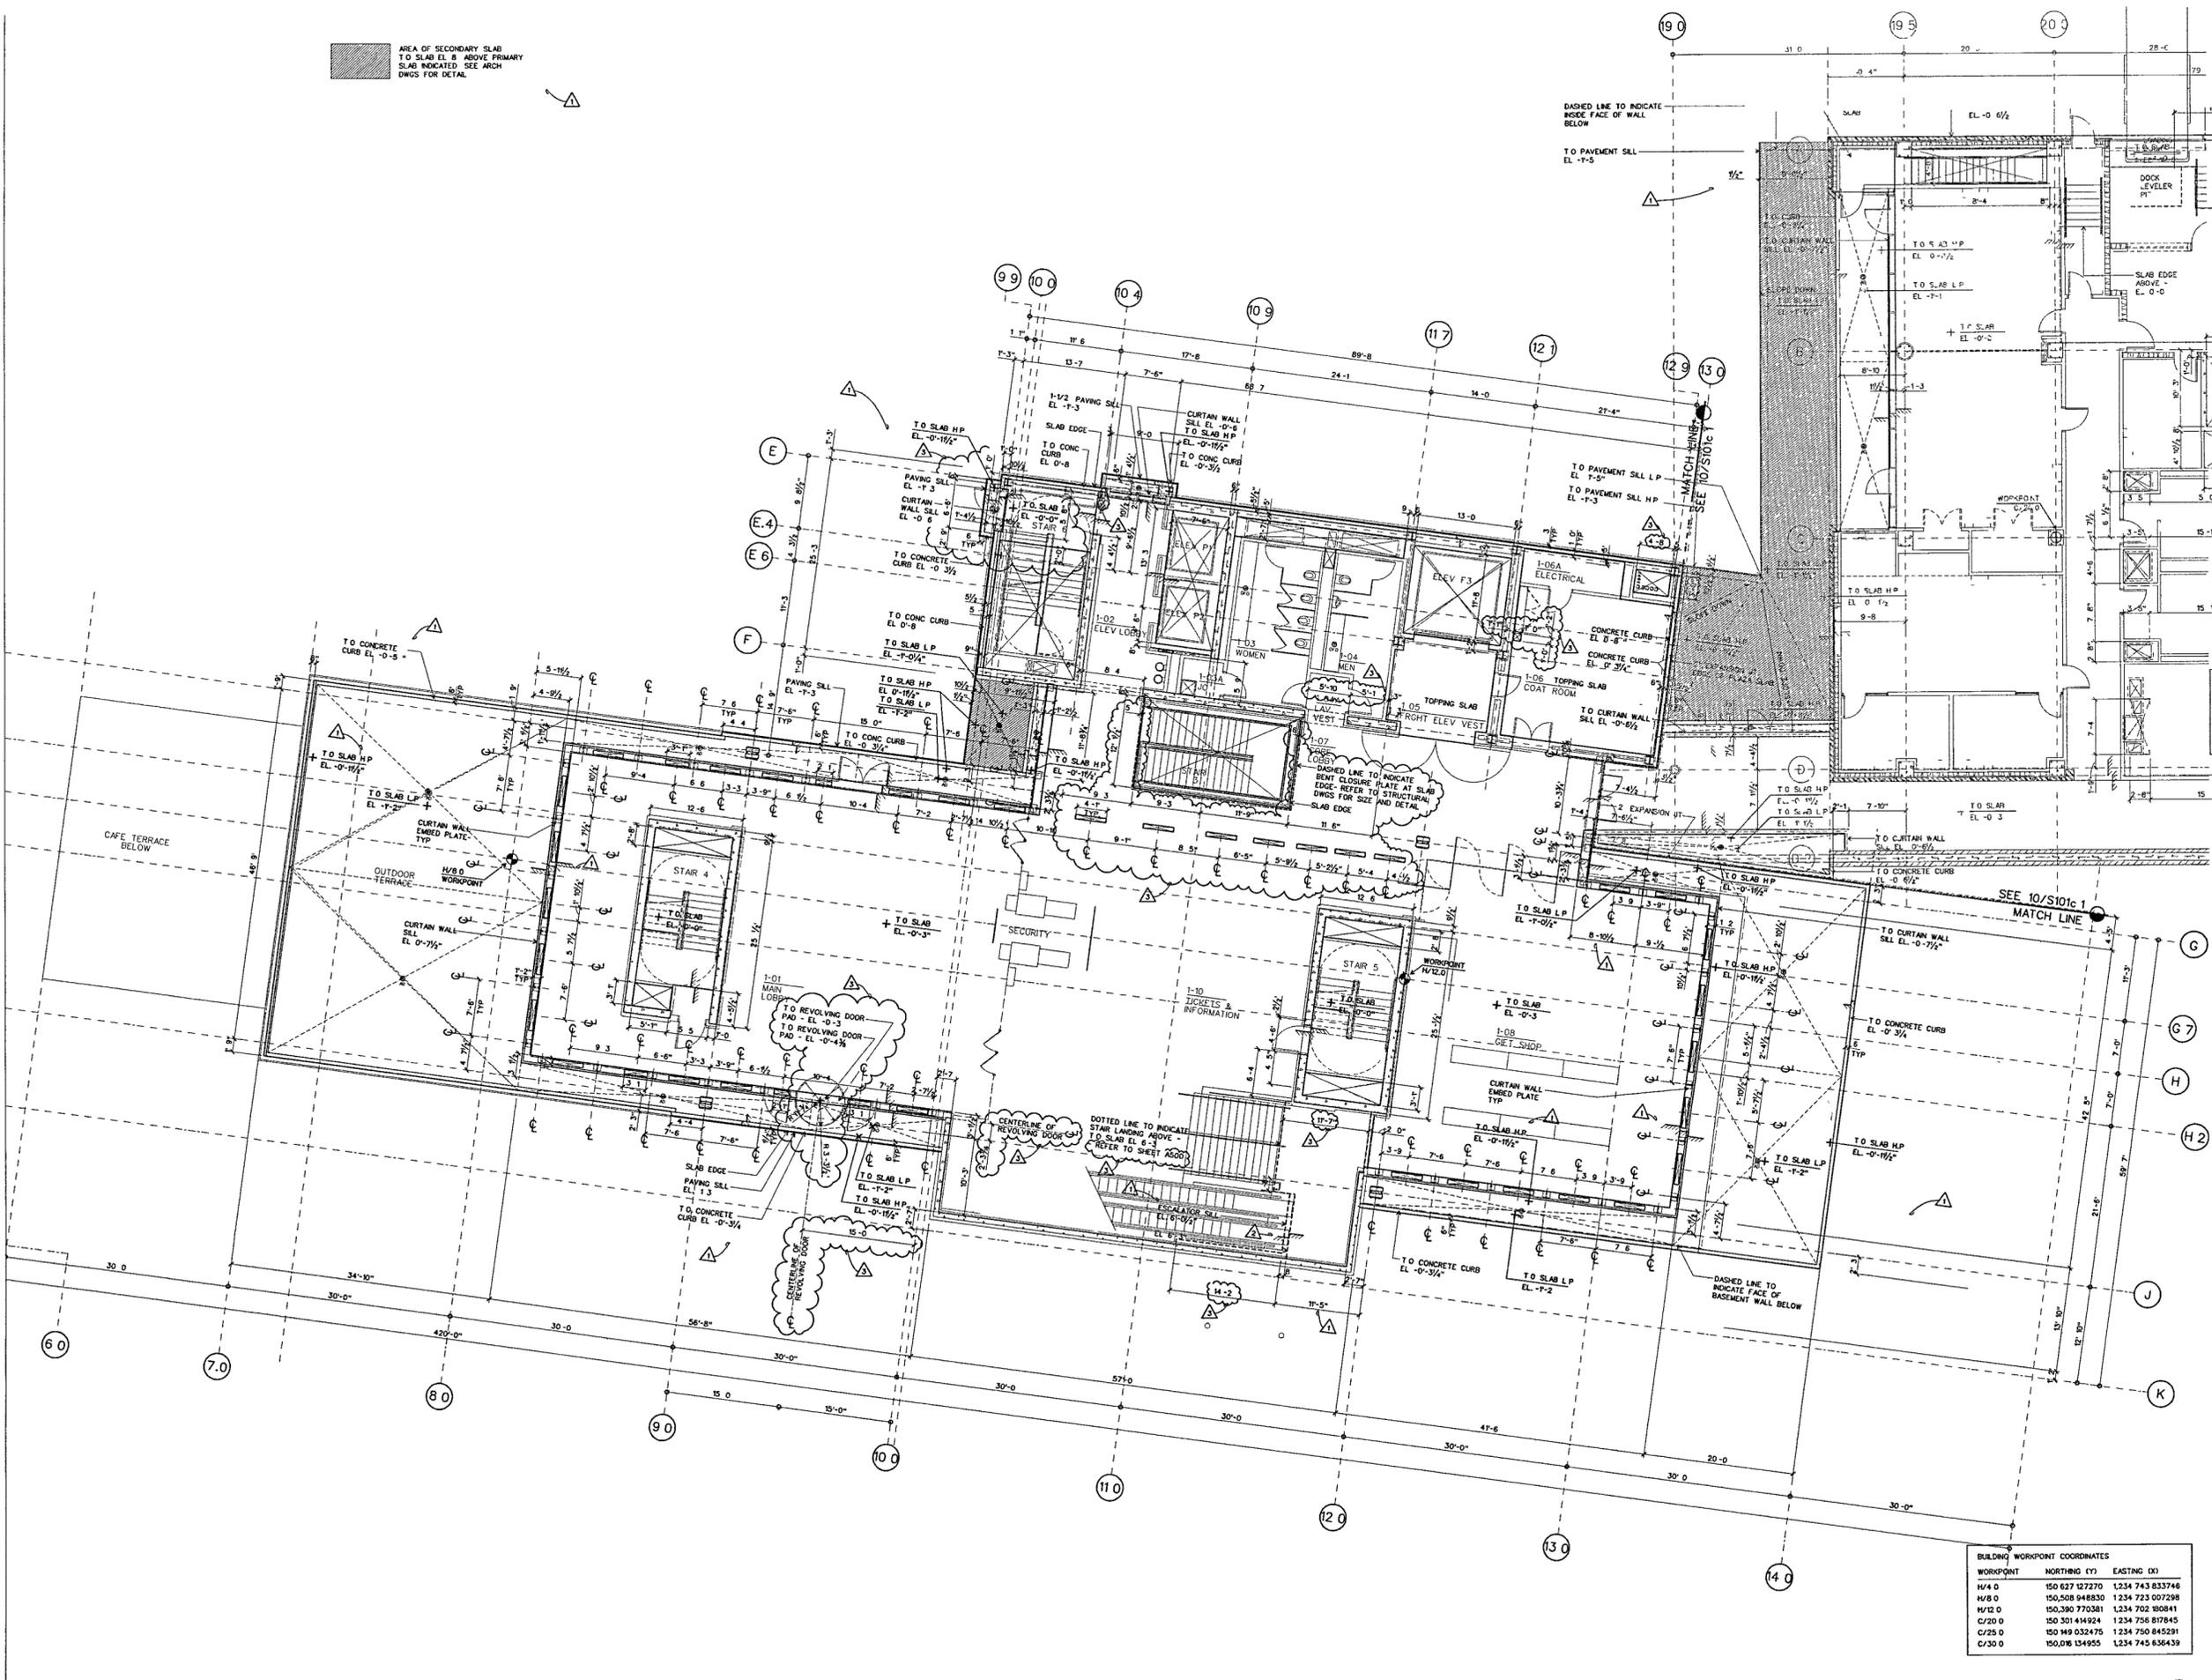

GROUND LEVEL SLAB PLAN B
SCALE 1/4" = 1'-0"

10
FOR OFFICIAL USE ONLY

**WILLIAM J CLINTON
PRESIDENTIAL
CENTER**

LITTLE ROCK, ARKANSAS

Architect
POLSHEK PARTNERSHIP LLP
320 West 13th Street
New York, New York 10014
212 807 7171

Coordinating Architects
POLK STANLEY YEARY ARCHITECTS LTD
700 South Schiller Street
Little Rock, Arkansas 72201
501 378 0878

WITSELL EVANS RASCO
901 West Third Street
Little Rock, Arkansas 72201
501 374 5300

WOODS CARADINE ARCHITECTS
2200 South Main Street
Little Rock, Arkansas 72206
501 374 4660

Landscape Architects
HARGREAVES ASSOCIATES
118 Magazine Street
Cambridge, Massachusetts 02139
617 661 0070

LANDSCAPE ARCHITECTURE Inc
2300 Cottondale Lane Suite 202
Little Rock, Arkansas 72202
501 374 5610

Structural Engineer
LESLIE E ROBERTSON ASSOC, RLLP
30 Broad Street 4th Floor
New York, New York 10004
212 750 9000

MEP Engineers
FLACK + KURTZ Inc
475 Fifth Avenue
New York, New York 10017
212 532 9600


CROMWELL ARCHITECTS ENGINEERS
101 South Spring Street
Little Rock, Arkansas 72201
501 372 2900

Curtainwall Consultant
R. A. HEINTGES ARCHITECTS
126 Fifth Avenue 9th Floor
New York, New York 10011
212 652 2966

Seal



100% Construction Documents	09/27/02
90% Progress Printing	08/30/02
100% Struct./CD Progress	07/01/02
100% Steel & Concrete CD	05/15/02
& Architectural CD Progress	
100% Design Development	03/01/02
Issue	Date

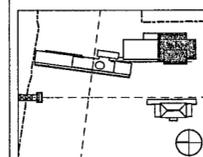

Job No 9908

Scale 1/8" = 1'-0"

Date September 27, 2002

Title


**GROUND LEVEL
PARTIAL SLAB PLAN**

Sheet No

S101d.1

10

FOR OFFICIAL USE ONLY

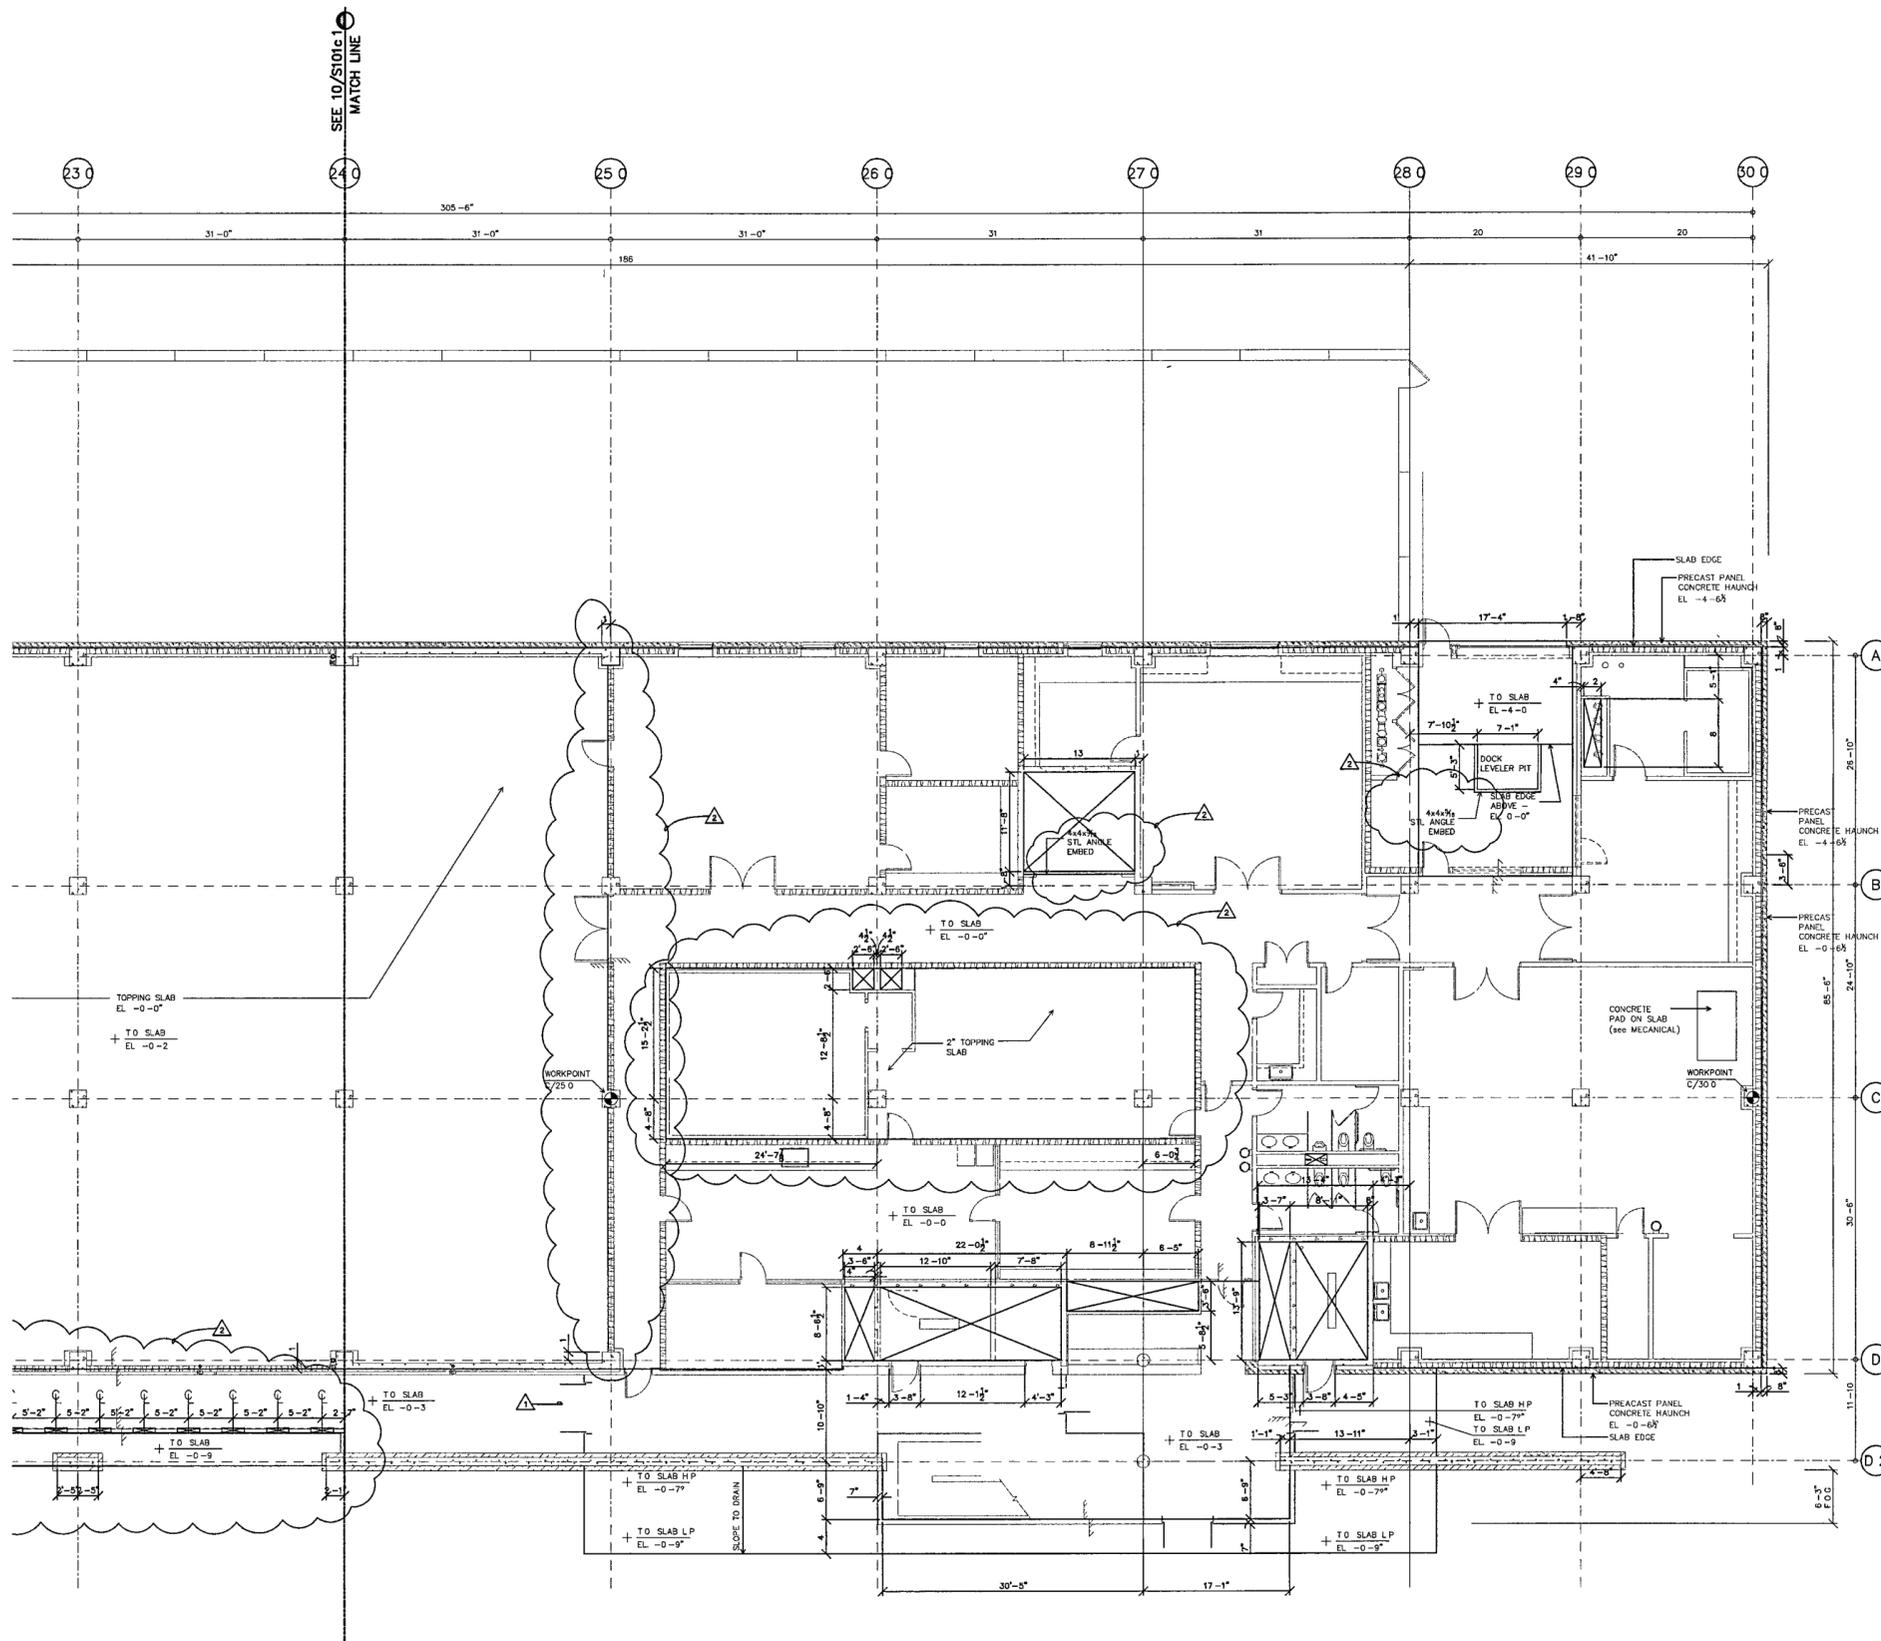

WORKPOINT	NORTHING (Y)	EASTING (X)
H/4 0	150,627 127270	1 234,743 833746
H/8 0	150,508 948830	1,234,723 007298
H/12 0	150,390 770381	1,234,702 180841
C/20 0	150,301 414924	1,234,756 817845
C/25 0	150,149 032475	1,234,750 845291
C/30 0	150,016 134955	1,234,745 636439

GROUND LEVEL SLAB PLAN D

SCALE 1/8" = 1'-0"

**WILLIAM J CLINTON
PRESIDENTIAL
CENTER**

LITTLE ROCK, ARKANSAS

Architect

POLSHEK PARTNERSHIP LLP
320 West 13th Street
New York, New York 10014
212 807 7171

Coordinating Architects

POLK STANLEY YEARY ARCHITECTS Ltd
700 South Schiller Street
Little Rock, Arkansas 72201
501 378 0878

WITSELL EVANS RASCO
901 West Third Street
Little Rock, Arkansas 72201
501 374 5300

WOODS CARADINE ARCHITECTS
2200 South Main Street
Little Rock, Arkansas 72206
501 374 4060

Landscape Architects

HARGREAVES ASSOCIATES
118 Magazine Street
Cambridge, Massachusetts 02139
617 661 0070

LANDSCAPE ARCHITECTURE, Inc.
2300 Cottondale Lane Suite 202
Little Rock, Arkansas 72202
501 374 5610

Structural Engineer

LESLIE E ROBERTSON ASSOC. RLLP
30 Broad Street, 47th Floor
New York, New York 10004
212 750 9000

MEP Engineers

FLACK + KURTZ Inc.
475 Fifth Avenue
New York, New York 10017
212 532 9600

CROMMELL ARCHITECTS ENGINEERS
101 South Spring Street
Little Rock, Arkansas 72201
501 372 2900


Curtainwall Consultant

R. A. HEINTGES ARCHITECTS
126 Fifth Avenue 8th Floor
New York, New York 10011
212 652-2968

Seal



100% Construction Documents	09/27/02
90% Progress Printing	08/30/02
100% Struct / CD Progress	07/01/02
100% Steel & Concrete CD	05/15/02
& Architectural CD Progress	
Issue	Date
*Issued originally as A702a	

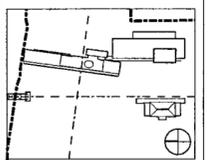

Job No. 9908

Scale 1/8" = 1'-0"


Date September 27 2002

Title

**SECOND LEVEL
PARTIAL SLAB PLAN**

Sheet No.

S102a.1

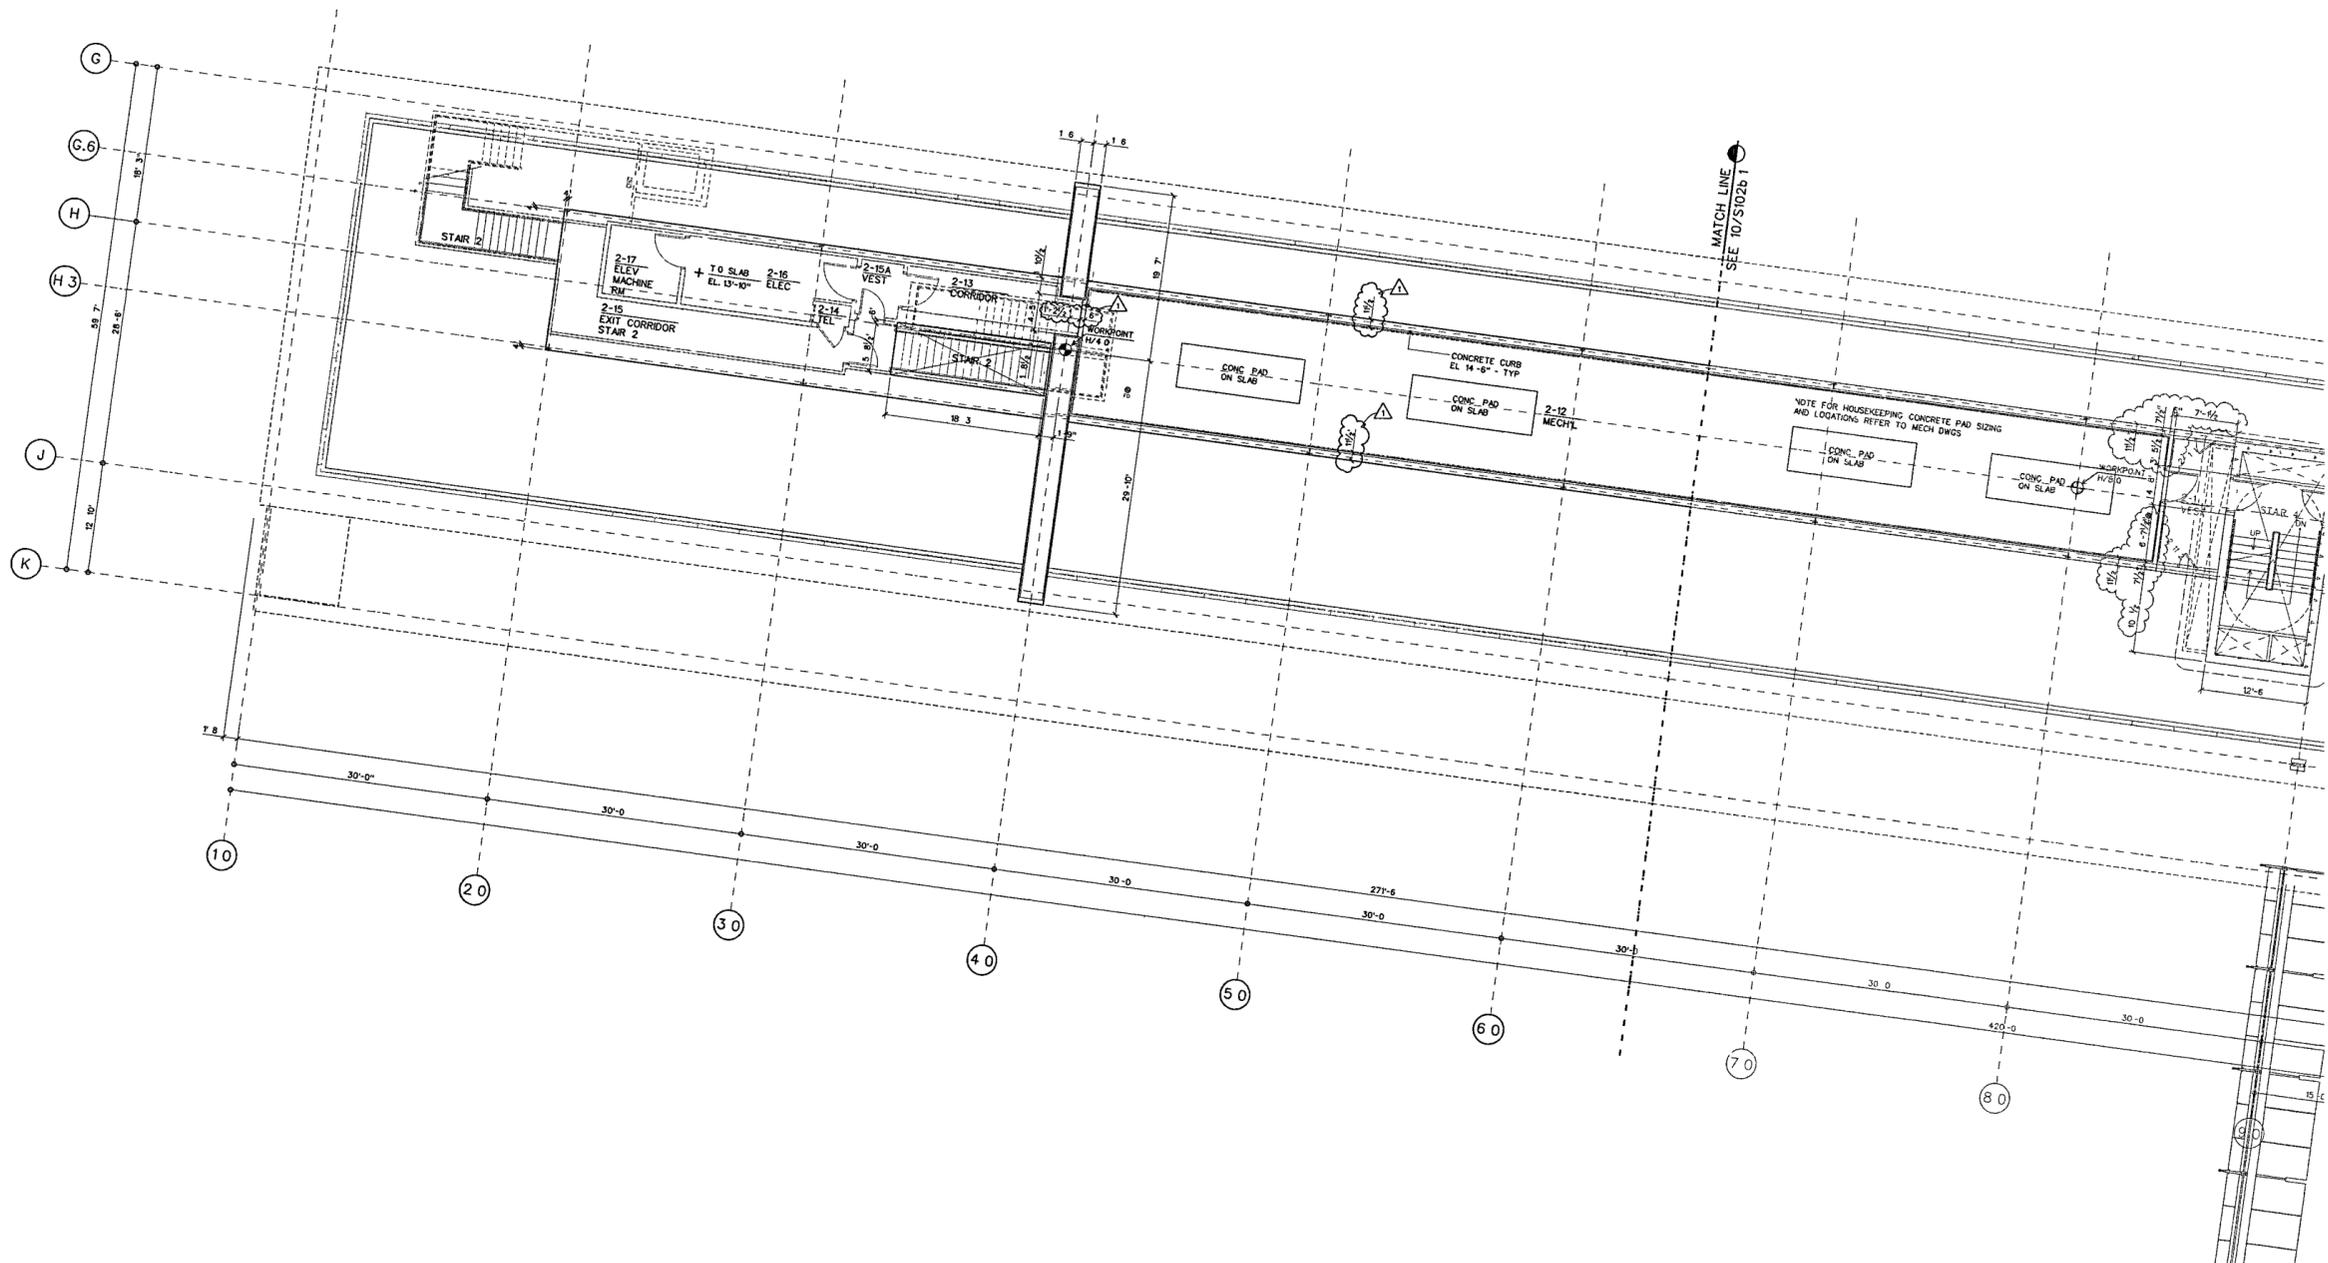

BUILDING WORKPOINT COORDINATES

WORKPOINT	NORTHING (Y)	EASTING (X)
H/4 0	150,627 127270	1,234 743 833746
H/6 0	150,508 944830	1,234 723,007298
H/20 0	150,390 770381	1,234 702 805841
C/20 0	150,301 414924	1,234 756 817845
C/25 0	150 149 032475	1,234 750 845291
C/30 0	150,016,134905	1,234 745 636439

SECOND LEVEL SLAB PLAN A

SCALE 1/8" = 1'-0"

SLAB-02 DGN 10

FOR OFFICIAL USE ONLY

**WILLIAM J CLINTON
PRESIDENTIAL
CENTER**

LITTLE ROCK ARKANSAS

Architect
POLSHK PARTNERSHIP LLP
320 West 13th Street
New York, New York 10014
212 607 7171

Coordinating Architects
POLK STANLEY YEARY ARCHITECTS Ltd
700 South Schaller Street
Little Rock, Arkansas 72201
501 378 0878

WITSELL EVANS RASCO
901 West Third Street
Little Rock, Arkansas 72201
501 374 6300

WOODS CARADINE ARCHITECTS
2200 South Main Street
Little Rock, Arkansas 72206
501 374 4050

Landscape Architects
HARGREAVES ASSOCIATES
118 Magazine Street
Cambridge, Massachusetts 02139
617 681 0070

LANDSCAPE ARCHITECTURE, Inc.
2300 Cotontdale Lane Suite 202
Little Rock, Arkansas 72202
501 374 6810

Structural Engineer
LESLIE E. ROBERTSON ASSOC. RLLP
30 Broad Street, 47th Floor
New York, New York 10004
212 750 9000


MEP Engineers
FLACK + KURTZ Inc.
475 Fifth Avenue
New York, New York 10017
212 532 9500

CROMWELL ARCHITECTS ENGINEERS
101 South Spring Street
Little Rock, Arkansas 72201
501 372 2900

Curtainwall Consultant
R. A. HEINTGES ARCHITECTS
125 Fifth Avenue 9th Floor
New York, New York 10011
212 652 2968



100% Construction Documents	06/27/02
90% Progress Printing	06/30/02
100% Struct./ CD Progress	07/01/02
100% Steel & Concrete CD	05/15/02
& Architectural CD Progress	
Issue	Date
*Issued originally as A702b	

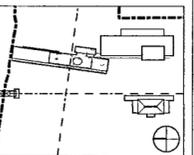


Job No | 9908
Scale | 1/8" = 1'-0"
Date | September 27, 2002
Title

**SECOND LEVEL
PARTIAL SLAB PLAN**

Sheet No
S102b.1

WORKPOINT	NORTHING (Y)	EASTING (X)
H/4 0	150 627 127270	1,234 743 833746
H/6 0	150 508 948830	1,234 723 007298
H/12 0	150,390 770381	1,234 702 190841
C/20 0	150 301,414,924	1,234 756 817845
C/25 0	150 149 032475	1,234 750 845291
C/30 0	150,016 134955	1,234 745 636439

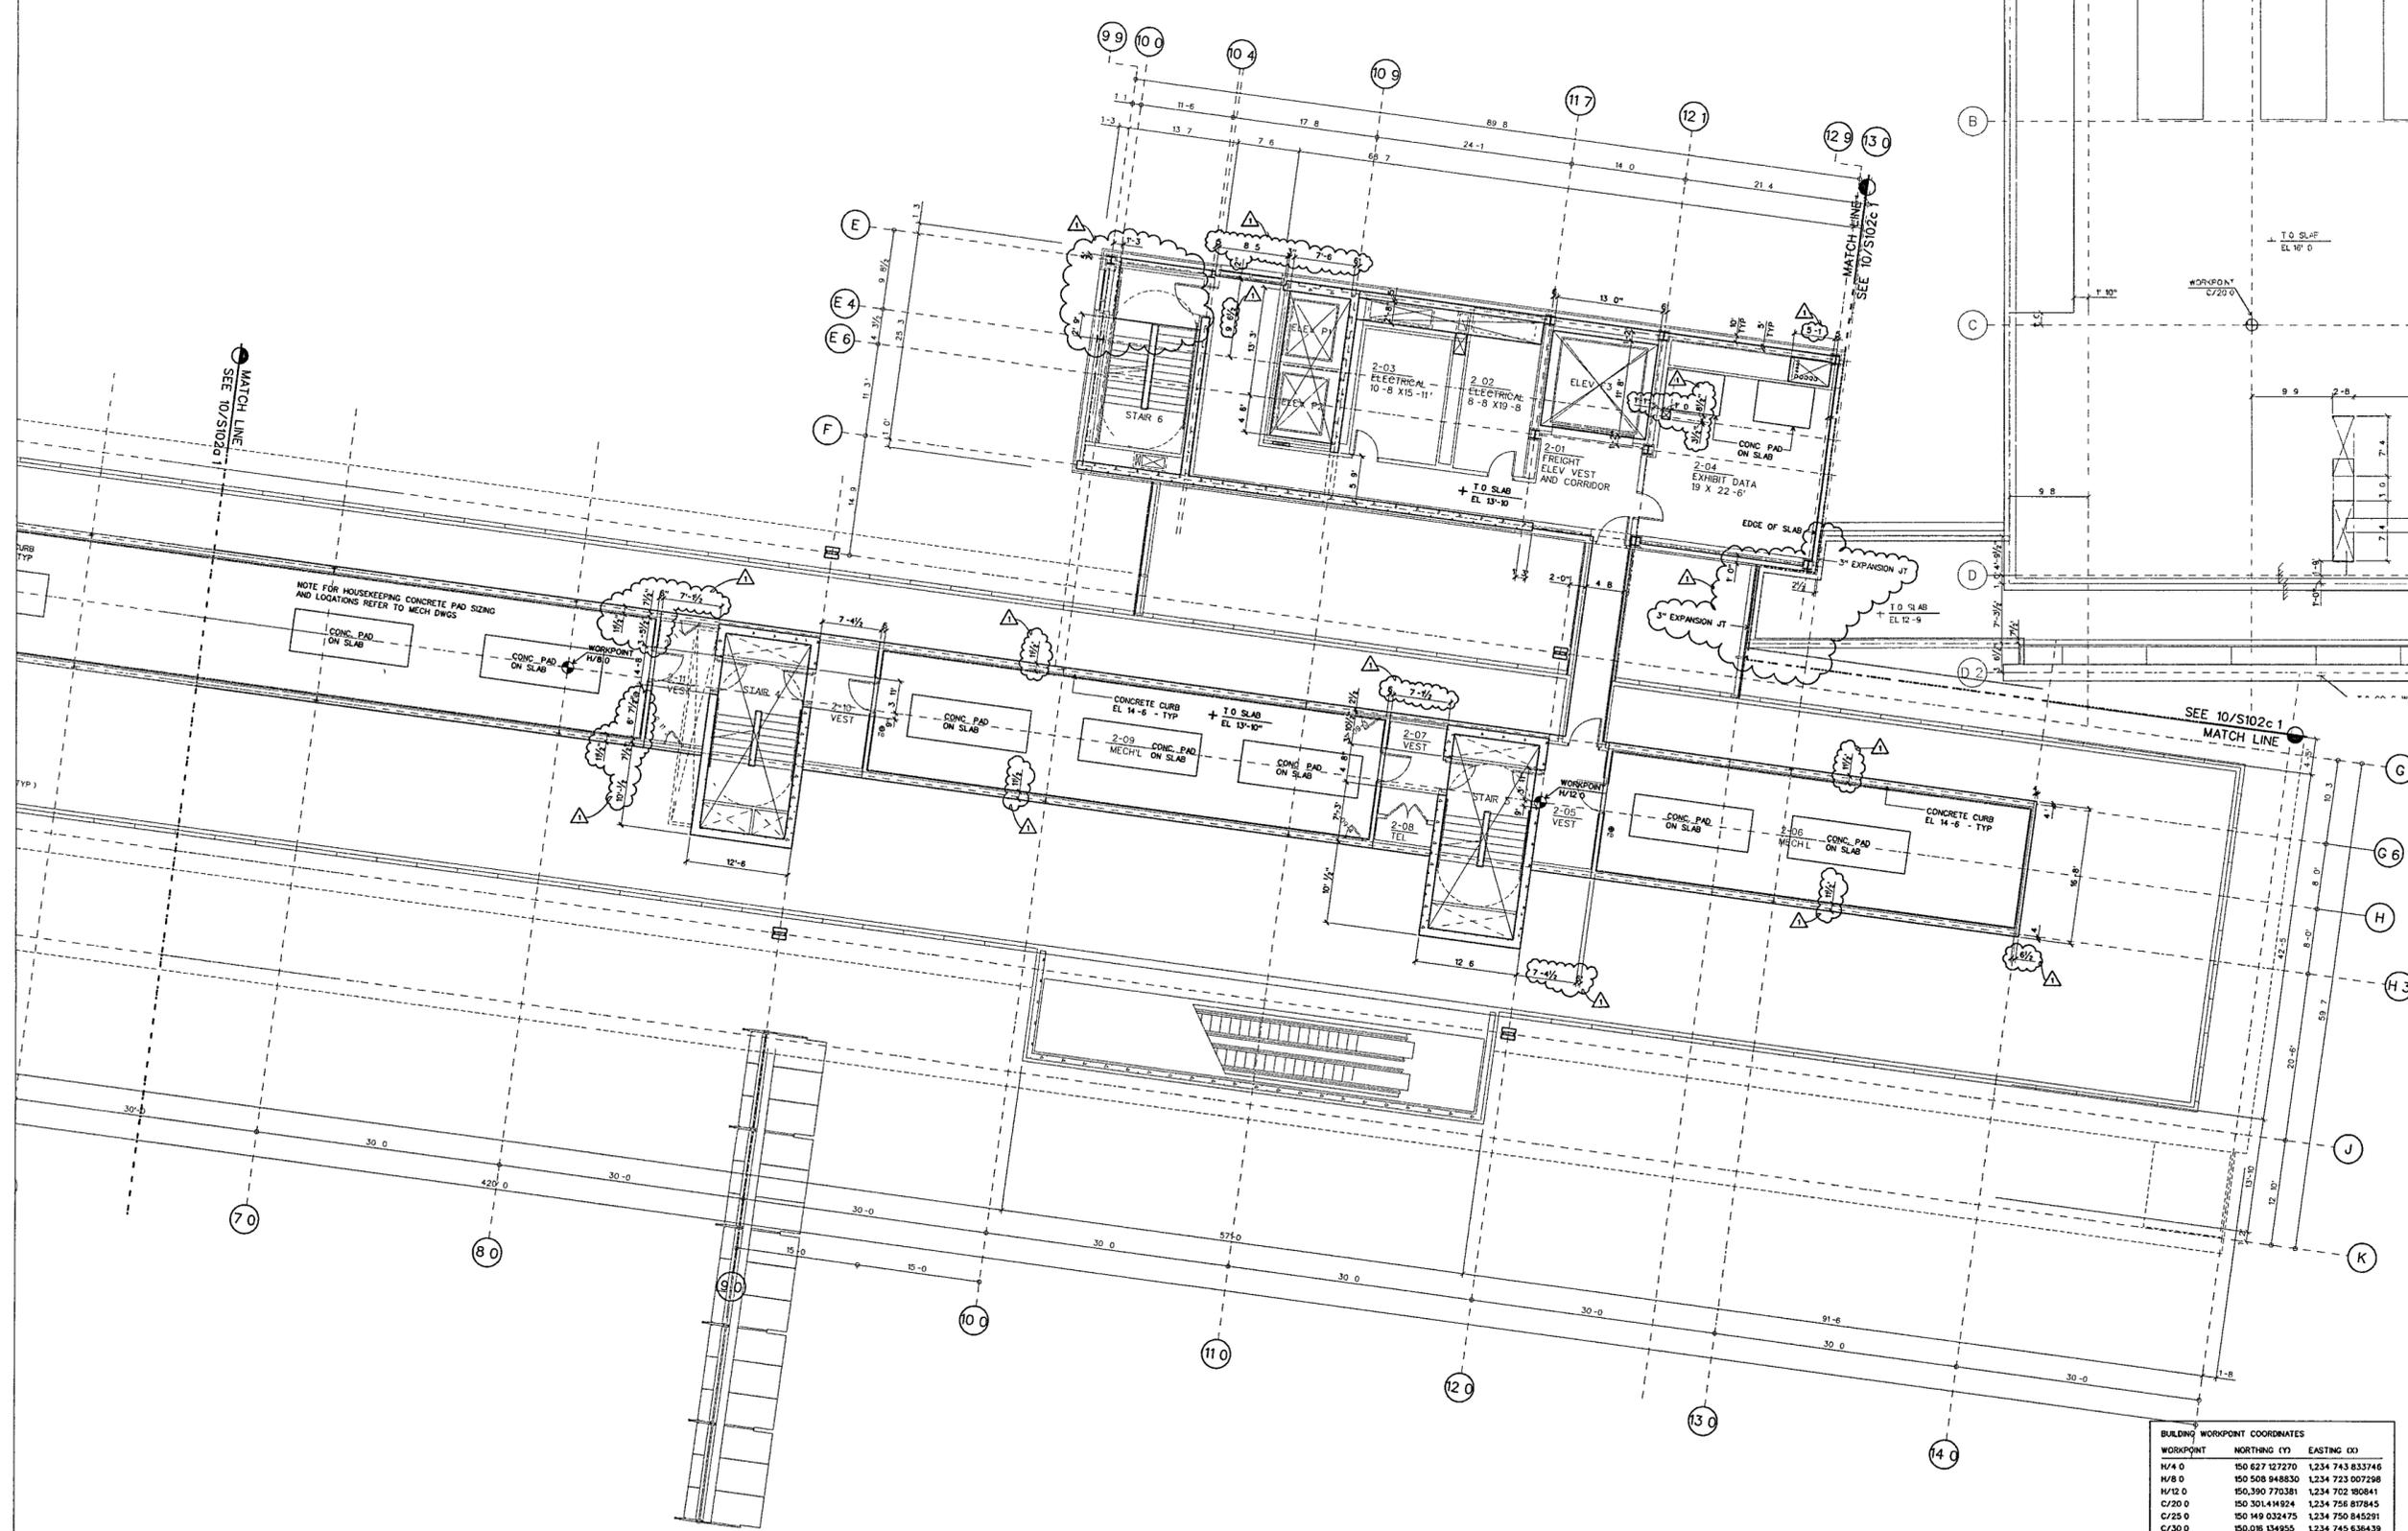

SECOND LEVEL SLAB PLAN B
SCALE 1/8" = 1'-0"

SLAB-02 DGN 10

FOR OFFICIAL USE ONLY

238

**WILLIAM J CLINTON
PRESIDENTIAL
CENTER**

LITTLE ROCK, ARKANSAS

Architect
POLSHEK PARTNERSHIP LLP
320 West 13th Street
New York, New York 10014
212 807 7171

Coordinating Architects
POLK STANLEY YEARY ARCHITECTS Ltd
700 South Schuler Street
Little Rock, Arkansas 72201
501 378 0878

WITSELL EVANS RASCO
901 West Third Street
Little Rock, Arkansas 72201
501 374 5300

WOODS CARADINE ARCHITECTS
2200 South Main Street
Little Rock, Arkansas 72206
501 374 4060

Landscape Architects
HARGREAVES ASSOCIATES
118 Magazine Street
Cambridge, Massachusetts 02139
617 661 0070

LANDSCAPE ARCHITECTURE, Inc.
2300 Cottondale Lane Suite 202
Little Rock, Arkansas 72202
501 374 5510

Structural Engineer
LESLIE E ROBERTSON ASSOC. RLLP
30 Broad Street, 47th Floor
New York, New York 10004
212 759 9000

MEP Engineers
FLACK + KURTZ, Inc.
475 Fifth Avenue
New York, New York 10017
212 532 9600


CROMWELL ARCHITECTS ENGINEERS
101 South Spring Street
Little Rock, Arkansas 72201
501 372 2900

Curtainwall Consultant
R A HEINTGES ARCHITECTS
126 Fifth Avenue 9th Floor
New York, New York 10011
212 652-2966

Seal



100% Construction Documents	09/27/02
90% Progress Printing	08/30/02
100% Struct./CD Progress	07/01/02
100% Steel & Concrete CD	05/15/02
& Architectural CD Progress	
100% Design Development	03/01/02
Issue	Date

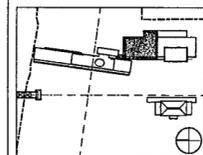

Job No. 9908

Scale 1/8" = 1'-0"

Date September 27, 2002


Title

**SECOND LEVEL
PARTIAL SLAB PLAN**
Sheet No.

S102c.1

10

FOR OFFICIAL USE ONLY

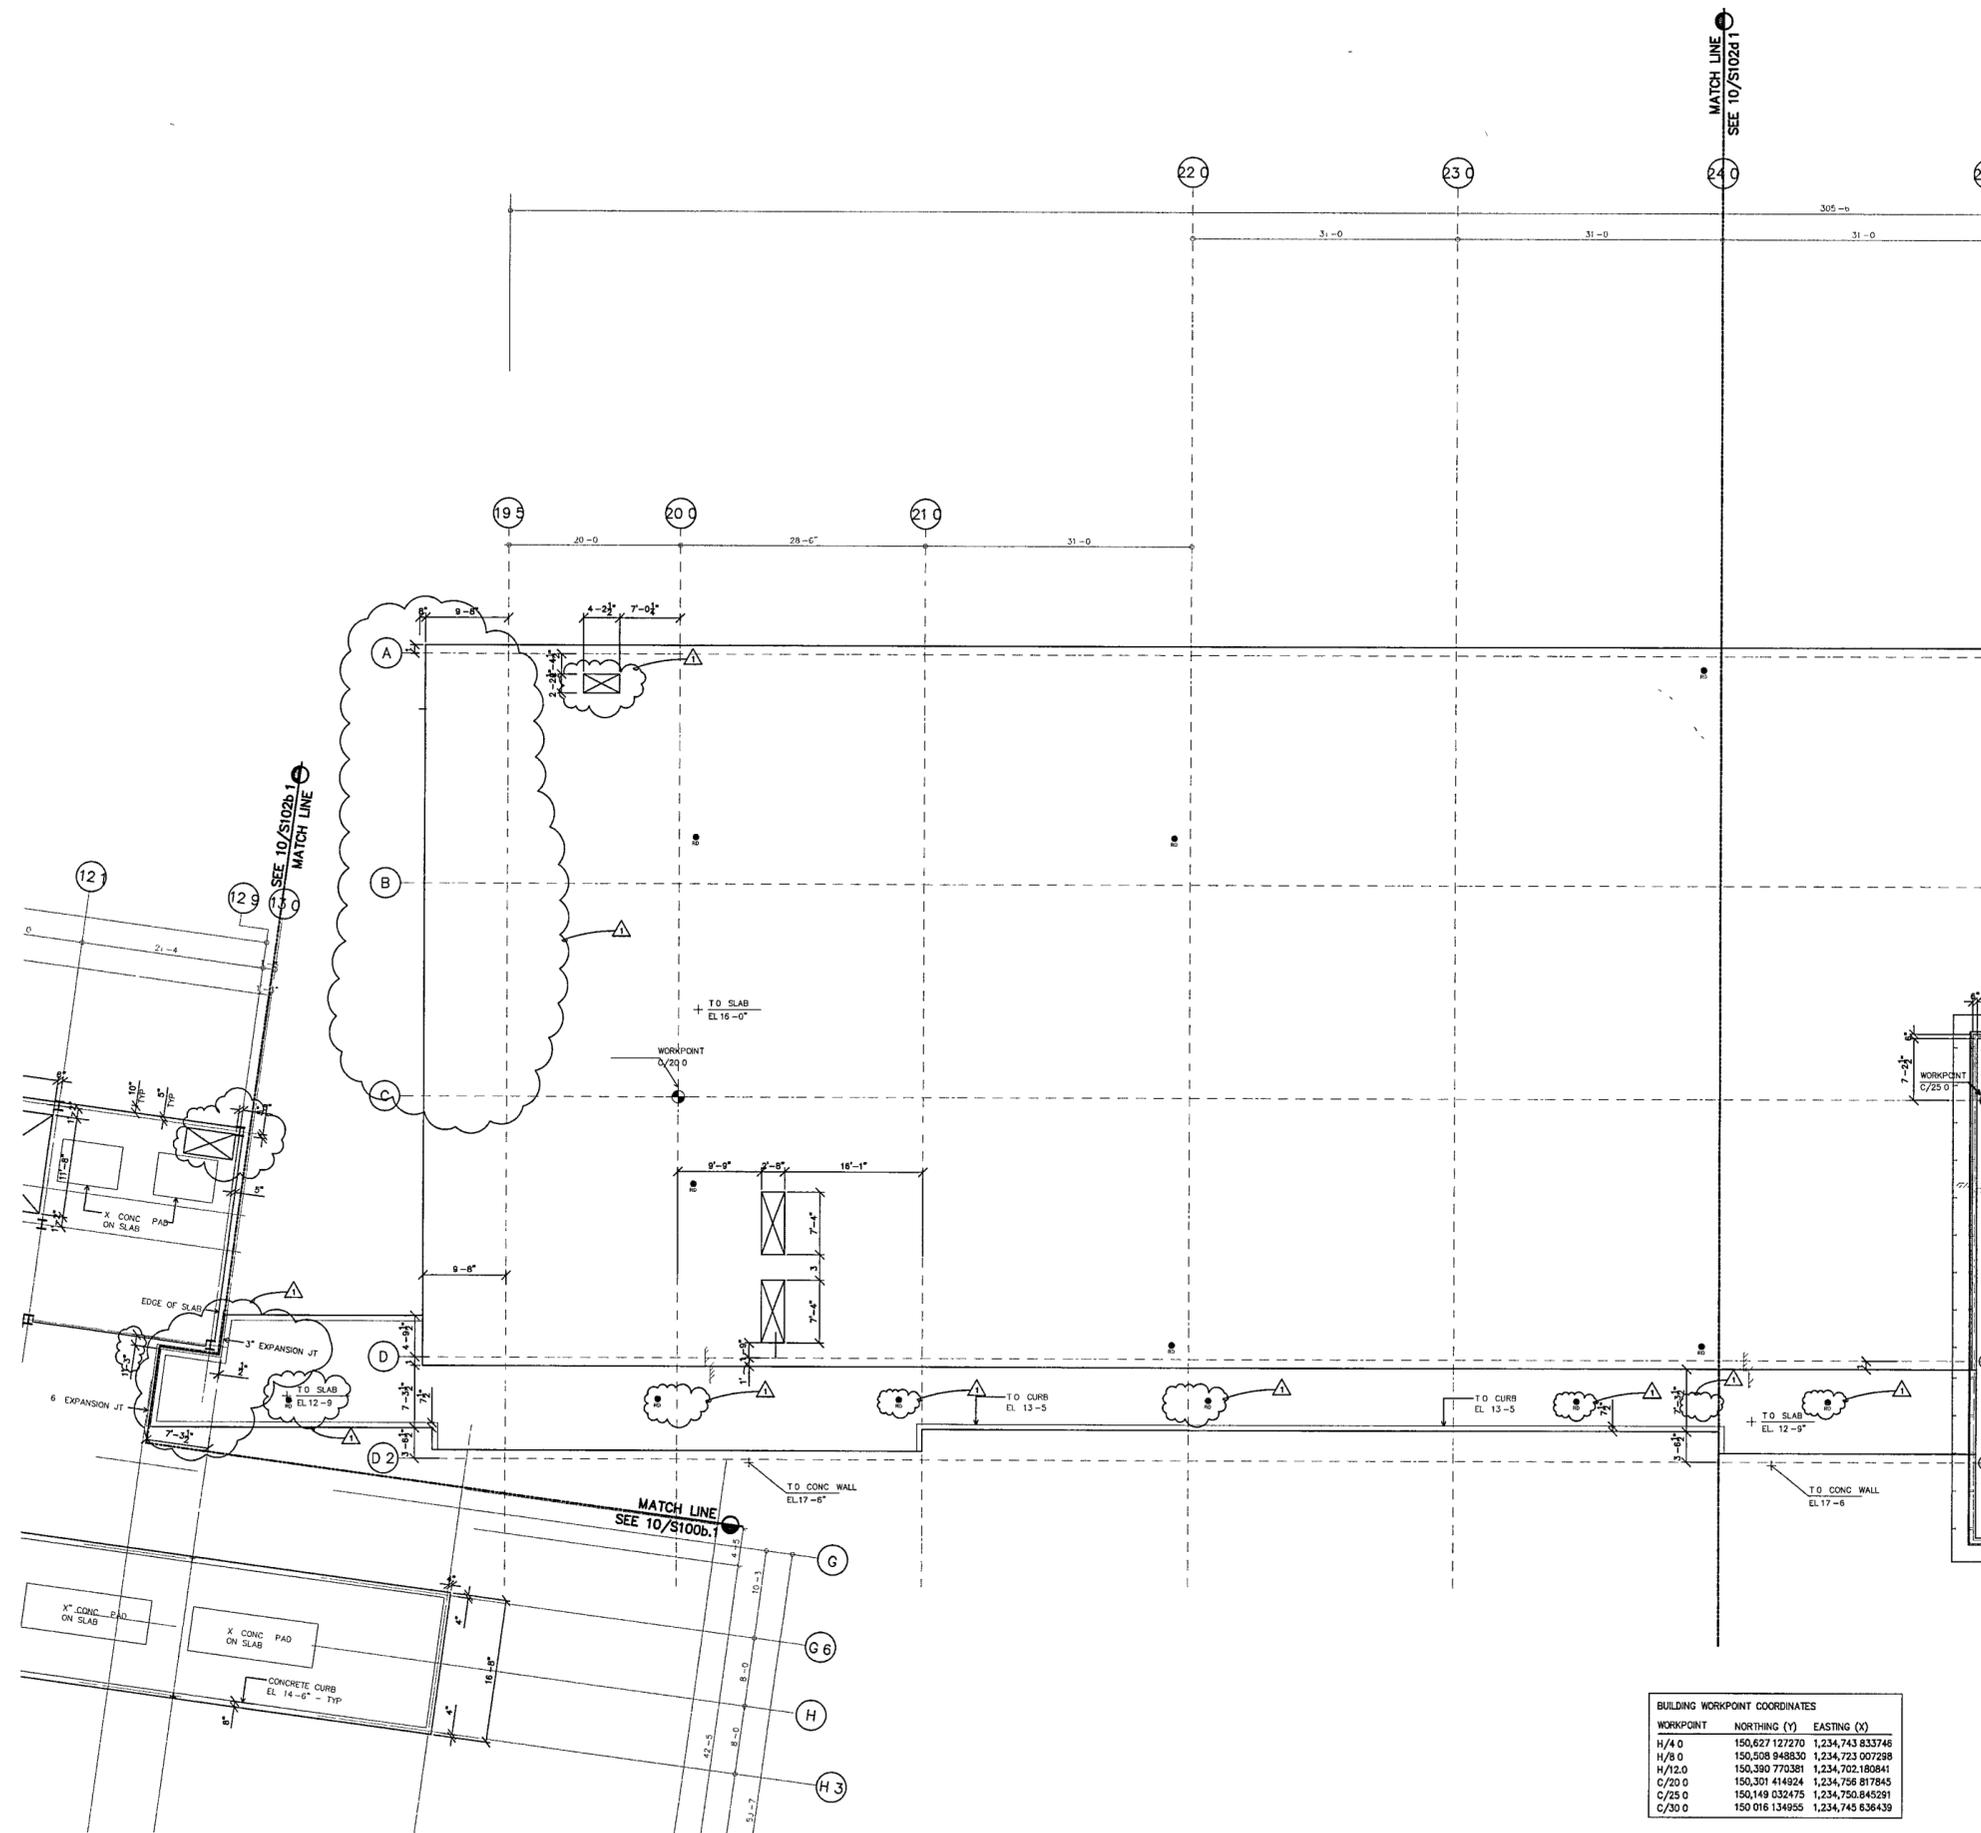

BUILDING WORKPOINT COORDINATES

WORKPOINT	NORTHING (Y)	EASTING (X)
H/4 0	150,627 127270	1,234,743 833746
H/6 0	150,508 948830	1,234,723 907298
H/12 0	150,390 770381	1,234,702 180841
C/20 0	150,301 414924	1,234,756 817845
C/25 0	150,149 032475	1,234,750 845291
C/30 0	150 016 134955	1,234,745 836439

SECOND LEVEL SLAB PLAN C

SCALE 1/8" = 1'-0"

**WILLIAM J CLINTON
PRESIDENTIAL
CENTER**

LITTLE ROCK, ARKANSAS

Architect
POLSHEK PARTNERSHIP LLP
320 West 13th Street
New York, New York 10014
212 807 7171

Coordinating Architects
POLK STANLEY YEARY ARCHITECTS Ltd
700 South Schiller Street
Little Rock, Arkansas 72201
501 378 0878

WITSELL EVANS RASCO
901 West Third Street
Little Rock, Arkansas 72201
501 374 5300

WOODS CARADINE ARCHITECTS
2200 South Main Street
Little Rock, Arkansas 72206
501 374 4060

Landscape Architects
HARGREAVES ASSOCIATES
118 Magazine Street
Cambridge, Massachusetts 02139
617 661 0070


LANDSCAPE ARCHITECTURE Inc
2300 Cottondale Lane Suite 202
Little Rock, Arkansas 72202
501 374 5610

Structural Engineer
LESLIE E ROBERTSON ASSOC , RLLP
30 Broad Street, 47th Floor
New York, New York 10004
212 750 9000


MEP Engineers
FLACK + KURTZ Inc
475 Fifth Avenue
New York, New York 10017
212 532 9600

CROMWELL ARCHITECTS ENGINEERS
101 South Spring Street
Little Rock, Arkansas 72201
501 372 2900

Curianwall Consultant
R A HEINTGES ARCHITECTS
128 Fifth Avenue, 9th Floor
New York, New York 10011
212 652-2966

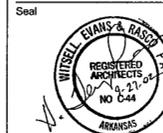


Issue	Date
100% Construction Documents	09/27/02
90% Progress Printing	08/30/02
100% Struct./CD Progress	07/01/02
100% Steel & Concrete CD	05/15/02
& Architectural CD Progress	
100% Design Development	03/01/02

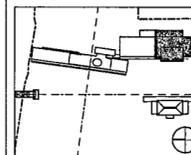

Job No 9908
Scale 1/8" = 1'-0"
Date September 27, 2002
Title

**SECOND LEVEL
PARTIAL SLAB PLAN**

Sheet No
S102d.1

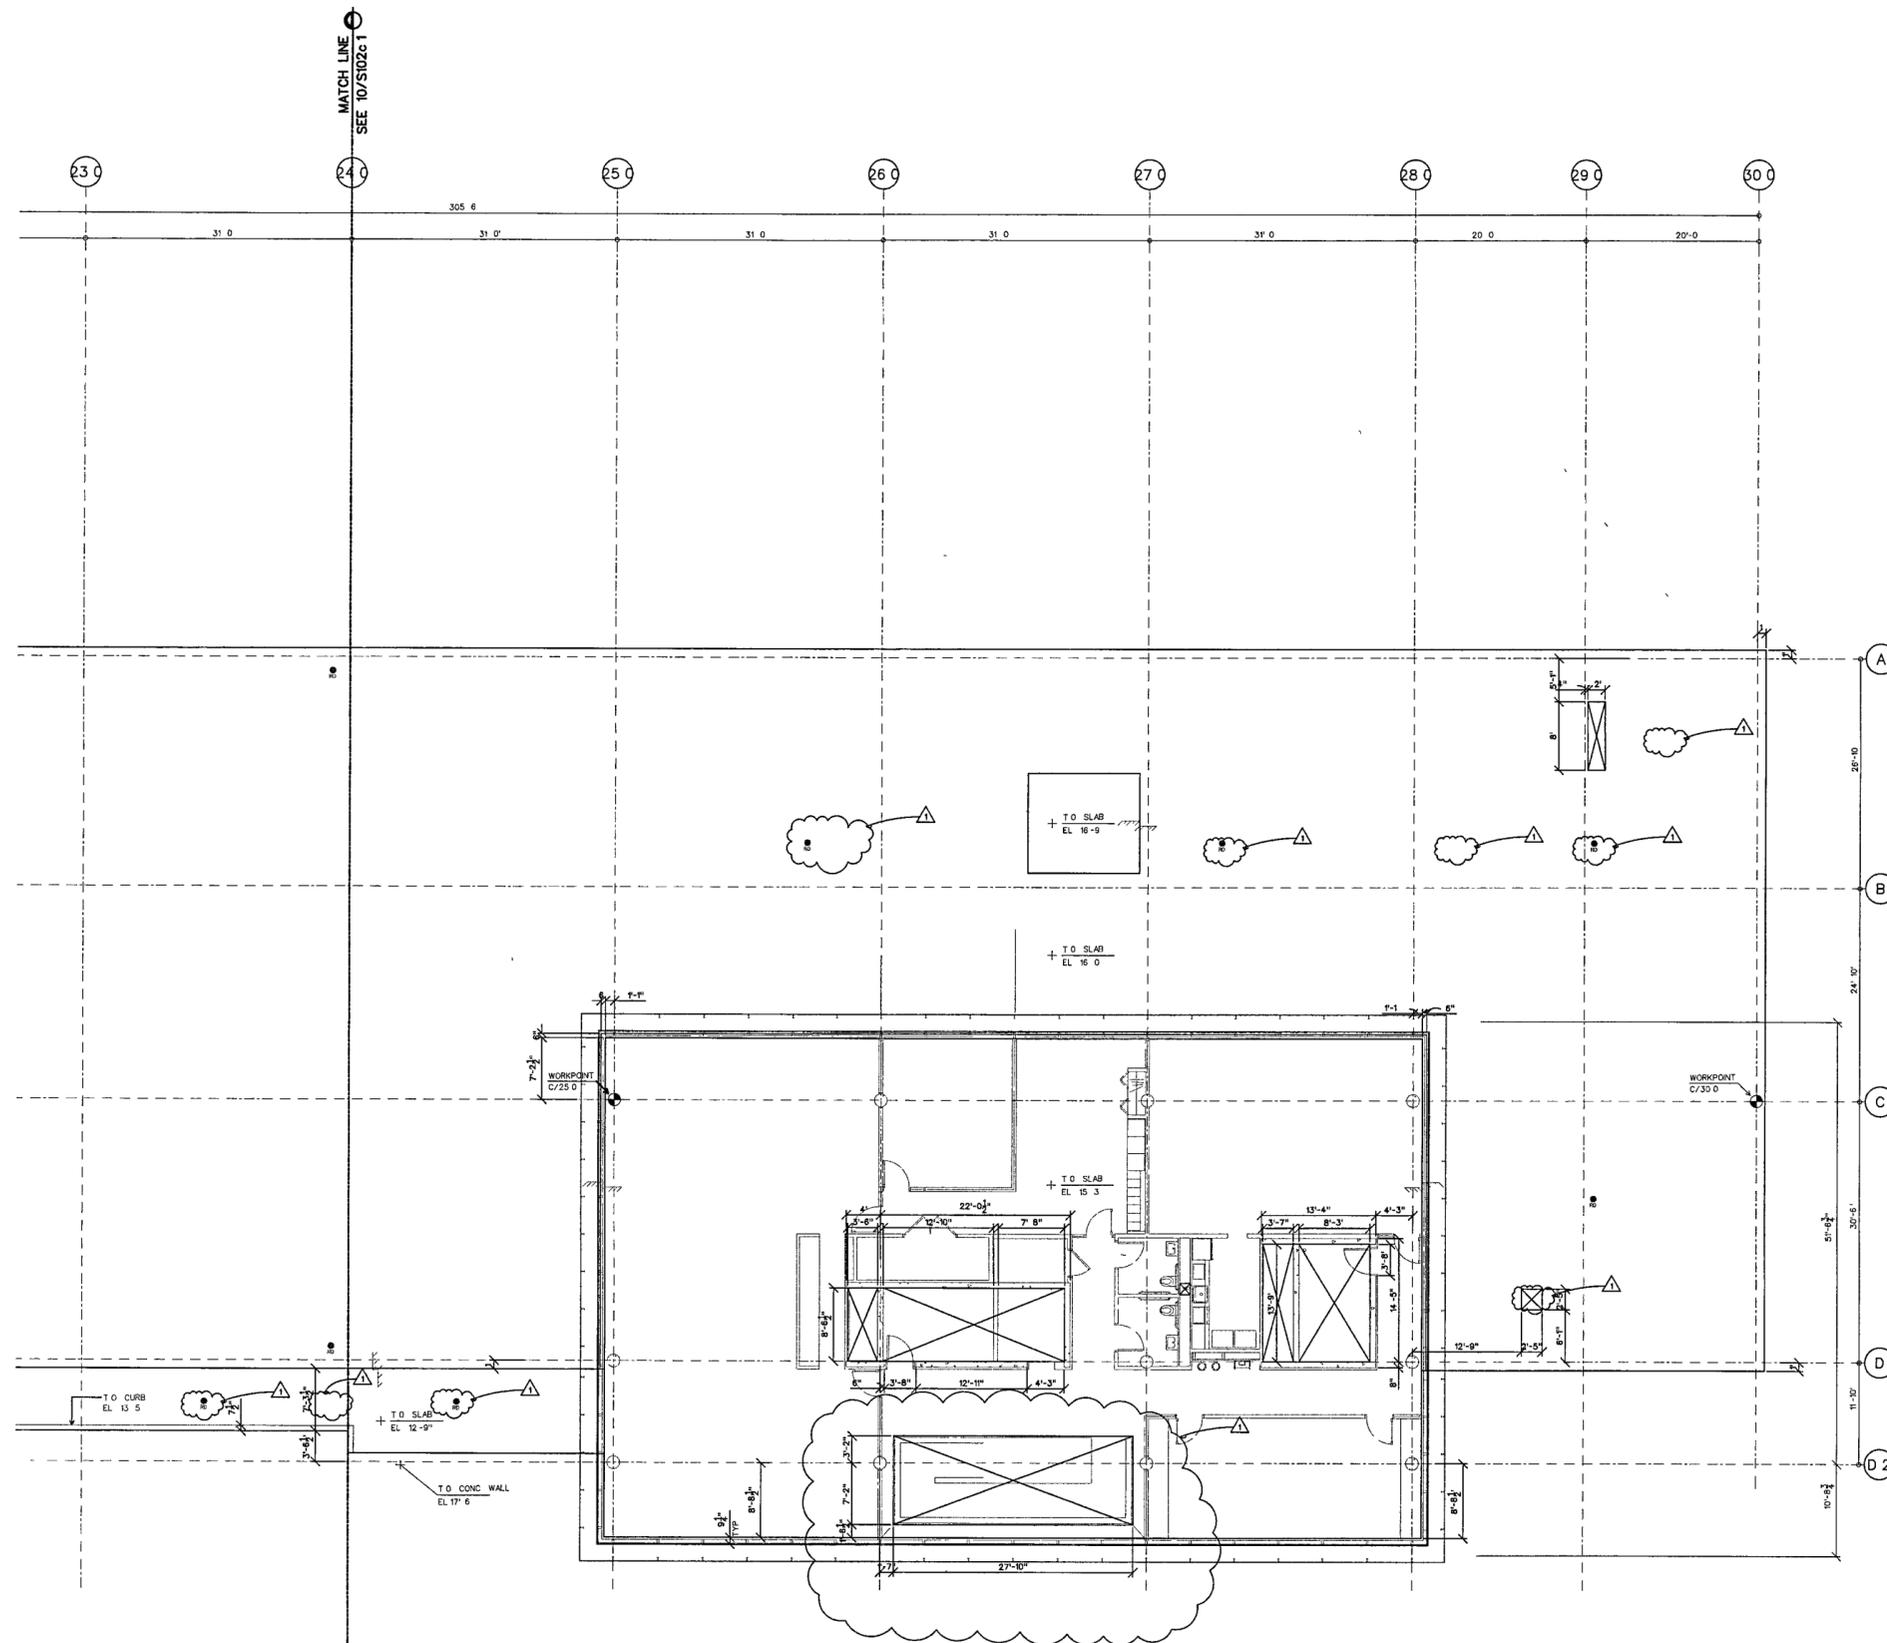

SECOND LEVEL SLAB PLAN D

SCALE 1/8" = 1'-0"

WORKPOINT	NORTHING (Y)	EASTING (X)
H/4.0	150,627.127270	1,234,743.833746
H/8.0	150,568.948830	1,234,723.007298
H/12.0	150,390.770381	1,234,702.180841
C/20.0	150,301.414924	1,234,756.817845
C/25.0	150,149.032475	1,234,750.845291
C/30.0	150,016.134955	1,234,745.836439

**WILLIAM J CLINTON
PRESIDENTIAL
CENTER**

LITTLE ROCK, ARKANSAS

Architect

POLSHEK PARTNERSHIP LLP
320 West 13th Street
New York, New York 10014
212 607 7171

Coordinating Architects

POLK STANLEY YEARY ARCHITECTS LTD
700 South Schiller Street
Little Rock, Arkansas 72201
501 378 0878

WITSELL EVANS RASCO
901 West Third Street
Little Rock, Arkansas 72201
501 374 5300

WOODS CARADINE ARCHITECTS
2200 South Main Street
Little Rock, Arkansas 72206
501 374 4060

Landscape Architects

HARGREAVES ASSOCIATES
118 Magazine Street
Cambridge, Massachusetts 02139
617 861 0070

LANDSCAPE ARCHITECTURE, Inc.
2300 Cottondale Lane Suite 202
Little Rock, Arkansas 72202
501 374 5610

Structural Engineer

LESLIE E ROBERTSON ASSOC., RLLP
30 Broad Street, 47th Floor
New York, New York 10004
212.750.9000

MEP Engineers

FLACK + KURTZ Inc.
475 Fifth Avenue
New York, New York 10017
212.532.9600

CROMWELL ARCHITECTS ENGINEERS
101 South Spring Street
Little Rock, Arkansas 72201
501 372.2900


Curtainwall Consultant

R. A. HEINTGES ARCHITECTS
125 Fifth Avenue 9th Floor
New York, New York 10011
212 652-2968

Seal



100% Construction Documents	06/27/02
90% Progress Printing	08/30/02
100% Struct/ CD Progress	07/01/02
100% Steel & Concrete CD	05/15/02
& Architectural CD Progress	
Issue	Date
*Issued originally as A703a	

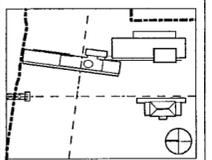


Job No 9908
Scale 1/8" = 1'-0"

Date September 27, 2002

Title
**MUSEUM
LOWER LEVEL
PARTIAL SLAB PLAN**

Sheet No
S103a.1

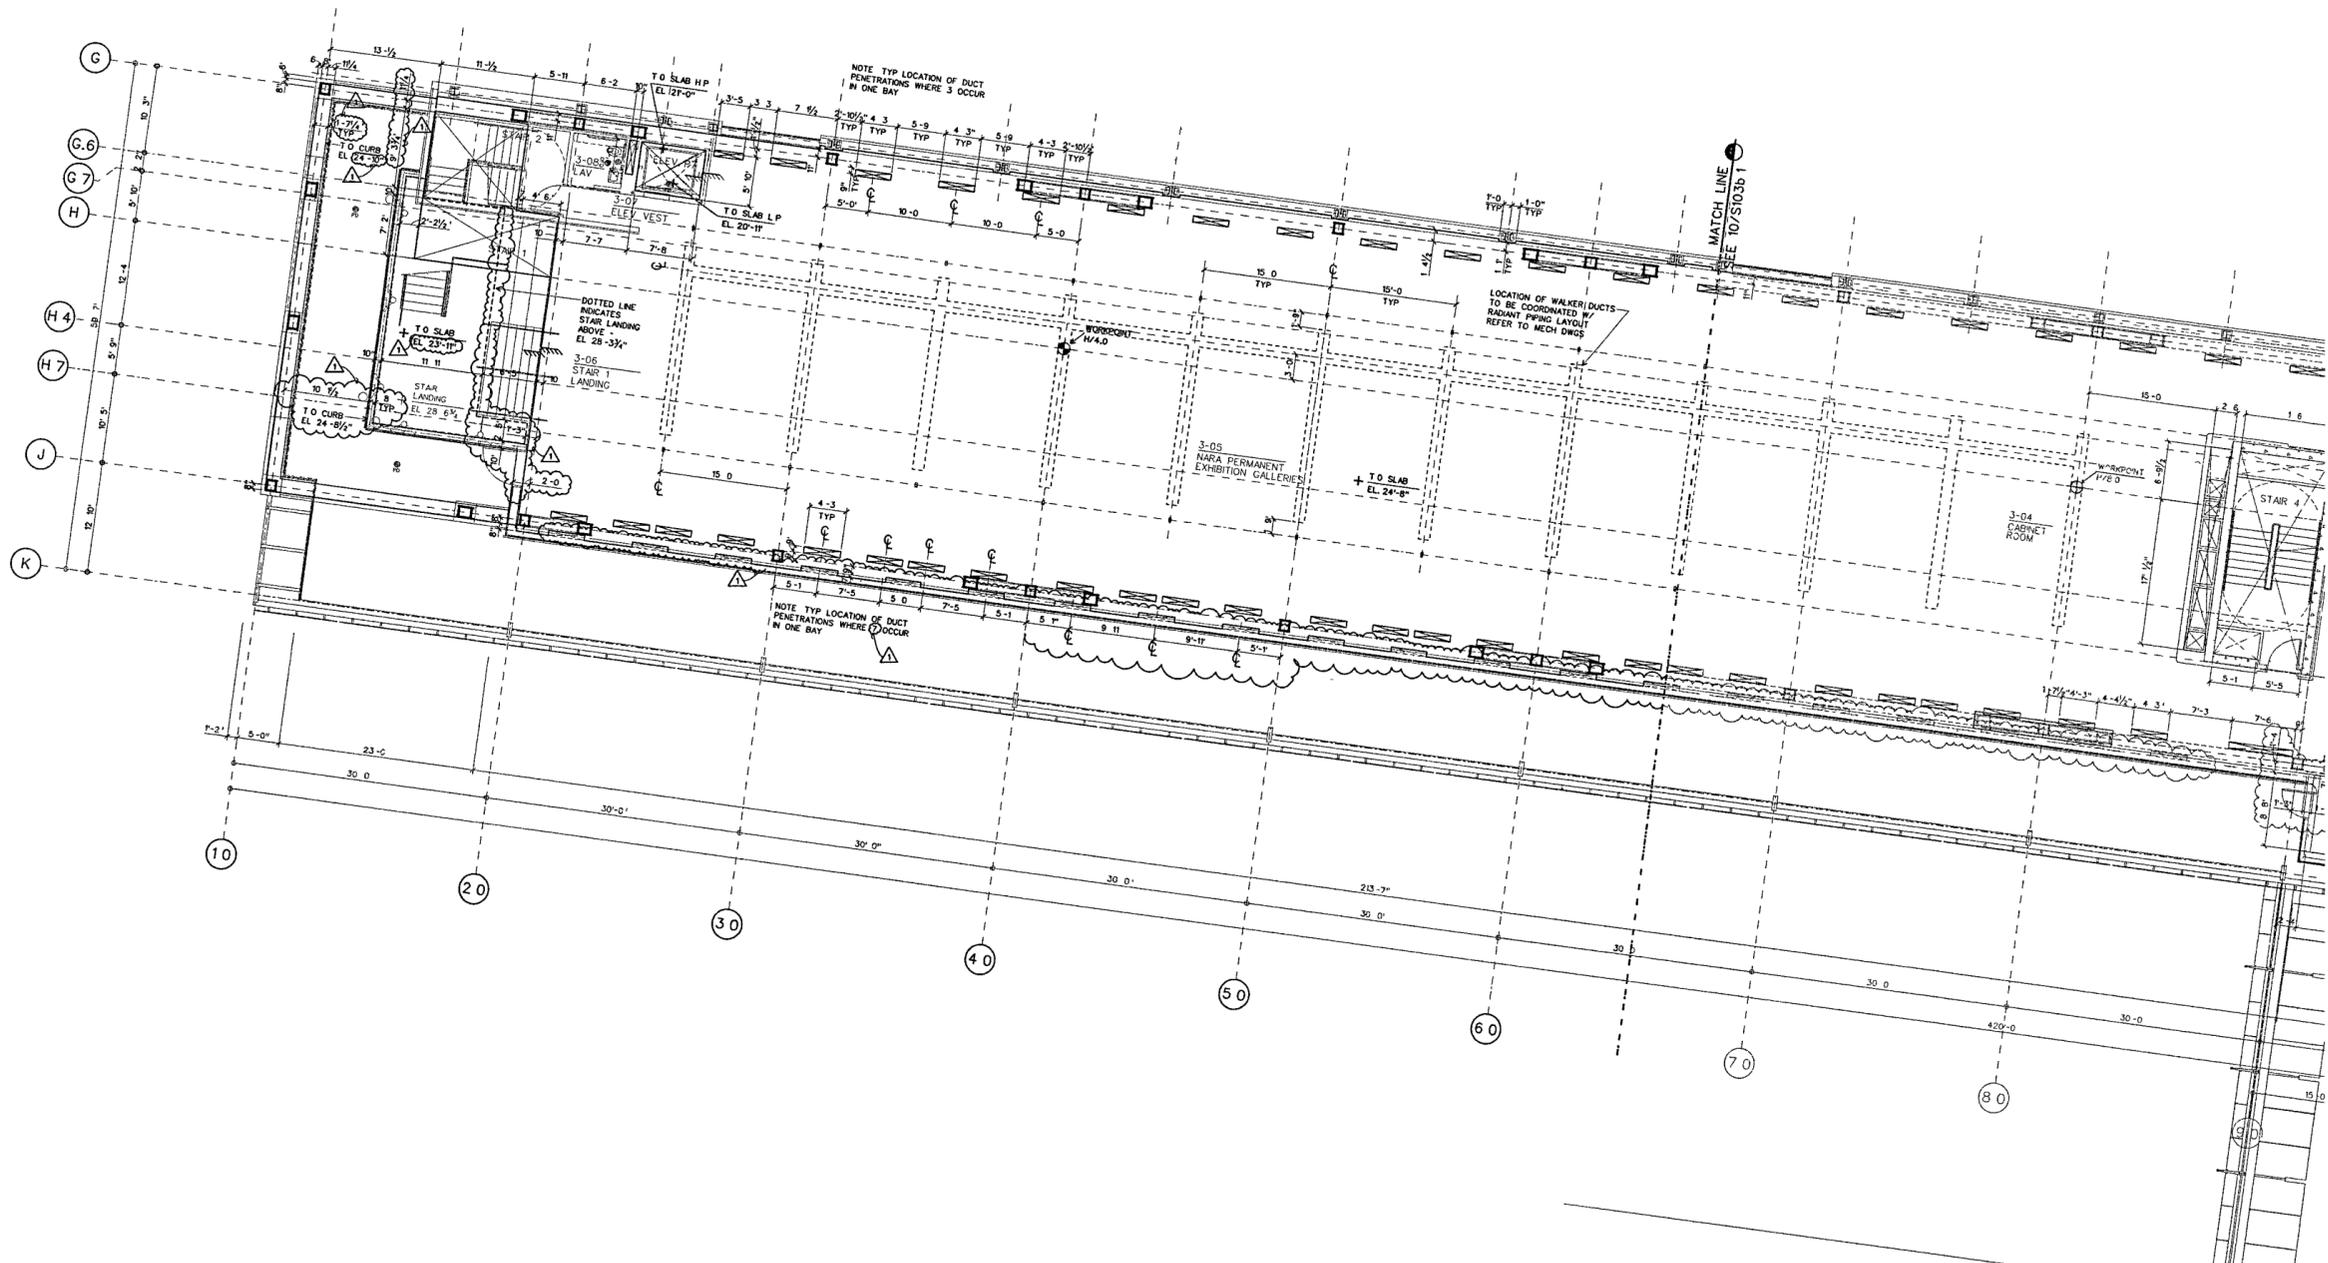

WORKPOINT	NORTHING (Y)	EASTING (X)
H/4.0	150 627 127270	1234 743 833746
H/6.0	150,568 948830	1234 723 007296
H/12.0	150,390 770381	1234 702 808841
C/20.0	150 30141924	1234 756 817845
C/25.0	150 149 032475	1234 750 845291
C/30.0	150 016 134955	1234 745 636439

MUSEUM LOWER LEVEL SLAB PLAN A

SCALE 1/8" = 1'-0"

SLAB-03 DGN 10

FOR OFFICIAL USE ONLY

**WILLIAM J CLINTON
PRESIDENTIAL
CENTER**

LITTLE ROCK, ARKANSAS

Architect
POLSHEK PARTNERSHIP LLP
320 West 13th Street
New York, New York 10014
212.807.7171

Coordinating Architects
POLK STANLEY YEARY ARCHITECTS Ltd
700 South Schuler Street
Little Rock, Arkansas 72201
501.378.0878

WITSELL EVANS RASCO
901 West Third Street
Little Rock, Arkansas 72201
501.374.5300

WOODS CARADINE ARCHITECTS
2200 South Main Street
Little Rock, Arkansas 72206
501.374.4055

Landscape Architects
HARGREAVES ASSOCIATES
118 Magalloway Street
Cambridge, Massachusetts 02139
617.661.0070

LANDSCAPE ARCHITECTURE, Inc.
2300 Cotuit Lane Suite 202
Little Rock, Arkansas 72202
501.374.5810

Structural Engineer
LESLIE E ROBERTSON ASSOC RLLP
30 Broad Street, 4th Floor
New York, New York 10004
212.750.9000

MEP Engineers
FLACK + KURTZ Inc
475 Fifth Avenue
New York, New York 10017
212.532.9600


CROMWELL ARCHITECTS ENGINEERS
101 South Spring Street
Little Rock, Arkansas 72201
501.372.2900

Curtainwall Consultant
R. A. HEINTGES ARCHITECTS
1228 Fifth Avenue, 9th Floor
New York, New York 10011
212.652.2866

Seal



100% Construction Documents	08/27/02
90% Progress Printing	08/30/02
100% Struct./CD Progress	07/01/02
100% Steel & Concrete CD	05/15/02
& Architectural CD Progress	
Issue	Date
*Issued originally as A703b	

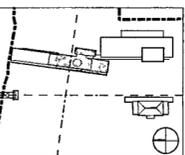

Job No 9908

Scale 1/8" = 1'-0"


Date September 27, 2002

Title
**MUSEUM
LOWER LEVEL
PARTIAL SLAB PLAN**

Sheet No

S103b.1

WORKPOINT	NORTHING (Y)	EASTING (X)
H/4 0	150,827.127270	1,234,743.833746
H/8 0	150,508.948830	1,234,723.007298
H/12 0	150,380.770381	1,234,702.808841
C/20 0	150,301.414924	1,234,726.817845
C/25 0	150,149.032475	1,234,750.845291
C/30 0	150,016.134955	1,234,745.836439

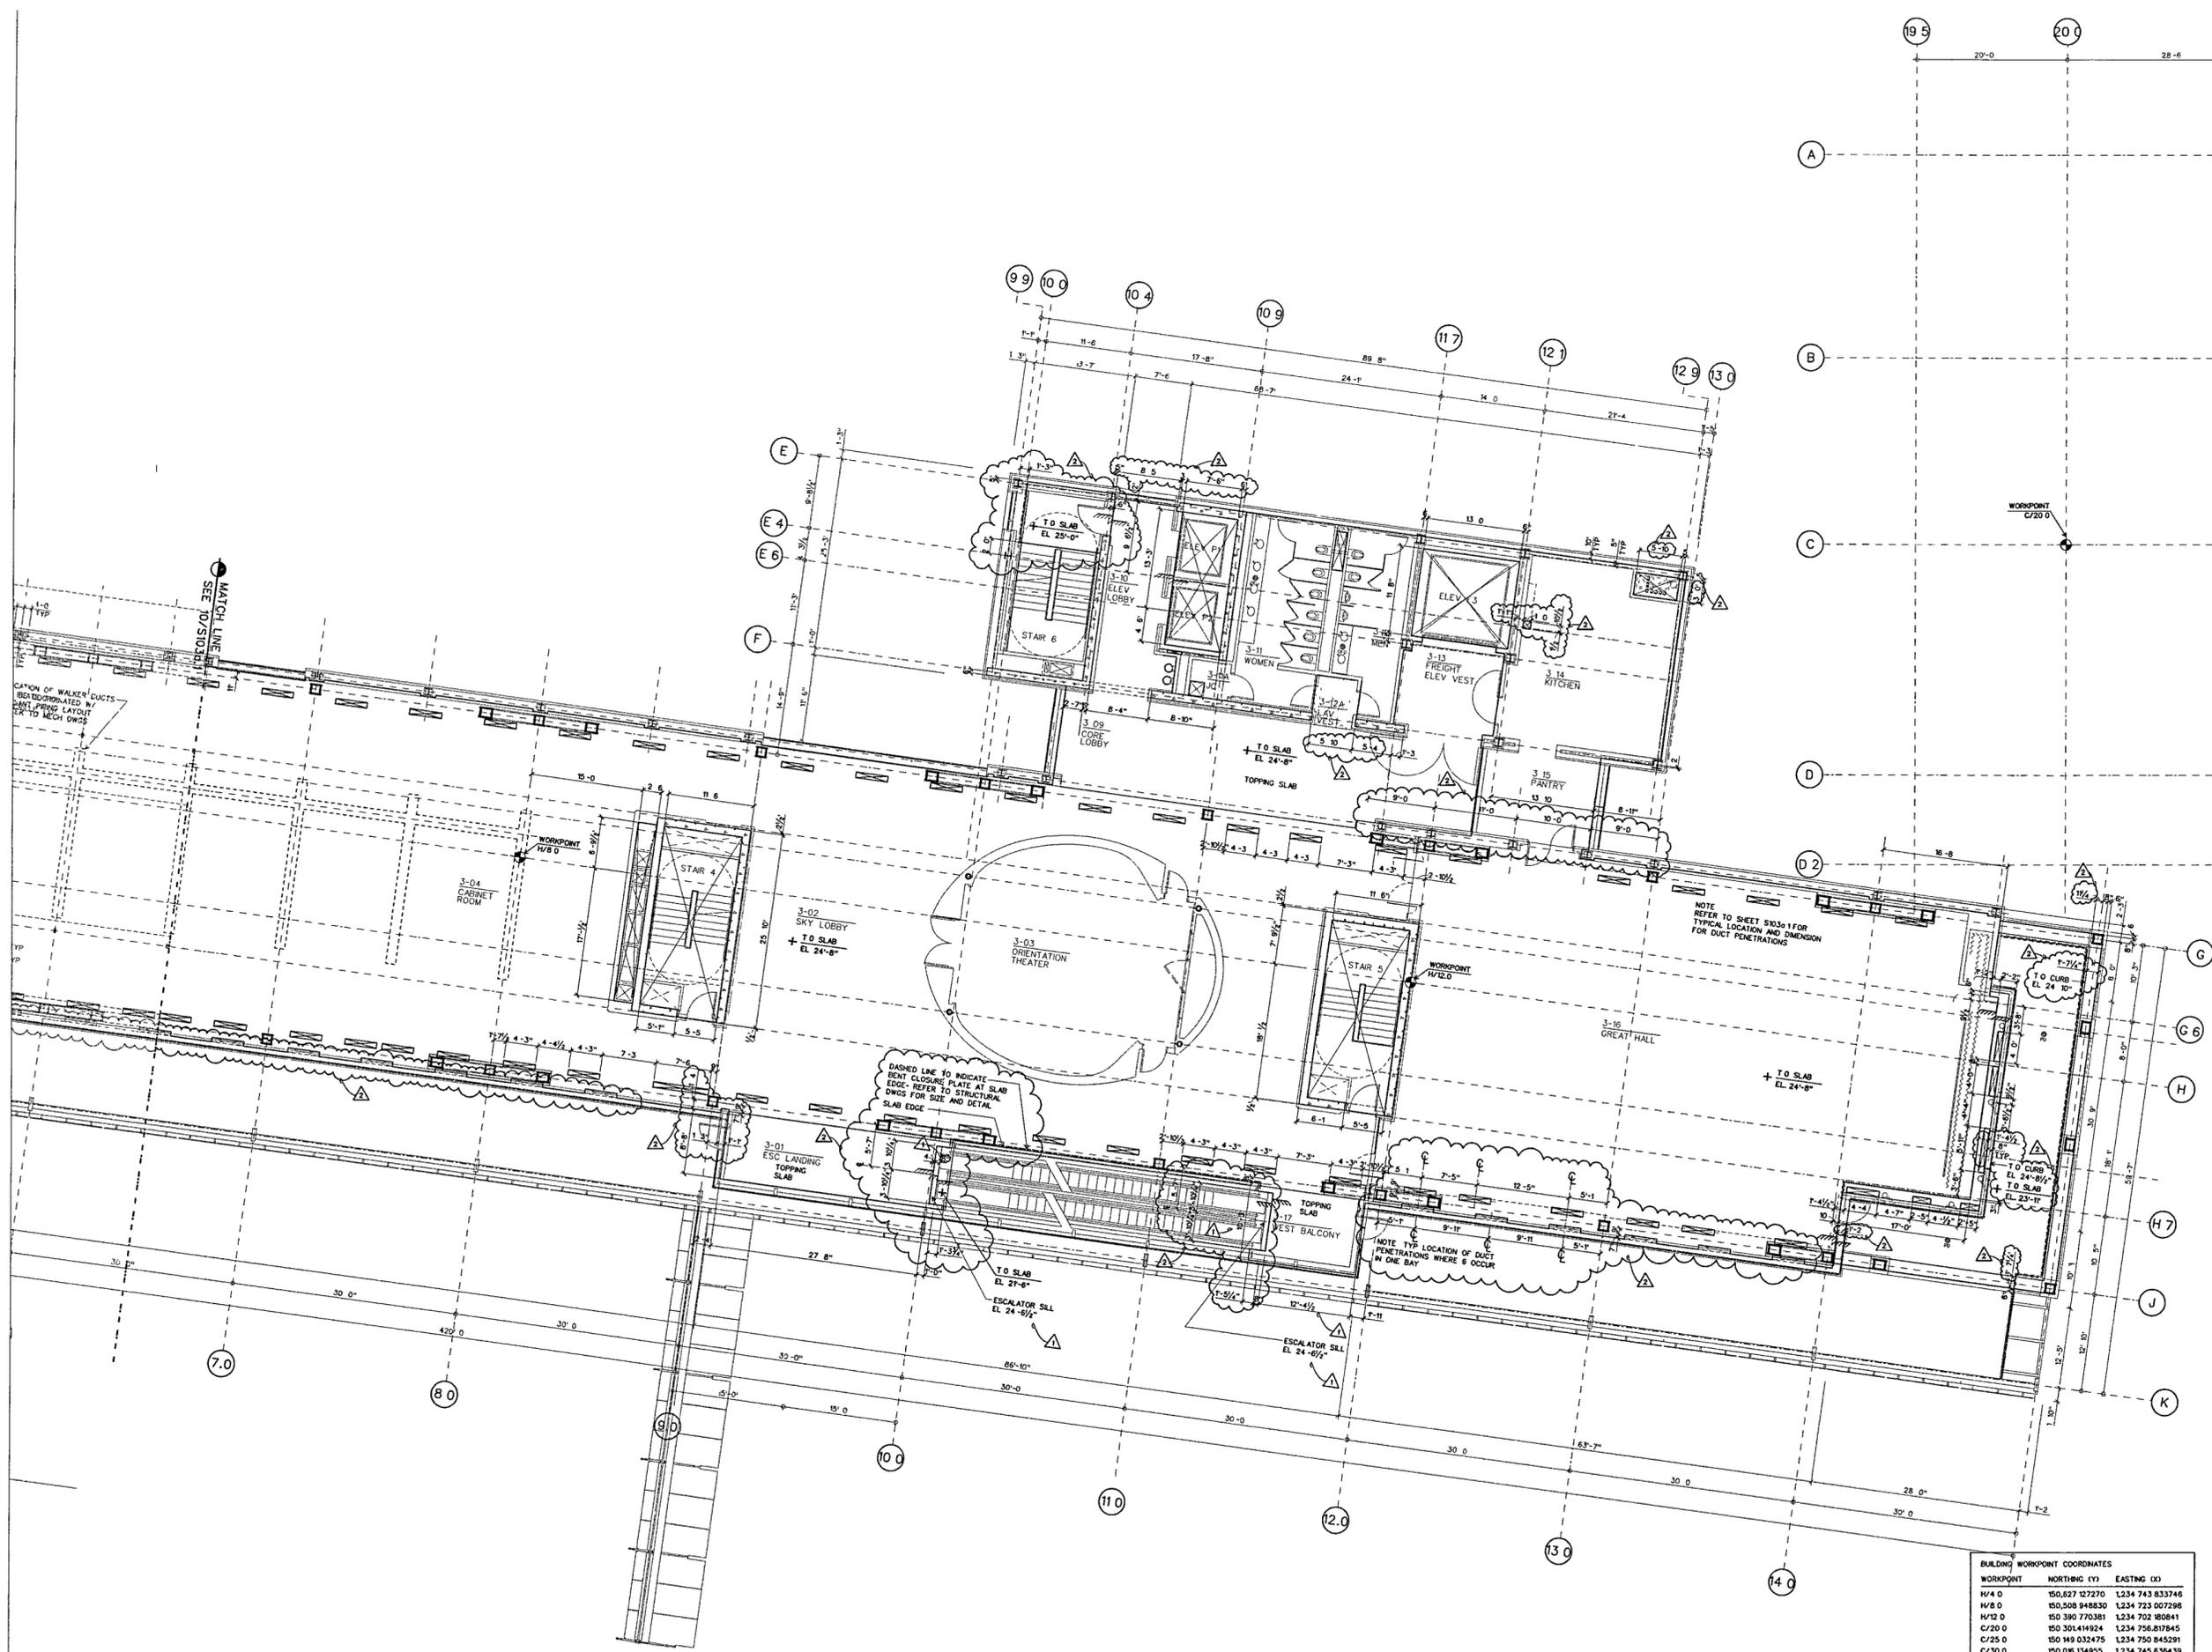

MUSEUM LOWER LEVEL SLAB PLAN B

SCALE 1/8" = 1'-0"

SLAB-03 DGN

10

FOR OFFICIAL USE ONLY

**WILLIAM J CLINTON
PRESIDENTIAL
CENTER**

LITTLE ROCK ARKANSAS

Architect
POLSHAK PARTNERSHIP LLP
320 West 13th Street
New York, New York 10014
212 807 7171

Coordinating Architects
POLK STANLEY YEARY ARCHITECTS L.L.C.
700 South Schiller Street
Little Rock, Arkansas 72201
501 378 0878

WITSELL EVANS RASCO
901 West Third Street
Little Rock, Arkansas 72201
501 374 5300

WOODS CARADINE ARCHITECTS
2200 South Main Street
Little Rock, Arkansas 72206
501 374 4060

Landscape Architects
HARGREAVES ASSOCIATES
118 Magazine Street
Cambridge Massachusetts 02139
617 661 0370


LANDSCAPE ARCHITECTURE, Inc.
2300 Cottondale Lane Suite 202
Little Rock, Arkansas 72202
501 374 5610

Structural Engineer
LESLIE E. ROBERTSON ASSOC., R.L.P.
33 Broad Street, 47th Floor
New York, New York 10004
212 750 9000


MEP Engineers
FLACK + KURTZ Inc.
475 Fifth Avenue
New York, New York 10017
212 532 9600

CROMWELL ARCHITECTS ENGINEERS
101 South Spring Street
Little Rock, Arkansas 72201
501 372 2900

Curtilwall Consultant
R. A. HEINTGES ARCHITECTS
126 Fifth Avenue, 9th Floor
New York, New York 10011
212 652 2886

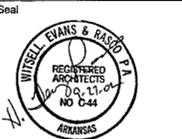


Issue	Date
100% Construction Documents	09/27/02
90% Progress Printing	08/30/02
100% Struct./CD Progress	07/01/02
100% Steel & Concrete CD	05/15/02
& Architectural CD Progress	
100% Design Development	03/01/02

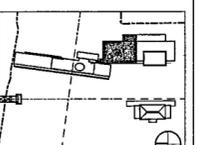

Job No 9908
Scale 1/8" = 1'-0"
Date September 27 2002
Title

**THIRD LEVEL
PARTIAL SLAB PLAN**
Sheet No
S103d.1

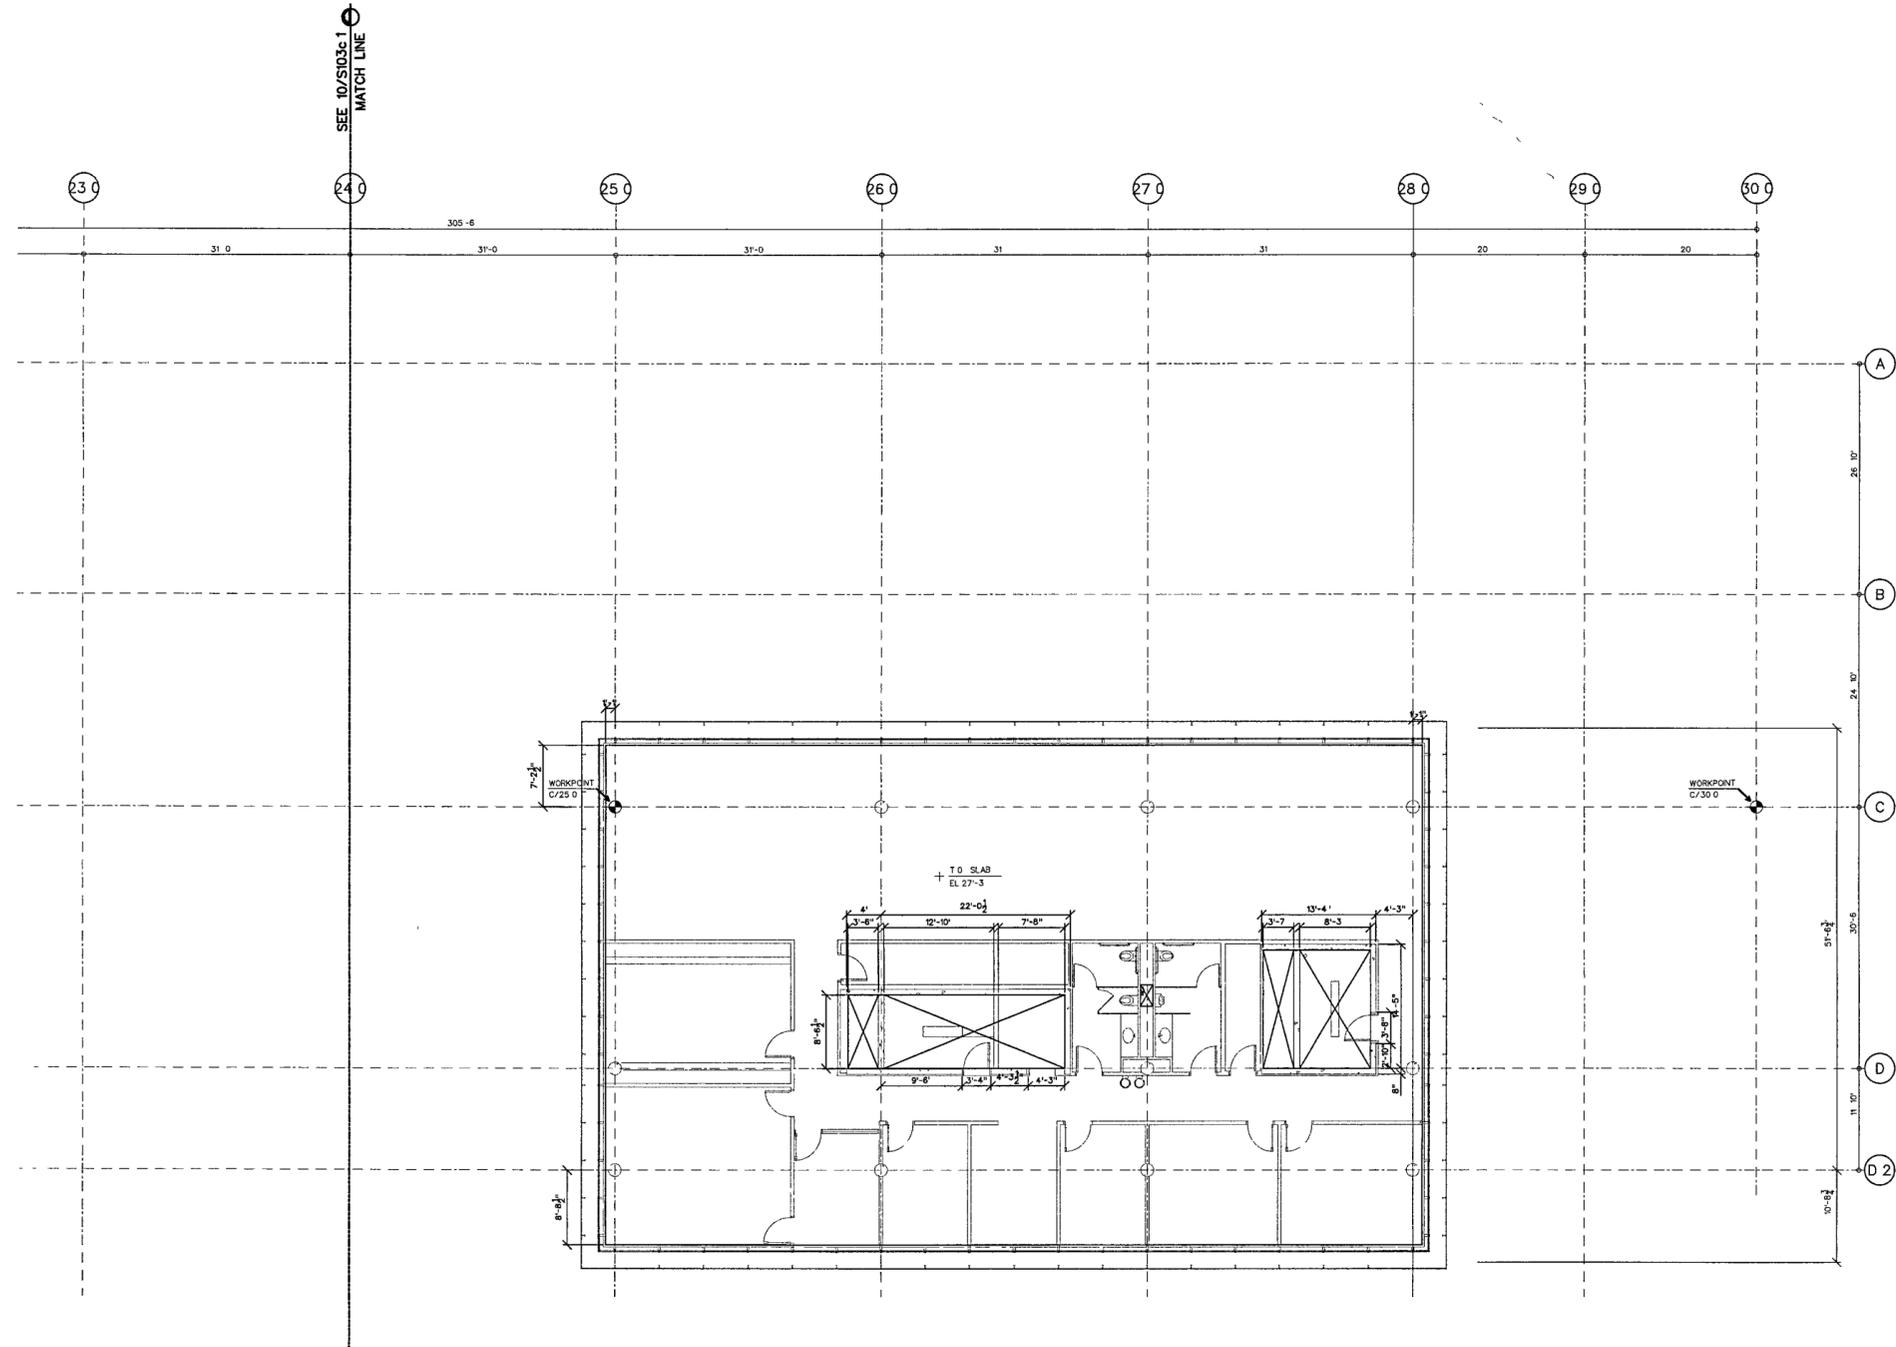

WORKPOINT	NORTHING (Y)	EASTING (X)
H/4 0	150,627 127270	1,234,743 833746
H/8 0	150,508 948830	1,234,723 007298
C/20 0	150,390 770381	1,234,702 180841
C/25 0	150,301 414924	1,234,756 878845
C/25 0	150,149 032475	1,234,750 845291
C/30 0	150,016 134955	1,234,745 636439

THIRD LEVEL SLAB PLAN D
SCALE 1/8" = 1'-0"

237

**WILLIAM J CLINTON
PRESIDENTIAL
CENTER**

LITTLE ROCK, ARKANSAS

Architect
POLSHEK PARTNERSHIP LLP
320 West 13th Street
New York, New York 10014
212.807.7171

Coordinating Architects
POLK STANLEY YEARY ARCHITECTS LM
700 South Schiller Street
Little Rock, Arkansas 72201
501.378.0878

WITSELL EVANS RASCO
901 West Third Street
Little Rock, Arkansas 72201
501.374.5300

WOODS GARADINE ARCHITECTS
2200 South Main Street
Little Rock, Arkansas 72206
501.374.4060

Landscape Architects
HARGREAVES ASSOCIATES
118 Magazine Street
Cambridge, Massachusetts 02139
617.681.0070

LANDSCAPE ARCHITECTURE, Inc.
2300 Cottondale Lane Suite 202
Little Rock, Arkansas 72202
501.374.5810

Structural Engineer
LESLIE E. ROBERTSON ASSOC., RLLP
30 Broad Street, 47th Floor
New York, New York 10004
212.759.9000

MEP Engineers
FLACK + KURTZ Inc.
475 Fifth Avenue
New York, New York 10017
212.532.9600


CROMWELL ARCHITECTS ENGINEERS
101 South Spring Street
Little Rock, Arkansas 72201
501.372.2900

Curtainwall Consultant
R. A. HEINTGES ARCHITECTS
128 Fifth Avenue, 8th Floor
New York, New York 10011
212.652-2966

Seal



100% Construction Documents	06/27/02
90% Progress Printing	08/30/02
100% Struct./ CD Progress	07/01/02
100% Steel & Concrete CD	05/15/02
& Architectural CD Progress	
Issue	Date
*Issued originally as A704a	

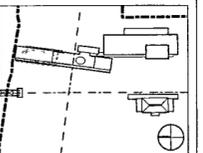

Job No. 9908


Scale 1/8" = 1'-0"

Date September 27, 2002

Title
**MUSEUM
UPPER LEVEL
PARTIAL SLAB PLAN**

Sheet No.

S104a.1

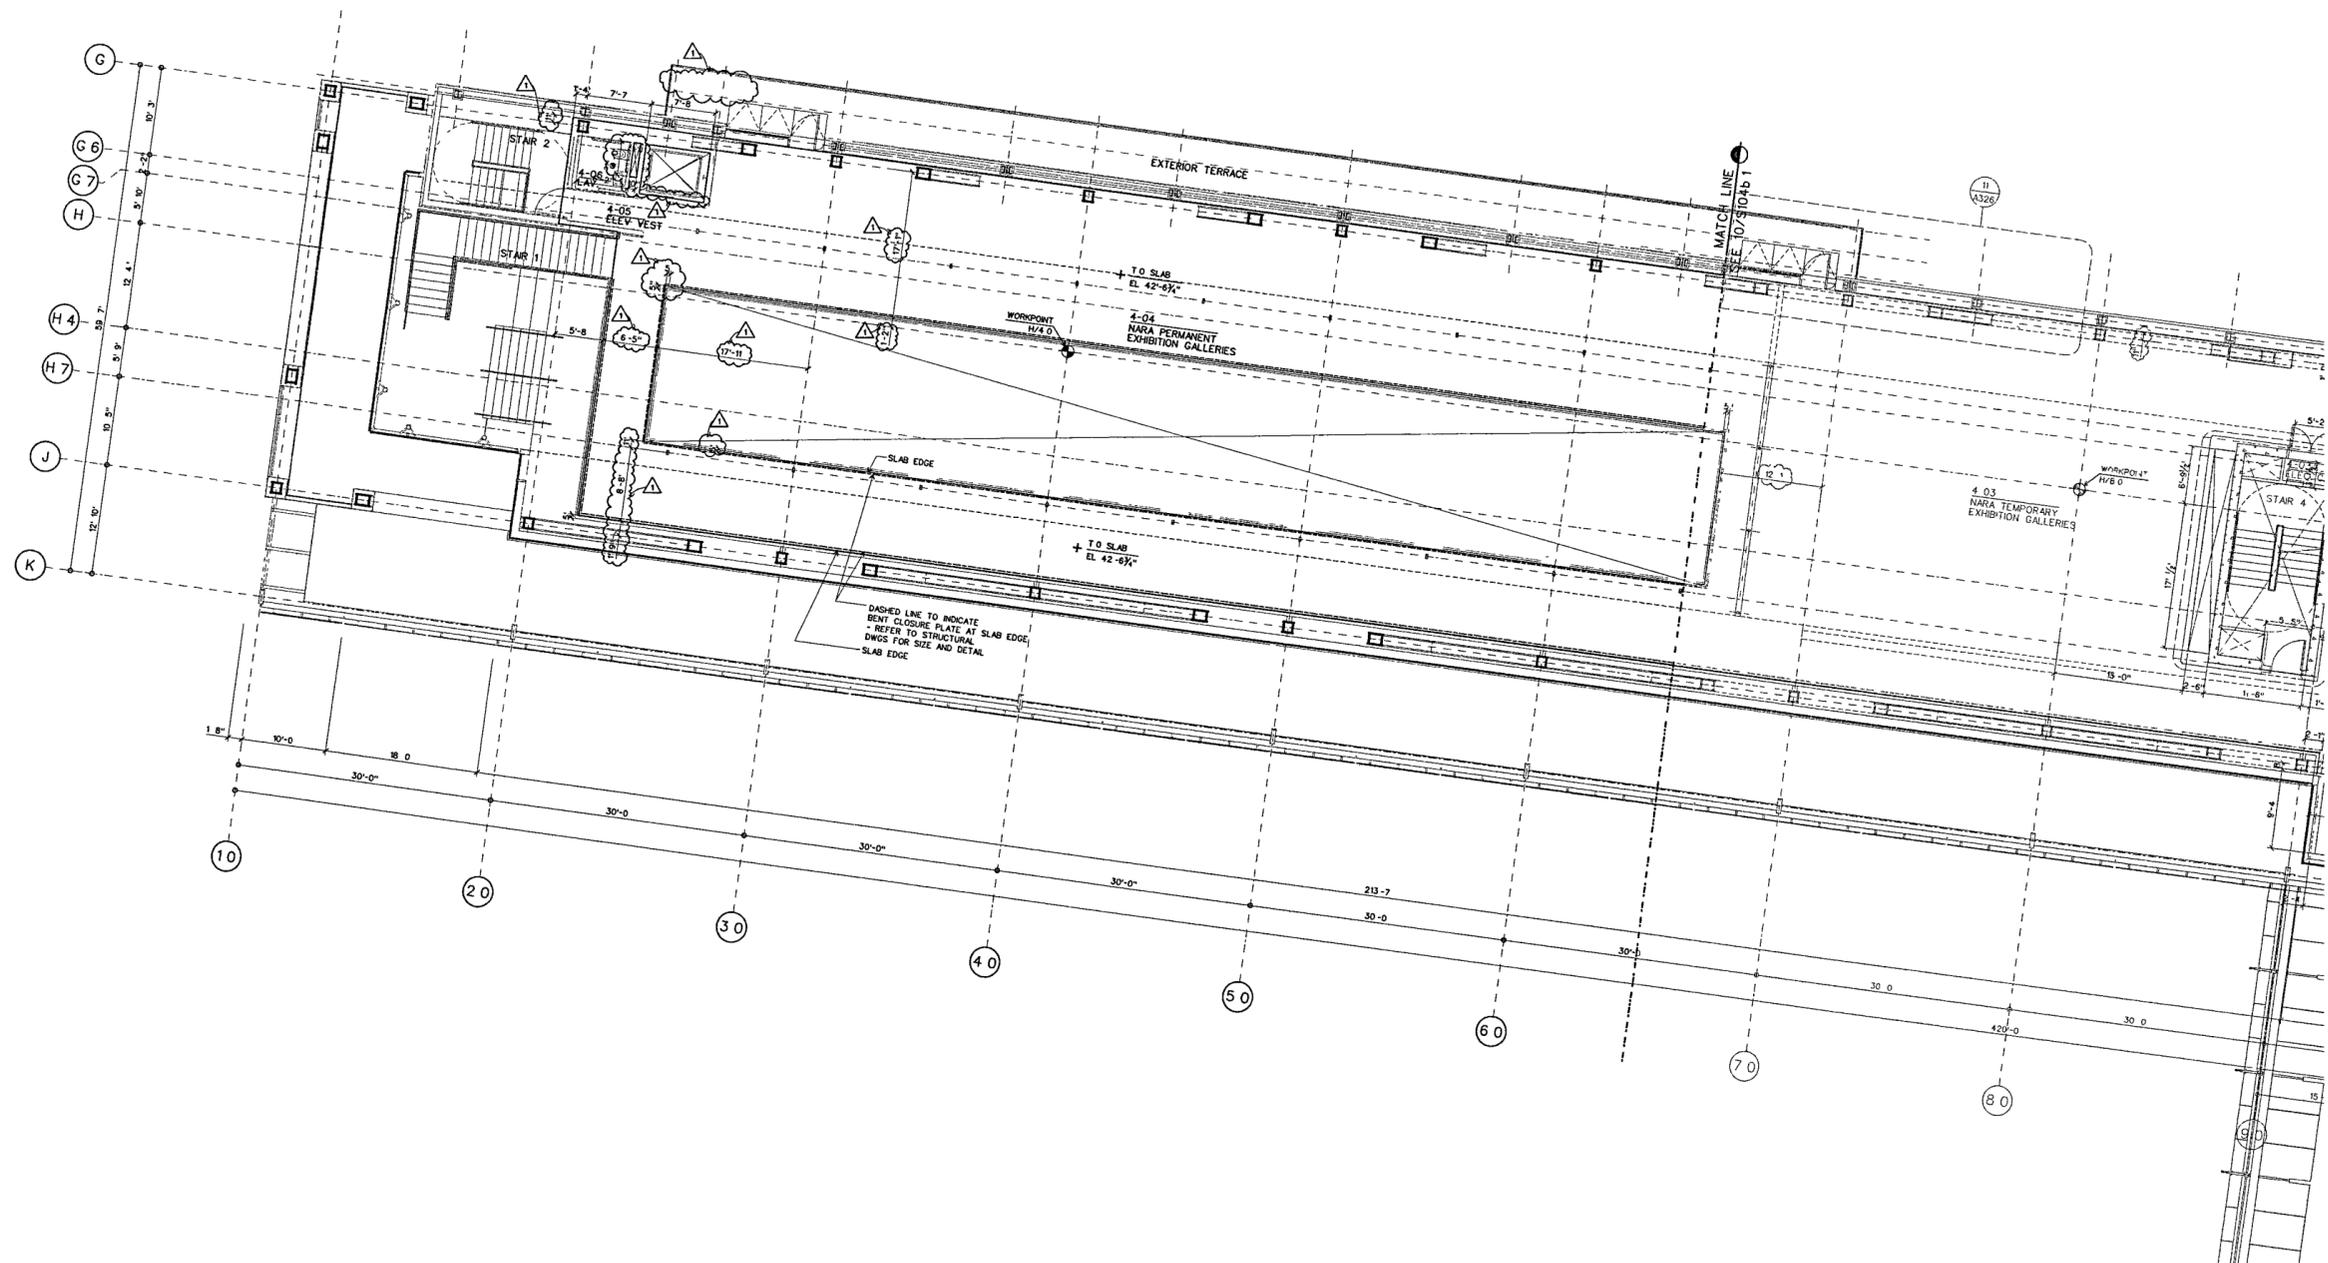

BUILDING WORKPOINT COORDINATES

WORKPOINT	NORTHING (Y)	EASTING (X)
H/4.0	150,627.127270	1,234,743.833746
H/6.0	150,508.948830	1,234,723.007298
H/8.0	150,390.770381	1,234,702.908841
C/20.0	150,301.414924	1,234,756.817845
C/25.0	150,149.032475	1,234,750.845291
C/30.0	150,016.134955	1,234,745.636439

MUSEUM UPPER LEVEL SLAB PLAN A

SCALE 1/8" = 1'-0"

SLAB-04 DGN 10

FOR OFFICIAL USE ONLY

**WILLIAM J CLINTON
PRESIDENTIAL
CENTER**

LITTLE ROCK, ARKANSAS

Architect
POLSHEK PARTNERSHIP LLP
 320 West 13th Street
 New York, New York 10014
 212 807 7171

Coordinating Architects
POLK STANLEY YEARY ARCHITECTS LTD
 700 South Schiller Street
 Little Rock, Arkansas 72201
 501 578.0878

WITSELL EVANS RASCO
 901 West Third Street
 Little Rock, Arkansas 72201
 501 574 5300

WOODS CARADINE ARCHITECTS
 2200 South Main Street
 Little Rock, Arkansas 72206
 501 574 4060

Landscape Architects
HARGREAVES ASSOCIATES
 118 Magazine Street
 Cambridge, Massachusetts 02139
 617 861 0070


Landscape Architecture Inc.
 2300 Cottondale Lane Suite 202
 Little Rock, Arkansas 72202
 501.374.5910

Structural Engineer
LESLIE E. ROBERTSON ASSOC. RLLP
 30 Broad Street, 47th Floor
 New York, New York 10004
 212 750 9000


MEP Engineers
FLACK + KURTZ Inc.
 475 Fifth Avenue
 New York, New York 10017
 212 532 9900

CROMWELL ARCHITECTS ENGINEERS
 101 South Spring Street
 Little Rock, Arkansas 72201
 501 572.2900

Curtilage Consultant
R. A. HEINTGES ARCHITECTS
 128 Fifth Avenue 9th Floor
 New York, New York 10011
 212 652-2986

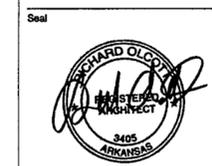

100% Construction Documents	09/27/02
90% Progress Printing	08/30/02
100% Struct./CD Progress	07/01/02
100% Steel & Concrete CD	05/15/02
& Architectural CD Progress	
Issue	Date
*Issued originally as A7D4b	

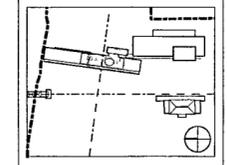

Job No. 9908


Scale 1/8" = 1'-0"

Date September 27, 2002

Title
**MUSEUM
 UPPER LEVEL
 PARTIAL SLAB PLAN**

Sheet No.
S104b.1

BUILDING WORKPOINT COORDINATES		
WORKPOINT	NORTHING (Y)	EASTING (X)
H/4 0	150,627 127270	1234 743 833746
H/8 0	150 508 948830	1234 723 007298
H/12 0	150 390 7703381	1234 702 808841
C/20 0	150,301 414924	1234 756 817845
C/25 0	150 149 032475	1234 750 845291
C/30 0	150 076 134955	1234 745 636439

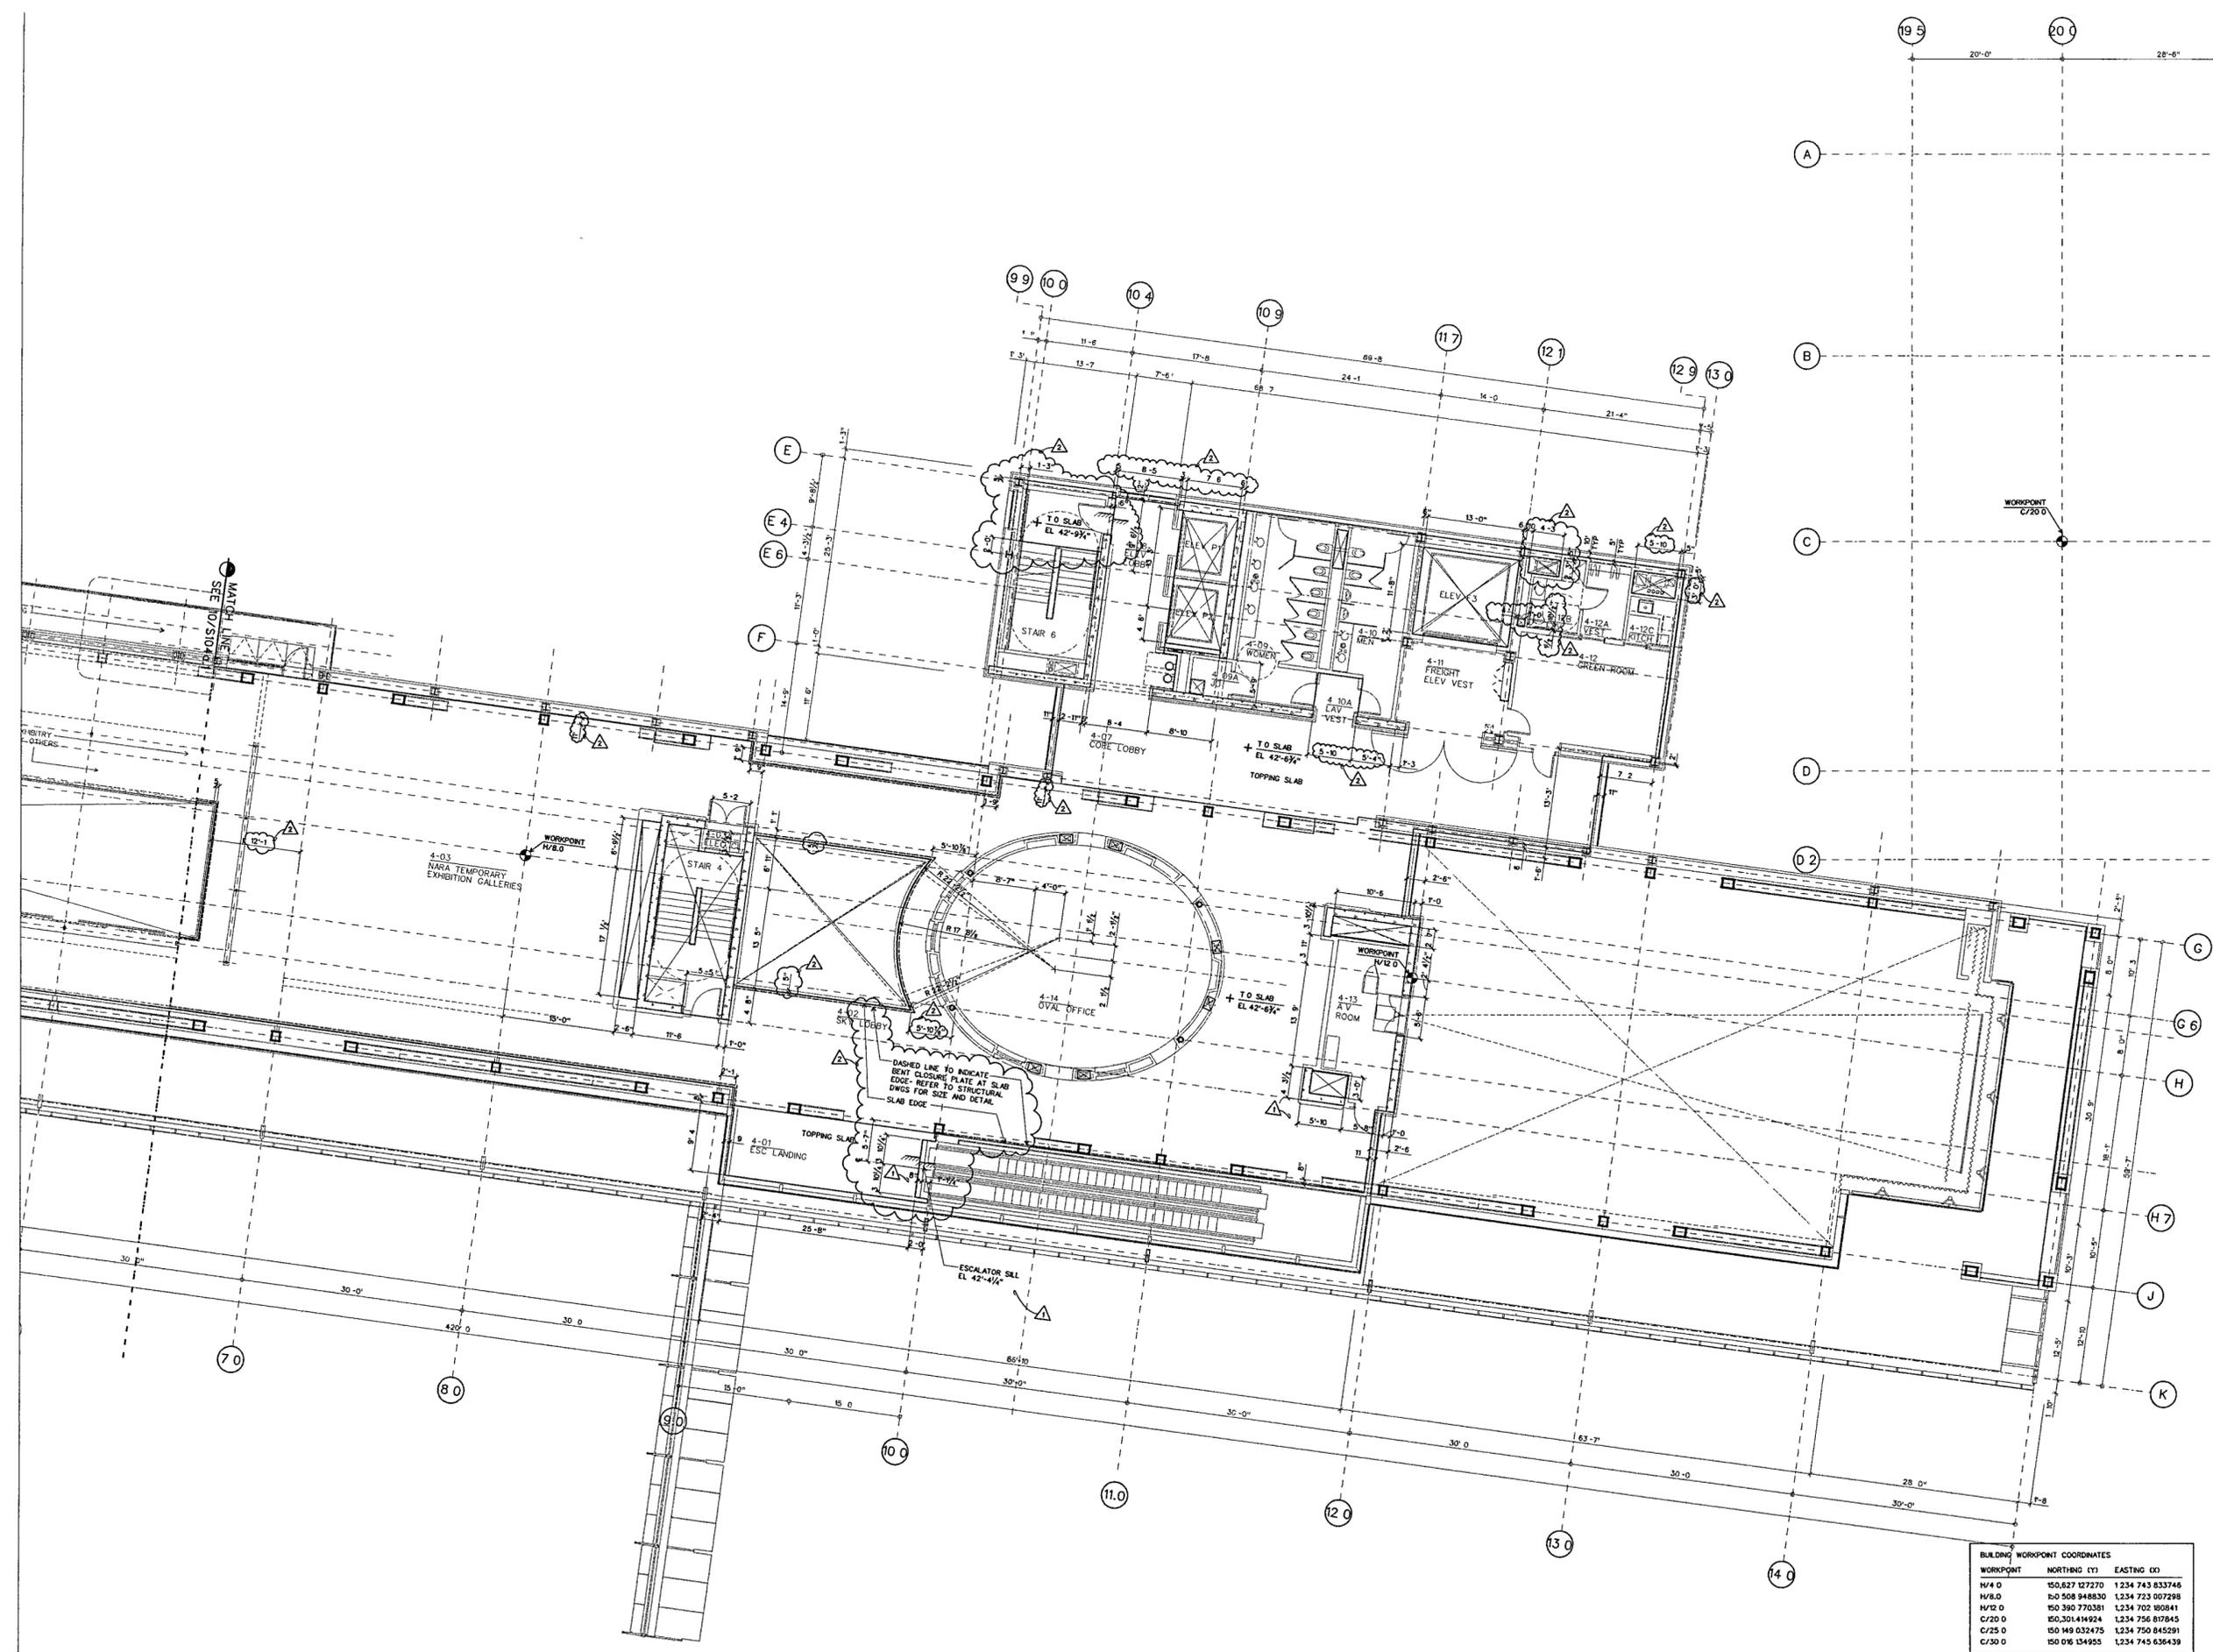

MUSEUM UPPER LEVEL SLAB PLAN B
 SCALE 1/8" = 1'-0"

SLAB-04 DGN 10

FOR OFFICIAL USE ONLY

**WILLIAM J CLINTON
PRESIDENTIAL
CENTER**

LITTLE ROCK, ARKANSAS

Architect

POLSHEK PARTNERSHIP LLP
320 West 13th Street
New York, New York 10014
212 807 7171

Coordinating Architects

POLK STANLEY YEARY ARCHITECTS Ltd
700 South Schiller Street
Little Rock, Arkansas 72201
501 378 0878

WITSELL EVANS RASCO
901 West Third Street
Little Rock, Arkansas 72201
501 374 5300

WOODS CARADINE ARCHITECTS
2200 South Main Street
Little Rock, Arkansas 72206
501 374 4080

Landscape Architects

HARGREAVES ASSOCIATES
118 Magazine Street
Cambridge, Massachusetts 02139
617 661 0070

LANDSCAPE ARCHITECTURE, Inc.
2300 Cottage Lane Suite 202
Little Rock, Arkansas 72202
501 374 5610

Structural Engineer

LESLIE E. ROBERTSON ASSOC RLLP
30 Broad Street, 47th Floor
New York, New York 10004
212 750 9000

MEP Engineers

FLACK + KURTZ Inc.
475 Fifth Avenue
New York, New York 10017
212 532 9600

CROMWELL ARCHITECTS ENGINEERS
101 South Spring Street
Little Rock, Arkansas 72201
501 372 2900


Curtainwall Consultant

R. A. HEINTGES ARCHITECTS
128 Fifth Avenue, 9th Floor
New York, New York 10011
212 652-2966

Seal




100% Construction Documents	05/27/02
90% Progress Printing	06/30/02
100% Struct./ CD Progress	07/01/02
100% Steel & Concrete CD	05/15/02
& Architectural CD Progress	
Issue	Date
*Issued originally as A705a	

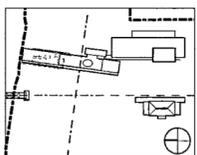

Job No. 9908
Scale 1/8" = 1'-0"
Date September 27, 2002
Title

**EXECUTIVE LEVEL
PARTIAL SLAB PLAN**

Sheet No. **S105a.1**

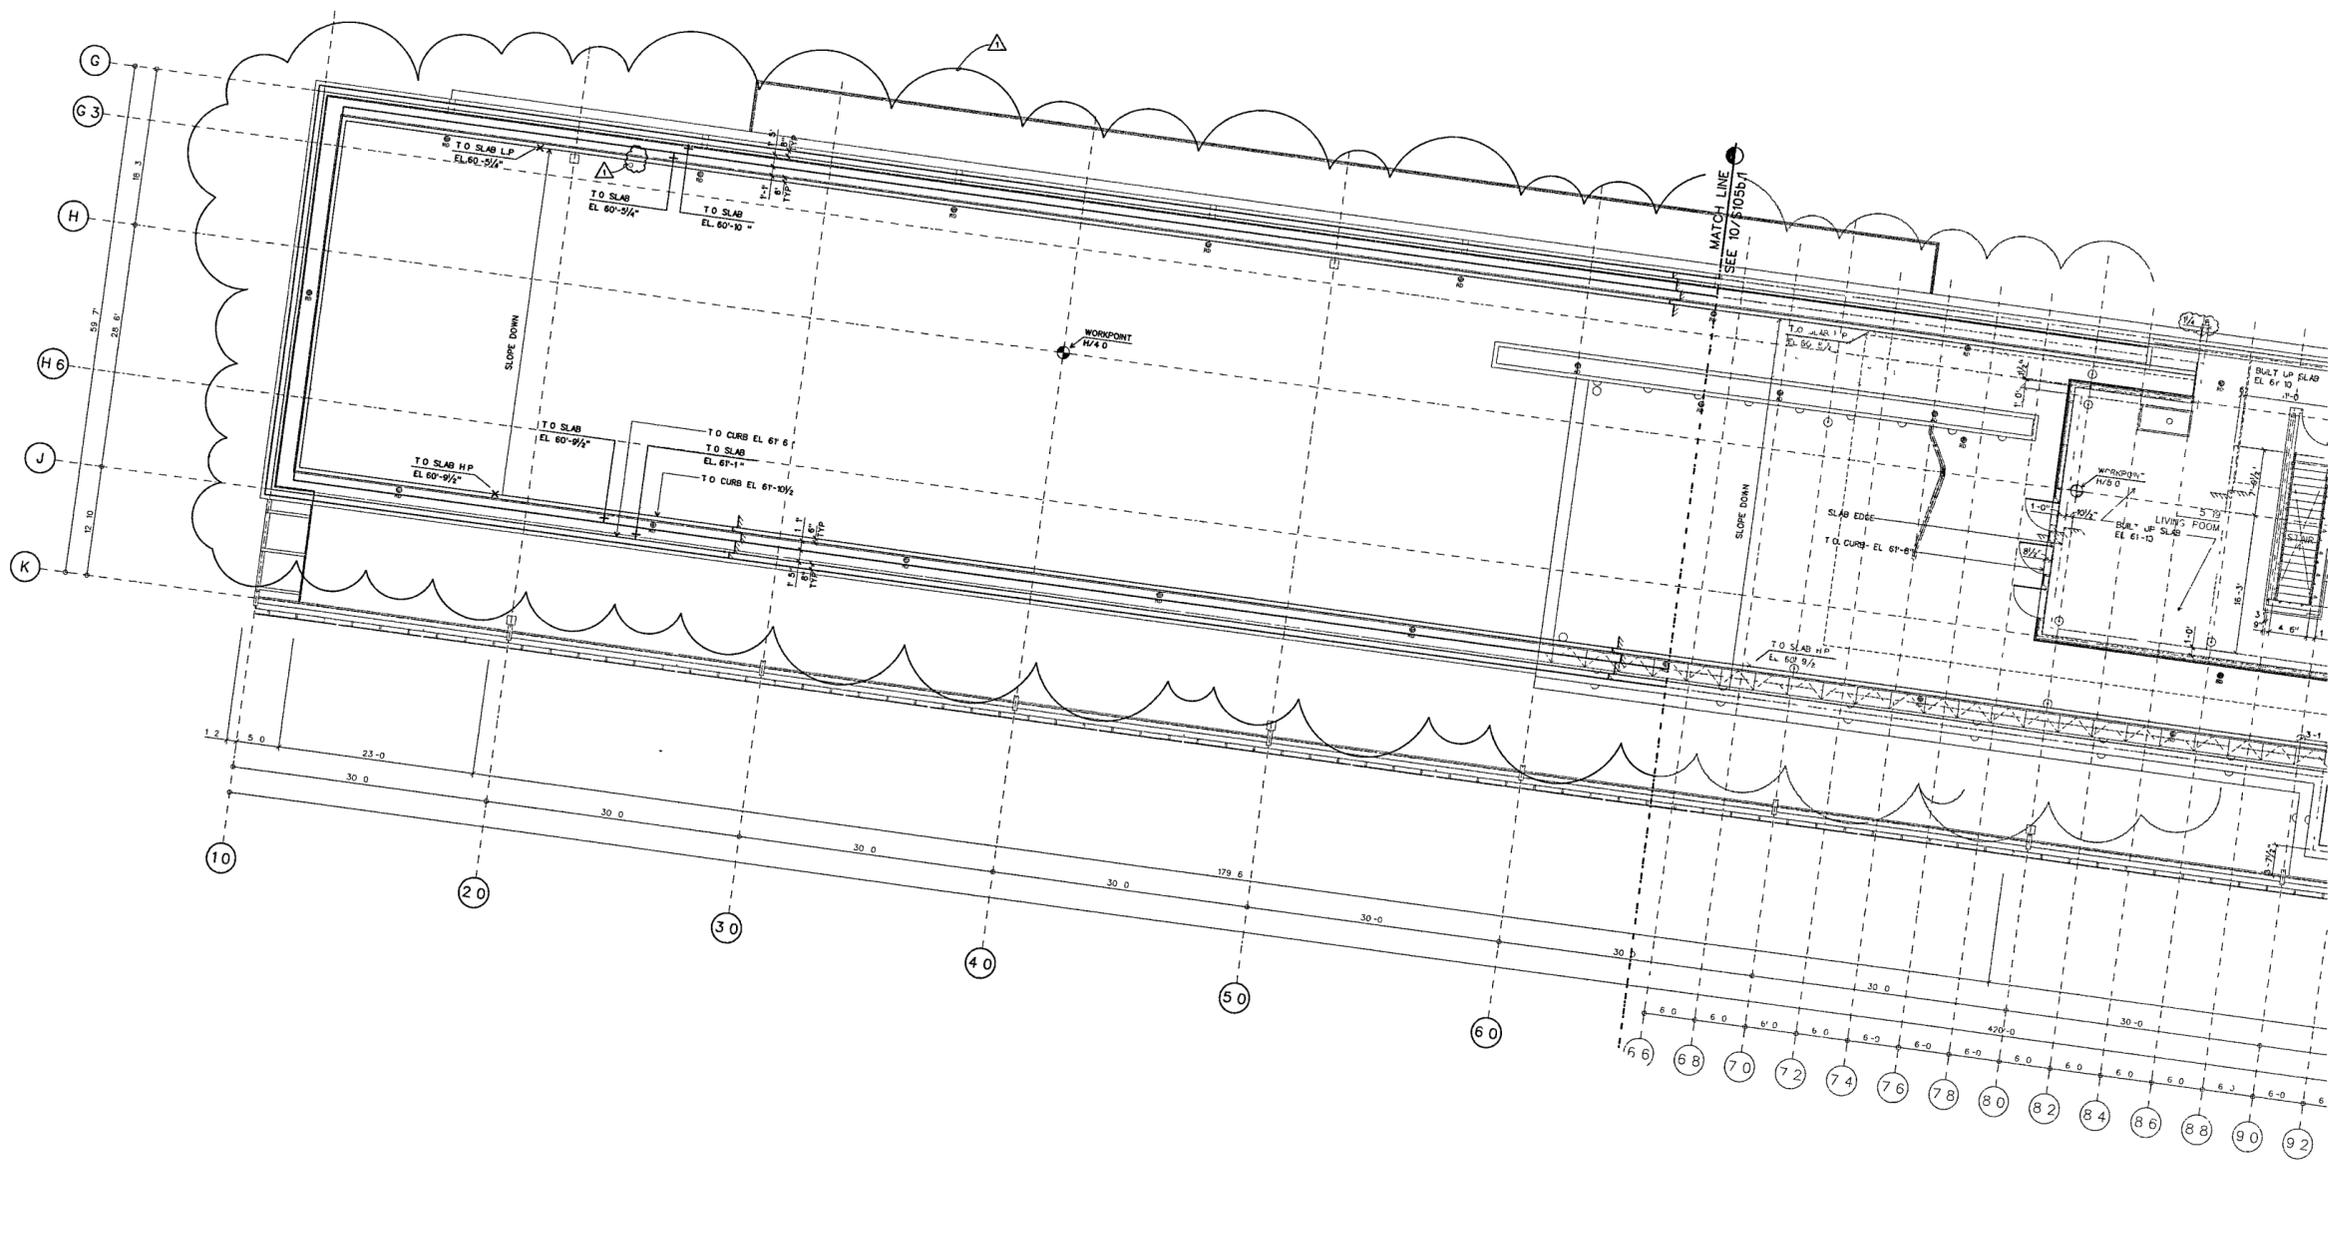

WORKPOINT	NORTHING (Y)	EASTING (X)
W/4 0	150 627 827270	1,234 743 833746
W/8 0	150 508 948630	1,234 723 007296
W/8 9	150,390 770581	1,234 702 806941
C/20 0	150,301 414524	1,234 756 878145
C/25 0	150 149 032475	1,234 750 845291
C/30 0	150,016.134955	1,234 745 636439

EXECUTIVE LEVEL SLAB PLAN A
SCALE 1/8" = 1'-0"

**WILLIAM J CLINTON
PRESIDENTIAL
CENTER**

LITTLE ROCK, ARKANSAS

Architect
POLSHEK PARTNERSHIP LLP
320 West 13th Street
New York, New York 10014
212 607 7171

Coordinating Architects
POLK STANLEY YEARY ARCHITECTS Ltd
700 South Schiller Street
Little Rock, Arkansas 72201
501 378 0878

WITSELL EVANS RASCO
901 West Third Street
Little Rock, Arkansas 72201
501 374 5300

WOODS CARADINE ARCHITECTS
2200 South Main Street
Little Rock, Arkansas 72206
501 374 4060

Landscape Architects
HARGREAVES ASSOCIATES
118 Magazine Street
Cambridge, Massachusetts 02139
617 661 0070

LANDSCAPE ARCHITECTURE Inc.
2300 Cottage Lane Suite 202
Little Rock, Arkansas 72202
501 374 5810

Structural Engineer
LESLIE E. ROBERTSON ASSOC., RLLP
30 Broad Street, 47th Floor
New York, New York 10004
212.750.9000


MEP Engineers
FLACK + KURTZ Inc.
475 Fifth Avenue
New York, New York 10017
212.532.9500

CROMWELL ARCHITECTS ENGINEERS
101 South Spring Street
Little Rock, Arkansas 72201
501 372.2900

Curtainwall Consultant
R. A. HEINTGES ARCHITECTS
128 Fifth Avenue, 6th Floor
New York, New York 10011
212.652.2966




Issue	Date
100% Construction Documents	06/27/02
90% Progress Printing	08/30/02
100% Struct./CD Progress	07/01/02
100% Steel & Concrete CD	05/15/02
& Architectural CD Progress	

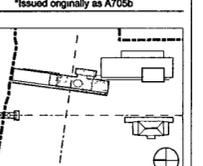

Job No: 8908
Scale: 1/8" = 1'-0"
Date: September 27, 2002
Title:

**EXECUTIVE LEVEL
PARTIAL SLAB PLAN**

Sheet No
S105b.1

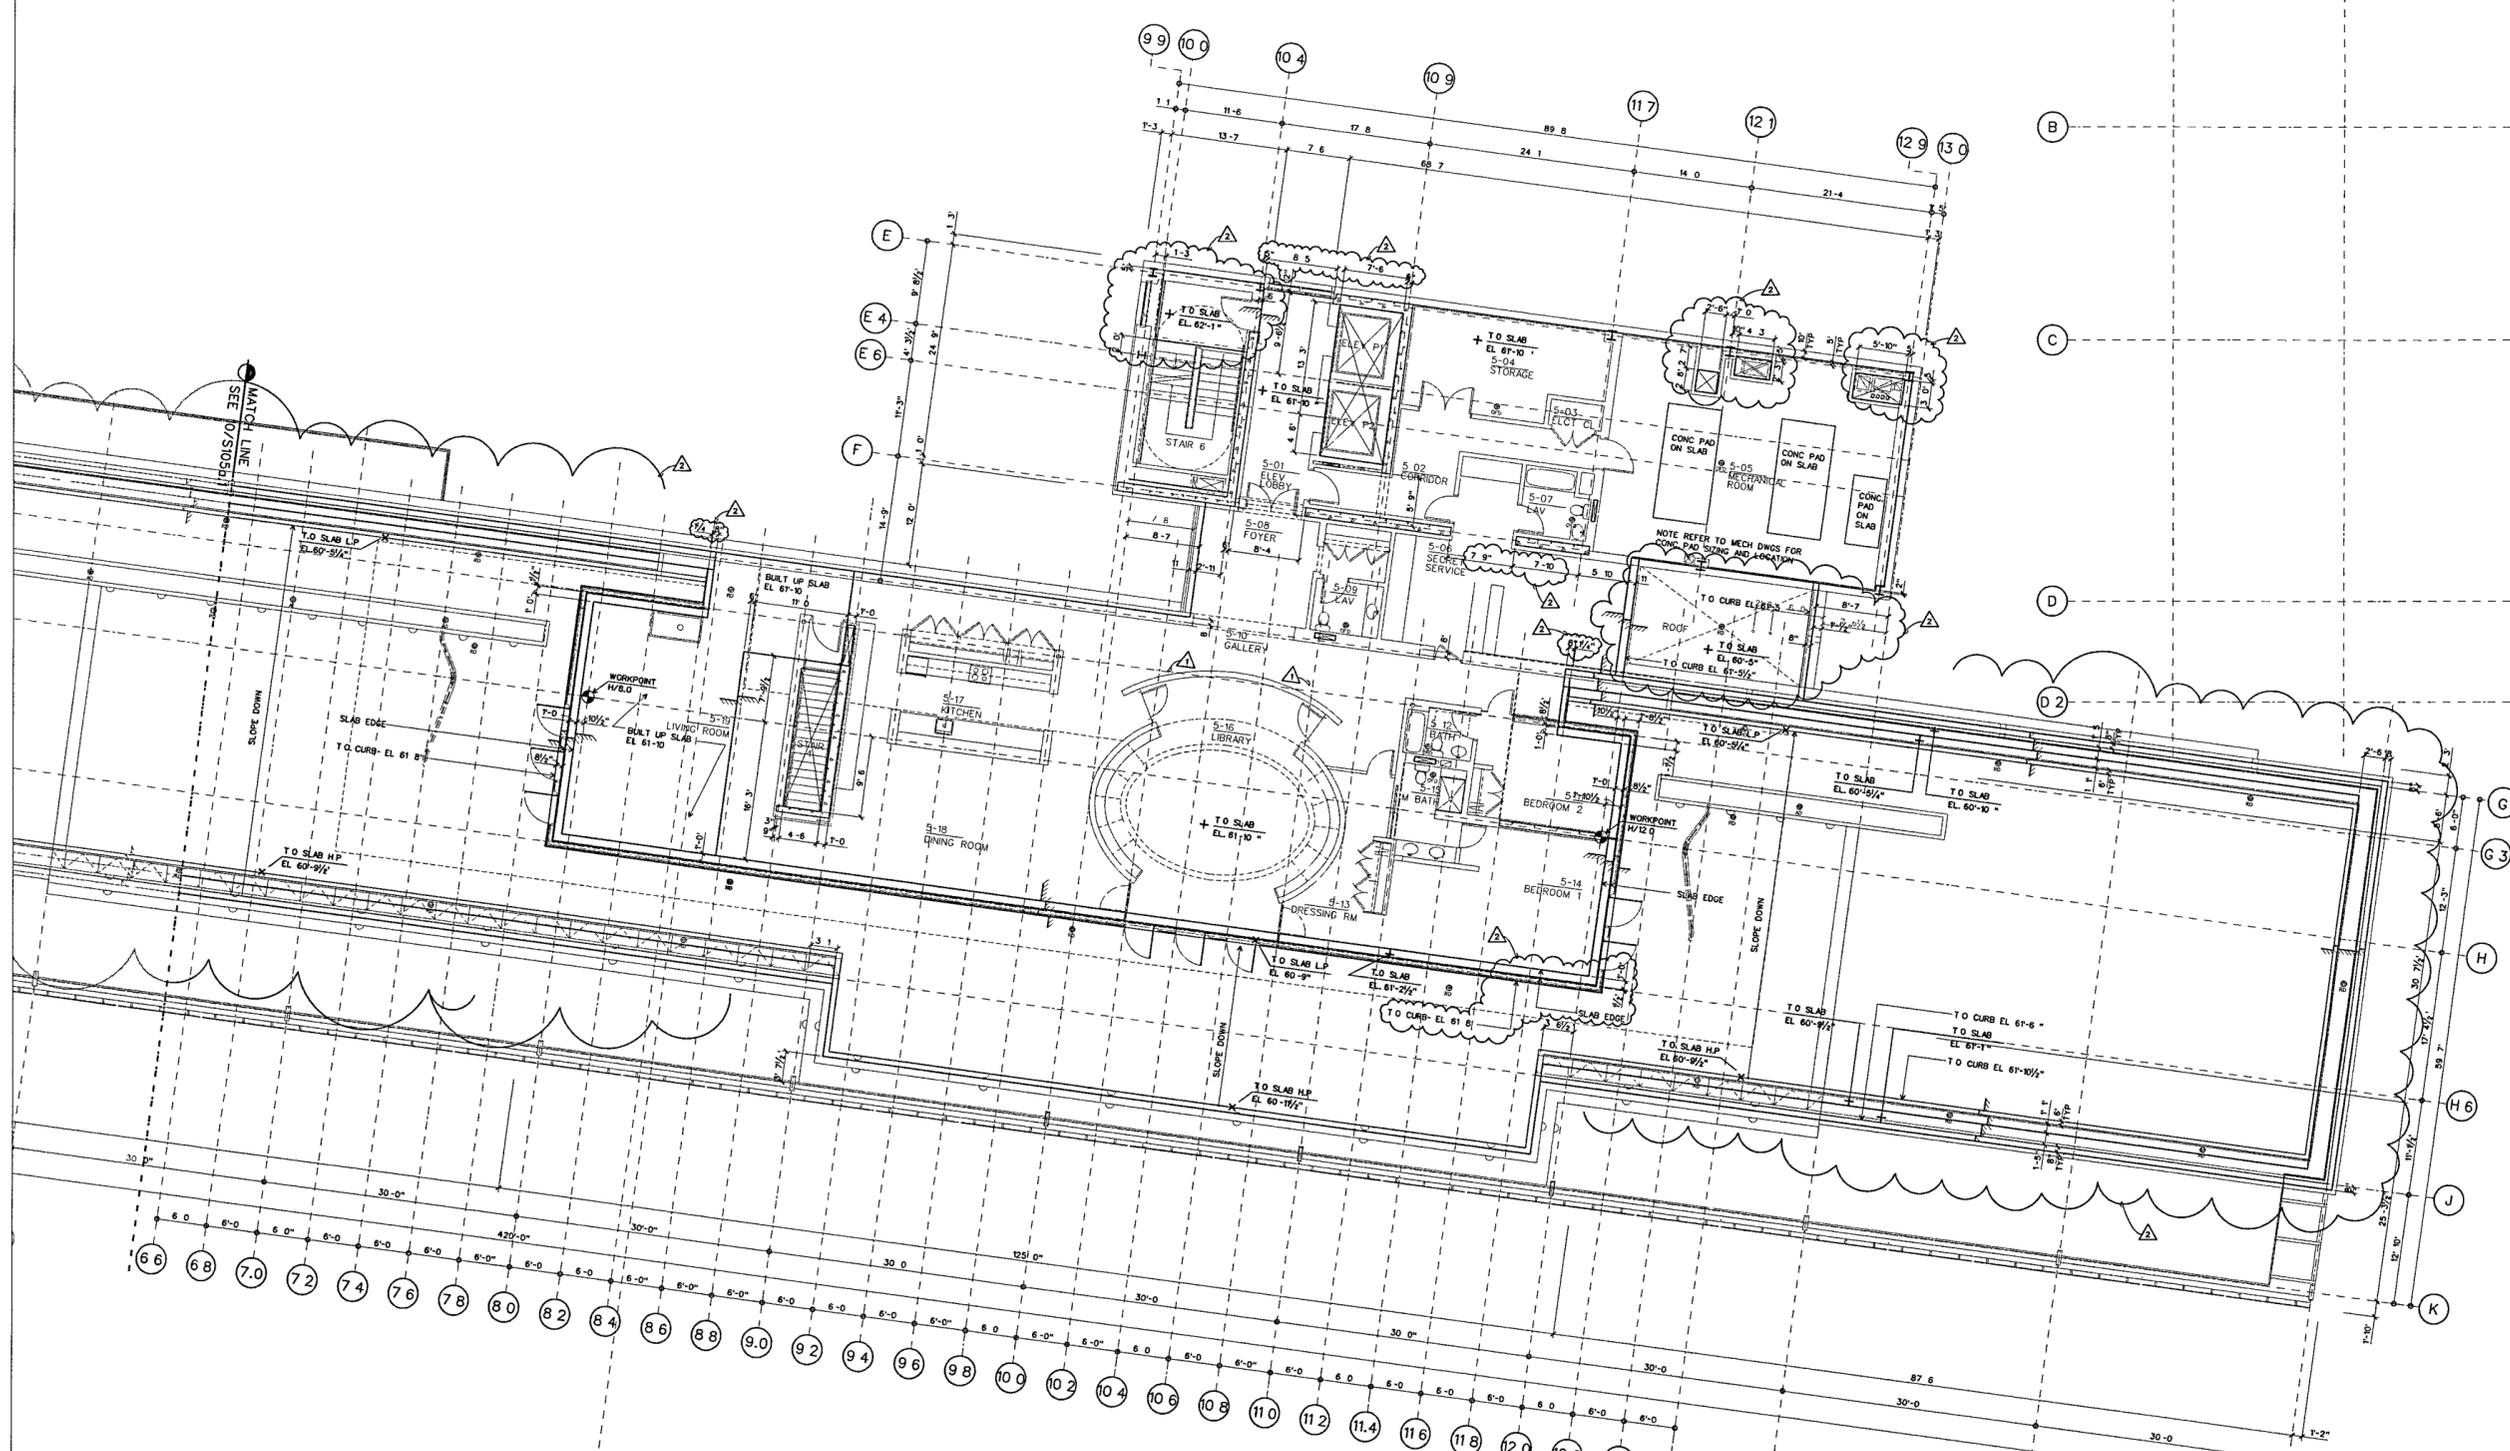


EXECUTIVE LEVEL SLAB PLAN B
SCALE 1/8" = 1'-0"


WORKPOINT	NORTHING (Y)	EASTING (X)
H/4 0	150,627,127270	1,234,743,833746
H/8 0	150,508,948630	1,234,723,007298
H/12 0	150,390,770381	1,234,702,80841
C/20 0	150,301,414924	1,234,756,817845
C/25 0	150,149,032475	1,234,750,845291
C/30 0	150,016,134955	1,234,745,636439

SLAB-05 DGN 10

FOR OFFICIAL USE ONLY

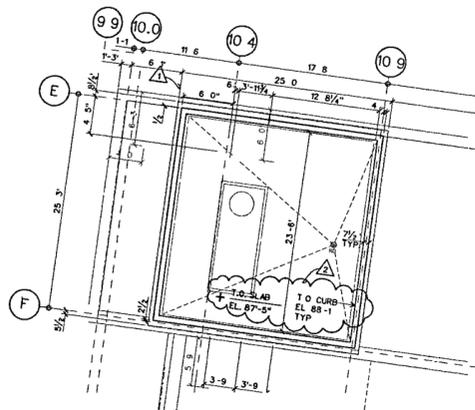

ELEV. MECHANICAL ROOF SLAB PLAN B
SCALE 1/4" = 1'-0" SLAB-MECH-ROOF DGN 20

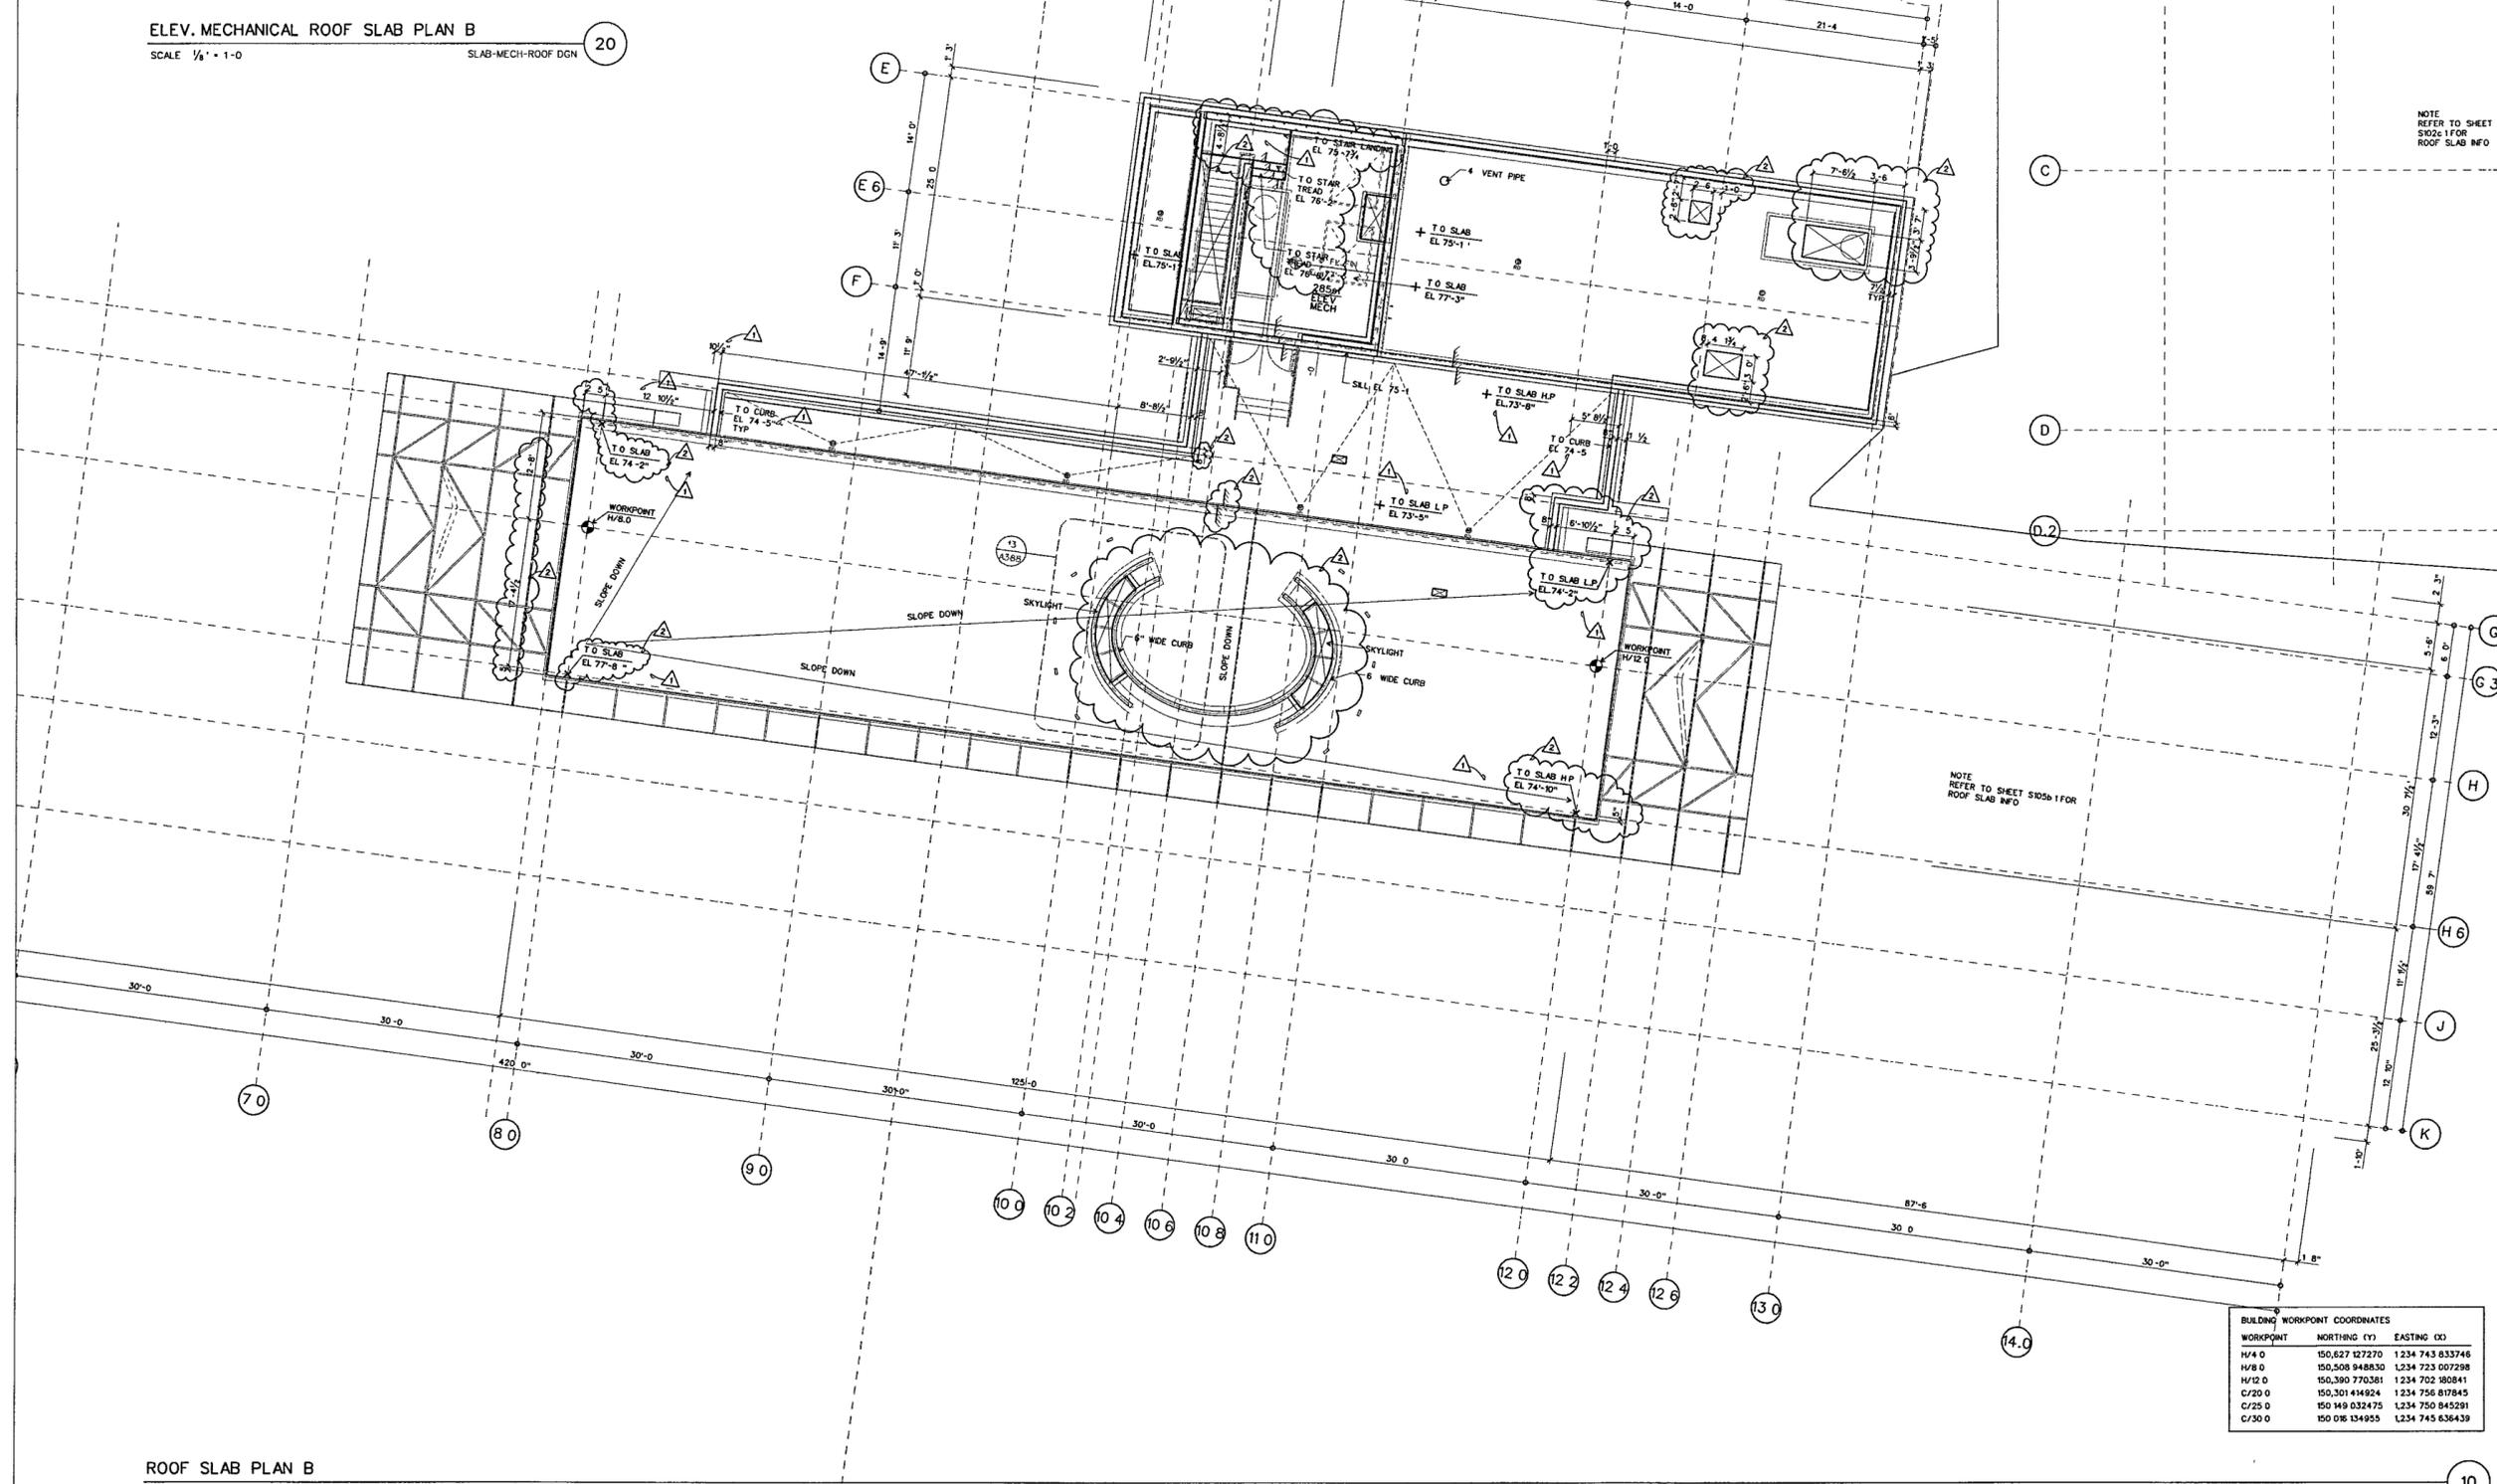

ROOF SLAB PLAN B
SCALE 1/4" = 1'-0"

BUILDING WORKPOINT COORDINATES	WORKPOINT	NORTHING (Y)	EASTING (X)
H/4.0	150,627.127270	1,234,743.833746	
H/8.0	150,508.948830	1,234,723.007298	
H/12.0	150,390.770381	1,234,702.180841	
C/20.0	150,301.414924	1,234,756.817845	
C/25.0	150,149.032475	1,234,750.845291	
C/30.0	150,006.134955	1,234,745.636439	

**WILLIAM J CLINTON
PRESIDENTIAL
CENTER**

LITTLE ROCK, ARKANSAS

Architect
POLSHAK PARTNERSHIP LLP
320 West 13th Street
New York, New York 10014
212 807 7171

Coordinating Architects
POLK STANLEY YEARY ARCHITECTS Ltd
700 South Schiller Street
Little Rock, Arkansas 72201
501 378 0878

WITSELL EVANS RASCO
801 West Third Street
Little Rock, Arkansas 72201
501 374 6300

WOODS CARADINE ARCHITECTS
2200 South Main Street
Little Rock, Arkansas 72206
501 374 4060

Landscape Architects
HARGREAVES ASSOCIATES
118 Magazine Street
Cambridge, Massachusetts 02139
617 661 0070

LANDSCAPE ARCHITECTURE, Inc.
2300 Cottondale Lane Suite 202
Little Rock, Arkansas 72202
501 374 6810

Structural Engineer
LESLIE E. ROBERTSON ASSOC. RLLP
30 Broad Street, 47th Floor
New York, New York 10004
212 750 9000


MEP Engineers
FLACK + KURTZ Inc.
475 Fifth Avenue
New York, New York 10017
212 532.9000

CROMWELL ARCHITECTS ENGINEERS
101 South Spring Street
Little Rock, Arkansas 72201
501 372.2900


Curtainwall Consultant
R. A. HENTGES ARCHITECTS
126 Fifth Avenue, 9th Floor
New York, New York 10011
212.652-2966

NOTE
REFER TO SHEET
S102c.1 FOR
ROOF SLAB INFO

NOTE
REFER TO SHEET S105b.1 FOR
ROOF SLAB INFO

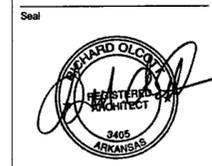

Issue	Date
100% Construction Documents	06/27/02
90% Progress Printing	06/30/02
100% Struct./CD Progress	07/01/02
100% Steel & Concrete CD	05/15/02
& Architectural CD Progress	
Issue	Date
*Issued originally as A706b	

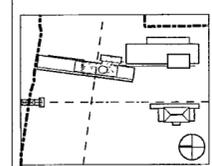

Job No 9908

Scale 1/8" = 1'-0"

Date September 27, 2002

Title

ROOF
PARTIAL SLAB PLAN

Sheet No

S106b.1

SLAB-ROOF DGN 10

FOR OFFICIAL USE ONLY

**WILLIAM J CLINTON
PRESIDENTIAL
CENTER**

LITTLE ROCK, ARKANSAS

Architect
POLSHKE PARTNERSHIP LLP
320 West 13th Street
New York, New York 10014
212.807.7171

Coordinating Architects
POLK STANLEY YEARY ARCHITECTS Ltd
700 South Schiller Street
Little Rock, Arkansas 72201
501.378.0878

WITSELL EVANS RASCO
801 West Third Street
Little Rock, Arkansas 72201
501.374.5300

WOODS GARADINE ARCHITECTS
2200 South Main Street
Little Rock, Arkansas 72206
501.374.4060

Landscape Architects
HARGREAVES ASSOCIATES
118 Magazine Street
Cambridge, Massachusetts 02139
617.661.0070

LANDSCAPE ARCHITECTURE, Inc.
2300 Cottondale Lane Suite 202
Little Rock, Arkansas 72202
501.374.5610

Structural Engineer
LESLIE E ROBERTSON ASSOC., RLLP
30 Broad Street, 47th Floor
New York, New York 10004
212.750.9000


MEP Engineers
FLACK + KURTZ Inc
475 Fifth Avenue
New York, New York 10017
212.532.9600

CROMWELL ARCHITECTS ENGINEERS
101 South Spring Street
Little Rock, Arkansas 72201
501.372.2900

Curranwell Consultant
R. A. HEINTGES ARCHITECTS
126 Fifth Avenue, 9th Floor
New York, New York 10011
212.652.2966

Seal

Issue	Date
5 100% CONSTRUCTION DOCS	09/27/02
4 90% PROGRESS PRINTING	08/30/02
3 100% STRUCTURAL CD	07/01/02
2 100% CD MUSEUM BLDG	06/14/02
STRUCTURAL PACKAGE	
1 100% STL & CONC CD	05/15/02

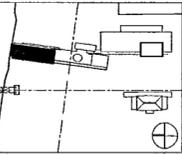


Job No 9908
Scale 1/16"=1'-0"
Date MAY 15 2001
Title


**SLAB REINFORCEMENT
GROUND AND
SECOND LEVEL PLAN**

Sheet No

S110

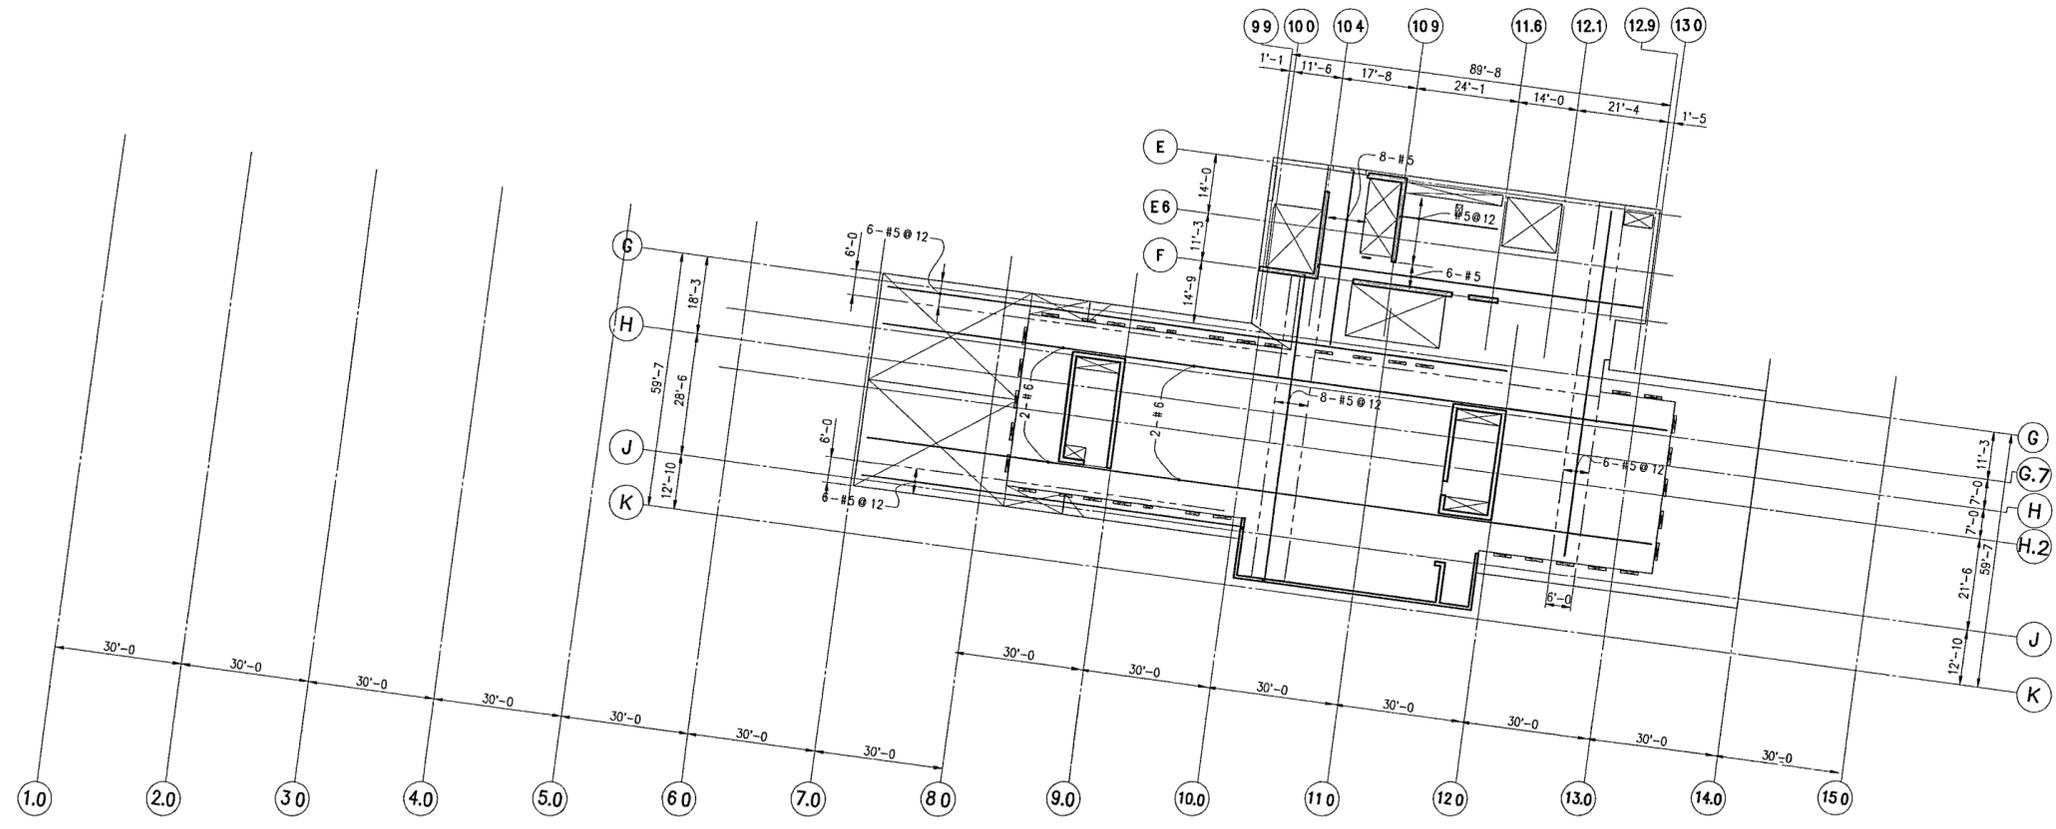

A GROUND LEVEL

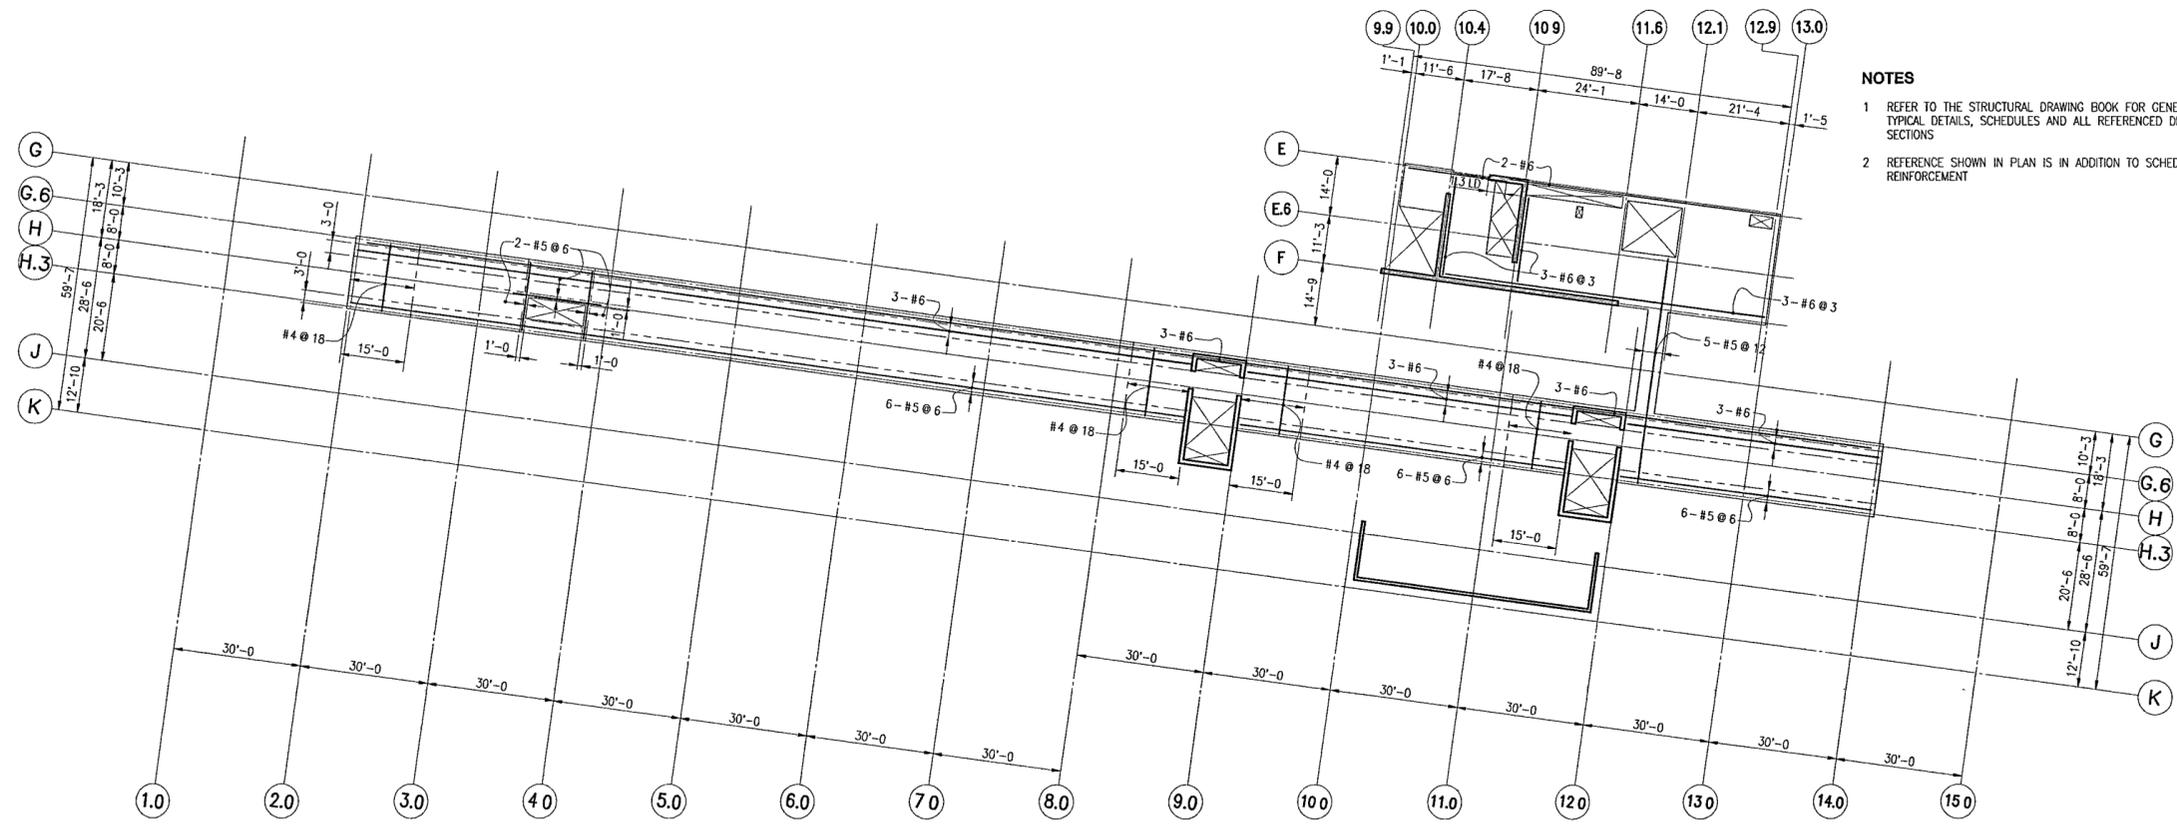

B SECOND LEVEL

NOTES

- 1 REFER TO THE STRUCTURAL DRAWING BOOK FOR GENERAL NOTES, TYPICAL DETAILS, SCHEDULES AND ALL REFERENCED DETAILS AND SECTIONS
- 2 REFERENCE SHOWN IN PLAN IS IN ADDITION TO SCHEDULED REINFORCEMENT

© Copyright LESLIE E ROBERTSON ASSOCIATES, RLLP
WARNING IT IS A VIOLATION OF LAW FOR ANY PERSON, UNLESS ACTING UNDER THE DIRECTION OF A PROFESSIONAL LICENSED IN THE STATE OF THIS PROJECT, TO ALTER IN ANY WAY THESE DRAWINGS WHERE ANY ITEM IS ALTERED THE SUPERVISING PROFESSIONAL SHALL AFFIX TO THE ITEM HIS SEAL AND THE INSCRIPTION "ALTERED BY" FOLLOWED BY HIS SIGNATURE, THE DATE, AND A SPECIFIC DESCRIPTION OF THE ALTERATION

**WILLIAM J. CLINTON
PRESIDENTIAL
CENTER**

LITTLE ROCK, ARKANSAS

Architect
POLSHAK PARTNERSHIP LLP
320 West 13th Street
New York, New York 10014
212.607.7171

Coordinating Architects
POLK STANLEY YEARY ARCHITECTS Ltd
700 South Schiller Street
Little Rock, Arkansas 72201
501.378.0878

WITSELL EVANS RASCO
901 West Third Street
Little Rock, Arkansas 72201
501.374.5300

WOODS CARADINE ARCHITECTS
2200 South Main Street
Little Rock, Arkansas 72206
501.374.4060

Landscape Architects
HARGREAVES ASSOCIATES
118 Magazine Street
Cambridge, Massachusetts 02139
617.661.0070

LANDSCAPE ARCHITECTURE, Inc.
2300 Cottondale Lane Suite 202
Little Rock, Arkansas 72202
501.374.5610

Structural Engineer
LESLIE E. ROBERTSON ASSOC., RLLP
30 Broad Street, 47th Floor
New York, New York 10004
212.750.9000


MEP Engineers
FLACK + KURTZ Inc.
475 Fifth Avenue
New York, New York 10017
212.532.9600

CROMMELL ARCHITECTS ENGINEERS
101 South Spring Street
Little Rock, Arkansas 72201
501.372.2900

Curtainwall Consultant
R. A. HEINTGES ARCHITECTS
126 Fifth Avenue, 9th Floor
New York, New York 10011
212.652-2968

Seal

Issue	Date
4	100% CONSTRUCTION DOCS 09/27/02
3	90% PROGRESS PRINTING 08/30/02
2	100% STRUCTURAL CD 07/01/02
1	100% STL & CONC CD 05/15/02

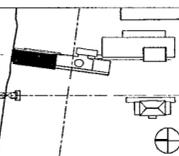

Job No 9908

Scale 1/16"=1'-0"

Date MAY 15, 2002

Title


**SLAB REINFORCEMENT
MUSEUM LOWER AND
UPPER LEVEL PLAN**

Sheet No

S111



C MUSEUM LOWER LEVEL

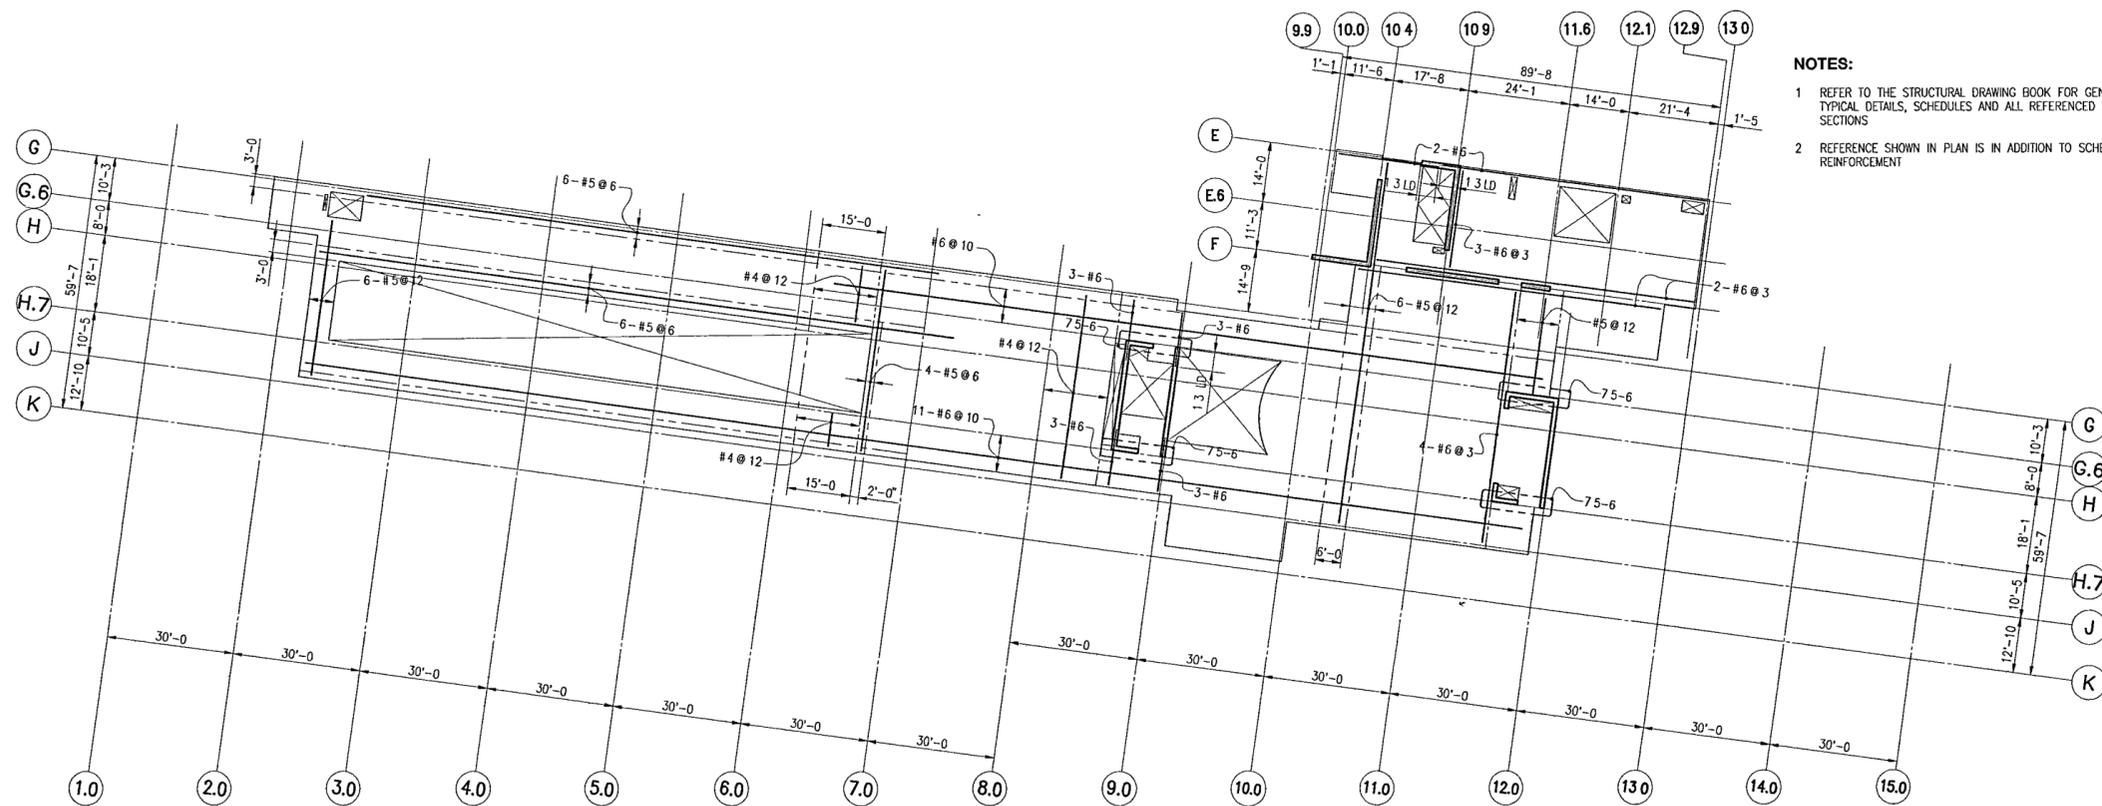

D MUSEUM UPPER LEVEL

NOTES:

- 1 REFER TO THE STRUCTURAL DRAWING BOOK FOR GENERAL NOTES, TYPICAL DETAILS, SCHEDULES AND ALL REFERENCED DETAILS AND SECTIONS
- 2 REFERENCE SHOWN IN PLAN IS IN ADDITION TO SCHEDULED REINFORCEMENT

© Copyright LESLIE E. ROBERTSON ASSOCIATES, R.L.L.P.
WARNING IT IS A VIOLATION OF LAW FOR ANY PERSON, UNLESS ACTING UNDER THE DIRECTION OF A PROFESSIONAL, LICENSED IN THE STATE OF THIS PROJECT, TO ALTER IN ANY WAY THESE DRAWINGS WHERE ANY ITEM IS ALTERED THE SUPERVISING PROFESSIONAL SHALL AFFIX TO THE ITEM HIS SEAL AND THE INSCRIPTION "ALTERED BY" FOLLOWED BY HIS SIGNATURE, THE DATE AND A SPECIFIC DESCRIPTION OF THE ALTERATION

**WILLIAM J. CLINTON
PRESIDENTIAL
CENTER**

LITTLE ROCK, ARKANSAS

Architect
POLSEK PARTNERSHIP LLP
320 West 13th Street
New York, New York 10014
212.607.7171

Coordinating Architects
POLK STANLEY YEARY ARCHITECTS LTD
700 South Schiller Street
Little Rock, Arkansas 72201
501.378.6878

WITSELL EVANS RASCO
901 West Third Street
Little Rock, Arkansas 72201
501.374.5300

WOODS GARADINE ARCHITECTS
2200 South Main Street
Little Rock, Arkansas 72206
501.374.4060

Landscape Architects
HARGREAVES ASSOCIATES
118 Magazine Street
Cambridge, Massachusetts 02139
617.661.0070

LANDSCAPE ARCHITECTURE, Inc.
2200 Cottondale Lane Suite 202
Little Rock, Arkansas 72202
501.374.5610

Structural Engineer
LESLIE E. ROBERTSON ASSOC., RLLP
30 Broad Street, 47th Floor
New York, New York 10004
212.759.9000


MEP Engineers
FLACK + KURTZ Inc
475 Fifth Avenue
New York, New York 10017
212.532.9600

CROMWELL ARCHITECTS ENGINEERS
101 South Spring Street
Little Rock, Arkansas 72201
501.372.2900

Consultant
R. A. HEINTGES ARCHITECTS
128 Fifth Avenue, 5th Floor
New York, New York 10011
212.652.2866

Seal

Issue	Date
4 100% CONSTRUCTION DOCS	09/27/02
3 90% PROGRESS PRINTING	08/30/02
2 100% STRUCTURAL CD	07/01/02
1 100% STL & CONC CD	05/15/02

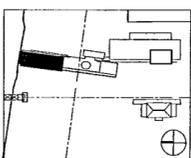

Job No. 9908

Scale 1/16"=1'-0"


Date MAY 15, 2002

Title


**SLAB REINFORCEMENT
EXECUTIVE LEVEL AND
EXECUTIVE ROOF PLAN**

Sheet No.

S112

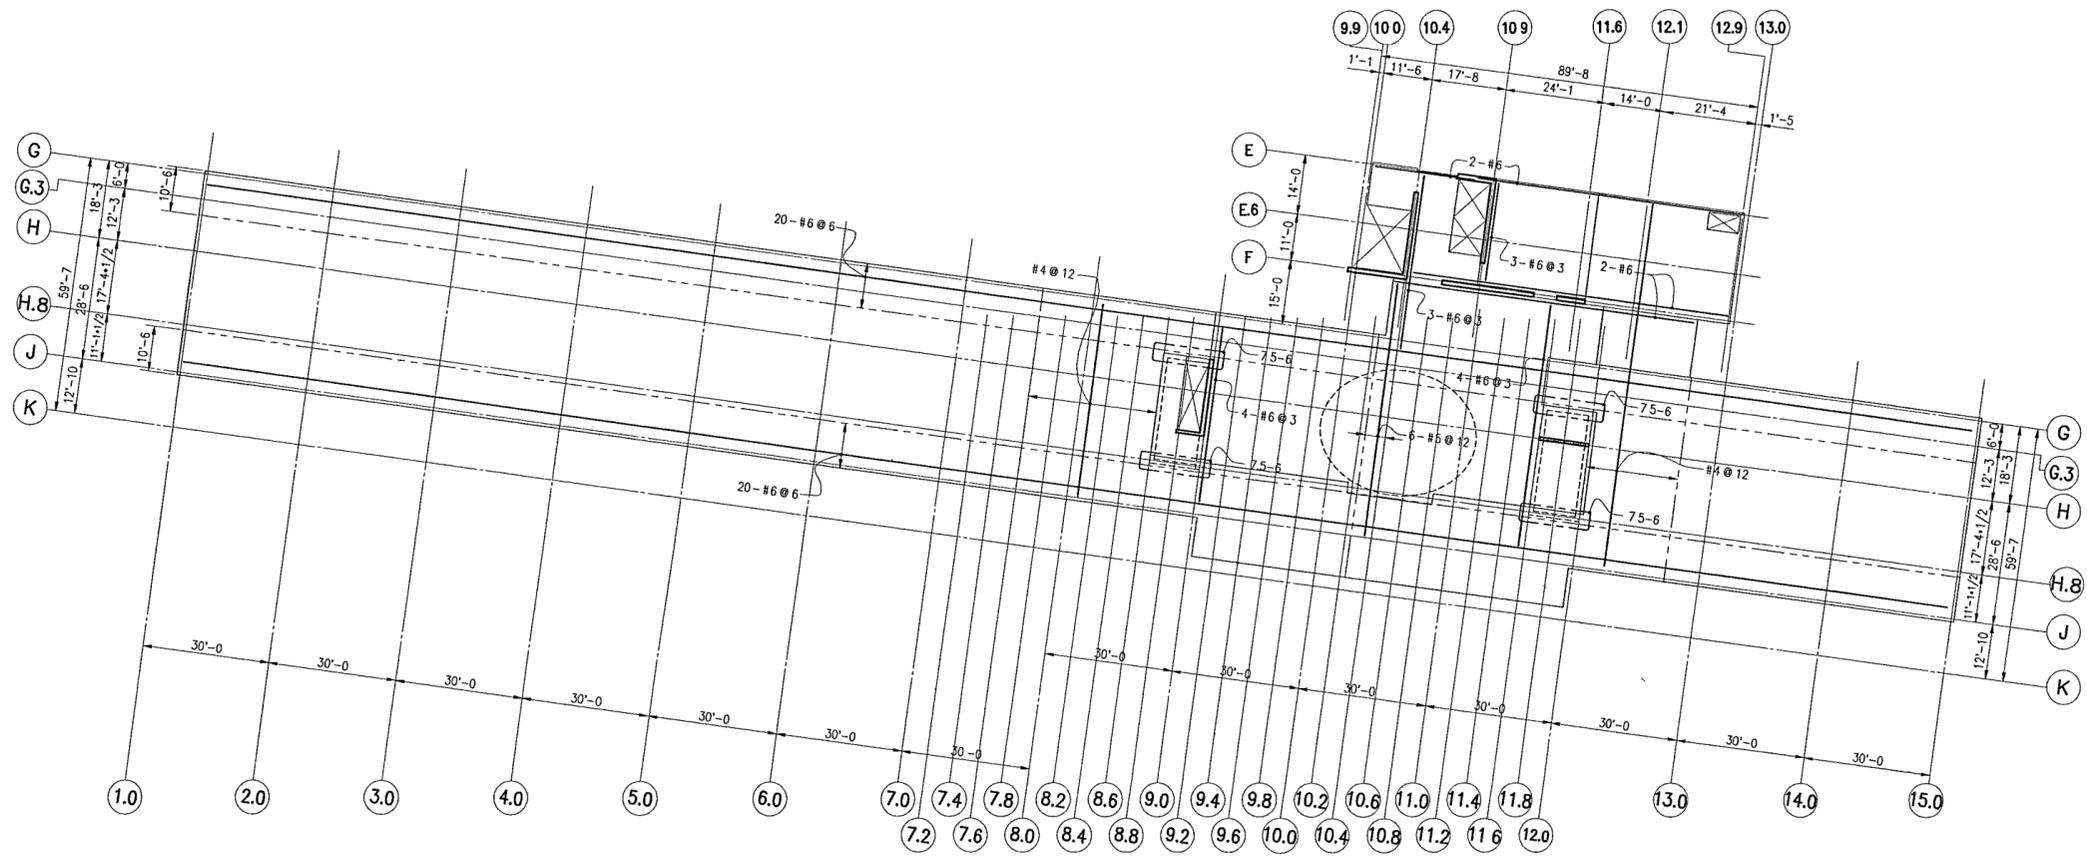

E EXECUTIVE LEVEL

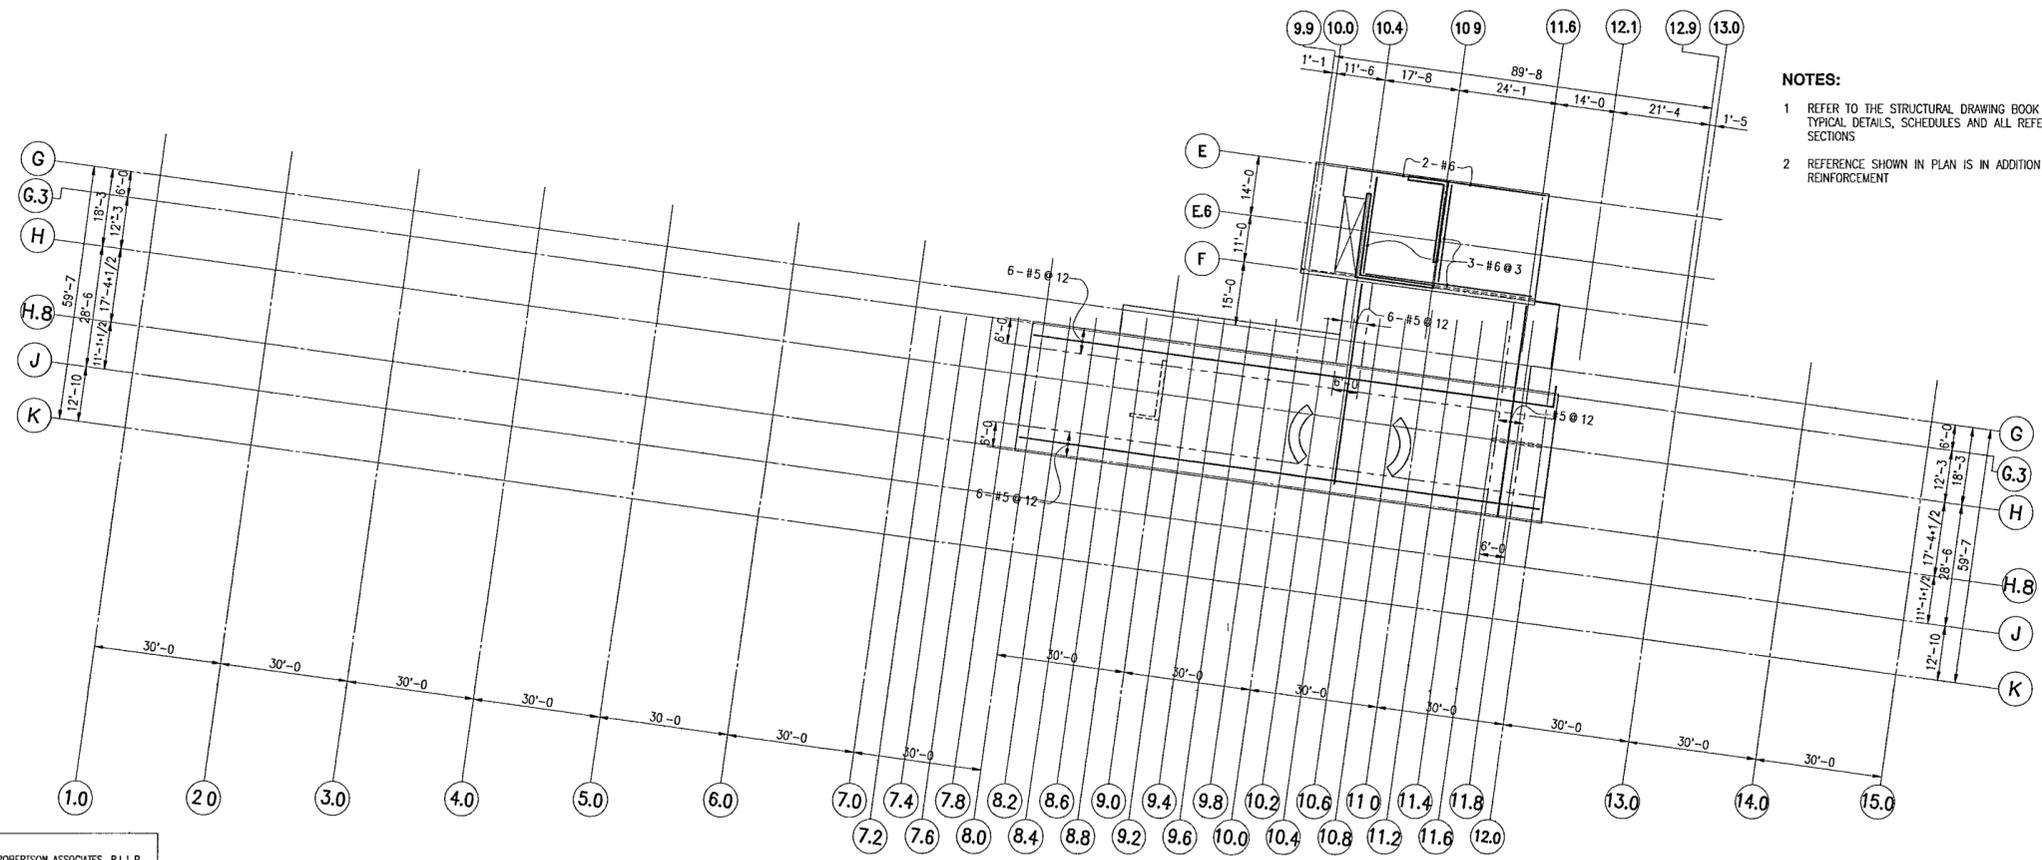

F EXECUTIVE ROOF LEVEL

- NOTES:**
- 1 REFER TO THE STRUCTURAL DRAWING BOOK FOR GENERAL NOTES, TYPICAL DETAILS, SCHEDULES AND ALL REFERENCED DETAILS AND SECTIONS
 - 2 REFERENCE SHOWN IN PLAN IS IN ADDITION TO SCHEDULED REINFORCEMENT

© Copyright LESLIE E. ROBERTSON ASSOCIATES, R.L.L.P.
WARNING IT IS A VIOLATION OF LAW FOR ANY PERSON UNLESS ACTING UNDER THE DIRECTION OF A PROFESSIONAL LICENSED IN THE STATE OF THIS PROJECT, TO ALTER IN ANY WAY THESE DRAWINGS WHERE ANY ITEM IS ALTERED THE SUPERVISING PROFESSIONAL SHALL AFFIX TO THE ITEM HIS SEAL AND THE INSCRIPTION ALTERED BY FOLLOWED BY HIS SIGNATURE THE DATE AND A SPECIFIC DESCRIPTION OF THE ALTERATION

**WILLIAM J. CLINTON
PRESIDENTIAL
CENTER**

LITTLE ROCK, ARKANSAS

Architect
POLSHKE PARTNERSHIP LLP
320 West 13th Street
New York, New York 10014
212.807.7171

Coordinating Architects
POLK STANLEY YEARY ARCHITECTS Ltd
700 South Schuler Street
Little Rock, Arkansas 72201
501.378.0878

WITSELL EVANS RASCO
501 West Third Street
Little Rock, Arkansas 72201
501.374.5300

WOODS GARADINE ARCHITECTS
2200 South Main Street
Little Rock, Arkansas 72206
501.374.4060

Landscape Architects
HARGREAVES ASSOCIATES
118 Magazine Street
Cambridge, Massachusetts 02139
617.681.0070

LANDSCAPE ARCHITECTURE, Inc.
2300 Cottondale Lane Suite 202
Little Rock, Arkansas 72202
501.374.5610

Structural Engineer
LESLIE E. ROBERTSON ASSOC., RLLP
30 Broad Street, 47th Floor
New York, New York 10004
212.750.9000


MEP Engineers
FLACK + KURTZ Inc.
475 7th Avenue
New York, New York 10017
212.532.9600

CRUMWELL ARCHITECTS ENGINEERS
101 South Spring Street
Little Rock, Arkansas 72201
501.372.2800

Curianwall Consultant
R. A. HENTGES ARCHITECTS
126 Fifth Avenue 8th Floor
New York, New York 10011
212.652.2668

Seal


8	100% CONSTRUCTION DOCS	09/27/02
7	90% PROGRESS PRINTING	08/30/02
6	100% STRUCTURAL CD	07/01/02
5	100% STL & CONC CD	05/15/02
4	BUILDING DEPT	03/18/02
3	BID ISSUE	03/01/02
2	75% DESIGN DEVEL	01/25/02
1	50% DESIGN DEVEL	12/19/01
	Issue	Date

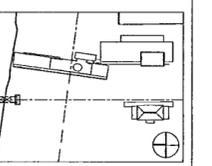

Job No. 9908
Scale 1/16"=1'-0"
Date DEC 11, 2001
Title

**MUSEUM BUILDING
TRUSS ELEVATIONS**

Sheet No. **S200**

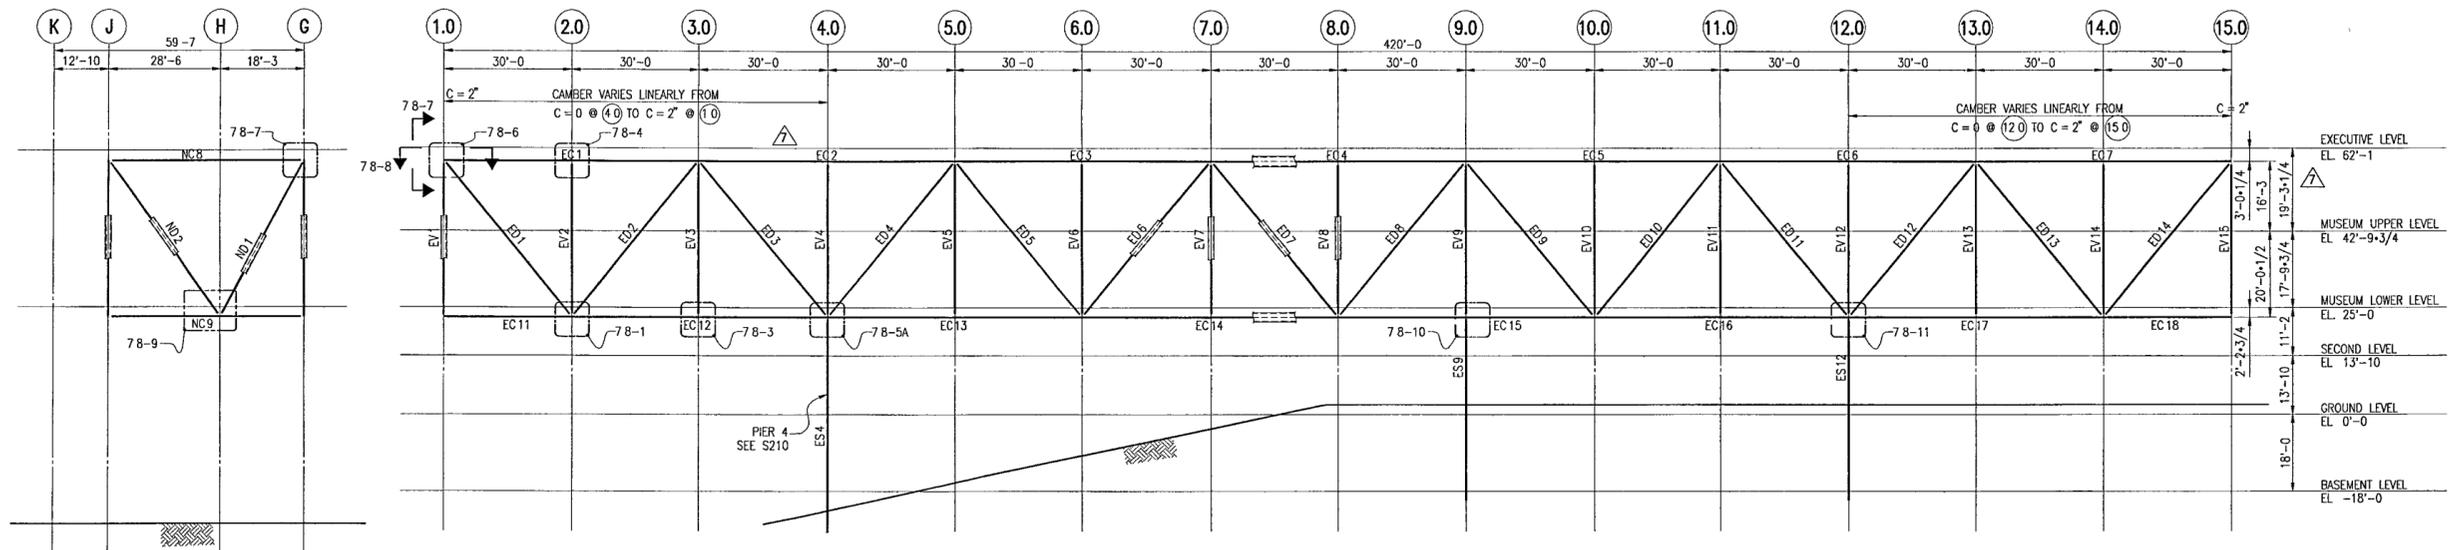

B NORTH TRUSS
LOOKING NORTH

A EAST TRUSS
LOOKING EAST

TRUSS MEMBER SCHEDULE

MEMBER	FY [KSI]	B [IN]	D [IN]	TW [IN]	TF [IN]	TENSION [KIPS]	COMPRESSION [KIPS]	M XX (K-FT)	M YY (K-FT)	WELD SIZE E. (IN)
EC1	50	16	30	5/8	1-1/4	390	-	550	10	1
EC2	50	16	30	5/8	2	2570	-	740	10	CJP
EC3	50	16	30	5/8	1-1/4	-	630	590	10	CJP
EC4	50	16	30	5/8	1-1/4	-	520	900	145	CJP
EC5	50	16	30	5/8	1-1/4	190	-	1090	225	CJP
EC6	50	16	30	5/8	1-3/4	1950	-	920	260	CJP
EC7	50	16	30	5/8	1-1/4	280	-	620	25	7/8
EC11	50	16	26	5/8	1-1/4	70	10	270	70	1/2
EC12	50	16	26	5/8	1-1/4	-	1190	420	85	CJP
EC13	50	16	26	5/8	1-1/4	-	1150	310	10	CJP
EC14	50	16	26	5/8	1-1/4	950	-	210	10	CJP
EC15	50	16	26	5/8	1-1/4	-	340	445	75	1
EC16	50	16	26	5/8	1-1/4	-	950	210	10	1
EC17	50	16	26	5/8	1-1/4	-	890	625	10	CJP
EC18	50	16	26	5/8	1-1/4	10	-	200	40	3/8

TRUSS MEMBER SCHEDULE

MEMBER	FY [KSI]	B [IN]	D [IN]	TW [IN]	TF [IN]	TENSION [KIPS]	COMPRESSION [KIPS]	M XX (K-FT)	M YY (K-FT)	WELD SIZE E. (IN)
ED1	50	16	16	5/8	1	-	450	50	20	3/4
ED2	50	16	16	5/8	1-3/4	1160	-	160	30	CJP
ED3	50	16	16	2-1/2	2-3/4	-	2060	120	10	CJP
ED4	50	16	16	6	3-1/4	-	2630	120	30	CJP
ED5	50	16	16	5/8	2-1/4	1700	-	160	40	CJP
ED6	50	16	16	1	1-1/4	-	790	170	10	CJP
ED7	50	16	16	1	1-3/4	-	620	430	30	CJP
ED8	50	16	16	5/8	2-1/2	1610	-	350	20	CJP
ED9	50	16	16	5/8	1	725	-	65	30	CJP
ED10	50	16	16	5/8	2-1/4	850	-	450	100	CJP
ED11	50	16	16	4	3-1/4	-	2105	345	70	CJP
ED12	50	16	16	2-1/2	2-1/2	-	1700	10	10	CJP
ED13	50	16	16	5/8	1-1/4	1000	-	40	20	CJP
ED14	50	16	16	5/8	1	-	380	30	10	3/4





TRUSS MEMBER SCHEDULE

MEMBER	FY [KSI]	B [IN]	D [IN]	TW [IN]	TF [IN]	TENSION [KIPS]	COMPRESSION [KIPS]	M XX (K-FT)	M YY (K-FT)	WELD SIZE E. (IN)
EV1	50	16	16	5/8	1	70	-	40	50	CJP
EV2	50	16	16	5/8	1	-	210	40	20	3/8
EV3	50	16	16	5/8	1	390	-	70	60	CJP
EV4	50	16	16	5/8	1-1/2	-	260	30	60	CJP
EV5	50	16	16	5/8	1-1/4	400	-	70	70	CJP
EV6	50	16	16	5/8	1	-	260	60	40	1/2
EV7	50	16	16	5/8	1	545	-	50	10	CJP
EV8	50	16	16	5/8	1	-	410	90	20	3/4
EV9	50	16	16	2	2-1/4	-	2060	50	10	CJP
EV10	50	16	16	5/8	1	-	465	90	20	3/4
EV11	50	16	16	5/8	1	535	-	65	45	CJP
EV12	50	16	16	5/8	1	-	310	30	30	3/4
EV13	50	16	16	5/8	1	330	-	60	50	CJP
EV14	50	16	16	5/8	1	-	180	50	30	1/2
EV15	50	16	16	5/8	1	80	-	60	70	CJP

TRUSS MEMBER SCHEDULE

MEMBER	FY [KSI]	B [IN]	D [IN]	TW [IN]	TF [IN]	TENSION [KIPS]	COMPRESSION [KIPS]	M XX (K-FT)	M YY (K-FT)	WELD SIZE E. (IN)
NC8	50	16	30	5/8	1-1/4	-	40	590	30	CJP
NC9	50	16	26	5/8	1-1/4	50	-	350	160	CJP
ND1	50	16	16	5/8	1	220	-	60	10	CJP
ND2	50	16	16	5/8	1	-	70	80	80	CJP
ES9	50	16	20	2	2	-	1590	390	20	CJP
ES12	50	16	20	1-1/2	3	-	2900	510	10	CJP

- NOTES.**
- TRUSS CONNECTION FORCES TABULATED ARE FACTORED
 - CONTRACTOR MAY INCREASE PLATE THICKNESSES AND/OR PLATE YIELD POINT WHERE PERMITTED BY THE STRUCTURAL ENGINEER AND ARCHITECT
 - THE TRUSS ELEVATION AND DIMENSIONS SHOW THE CENTERLINES OF THE MEMBERS

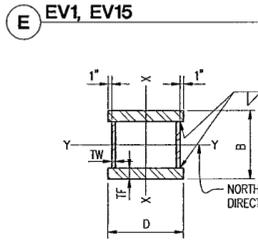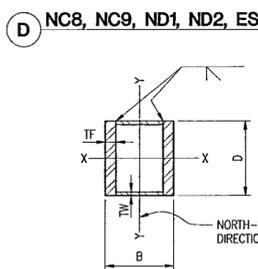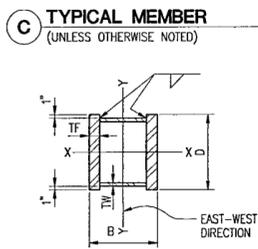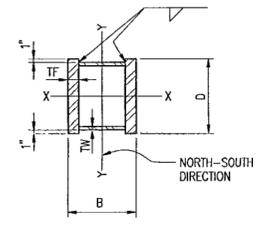

© Copyright LESLIE E. ROBERTSON ASSOCIATES, RLLP
WARNING IT IS A VIOLATION OF LAW FOR ANY PERSON, UNLESS ACTING UNDER THE DIRECTION OF A PROFESSIONAL, LICENSED IN THE STATE OF THIS PROJECT TO ALTER IN ANY WAY THESE DRAWINGS WHERE ANY ITEM IS ALTERED THE SUPERVISING PROFESSIONAL SHALL AFFIX TO THE ITEM HIS SEAL AND THE INSCRIPTION "ALTERED BY" FOLLOWED BY HIS SIGNATURE, THE DATE, AND A SPECIFIC DESCRIPTION OF THE ALTERATION

LITTLE ROCK, ARKANSAS
Architect
POLSHKE PARTNERSHIP LLP
320 West 13th Street
New York, New York 10014
212.697.7171

Coordinating Architects
POLK STANLEY YEARY ARCHITECTS Ltd
700 South Schiller Street
Little Rock, Arkansas 72201
501.378.0878
WITSELL EVANS RASCO
901 West Third Street
Little Rock, Arkansas 72201
501.374.6300
WOODS CARADINE ARCHITECTS
2200 South Main Street
Little Rock, Arkansas 72206
501.374.4060

Landscape Architects
HARGREAVES ASSOCIATES
118 Magazine Street
Cambridge, Massachusetts 02139
617.661.0070
LANDSCAPE ARCHITECTURE, Inc.
2300 Cottondale Lane Suite 202
Little Rock, Arkansas 72202
501.374.9610

Structural Engineer
LESLIE E. ROBERTSON ASSOC., RLLP
30 Broad Street, 47th Floor
New York, New York 10004
212.750.9000


MEP Engineers
FLACK + KURTZ Inc
475 Fifth Avenue
New York, New York 10017
212.532.9600

CRUMWELL ARCHITECTS ENGINEERS
101 South Swaney Street
Little Rock, Arkansas 72201
501.372.2900

Curran & Mitchell Consultant
R. A. HENTGES ARCHITECTS
126 Fifth Avenue, 9th Floor
New York, New York 10011
212.652.2966

Seal


8	100% CONSTRUCTION DOCS	09/27/02
7	90% PROGRESS PRINTING	08/30/02
6	100% STRUCTURAL CD	07/01/02
5	100% STL & CONC CD	05/15/02
4	BUILDING DEPT	03/18/02
3	BID ISSUE	03/01/02
2	75% DESIGN LEVEL	01/25/02
1	50% DESIGN LEVEL	12/19/01
Issue		Date

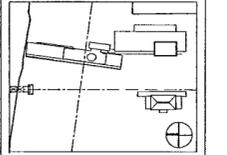

Job No 9908
Scale 1/16"=1'-0"
Date DEC 11, 2001
Title

MUSEUM BUILDING
TRUSS ELEVATIONS

Sheet No **S201**

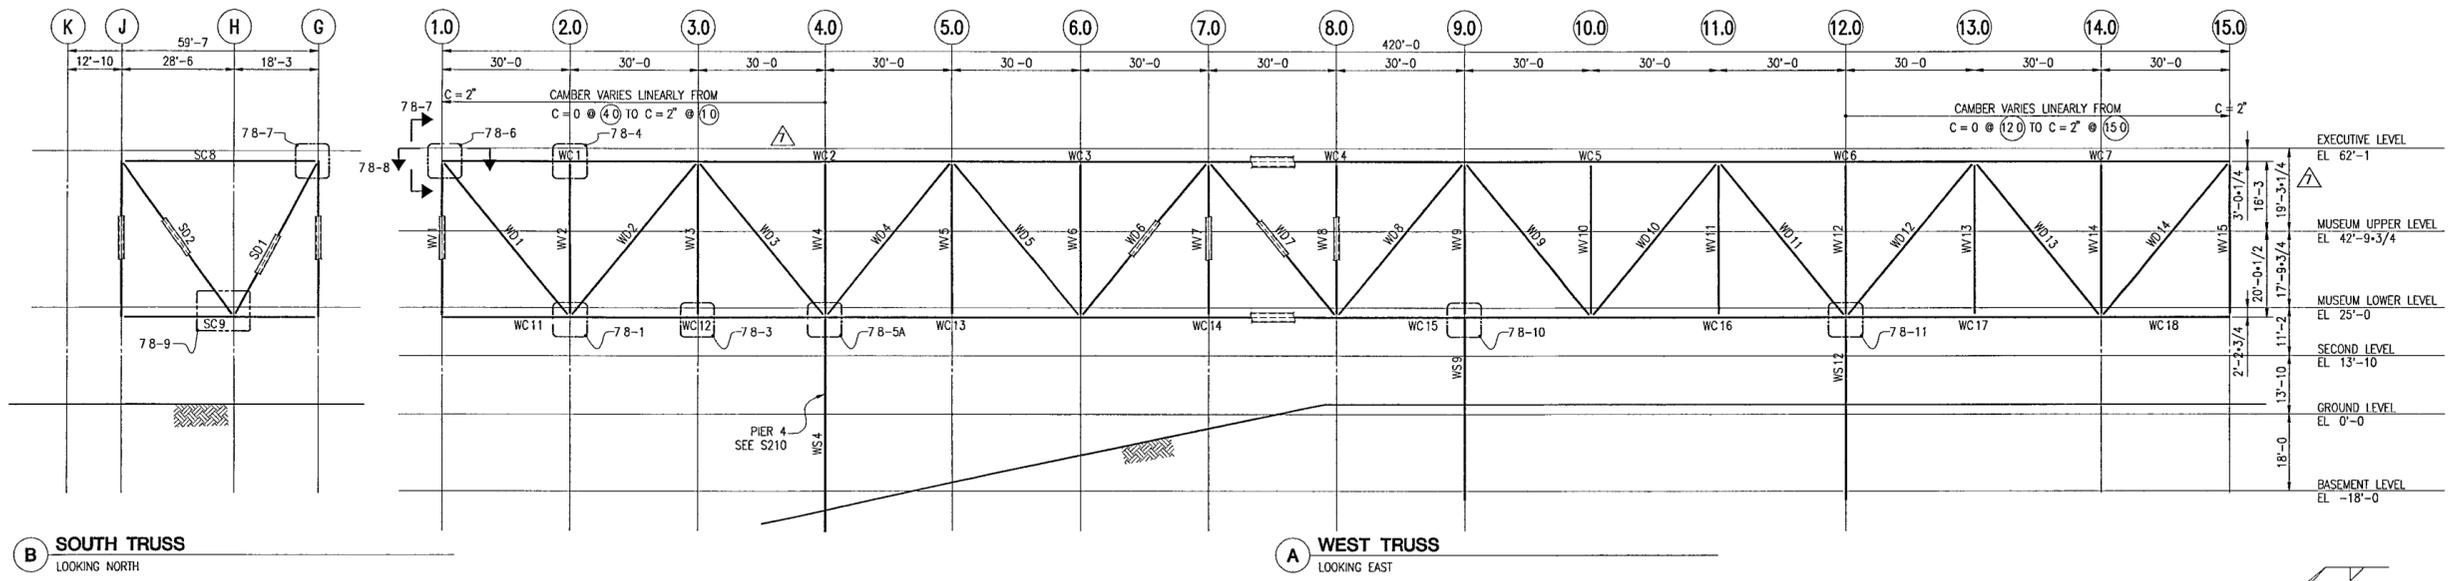

B SOUTH TRUSS
LOOKING NORTH

A WEST TRUSS
LOOKING EAST


MEMBER	FY [KSI]	B [IN]	D [IN]	TW [IN]	TF [IN]	TENSION [KIPS]	COMPRESSION [KIPS]	M XX (K-FT)	M YY (K-FT)	WELD SIZE E. (IN)
WC1	50	16	30	5/8	1-1/4	110	-	680	60	7/8
WC2	50	16	30	5/8	2	2470	-	640	50	CJP
WC3	50	16	30	5/8	1-1/4	-	880	670	70	CJP
WC4	50	16	30	5/8	1-1/4	-	490	1250	220	CJP
WC5	50	16	30	5/8	1-1/2	630	-	900	390	CJP
WC6	50	16	30	5/8	2-1/4	2640	-	980	265	CJP
WC7	50	16	30	5/8	1-1/4	200	-	640	100	7/8
WC11	50	16	26	5/8	1-1/4	10	-	250	90	5/8
WC12	50	16	26	5/8	1-1/4	-	820	320	50	CJP
WC13	50	16	26	5/8	1-1/4	-	1140	290	10	CJP
WC14	50	16	26	5/8	1-1/4	950	-	180	50	CJP
WC15	50	16	26	5/8	1-1/2	-	1000	590	40	CJP
WC16	50	16	26	5/8	1-1/4	-	1470	110	10	CJP
WC17	50	16	26	5/8	2-3/4	2600	-	900	255	CJP
WC18	50	16	26	5/8	1-1/4	40	-	280	70	1/2

MEMBER	FY [KSI]	B [IN]	D [IN]	TW [IN]	TF [IN]	TENSION [KIPS]	COMPRESSION [KIPS]	M XX (K-FT)	M YY (K-FT)	WELD SIZE E. (IN)
WV1	50	16	16	5/8	1	120	-	110	40	CJP
WV2	50	16	16	5/8	1	-	350	70	330	CJP
WV3	50	16	16	5/8	1	470	-	10	200	CJP
WV4	50	16	16	5/8	1	-	300	20	250	CJP
WV5	50	16	16	5/8	1	475	-	10	200	CJP
WV6	50	16	16	5/8	1	-	350	10	200	CJP
WV7	50	16	16	5/8	1	440	-	10	420	CJP
WV8	50	16	16	5/8	1	-	610	95	420	CJP
WV9	50	16	16	4	4	-	3210	40	780	CJP
WV10	50	16	16	5/8	1	-	745	35	720	CJP
WV11	50	16	16	5/8	1	350	-	60	700	CJP
WV12	50	16	16	5/8	1-1/2	-	460	20	650	CJP
WV13	50	16	16	5/8	1	335	-	55	620	CJP
WV14	50	16	16	5/8	1	-	350	70	400	CJP
WV15	50	16	16	5/8	1	100	-	110	30	CJP


MEMBER	FY [KSI]	B [IN]	D [IN]	TW [IN]	TF [IN]	TENSION [KIPS]	COMPRESSION [KIPS]	M XX (K-FT)	M YY (K-FT)	WELD SIZE E. (IN)
WD1	50	16	16	5/8	1	-	340	40	250	3/4
WD2	50	16	16	5/8	1-1/2	1410	-	50	270	CJP
WD3	50	16	16	6	4	-	2510	30	100	CJP
WD4	50	16	16	6	4	-	2690	20	80	CJP
WD5	50	16	16	5/8	1-1/2	1560	-	50	10	CJP
WD6	50	16	16	5/8	1	-	530	20	70	CJP
WD7	50	16	16	1-1/2	1-1/2	-	1100	30	340	CJP
WD8	50	16	16	5/8	3	2420	-	100	450	CJP
WD9	50	16	16	5/8	1-3/4	1175	-	225	390	CJP
WD10	50	16	16	5/8	2-1/2	1000	-	420	540	CJP
WD11	50	16	16	5/8	3-3/4	-	2425	300	70	CJP
WD12	50	16	16	6	4	-	2480	30	100	CJP
WD13	50	16	16	5/8	1-3/4	1410	-	50	310	CJP
WD14	50	16	16	5/8	1	-	390	50	270	3/4

MEMBER	FY [KSI]	B [IN]	D [IN]	TW [IN]	TF [IN]	TENSION [KIPS]	COMPRESSION [KIPS]	M XX (K-FT)	M YY (K-FT)	WELD SIZE E. (IN)
SC8	50	16	30	5/8	1-1/4	-	30	675	10	CJP
SC9	50	16	26	5/8	1-1/4	30	-	290	30	CJP
SD1	50	16	16	5/8	1	130	-	30	45	CJP
SD2	50	16	16	5/8	1	30	-	60	80	CJP
WS9	50	16	20	1-1/2	3	-	3535	155	200	CJP
WS12	50	16	20	3	4	-	3720	770	290	CJP


- NOTES**
- 1 TRUSS CONNECTION FORCES TABULATED ARE FACTORED
 - 2 CONTRACTOR MAY INCREASE PLATE THICKNESSES AND/OR PLATE YIELD POINT WHERE PERMITTED BY THE STRUCTURAL ENGINEER AND ARCHITECT
 - 3 THE TRUSS ELEVATION AND DIMENSIONS SHOW THE CENTERLINES OF THE MEMBERS

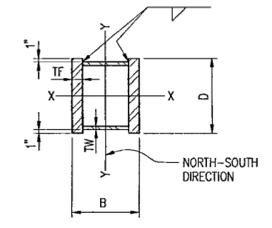


C TYPICAL MEMBER
(UNLESS OTHERWISE NOTED)

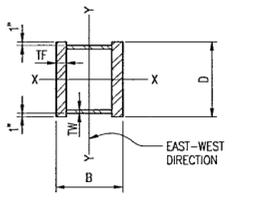

D SC8, SC9, SD1, SD2

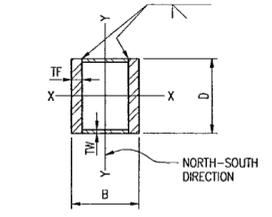

E WV1, WV15

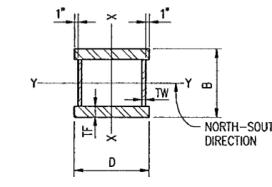

F WS9, WS12

© Copyright LESLIE E ROBERTSON ASSOCIATES, RLLP
WARNING IT IS A VIOLATION OF LAW FOR ANY PERSON UNLESS ACTING UNDER THE DIRECTION OF A PROFESSIONAL, LICENSED IN THE STATE OF THIS PROJECT TO ALTER IN ANY WAY THESE DRAWINGS WHERE ANY ITEM IS ALTERED THE SUPERVISING PROFESSIONAL SHALL AFFIX TO THE ITEM HIS SEAL AND THE INSCRIPTION "ALTERED BY" FOLLOWED BY HIS SIGNATURE, THE DATE, AND A SPECIFIC DESCRIPTION OF THE ALTERATION

**WILLIAM J CLINTON
PRESIDENTIAL
CENTER**

LITTLE ROCK, ARKANSAS

Architect

POLSHEK PARTNERSHIP LLP
320 West 13th Street
New York, New York 10014
212.807.7171

Coordinating Architects

POLK STANLEY YEARY ARCHITECTS Ltd
700 South Schiller Street
Little Rock, Arkansas 72201
501.378.0878

WITSELL EVANS RASCO
901 West Third Street
Little Rock, Arkansas 72201
501.374.5300

WOODS CARADINE ARCHITECTS
2200 South Main Street
Little Rock, Arkansas 72206
501.374.4080

Landscape Architects

HARGREAVES ASSOCIATES
118 Magazine Street
Cambridge, Massachusetts 02139
617.861.0070

LANDSCAPE ARCHITECTURE, Inc.
2300 Cottondale Lane Suite 202
Little Rock, Arkansas 72202
501.374.5610

Structural Engineer

LESLIE E. ROBERTSON ASSOC., RLLP
30 Broad Street, 47th Floor
New York, New York 10004
212.750.9000

MEP Engineers

FLACK + KURTZ Inc.
475 Fifth Avenue
New York, New York 10017
212.532.9600

CROMWELL ARCHITECTS ENGINEERS

101 South Spring Street
Little Rock, Arkansas 72201
501.372.2900


Curtainwall Consultant

R. A. HEINTGES ARCHITECTS
126 Fifth Avenue, 9th Floor
New York, New York 10011
212.852.2965

Seal



1 100% CONSTRUCTION DOCS 09/27/02
0 90% PROGRESS PRINTING 08/30/02
Issue Date

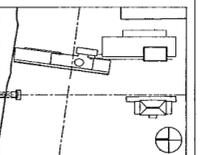

Job No 9908

Scale 1/16"=1'-0"


Date AUG 30, 2002

Title

**EAST WALL
ELEVATION**



Sheet No

S205

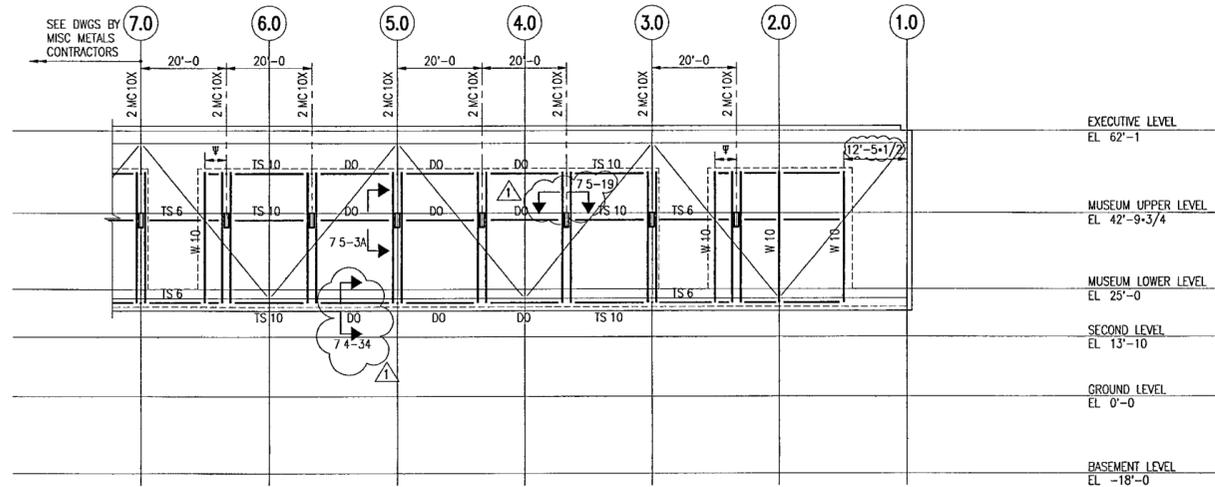

A EAST WALL ELEVATION

LOOKING WEST, ALL STEEL IN THIS ELEVATION IS PAINTED W/ ZINC RICH PRIMER

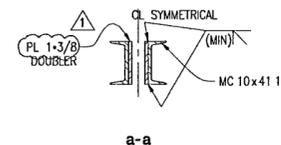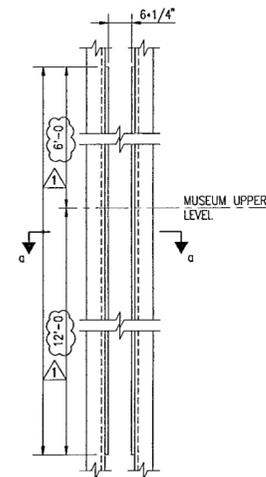

B TYPICAL 2 MC10

SCALE 3/4" = 1'-0"

© Copyright LESLIE E. ROBERTSON ASSOCIATES, R.L.L.P.
WARNING IT IS A VIOLATION OF LAW FOR ANY PERSON, UNLESS ACTING UNDER THE DIRECTION OF A PROFESSIONAL, LICENSED IN THE STATE OF THIS PROJECT, TO ALTER IN ANY WAY THESE DRAWINGS WHERE ANY ITEM IS ALTERED THE SUPERVISING PROFESSIONAL SHALL AFFIX TO THE ITEM HIS SEAL AND THE INSCRIPTION "ALTERED BY" FOLLOWED BY HIS SIGNATURE, THE DATE, AND A SPECIFIC DESCRIPTION OF THE ALTERATION.

**WILLIAM J CLINTON
PRESIDENTIAL
CENTER**

LITTLE ROCK, ARKANSAS

Architect
POLSHEK PARTNERSHIP LLP
320 West 13th Street
New York, New York 10014
212.607.7171

Coordinating Architects
POLK STANLEY YEARY ARCHITECTS Ltd
700 South Schiller Street
Little Rock, Arkansas 72201
501.378.0878

WITSELL EVANS RASCO
901 West Third Street
Little Rock, Arkansas 72201
501.374.5300

WOODS GARADINE ARCHITECTS
2200 South Main Street
Little Rock, Arkansas 72208
501.374.4060

Landscape Architects
HARGREAVES ASSOCIATES
118 Magazine Street
Cambridge, Massachusetts 02139
617.661.0070

LANDSCAPE ARCHITECTURE, Inc.
2300 Cottondale Lane Suite 202
Little Rock, Arkansas 72202
501.374.5610

Structural Engineer
LESLIE E. ROBERTSON ASSOC., RLLP
30 Broad Street, 47th Floor
New York, New York 10004
212.750.9000


MEP Engineers
FLACK + KURTZ Inc.
475 Fifth Avenue
New York, New York 10017
212.532.9600

CROMWELL ARCHITECTS ENGINEERS
101 South Spring Street
Little Rock, Arkansas 72201
501.372.2300

Curfameill Consultant
R. A. HEINTGES ARCHITECTS
128 Fifth Avenue 9th Floor
New York, New York 10011
212.652.2966

Seal

9	100% CONSTRUCTION DOCS	09/27/02
8	90% PROGRESS PRINTING	08/30/02
7	100% STRUCTURAL CD	07/01/02
6	100% STL & CONC CD	05/15/02
5	CD PRE-RELEASE	05/01/02
4	BUILDING DEPT	03/18/02
3	BID ISSUE	03/01/02
2	75% DESIGN DEVEL.	01/25/02
1	50% DESIGN DEVEL.	12/19/01
Issue		Date

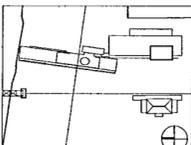

Job No 9908

Scale 1/4"=1'-0" UON




Date DEC 11, 2001

Title

PIER 4
ELEVATION

Sheet No

S210

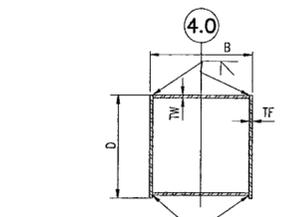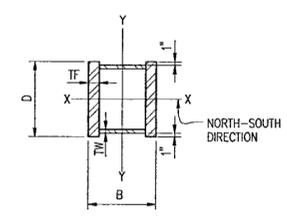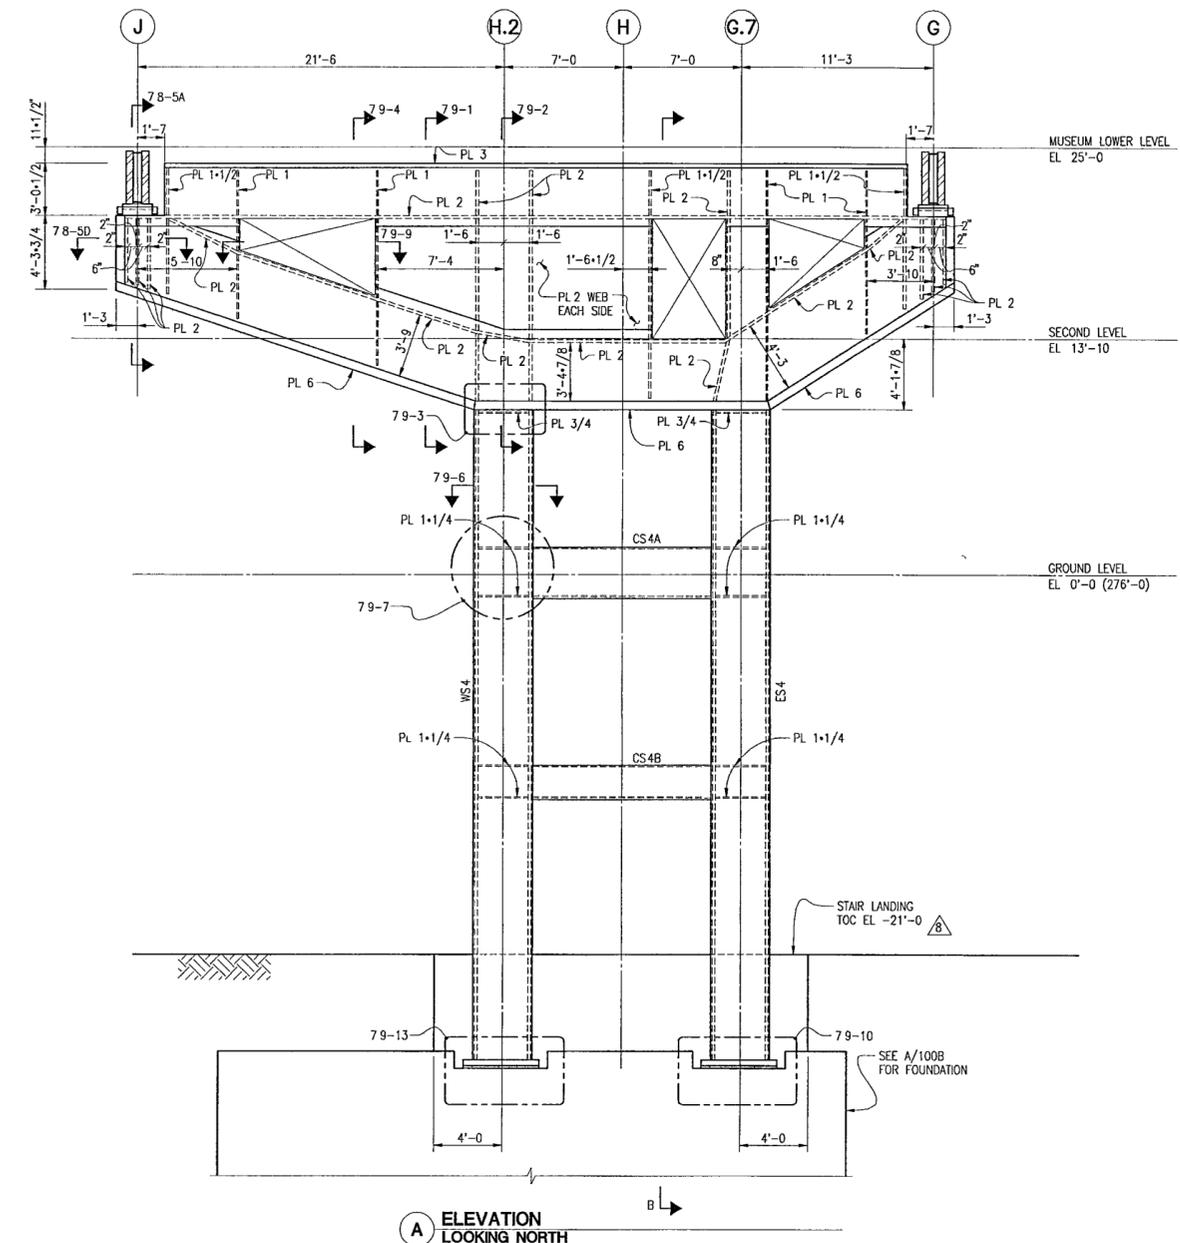

PIER 4 - MEMBER SCHEDULE

MEMBER	FY [KSI]	B [IN]	D [IN]	TW [IN]	TF [IN]	TENSION [KIPS]	COMPRESSION [KIPS]	M XX (K-FT)	M YY (K-FT)	WELD SIZE E, (IN)
WS4	50	34	42	2	4	-	8400	2770	520	CJP
ES4	50	34	42	2	4	-	1520	1560	1500	CJP
CS4A	50	32	36	1-1/4	1-1/4	10	-	10	1700	CJP
CS4B	50	32	24	1-1/4	1-1/4	50	-	20	1600	CJP

- NOTES.**
- MEMBER CONNECTION FORCES TABULATED ARE FACTORED
 - CONTRACTOR MAY INCREASE PLATE THICKNESSES AND/OR PLATE YIELD POINT WHERE PERMITTED BY THE STRUCTURAL ENGINEER AND ARCHITECT

© Copyright LESLIE E. ROBERTSON ASSOCIATES, R.L.L.P.
WARNING IT IS A VIOLATION OF LAW FOR ANY PERSON, UNLESS ACTING UNDER THE DIRECTION OF A PROFESSIONAL, LICENSED IN THE STATE OF THIS PROJECT, TO ALTER IN ANY WAY THESE DRAWINGS WHERE ANY ITEM IS ALTERED, THE SUPERVISING PROFESSIONAL SHALL AFFIX TO THE ITEM HIS SEAL AND THE INSCRIPTION ALTERED BY FOLLOWED BY HIS SIGNATURE, THE DATE, AND A SPECIFIC DESCRIPTION OF THE ALTERATION

**WILLIAM J CLINTON
PRESIDENTIAL
CENTER**

LITTLE ROCK, ARKANSAS

Architect
POLSHEK PARTNERSHIP LLP
320 West 13th Street
New York, New York 10014
212.807.7171

Coordinating Architects
POLK STANLEY YEARY ARCHITECTS LM
700 South Schiller Street
Little Rock, Arkansas 72201
501.378.0878

WITSELL EVANS RASCO
901 West Third Street
Little Rock, Arkansas 72201
501.374.5300

WOODS CARADINE ARCHITECTS
2200 South Main Street
Little Rock, Arkansas 72206
501.374.4060

Landscape Architects
HARGREAVES ASSOCIATES
118 Magazine Street
Cambridge, Massachusetts 02139
617.661.0070


LANDSCAPE ARCHITECTURE, Inc.
2300 Cottondale Lane Suite 202
Little Rock, Arkansas 72202
501.374.5510

Structural Engineer
LESLIE E. ROBERTSON ASSOC., RLLP
30 Broad Street, 4th Floor
New York, New York 10004
212.750.9000


MEP Engineers
FLACK + KURTZ Inc
475 Fifth Avenue
New York, New York 10017
212.532.9600

CROMWELL ARCHITECTS ENGINEERS
101 South Spring Street
Little Rock, Arkansas 72201
501.372.2900

Curtainwall Consultant
R. A. HEINTGES ARCHITECTS
126 Fifth Avenue 9th Floor
New York, New York 10011
212.632-2966

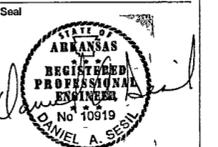


Issue	Date
0	09/27/02

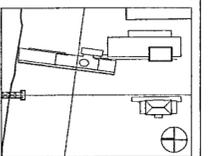


Job No. 9908
Scale 1/4"=1'-0" UON
Date SEP 27, 2002
Title


STAIR #2
Sheet No. S215

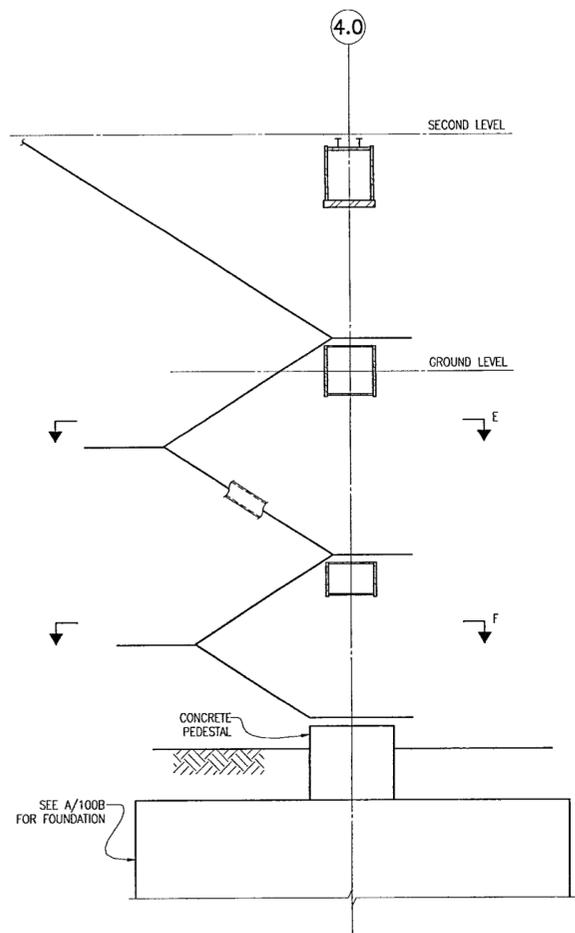

**C SECTION AT EGRESS STAIRS
LOOKING EAST**

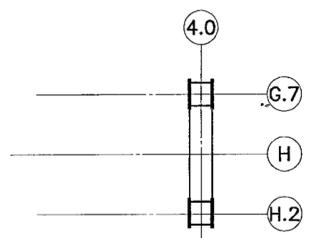

B PART PLAN

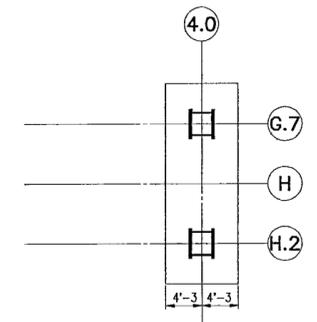


A PART PLAN

© Copyright LESLIE E. ROBERTSON ASSOCIATES, RLLP
WARNING IT IS A VIOLATION OF LAW FOR ANY PERSON, UNLESS ACTING UNDER THE DIRECTION OF A PROFESSIONAL LICENSED IN THE STATE OF THIS PROJECT, TO ALTER IN ANY WAY THESE DRAWINGS WHERE ANY ITEM IS ALTERED, THE SUPERVISING PROFESSIONAL SHALL AFFIX TO THE ITEM HIS SEAL AND THE INSCRIPTION "ALTERED BY" FOLLOWED BY HIS SIGNATURE, THE DATE, AND A SPECIFIC DESCRIPTION OF THE ALTERATION

Seal

Issue	Date
6	100% CONSTRUCTION DOCS 09/27/02
5	SFS-12 09/18/02
4	100% PROGRESS PRINTING 08/30/02
3	100% STRUCTURAL CD 07/01/02
2	100% CD MUSEUM BLDG 06/14/02
1	100% STL & CONC CD 05/15/02

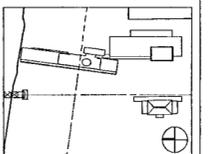

Job No 9908
Scale 1/8"=1'-0"
Date MAY 15, 2002
Title

**WALL ELEVATIONS
MUSEUM BUILDING**


Sheet No

S220


FOR OFFICIAL USE ONLY

NOTES.

- REFER TO THE STRUCTURAL DRAWING BOOK FOR GENERAL NOTES, TYPICAL DETAILS, SCHEDULES AND ALL REFERENCED DETAILS AND SECTIONS
- PROVIDE MIN VERTICAL AND HORIZONTAL REINFORCEMENTS UNLESS OTHERWISE NOTED SHOWN
- PROVIDE MIN WALL DOWELS AT WALL FOOTINGS UNON
- AT COLUMN FOOTINGS AND CAISSON CAPS PROVIDE DOWELS TO MATCH WALL VERTICALS WHERE TENSION DOWELS ARE NOTED PROVIDE LD EMBEDMENT IN FOOTING OR CAP AND 1.3 LD LAP SPLICE IN WALL HOOK DOWELS IN FOOTING AS REQUIRED
- SEE SECTIONS AND DETAILS FOR REINFORCEMENT IN ELEVATOR PIT WALLS

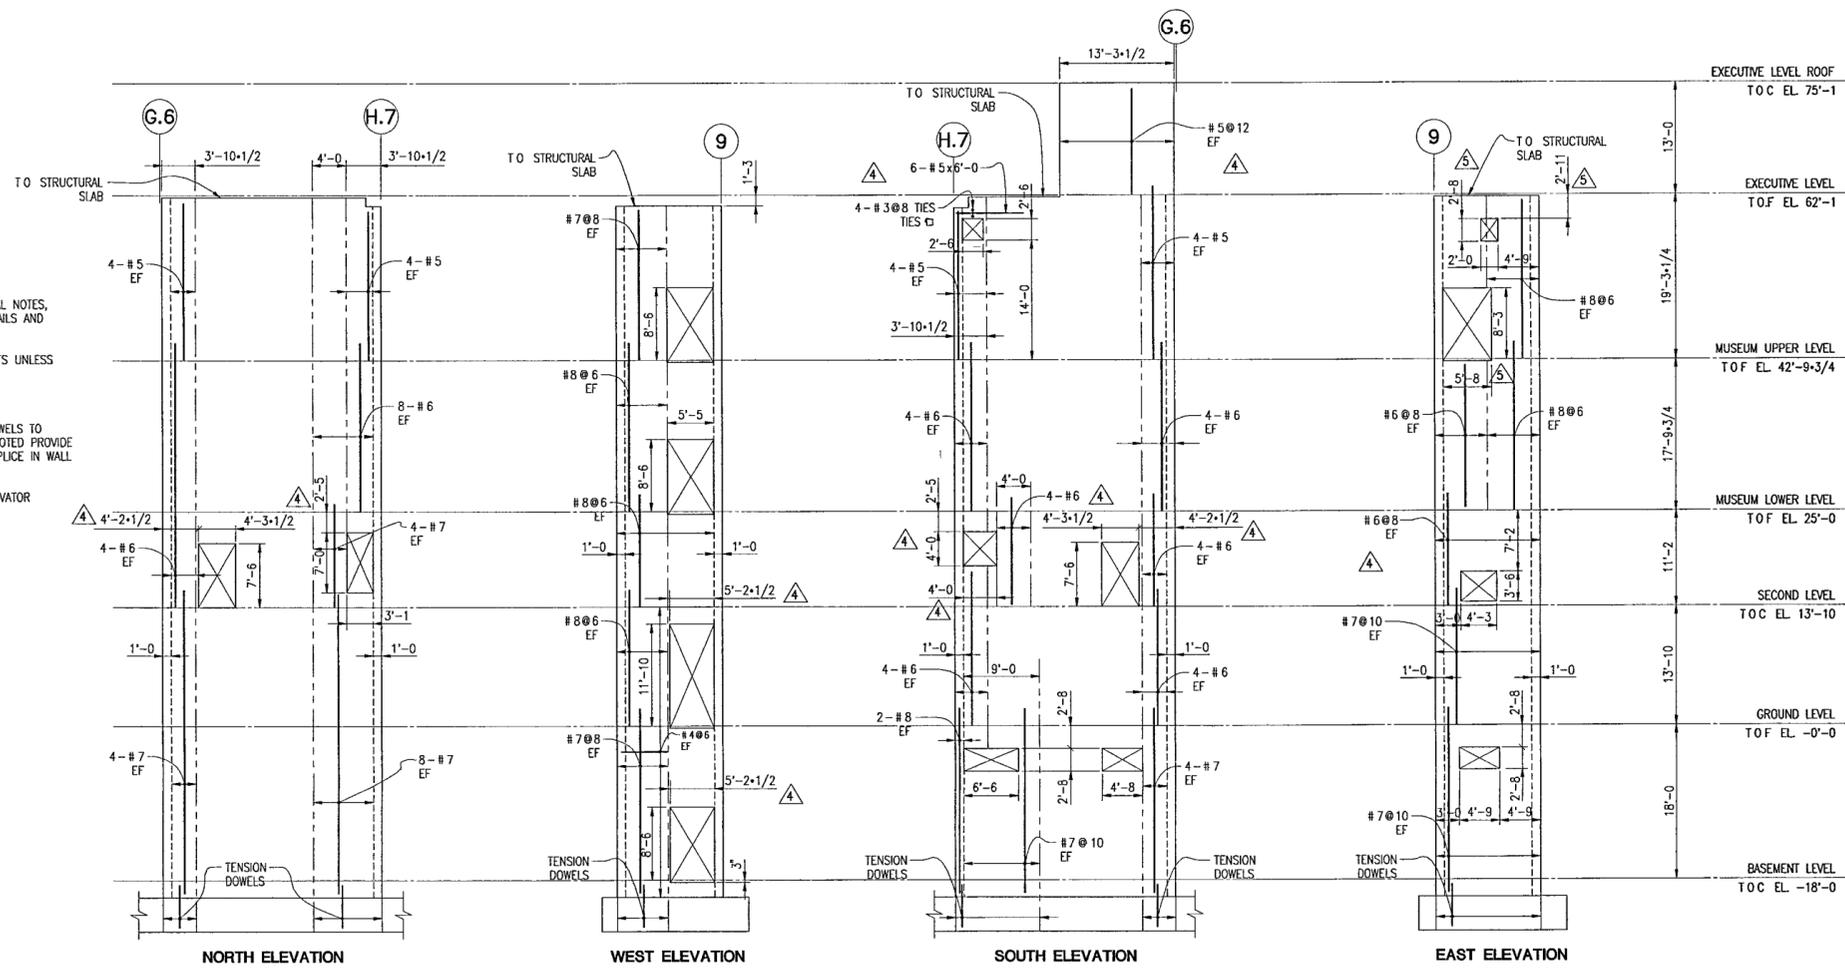

B WALL @ GRID 9 (STAIR 4)

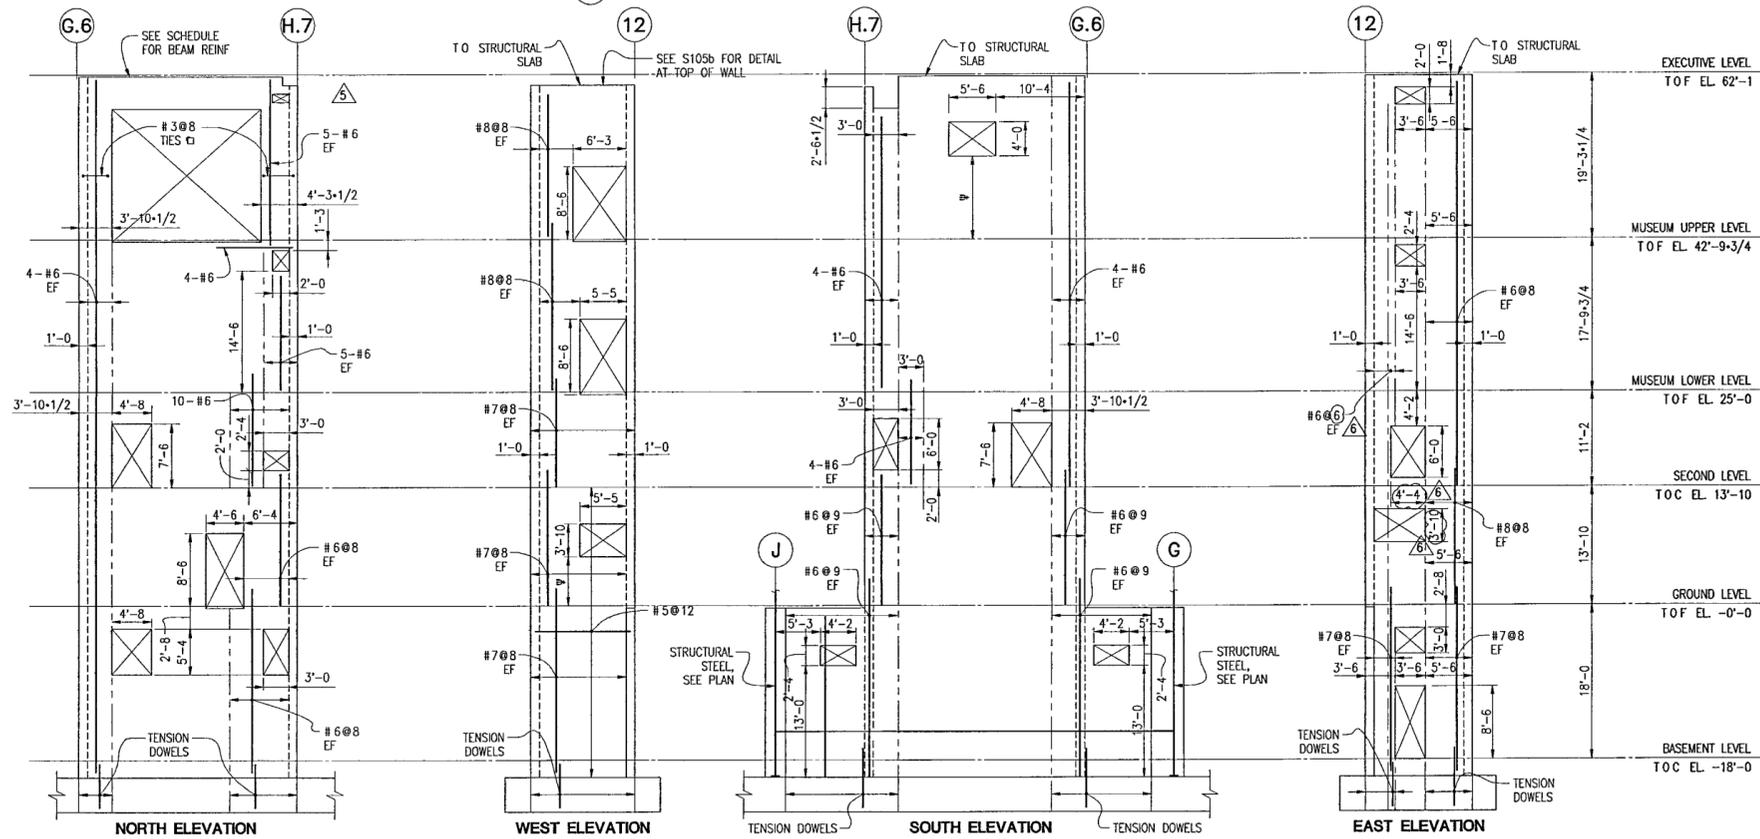

A WALL @ GRID 12 (STAIR 5)

© Copyright LESLIE E. ROBERTSON ASSOCIATES, RLLP
WARNING IT IS A VIOLATION OF LAW FOR ANY PERSON, UNLESS ACTING UNDER THE DIRECTION OF A PROFESSIONAL LICENSED IN THE STATE OF THIS PROJECT TO ALTER IN ANY WAY THESE DRAWINGS WHERE ANY ITEM IS ALTERED THE SUPERVISING PROFESSIONAL SHALL AFFIX TO THE ITEM HIS SEAL AND THE INSCRIPTION "ALTERED BY" FOLLOWED BY HIS SIGNATURE, THE DATE, AND A SPECIFIC DESCRIPTION OF THE ALTERATION

**WILLIAM J. CLINTON
PRESIDENTIAL
CENTER**

LITTLE ROCK, ARKANSAS

Architect

POLSHEK PARTNERSHIP LLP
320 West 13th Street
New York, New York 10014
212.807.7171

Coordinating Architects

POLK STANLEY YEARY ARCHITECTS Ltd
700 South Schiller Street
Little Rock, Arkansas 72201
501.378.0878

WITSELL EVANS RASCO
901 West Third Street
Little Rock, Arkansas 72201
501.374.5300

WOODS CARADINE ARCHITECTS
2200 South Main Street
Little Rock, Arkansas 72206
501.374.4060

Landscape Architects

HARGREAVES ASSOCIATES
118 Magazine Street
Cambridge, Massachusetts 02139
617.661.0070

LANDSCAPE ARCHITECTURE Inc.
2300 Cottondale Lane Suite 202
Little Rock, Arkansas 72202
501.374.5510

Structural Engineer

LESLIE E. ROBERTSON ASSOC. RLLP
30 Broad Street, 47th Floor
New York, New York 10004
212.750.9000

MEP Engineers

FLACK + KURTZ Inc.
475 Fifth Avenue
New York, New York 10017
212.532.9600

CROMWELL ARCHITECTS ENGINEERS


101 South Spring Street
Little Rock, Arkansas 72201
501.372.2900

Curtainwall Consultant

R.A. HEINTGES ARCHITECTS
128 Fifth Avenue, 9th Floor
New York, New York 10011
212.652-2966

Seal

7	100% CONSTRUCTION DOCS	09/27/02
6	90% PROGRESS PRINTING	08/30/02
5	SFS-12	08/20/02
4	SFS-5 (REF #104)	08/02/02
3	100% STRUCTURAL CD	07/01/02
2	100% CD MUSEUM BLDG	06/14/02
SUBSTRUCTURE PACKAGE		
1	100% STL & CONC CD	05/15/02
Issue	Date	

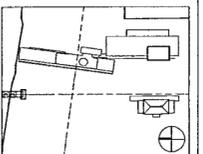


Job No. 9908

Scale 1/8"=1'-0"

Date MAY 15, 2002

Title WALL ELEVATIONS
MUSEUM BUILDING

Sheet No. S221

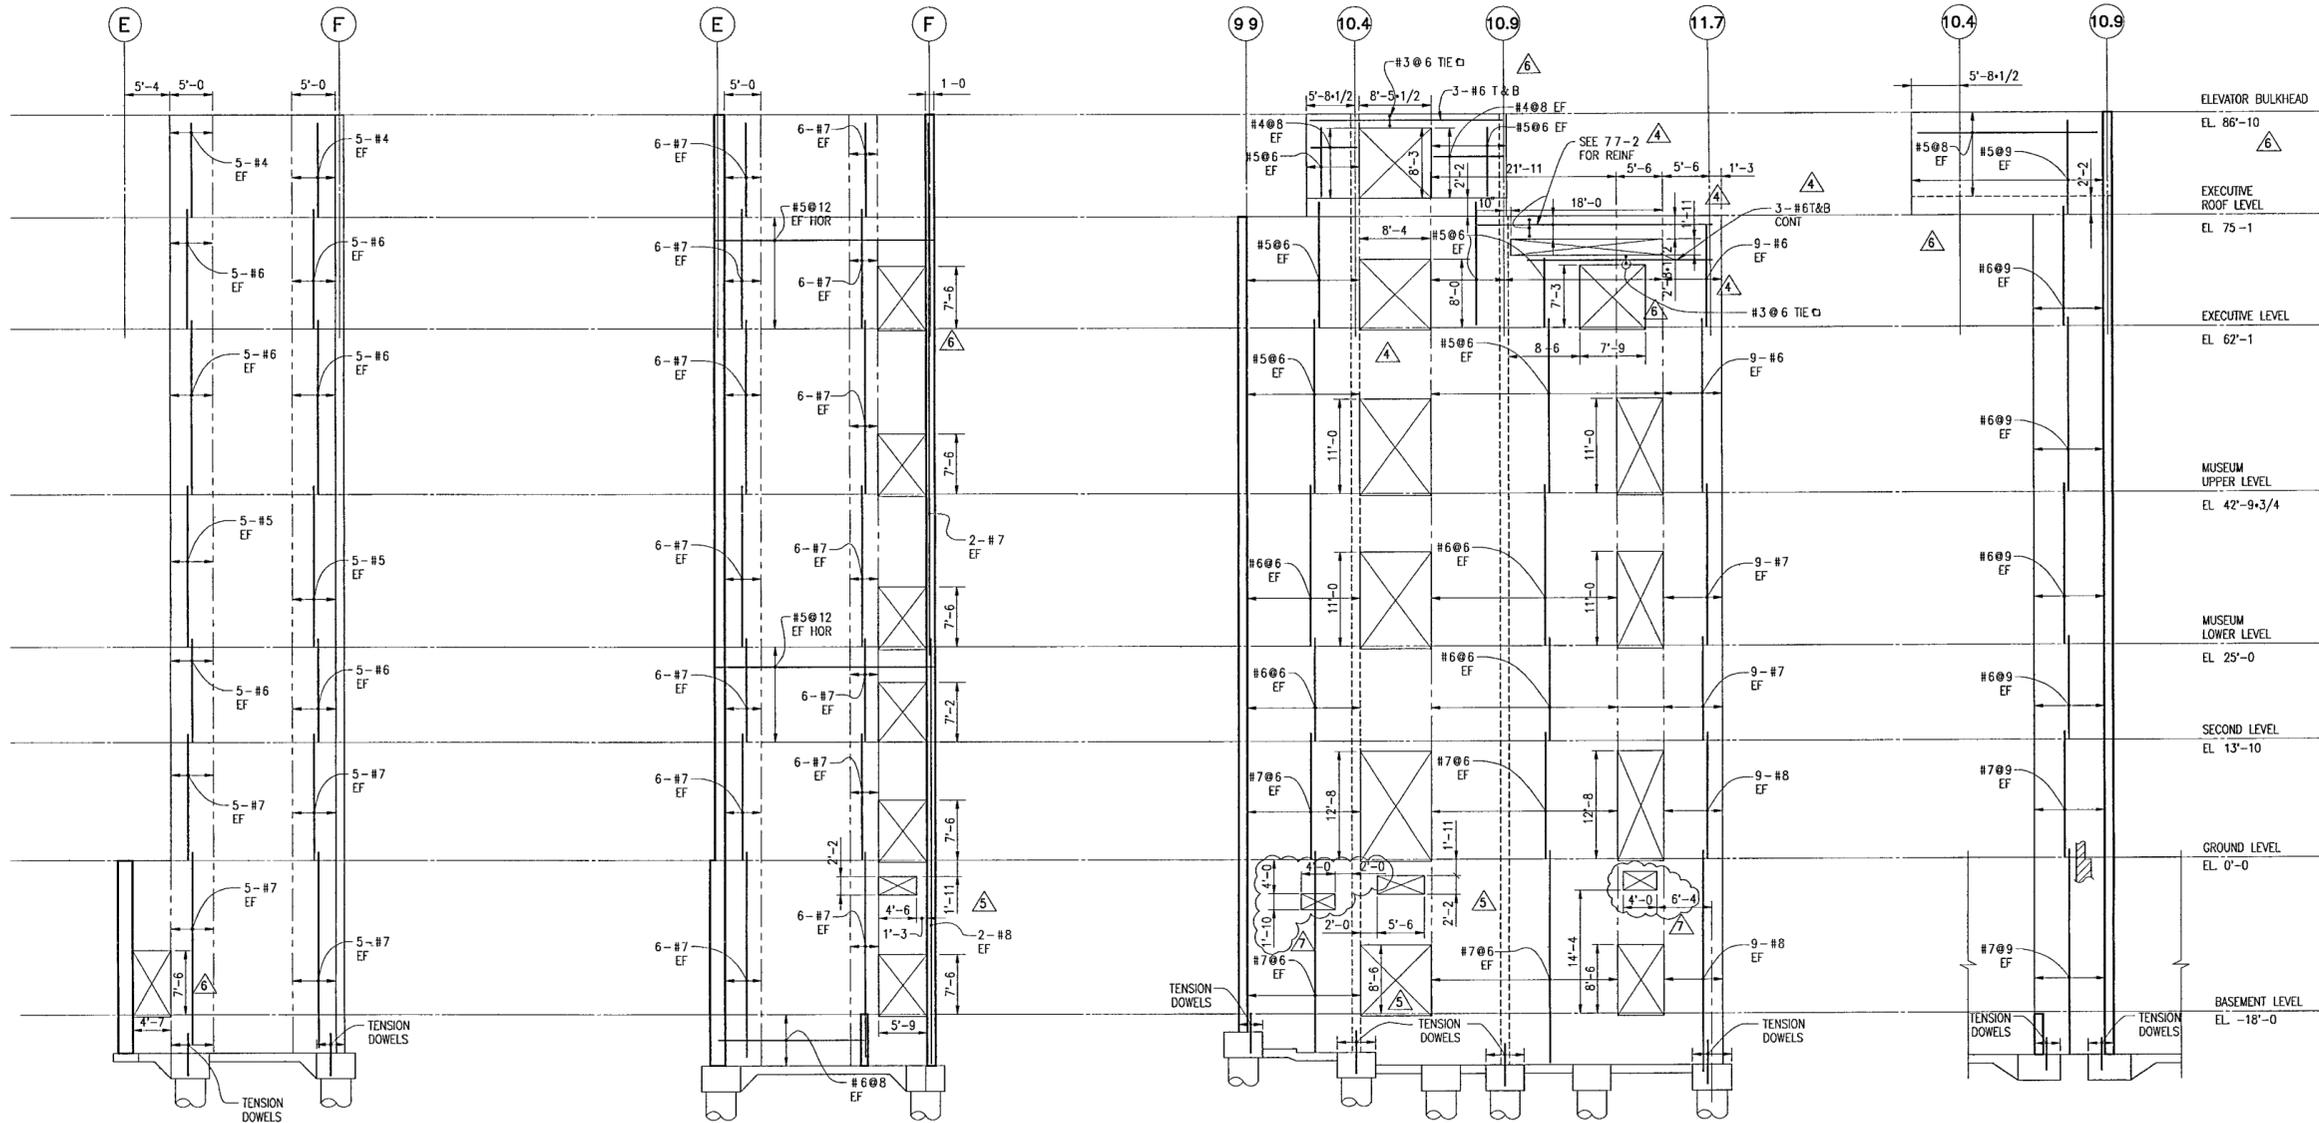

A WALL @ GRID 10.4

B WALL @ GRID 10.9

C WALL @ GRID F

D WALL @ GRID E


NOTES

- REFER TO THE STRUCTURAL DRAWING BOOK FOR GENERAL NOTES, TYPICAL DETAILS, SCHEDULES AND ALL REFERENCED DETAILS AND SECTIONS
- PROVIDE MIN VERTICAL AND HORIZONTAL REINFORCEMENTS UNLESS OTHERWISE NOTED SHOWN
- PROVIDE MIN WALL DOWELS AT WALL FOOTINGS UON
- AT COLUMN FOOTINGS AND CAISSON CAPS PROVIDE DOWELS TO MATCH WALL VERTICALS WHERE TENSION DOWELS ARE NOTED PROVIDE LD EMBEDMENT IN FOOTING OR CAP AND 1.3 LD LAP SPICE IN WALL. HOOK DOWELS IN FOOTING AS REQUIRED
- SEE SECTIONS AND DETAILS FOR REINFORCEMENT IN ELEVATOR PIT WALLS

© Copyright LESLIE E. ROBERTSON ASSOCIATES R.L.L.P.
WARNING IT IS A VIOLATION OF LAW FOR ANY PERSON UNLESS ACTING UNDER THE DIRECTION OF A PROFESSIONAL LICENSED IN THE STATE OF THIS PROJECT TO ALTER IN ANY WAY THESE DRAWINGS WHERE ANY ITEM IS ALTERED, THE SUPERVISING PROFESSIONAL SHALL AFFIX TO THE ITEM HIS SEAL AND THE INSCRIPTION "ALTERED BY" FOLLOWED BY HIS SIGNATURE, THE DATE, AND A SPECIFIC DESCRIPTION OF THE ALTERATION

Seal


Issue	Date
4	100% CONSTRUCTION DOCS 09/27/02
3	90% PROGRESS PRINTING 08/30/02
2	100% STRUCTURAL CD 07/01/02
1	100% STL & CONC CD 05/15/02

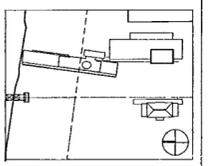


Job No.	9908
Scale	1/8"=1'-0"
Date	DEC 11, 2001
Title	WALL ELEVATIONS ARCHIVE BUILDING

Sheet No.

S222

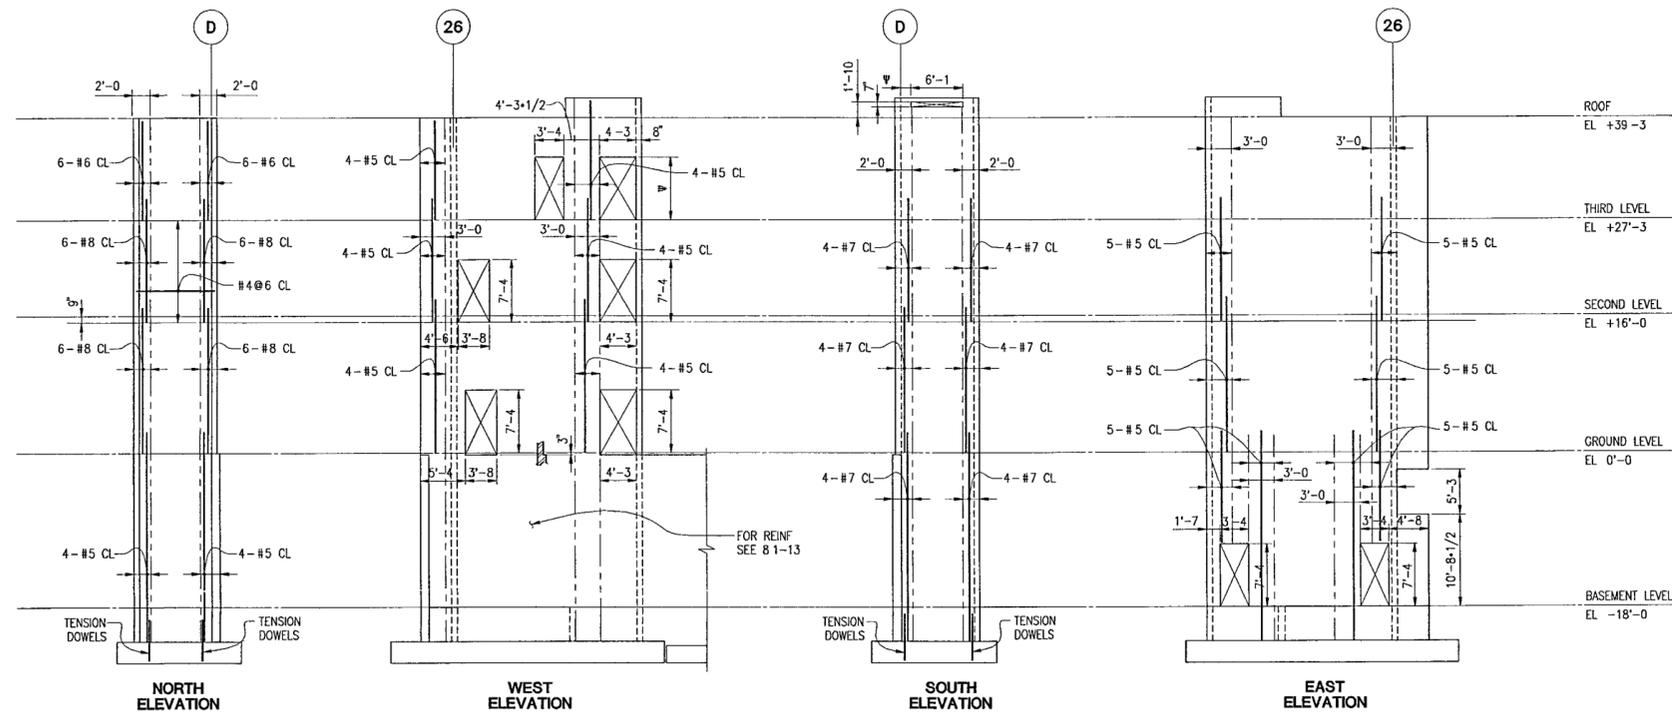

A WALL @ STAIR 10

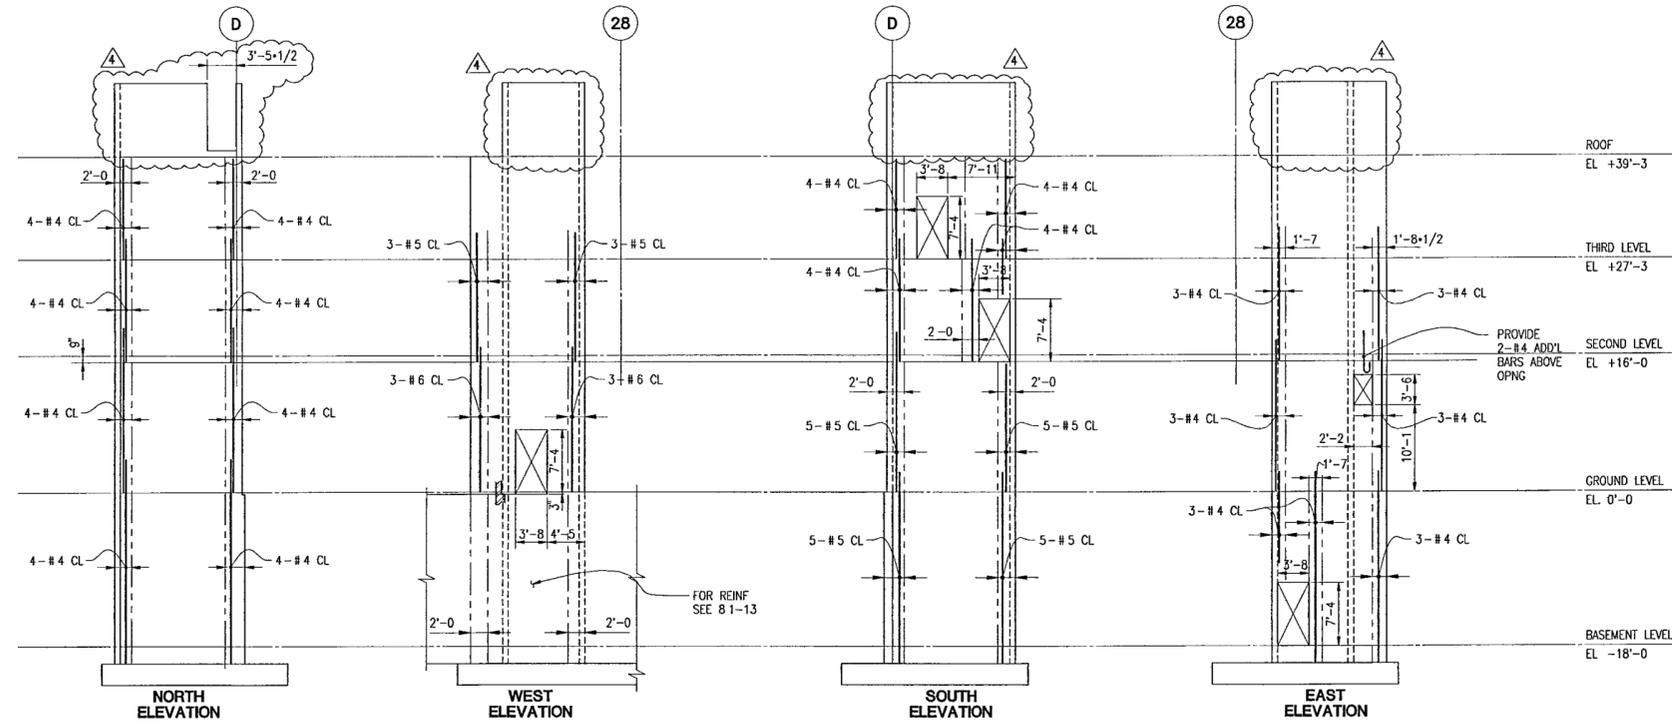

B WALL @ STAIR 11

NOTES.

- REFER TO THE STRUCTURAL DRAWING BOOK FOR GENERAL NOTES, TYPICAL DETAILS, SCHEDULES AND ALL REFERENCED DETAILS AND SECTIONS
- PROVIDE MIN VERTICAL AND HORIZONTAL REINFORCEMENTS UNLESS OTHERWISE SHOWN
- PROVIDE MIN WALL DOWELS AT WALL FOOTINGS UNON
- AT COLUMN FOOTINGS AND CAISSON CAPS PROVIDE DOWELS TO MATCH WALL VERTICALS WHERE TENSION DOWELS ARE NOTED PROVIDE LD EMBEDMENT IN FOOTING OR CAP AND 1.3 LD LAP SPLICE IN WALL HOOK DOWELS IN FOOTING AS REQUIRED
- SEE SECTIONS AND DETAILS FOR REINFORCEMENT IN ELEVATOR PIT WALLS

© Copyright LESLIE E. ROBERTSON ASSOCIATES, RLLP
WARNING IT IS A VIOLATION OF LAW FOR ANY PERSON UNLESS ACTING UNDER THE DIRECTION OF A PROFESSIONAL LICENSED IN THE STATE OF THIS PROJECT, TO ALTER IN ANY WAY THESE DRAWINGS WHERE ANY ITEM IS ALTERED. THE SUPERVISING PROFESSIONAL SHALL AFFIX TO THE ITEM HIS SEAL AND THE INSCRIPTION "ALTERED BY" FOLLOWED BY HIS SIGNATURE, THE DATE, AND A SPECIFIC DESCRIPTION OF THE ALTERATION.

**WILLIAM J CLINTON
PRESIDENTIAL
CENTER**

LITTLE ROCK, ARKANSAS

Architect

POLSHEK PARTNERSHIP LLP
320 West 13th Street
New York, New York 10014
212 607 7171

Coordinating Architects

POLK STANLEY YEARY ARCHITECTS Ltd
700 South Schiller Street
Little Rock, Arkansas 72201
501.378.0878

WITSELL EVANS RASCO
901 West Third Street
Little Rock, Arkansas 72201
501.374.5300

WOODS CARADINE ARCHITECTS
2200 South Main Street
Little Rock, Arkansas 72206
501.374.4060

Landscape Architects

HARGREAVES ASSOCIATES
118 Magazine Street
Cambridge, Massachusetts 02139
617 661 0070

LANDSCAPE ARCHITECTURE, Inc.
2300 Cottondale Lane Suite 202
Little Rock, Arkansas 72202
501.374.5610

Structural Engineer

LESLIE E. ROBERTSON ASSOC., RLLP
30 Broad Street, 4th Floor
New York, New York 10004
212 750 9000

MEP Engineers

FLACK + KURTZ Inc.
475 Fifth Avenue
New York, New York 10017
212 632 9600

CROMWELL ARCHITECTS ENGINEERS
101 South Spring Street
Little Rock, Arkansas 72201
501.372.2900

Curtainwall Consultant


R. A. HEINTGES ARCHITECTS
126 Fifth Avenue 9th Floor
New York, New York 10011
212 652-2966

Seal

NOTES

- REFER TO THE STRUCTURAL DRAWING BOOK FOR GENERAL NOTES, TYPICAL DETAILS, SCHEDULES AND ALL REFERENCED DETAILS AND SECTIONS
- PROVIDE MIN VERTICAL AND HORIZONTAL REINFORCEMENT UNLESS OTHERWISE SHOWN
- PROVIDE MIN WALL DOWELS AT WALL FOOTINGS UNON
- AT COLUMN FOOTINGS AND CAISSON CAPS PROVIDE DOWELS TO MATCH WALL VERTICALS WHERE TENSION DOWELS ARE NOTED PROVIDE LD EMBEDMENT IN FOOTING OR CAP AND 1 3 LD LAP SPLICE IN WALL HOOK DOWELS IN FOOTING AS REQUIRED
- SEE SECTIONS AND DETAILS FOR REINFORCEMENT IN ELEVATOR PIT WALLS

Issue	Date
4	100% CONSTRUCTION DOCS 09/27/02
3	90% PROGRESS PRINTING 08/30/02
2	100% STRUCTURAL CD 07/01/02
1	100% STL & CONC CD 05/15/02

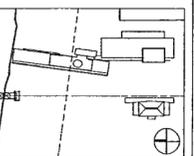





Job No. 9808

Scale 1/8"=1'-0"

Date MAY 15, 2001

Title WALL ELEVATIONS ARCHIVE BUILDING

Sheet No. S223

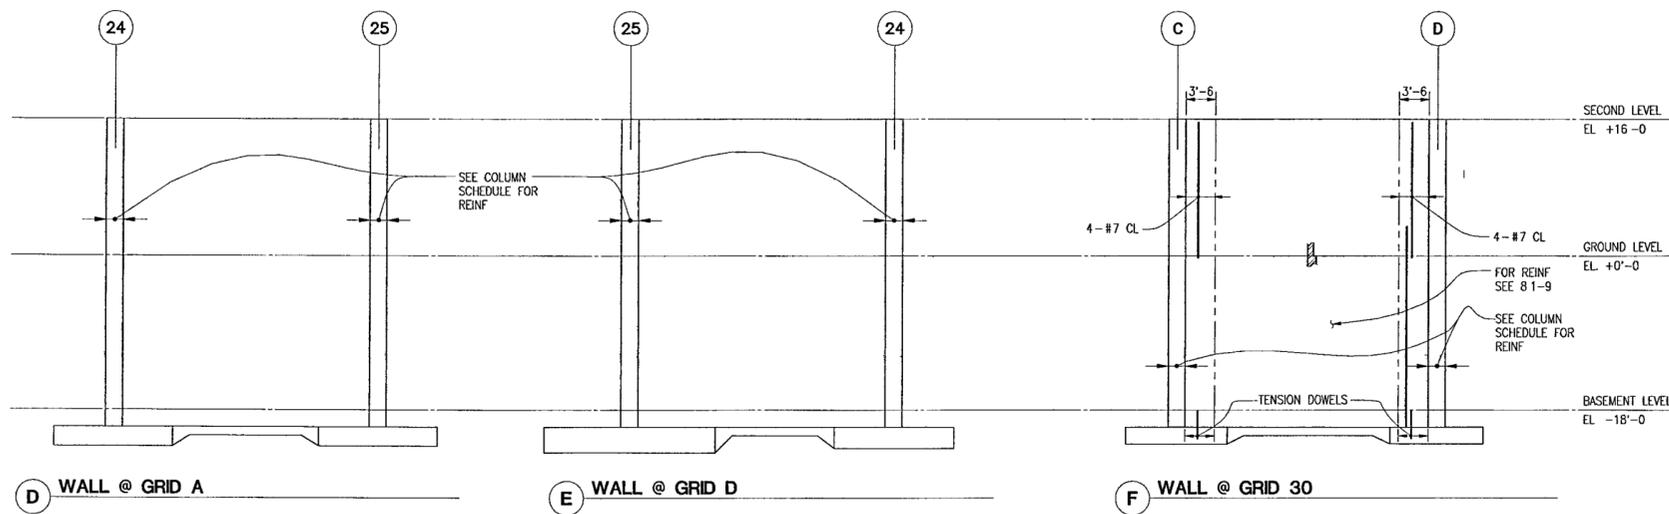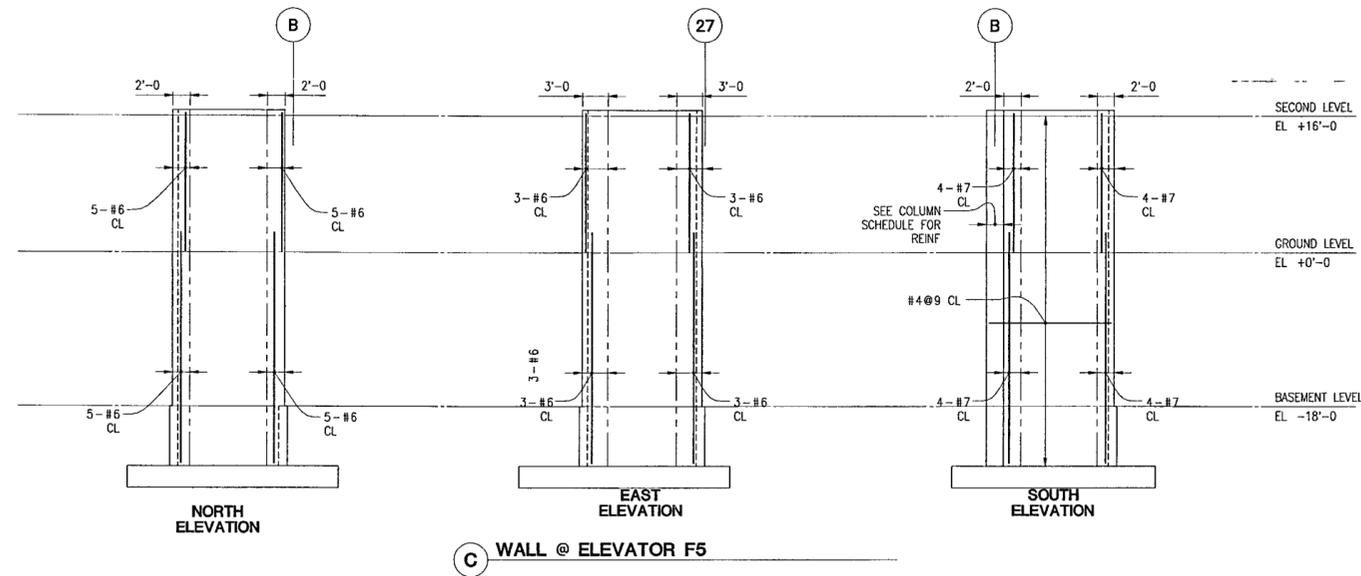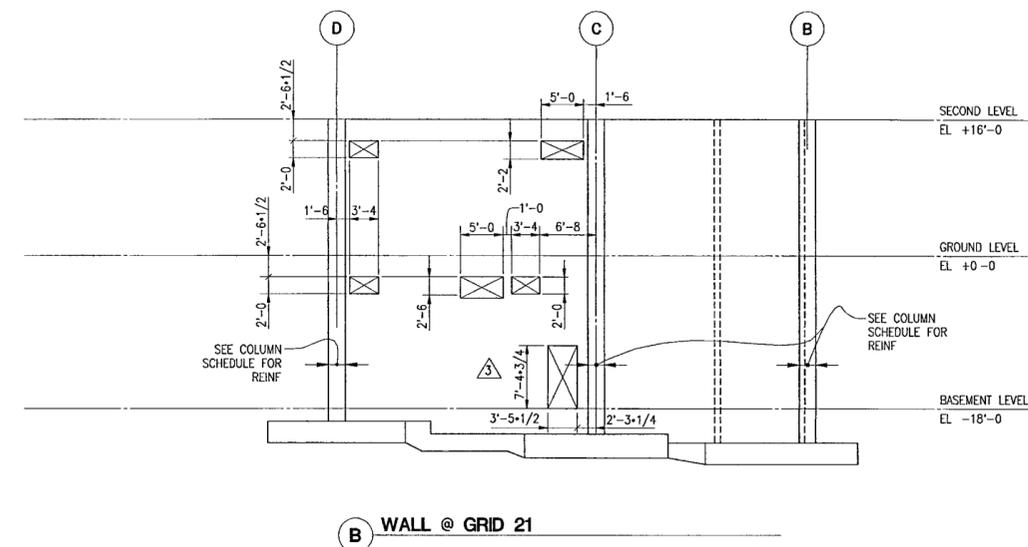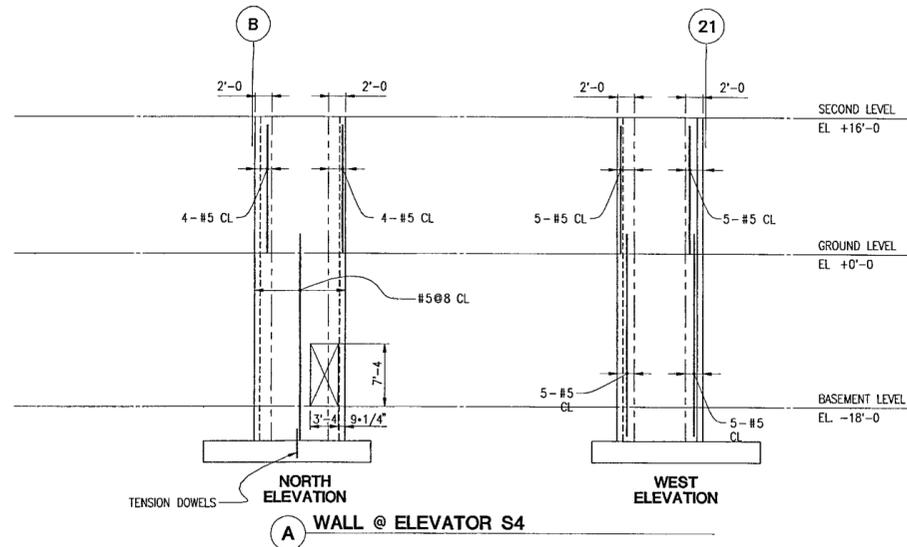

© Copyright LESLIE E. ROBERTSON ASSOCIATES RLLP

WARNING IT IS A VIOLATION OF LAW FOR ANY PERSON, UNLESS ACTING UNDER THE DIRECTION OF A PROFESSIONAL, LICENSED IN THE STATE OF THIS PROJECT, TO ALTER IN ANY WAY THESE DRAWINGS WHERE ANY ITEM IS ALTERED, THE SUPERVISING PROFESSIONAL SHALL AFFIX TO THE ITEM HIS SEAL AND THE INSCRIPTION "ALTERED BY FOLLOWED BY HIS SIGNATURE, THE DATE, AND A SPECIFIC DESCRIPTION OF THE ALTERATION"

**WILLIAM J CLINTON
PRESIDENTIAL
CENTER**

LITTLE ROCK, ARKANSAS

Architect
POLSKHEK PARTNERSHIP LLP
320 West 13th Street
New York, New York 10014
212.807.7171

Coordinating Architects
POLK STANLEY YEARY ARCHITECTS Ltd
700 South Schiller Street
Little Rock, Arkansas 72201
501.378.0878

WITSELL EVANS RASCO
501 West Third Street
Little Rock, Arkansas 72201
501.374.5300

WOODS CARADINE ARCHITECTS
2200 South Main Street
Little Rock, Arkansas 72206
501.374.4060

Landscape Architects
HARGREAVES ASSOCIATES
118 Magazine Street
Cambridge, Massachusetts 02139
617.861.0070

LANDSCAPE ARCHITECTURE, Inc.
2300 Cottontail Lane Suite 202
Little Rock, Arkansas 72202
501.374.5610

Structural Engineer
LESLIE E. ROBERTSON ASSOC., RLLP
30 Broad Street, 47th Floor
New York, New York 10004
212.750.9000


MEP Engineers
FLACK + KURTZ Inc.
475 Fifth Avenue
New York, New York 10017
212.532.9600

CRAMNELL ARCHITECTS ENGINEERS
101 South Spring Street
Little Rock, Arkansas 72201
501.372.2900

Curtainwall Consultant
R. A. HEINTGES ARCHITECTS
126 Fifth Avenue, 8th Floor
New York, New York 10011
212.652-2968




100% Construction Documents	09/27/02
90% Progress Printing	06/30/02
100% Struct./CD Progress	07/01/02
Bridge Bldg. Substructure	06/14/02
100% Steel & Concrete CD	06/15/02
& Architectural CD Progress	
Issue	Date
*Issued originally as A710	

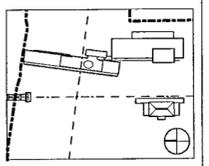

Job No. 9908
Scale 1/4" = 1'-0"
Date September 27, 2002
Title

STAIR 4 SHEAR WALL ELEVATIONS

Sheet No. **S220.1**

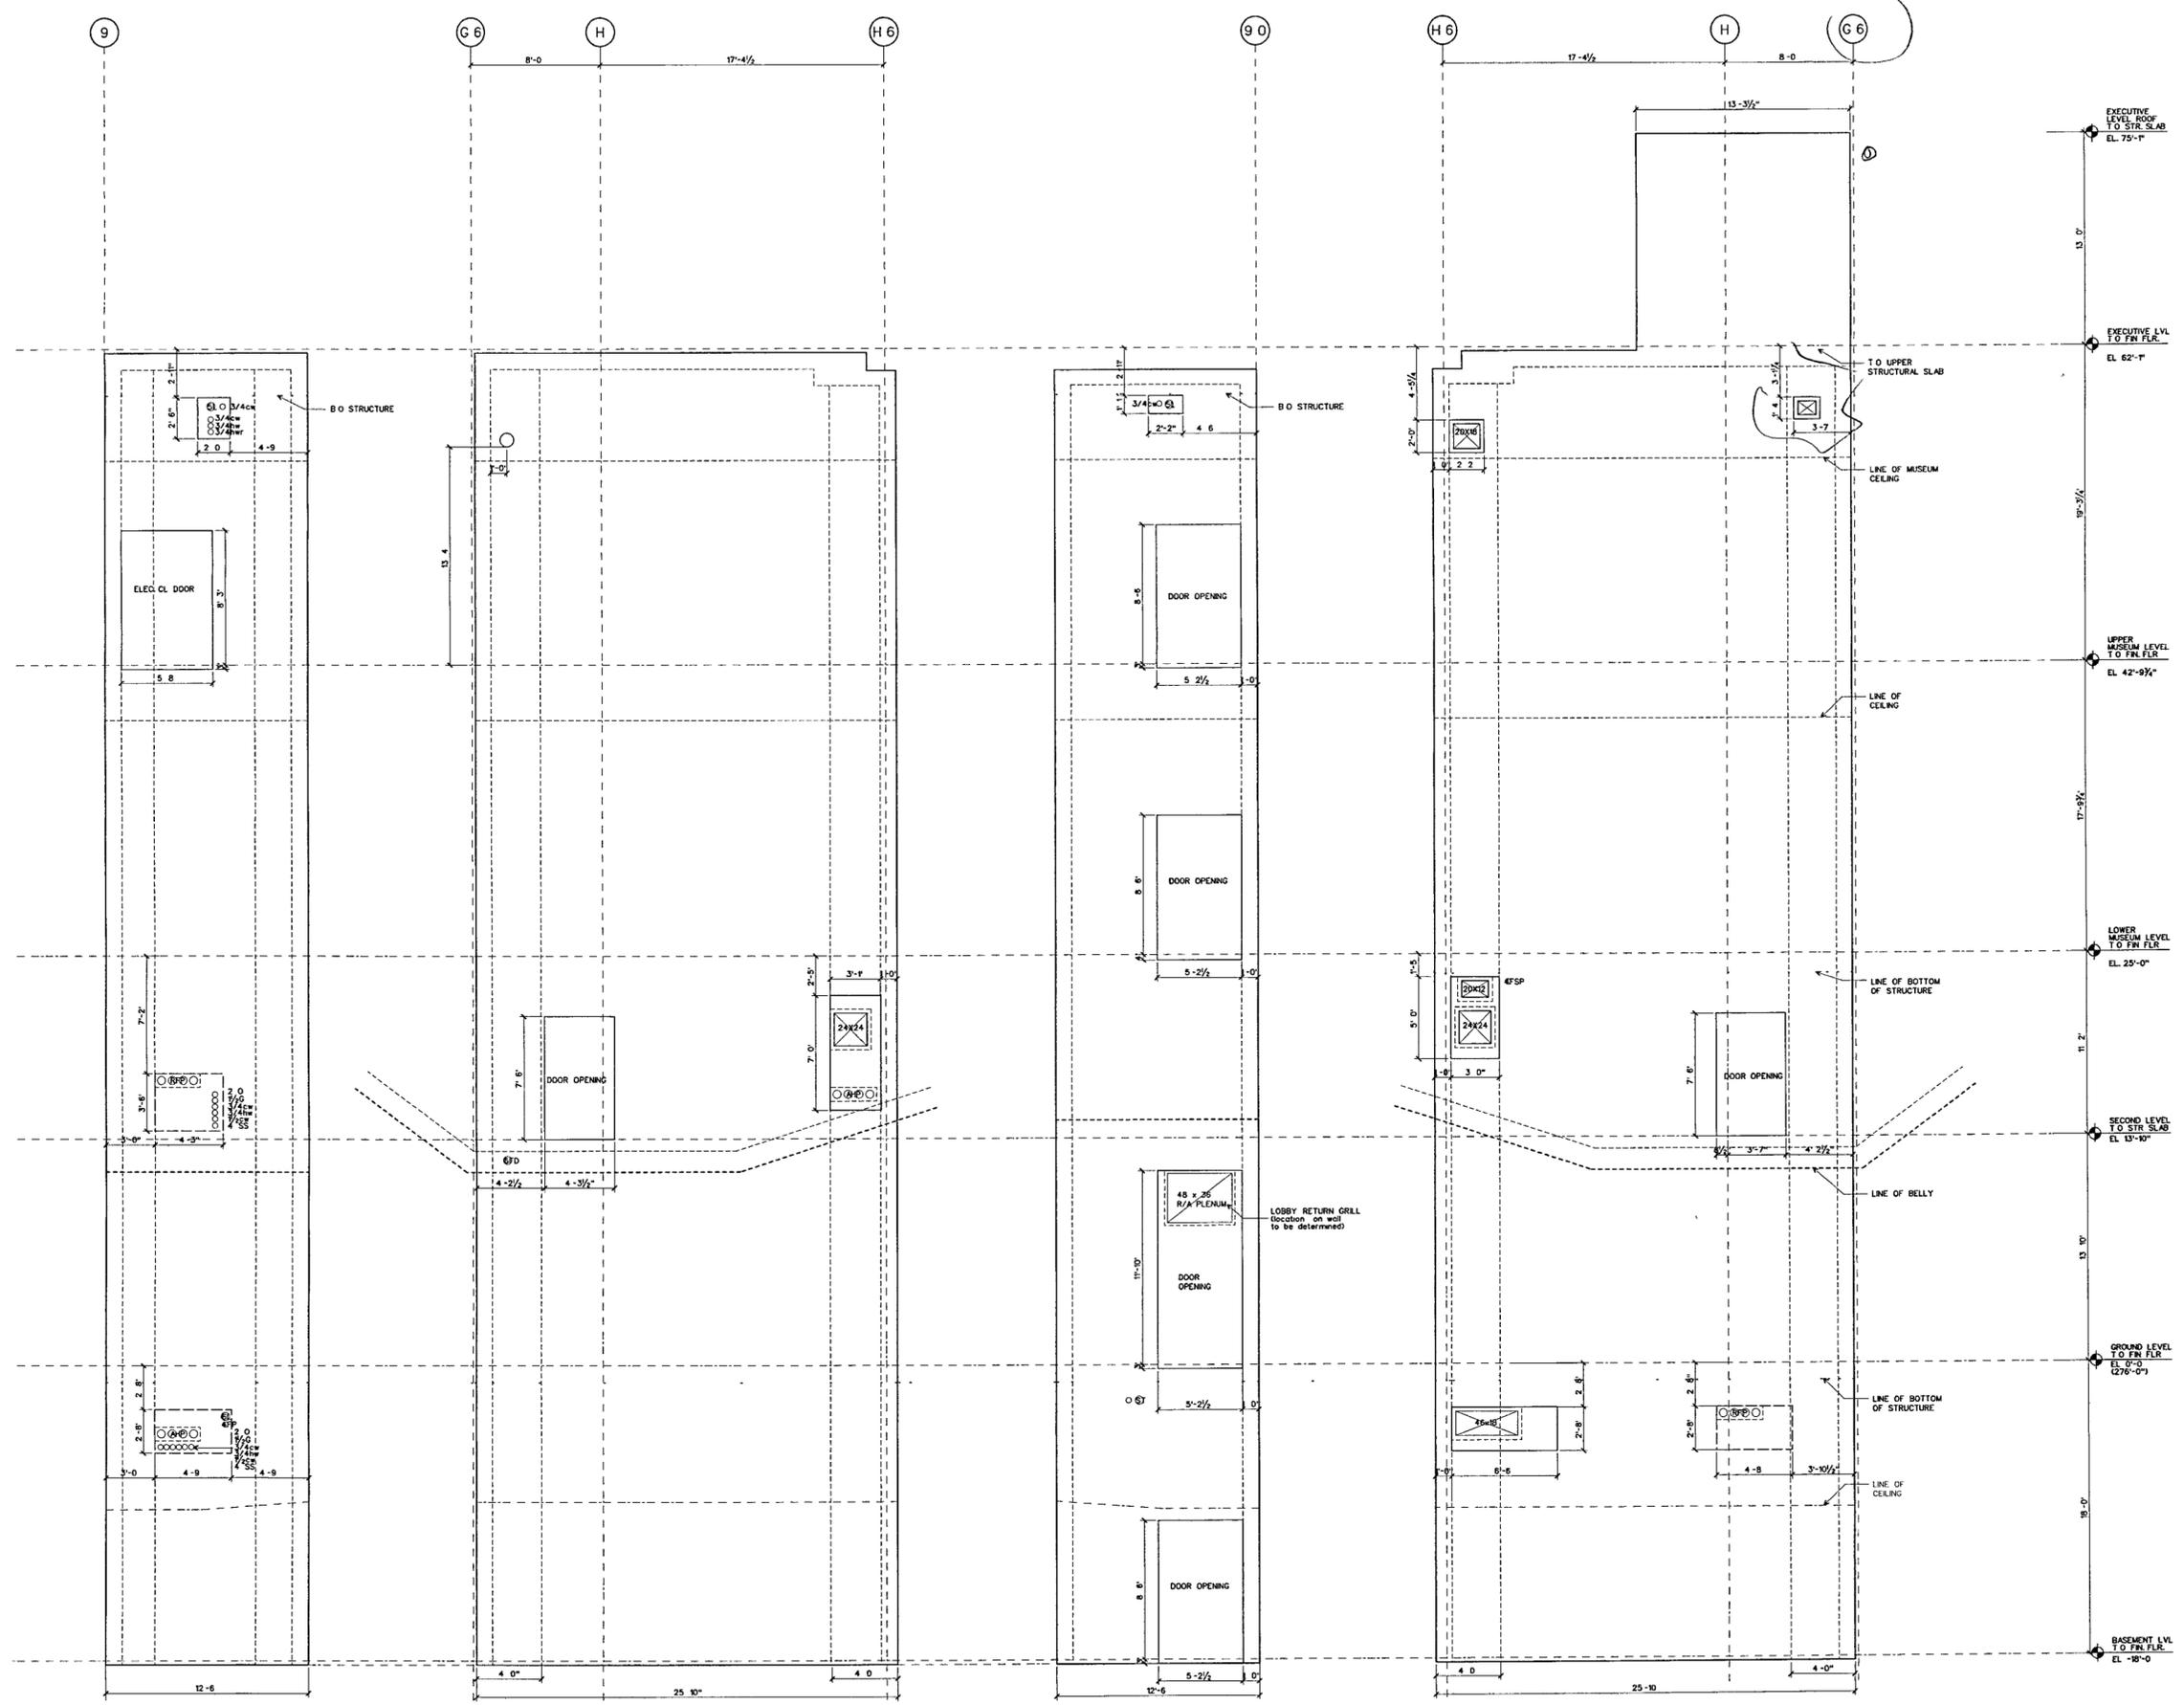


EAST WALL ELEVATION
SCALE 1/4" = 1'-0" PLANS/STAR 4 **10**

NORTH WALL ELEVATION
SCALE 1/4" = 1'-0" PLANS/STAR 4 **13**

WEST WALL ELEVATION
SCALE 1/4" = 1'-0" PLANS/STAR 4 **12**

SOUTH WALL ELEVATION
SCALE 1/4" = 1'-0" PLANS/STAR 4 **11**

FOR OFFICIAL USE ONLY

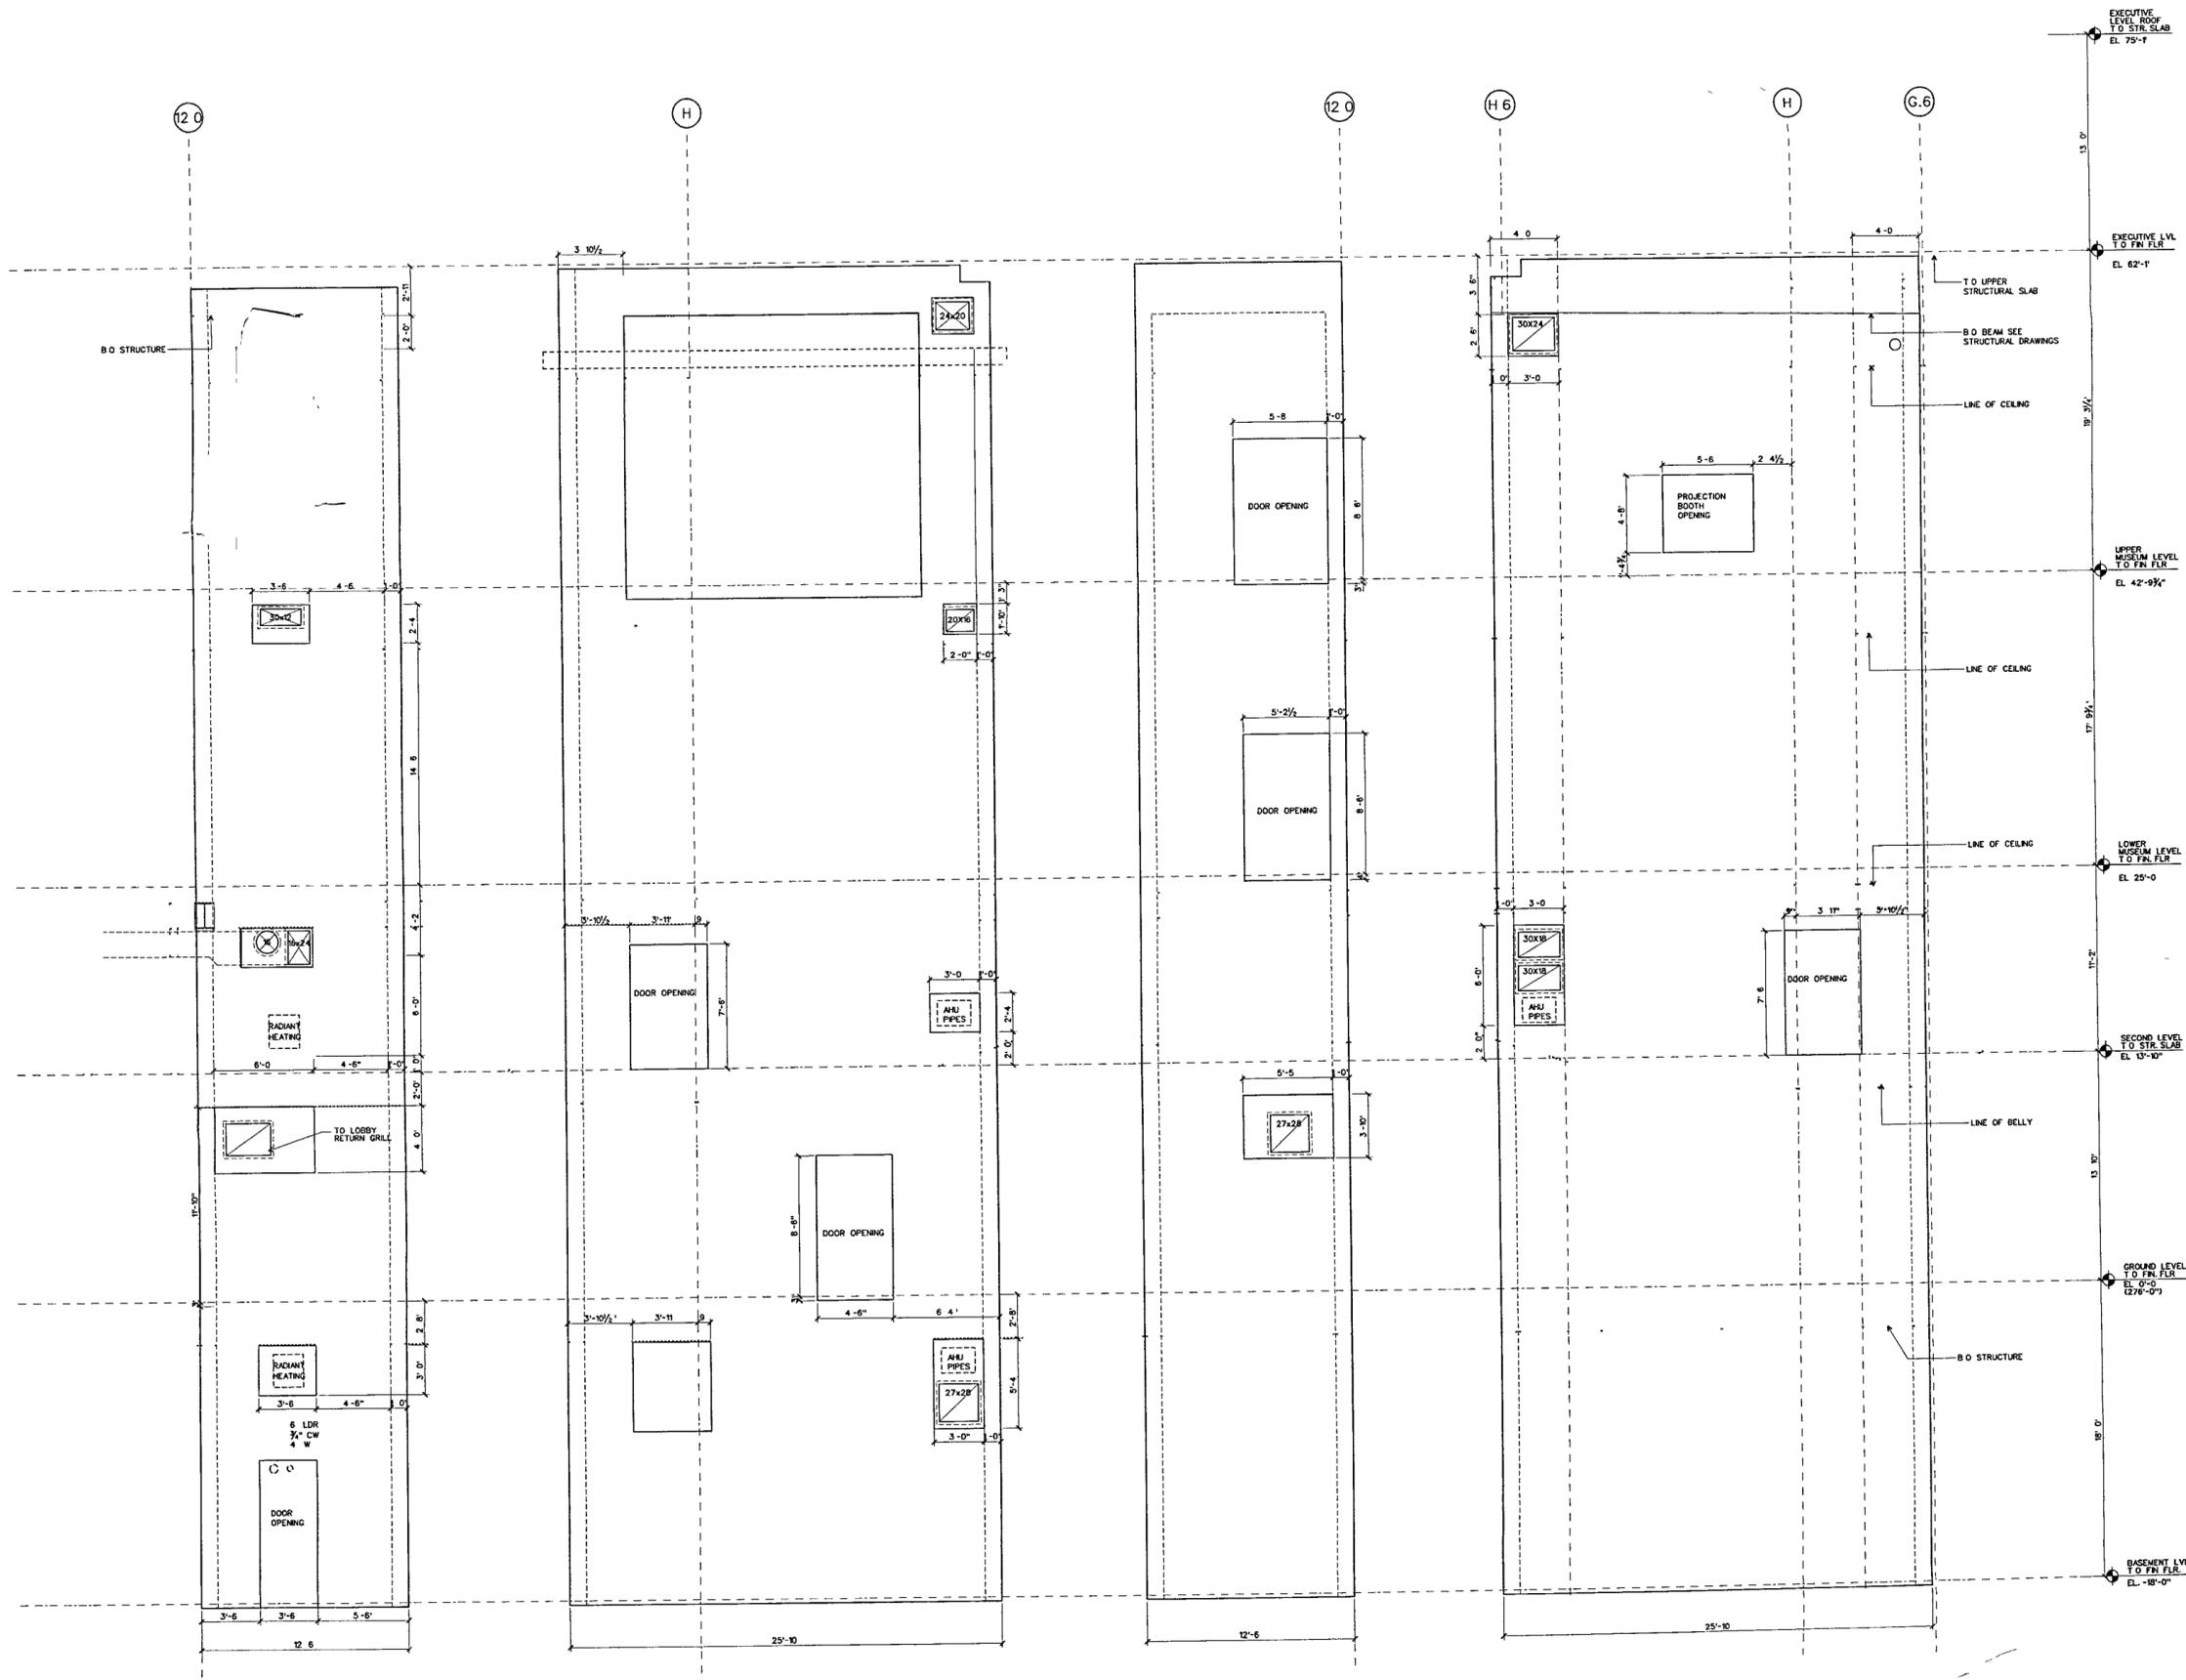

EAST ELEVATION
SCALE 1/4" = 1'-0"
PLANS/STAR 5 13

NORTH ELEVATION
SCALE 1/4" = 1'-0"
PLANS/STAR 5 12

WEST ELEVATION
SCALE 1/4" = 1'-0"
PLANS/STAR 5 11

SOUTH ELEVATION
SCALE 1/4" = 1'-0"
PLANS/STAR 5 10

LITTLE ROCK, ARKANSAS

Architect
POLISHEK PARTNERSHIP L.P.
320 West 13th Street
New York, New York 10014
212 607 7171

Coordinating Architects
POLK STANLEY YEARY ARCHITECTS LTD
700 South Schaller Street
Little Rock, Arkansas 72201
501 378 0878

WITSELL EVANS RASCO
901 West Third Street
Little Rock, Arkansas 72201
501 374 5300

WOODS CARADINE ARCHITECTS
2200 South Main Street
Little Rock, Arkansas 72208
501 374 4060

Landscape Architects
HARGREAVES ASSOCIATES
118 Magazine Street
Cambridge, Massachusetts 02139
617 661 0070


LANDSCAPE ARCHITECTURE Inc.
2300 C-Island Lane Suite 202
Little Rock, Arkansas 72202
501 374 5610

Structural Engineer
LESLIE E. ROBERTSON ASSOC. P.L.L.C.
30 Broad Street, 47th Floor
New York, New York 10004
212 750 9000


MEP Engineers
FLACK + KURTZ Inc.
475 Fifth Avenue
New York, New York 10017
212 632 9600

CRAMWELL ARCHITECTS ENGINEERS
101 South Spring Street
Little Rock, Arkansas 72201
501 372-2900

Curtainwall Consultant
R. A. HEINTGES ARCHITECTS
128 Fifth Avenue 9th Floor
New York, New York 10011
212 652-2968

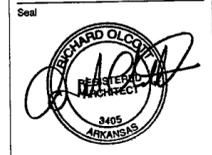

100% Construction Documents	09/27/02
90% Progress Printing	08/30/02
100% Struct/CD Progress	07/01/02
Bridge Bldg Substructure	09/14/02
100% Steel & Concrete CD	05/15/02
& Architectural CD Progress	
Issue	Date
*Issued originally as A711	

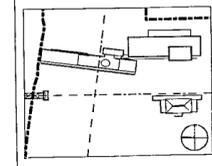

Job No. 9902
Scale 1/4" = 1'-0"
Date September 27, 2002
Title

STAIR 5
SHEAR WALL
ELEVATION
Sheet No. S220

OFFICIAL USE