


100% PLUMBING
CONSTRUCTION DRAWINGS
ISSUE - JULY 1, 2002

Seal



Issue	Date
100% Construction Documents	06/27/02
90% Progress Printing	06/30/02
General Revision: ASI #3	9 Aug 02
Plumbing Contract Documents	07/01/02

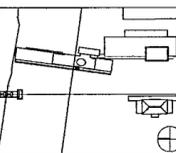

Job No: POLSHEK & PARTNERS ARCH 9908
CROMWELL AE 99-114

Scale:

Date:

JULY 01 2002


Title:

ENLARGED
BASEMENT
KITCHEN PLAN

Sheet No:

P201

FOR OFFICIAL USE ONLY

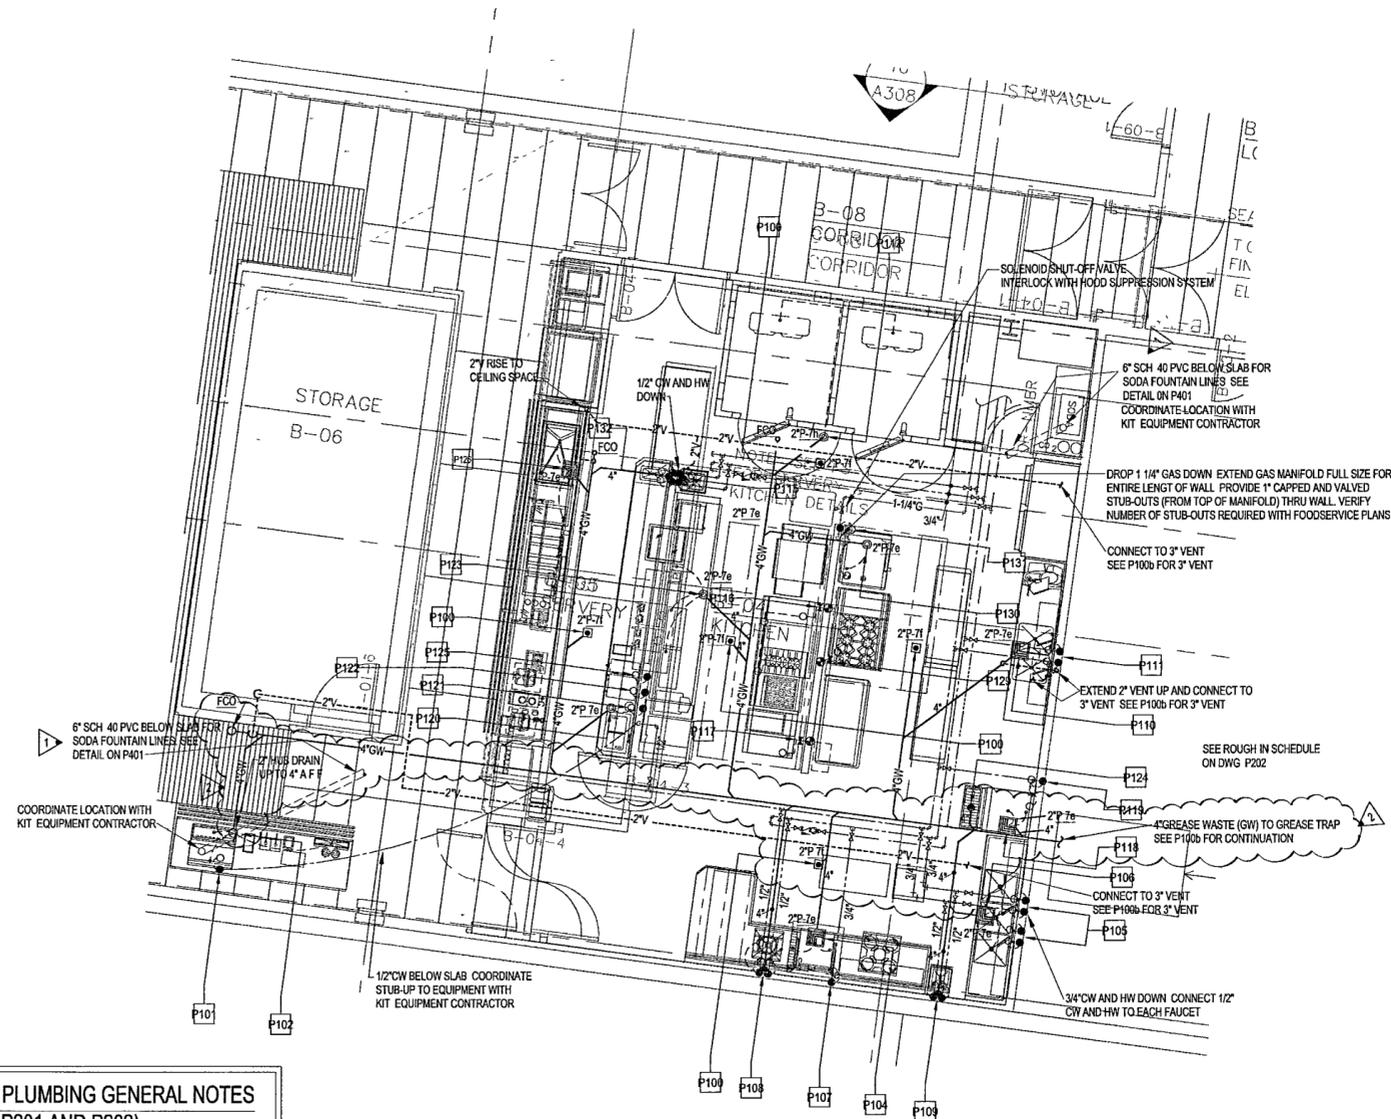

**KITCHEN EQUIPMENT PLUMBING GENERAL NOTES
(TYPICAL FOR DWGS P201 AND P202)**

- 1 PLUMBING CONTRACTOR TO PROVIDE FINAL CONNECTIONS TO ALL KITCHEN EQUIPMENT ITEMS PER LOCAL, STATE AND NATIONAL PLUMBING CODES
- 2 PLUMBING CONTRACTOR TO VERIFY REQUIREMENTS OF ALL KITCHEN EQUIPMENT ITEMS PROVIDED BY OTHERS BEFORE ROUGHING IN AND MAKING FINAL CONNECTIONS
- 3 PLUMBING CONTRACTOR TO FURNISH AND INSTALL ALL SHUT-OFF VALVES, SHOCK ABSORBERS, SNAP ACTION VALVES, TRIM, TRAPS, ETC. REQUIRED FOR FINAL CONNECTION TO OUTLETS
- 4 PLUMBING CONTRACTOR TO FURNISH, INSTALL AND CONNECT ALL WATER, DRAIN, INDIRECT DRAIN LINES, ETC. FOR ALL KITCHEN EQUIPMENT
- 5 PLUMBING CONTRACTOR TO FLUSH ALL LINES BEFORE MAKING FINAL CONNECTIONS
- 6 REFER TO FOODSERVICE PLANS FOR ROUGH IN CONNECTIONS

1 BASEMENT KITCHEN ENLARGED PLAN
P101b | P202 1/4" = 1'-0" NORTH

