

**POLK
STANLEY
YEARY
ARCHITECTS, LTD.**

700 SOUTH SCHILLER
LITTLE ROCK, AR 72201
501.378-0878
FAX 372-7629

21 W. MOUNTAIN, SUITE 227
FAYETTEVILLE, AR 72701
479-444-0473

CONSULTANTS:

OWNER'S PROJECT ADVISOR:
MOSES TUCKER REAL ESTATE, INC.

CIVIL ENGINEER:
McCLELLAND ENGINEERS

LANDSCAPE ARCHITECT:
LARSON BURNS SMITH

STRUCTURAL ENGINEER:
CROMWELL ENGINEERS INC.

MECH. ELEC. PLUMB. ENGINEER:
CROMWELL ENGINEERS INC.

SUSTAINABLE CONSULTANT:
BNIM / ELEMENTS

GLOBAL VILLAGE CONSULTANT
CAMBRIDGE SEVEN ASSOCIATES

INTERIOR DESIGNER:
POLK STANLEY YEARY

GENERAL CONTRACTOR:
CDI

GENERAL NOTES:

NOTES:

ISSUE DATE:
DECEMBER 15, 2003
CORE/SHELL
PACKAGE #5

REVISIONS:


#	DATE	DESCRIPTION
1	1/16/04	ADDENDUM #1
2	7/01/04	PACKAGE 7, 100% ROLLUP
3	10/12/04	ASI #20
4	11/29/04	ASI #27

**HEIFER
INTERNATIONAL
CENTER
OFFICE BUILDING**
LITTLE ROCK, ARKANSAS

PSY PROJECT NUMBER:
431C

CONTENTS:
FIRST FLOOR LIGHTING
PLAN - EAST END
SHEET NUMBER:

E101a

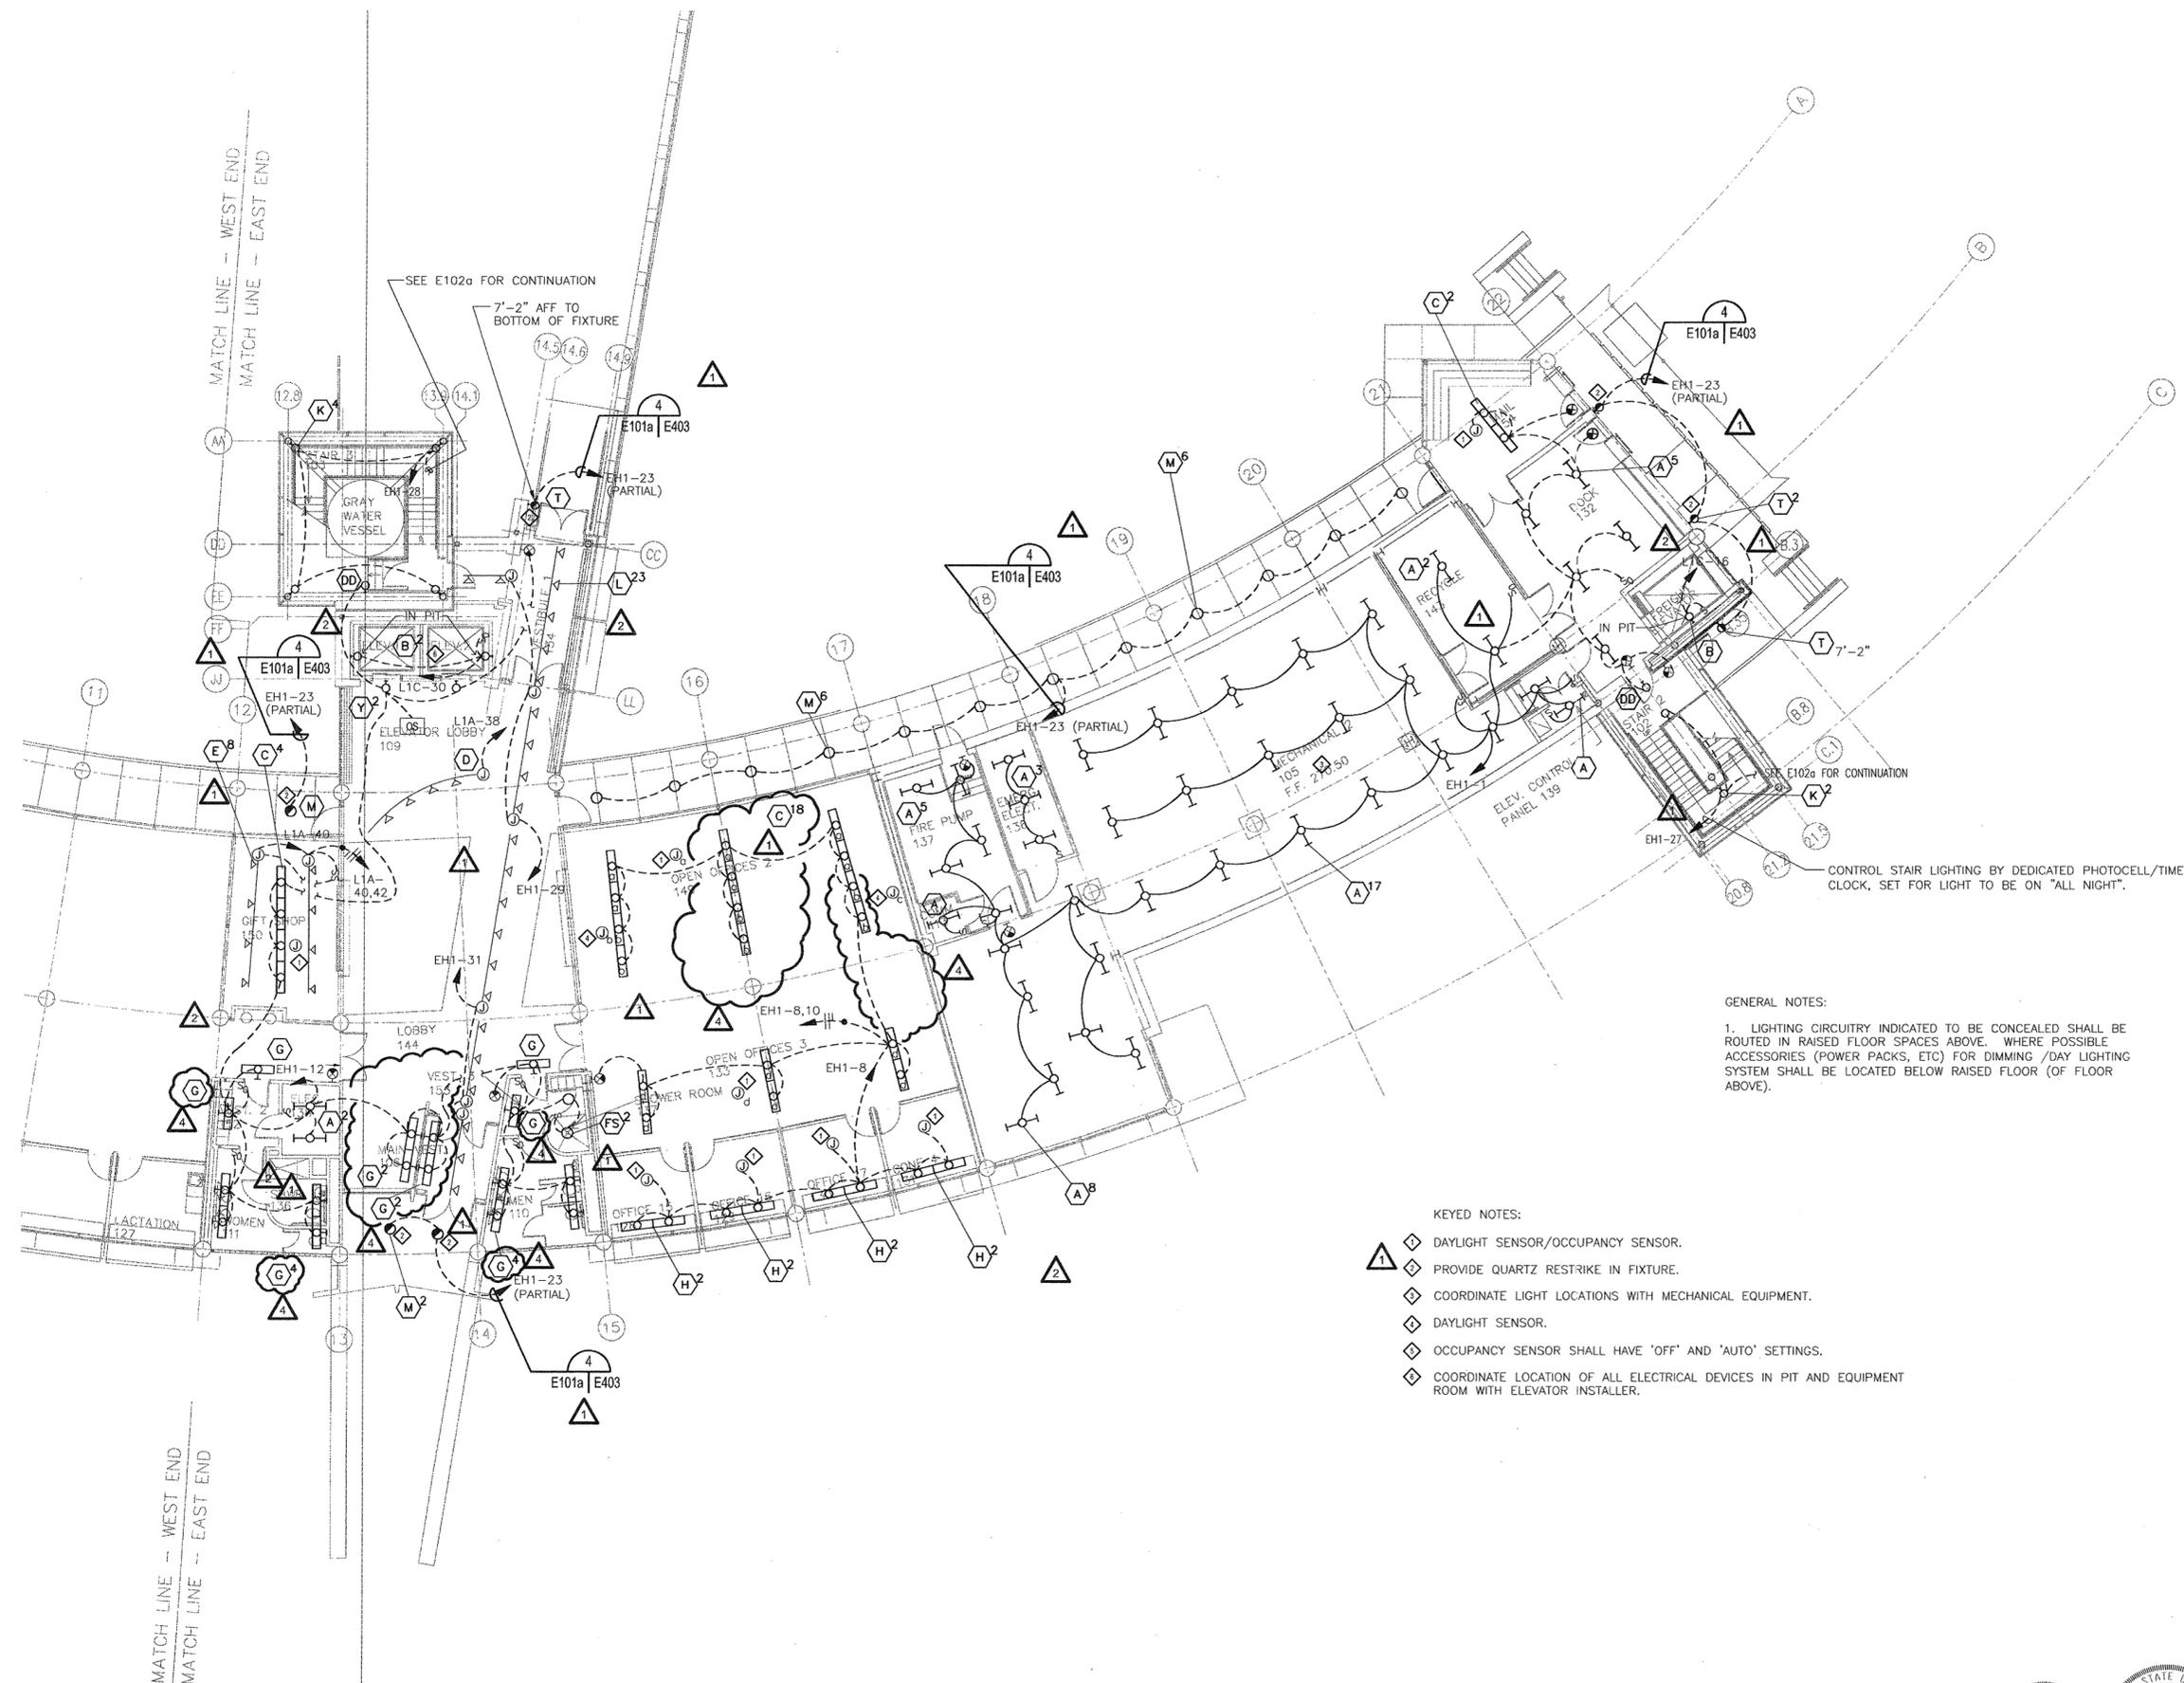

GENERAL NOTES:
1. LIGHTING CIRCUITRY INDICATED TO BE CONCEALED SHALL BE ROUTED IN RAISED FLOOR SPACES ABOVE. WHERE POSSIBLE ACCESSORIES (POWER PACKS, ETC) FOR DIMMING /DAY LIGHTING SYSTEM SHALL BE LOCATED BELOW RAISED FLOOR (OF FLOOR ABOVE).

- KEYED NOTES:**
- ◇ DAYLIGHT SENSOR/OCCUPANCY SENSOR.
 - ◇ PROVIDE QUARTZ RESTRIKE IN FIXTURE.
 - ◇ COORDINATE LIGHT LOCATIONS WITH MECHANICAL EQUIPMENT.
 - ◇ DAYLIGHT SENSOR.
 - ◇ OCCUPANCY SENSOR SHALL HAVE 'OFF' AND 'AUTO' SETTINGS.
 - ◇ COORDINATE LOCATION OF ALL ELECTRICAL DEVICES IN PIT AND EQUIPMENT ROOM WITH ELEVATOR INSTALLER.

1 FIRST FLOOR LIGHTING PLAN - EAST END
SCALE: 1/8" = 1'-0"

