

CONSULTANTS:
 OWNER'S PROJECT ADVISOR:
 MOSES TUCKER REAL ESTATE, INC.
 CIVIL ENGINEER:
 McCLELLAND ENGINEERS
 LANDSCAPE ARCHITECT:
 LARSON BURNS SMITH
 STRUCTURAL ENGINEER:
 CROMWELL ENGINEERS INC.
 MECH., ELEC., PLUMB. ENGINEER:
 CROMWELL ENGINEERS INC.
 SUSTAINABLE CONSULTANT:
 BNIM / ELEMENTS
 GLOBAL VILLAGE CONSULTANT
 CAMBRIDGE SEVEN ASSOCIATES
 INTERIOR DESIGNER:
 POLK STANLEY YEARY
 GENERAL CONTRACTOR:
 CDI

GENERAL NOTES:

NOTES:


ISSUE DATE:
 NOVEMBER 17, 2003
STRUCTURAL FOUNDATION PACKAGE #4
REVISIONS:

#	DATE	DESCRIPTION
1	01/19/2004	PACKAGE 4 - ADDM 04
2	02/26/2004	PACKAGE 4 - ADDM 05
3	03/17/2004	PACKAGE 4 - ADDM 06
4	03/23/2004	PACKAGE 4 - ADDM 07
5	06/12/2004	ASI #2
6	08/26/2004	ASI #17


HEIFER INTERNATIONAL CENTER OFFICE BUILDING
 LITTLE ROCK, ARKANSAS

PSY PROJECT NUMBER:
 431C


CONTENTS:
 SLAB AND FOUNDATION DETAILS
SHEET NUMBER:
S400

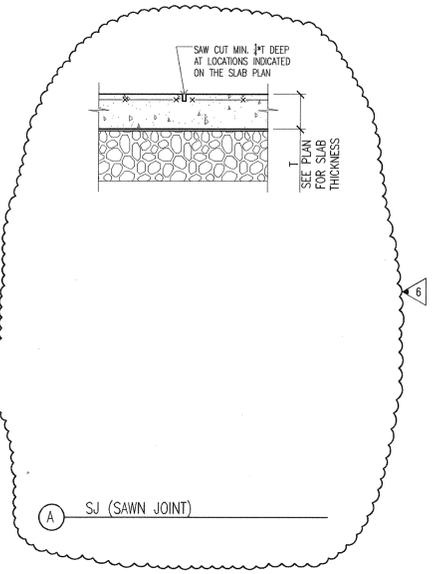


1 TYPICAL SECTIONS AT SLAB ON GRADE
 NOT TO SCALE

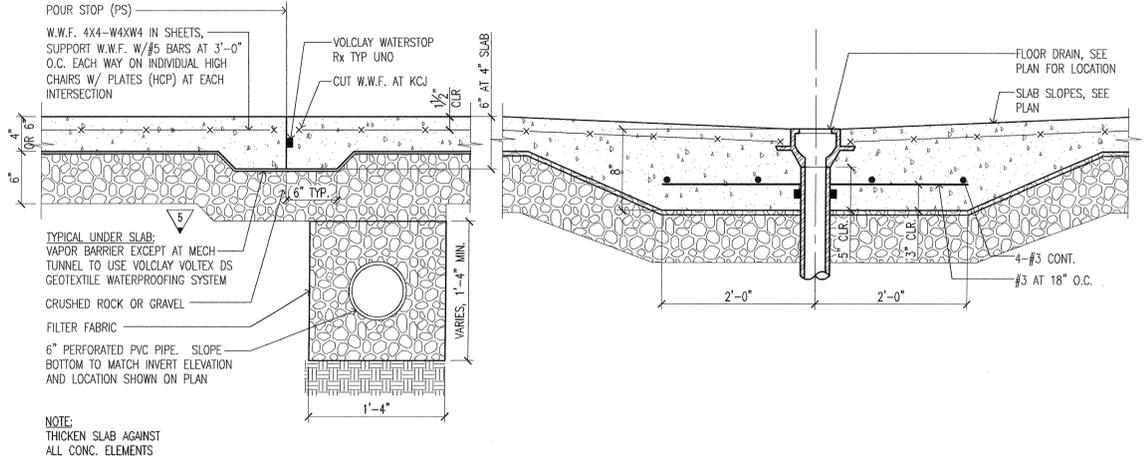


B DRAINAGE PIPE DETAIL

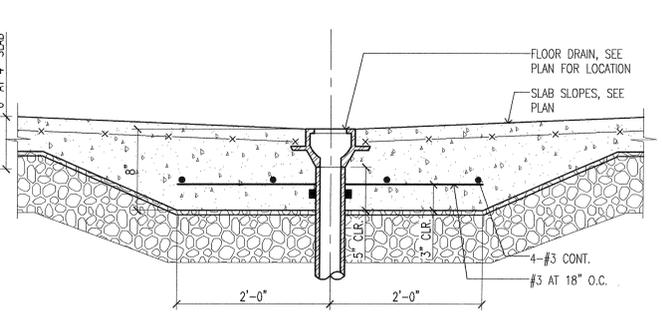


C FLOOR DRAIN AT SLOPED SLAB

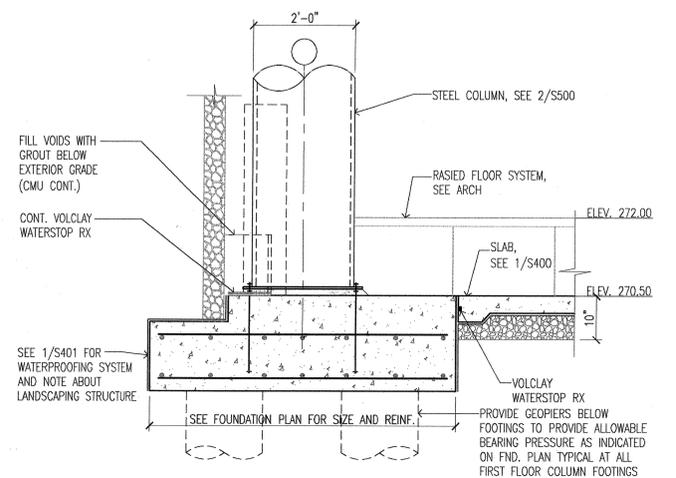


2 STEEL COL. BRG. AT EXT. FOOTING ON GRID LINE C
 3/4" = 1'-0"

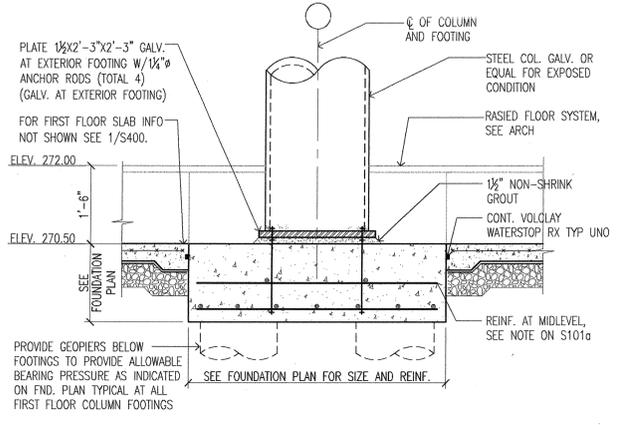

3 TYPICAL STEEL COL. BRG. AT INTERIOR FOOTING (EXTERIOR FOOTING SIM.)
 NOT TO SCALE

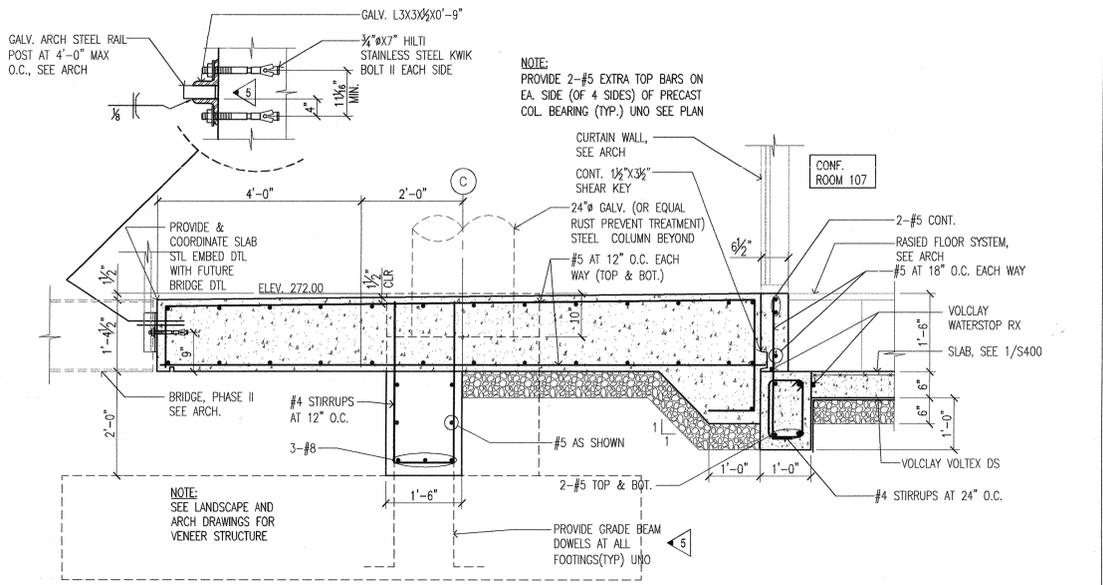

4 SECTION AT CANTILEVER SLAB
 3/4" = 1'-0" (REF. 11, 12/A435)

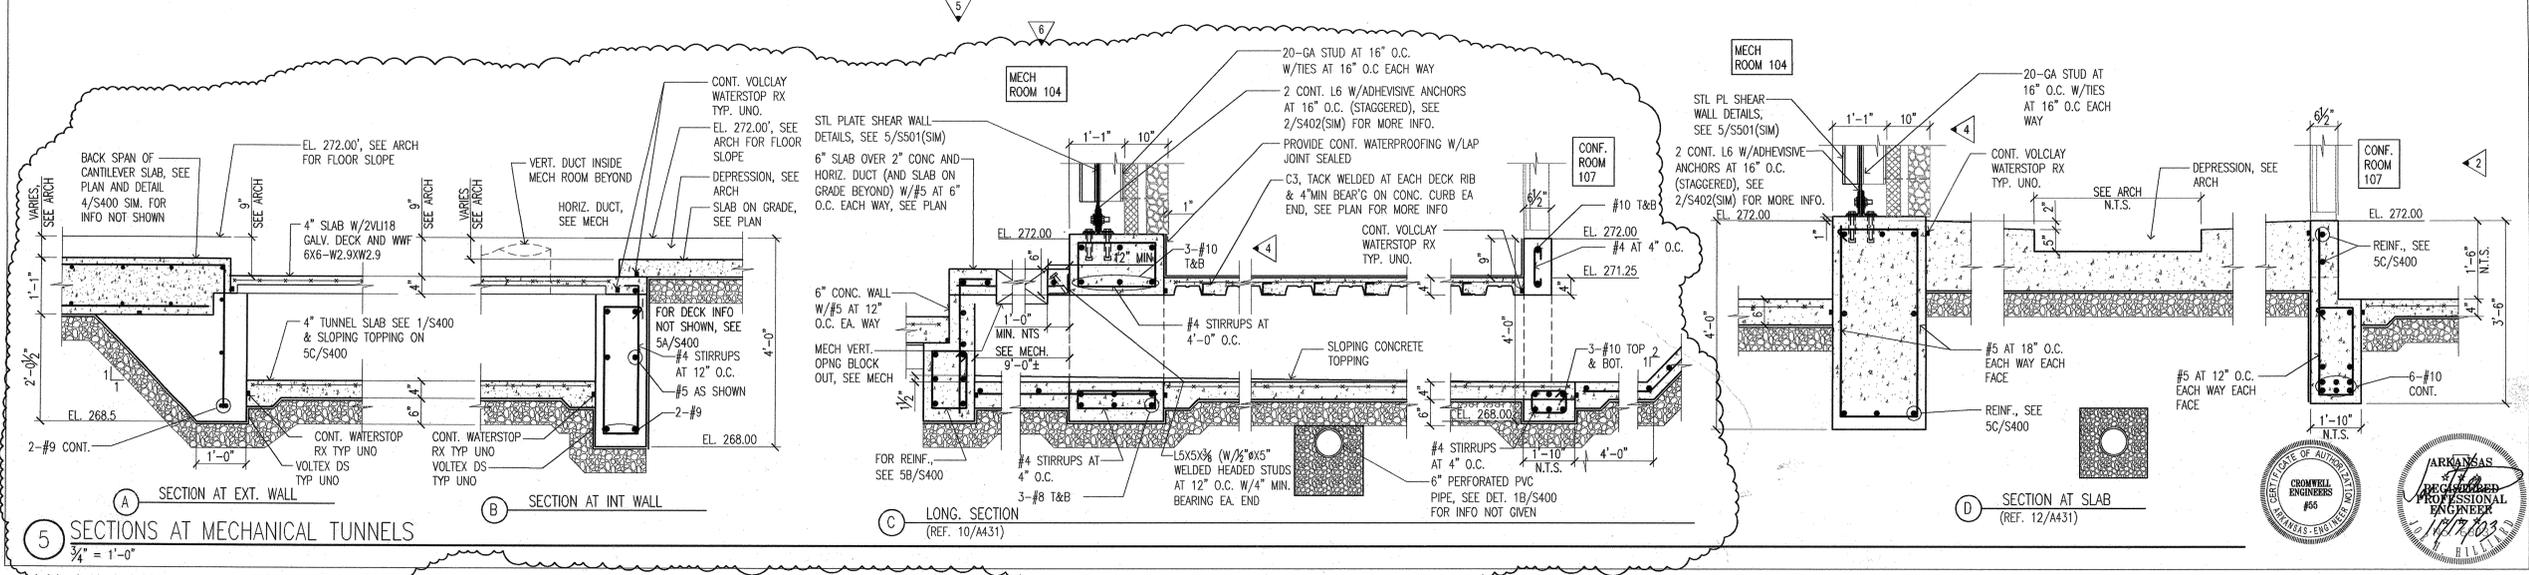

5 SECTIONS AT MECHANICAL TUNNELS
 3/4" = 1'-0"

F:\Projects\2001\2001_066\2001066.dwg\5400.dwg, 08/27/2004 1:54:29 PM

