

700 SOUTH SCHILLER
LITTLE ROCK, AR 72201
501.378.0878 office
501.372.7629 fax

509 W. SPRING STREET,
SUITE 150
FAYETTEVILLE, AR 72701
479.444.0473 office
473.251.7216 fax

www.polkstanley.com

- CONSULTANTS:
- CIVIL ENGINEER:
MCCELLELAND ENGINEERS
 - LANDSCAPE ARCHITECT:
LARSON BURNS SMITH
 - STRUCTURAL ENGINEER:
CROMWELL ENGINEERS INC.
 - MECH., ELEC., PLUMB. ENGINEER:
CROMWELL ENGINEERS INC.
 - GLOBAL VILLAGE CONSULTANT
CAMBRIDGE SEVEN ASSOCIATES
 - INTERIOR DESIGNER:
POLK STANLEY ROWLAND
CURZON PORTER ARCHITECTS
 - GENERAL CONTRACTOR:
CDI CONTRACTORS, INC.

NOTES:

ISSUE DATE:
17 SEPTEMBER 2007

REVISIONS:


#	DATE:	DESCRIPTION:
1	02/06/08	ASI #2
2	05/16/08	ASI #13
3	02/27/09	ASI #37

MURPHY - KELLER
EDUCATIONAL CENTER
HEIFER
INTERNATIONAL
CENTER
LITTLE ROCK, ARKANSAS

PSRCP JOB NUMBER:
431E

CONTENTS:
PLUMBING RISER
DIAGRAMS

SHEET NUMBER:
P901

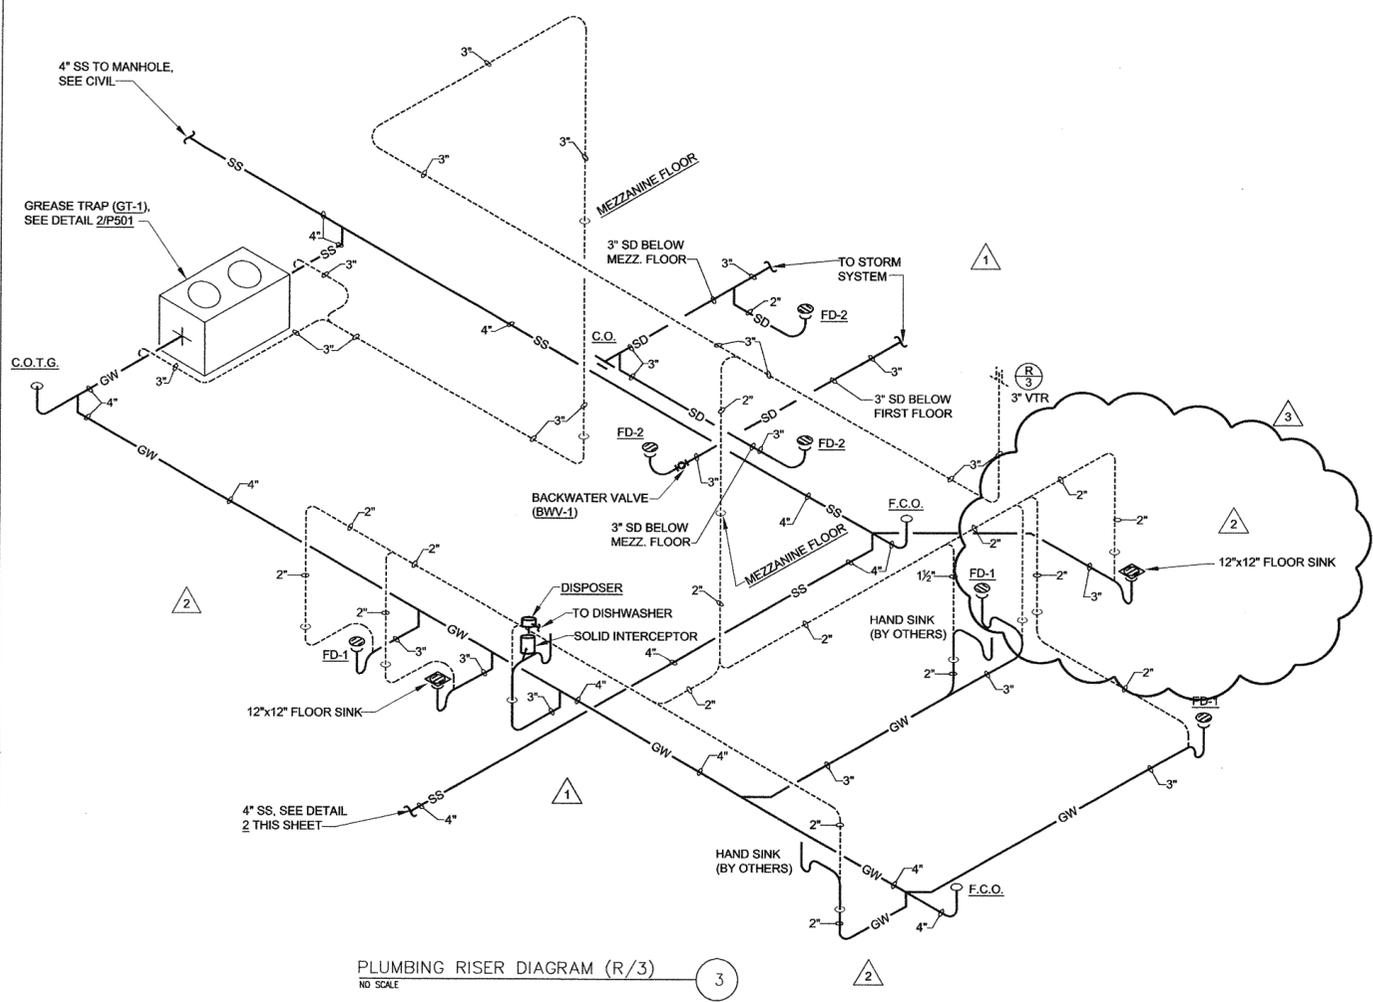

PLUMBING RISER DIAGRAM (R/3)
NO SCALE

