

CONSULTANTS:

CIVIL ENGINEER:
MCCLELLAND ENGINEERS

LANDSCAPE ARCHITECT:
LARSON BURNS SMITH

STRUCTURAL ENGINEER:
CROMWELL ENGINEERS INC.

MECH., ELEC., PLUMB ENGINEER:
CROMWELL ENGINEERS INC.

GLOBAL VILLAGE CONSULTANT
CAMBRIDGE SEVEN ASSOCIATES

INTERIOR DESIGNER:
POLK STANLEY ROWLAND
CURZON PORTER ARCHITECTS

GENERAL CONTRACTOR:
CDI CONTRACTORS, INC.

NOTES:

ISSUE DATE:
17 SEPTEMBER 07

REVISONS:

#	DATE	DESCRIPTION
1	28 SEP 07	ADDENDUM 01
2	10 OCT 07	ADDENDUM 02
3	7 JAN 08	ASI 01
4	7 MAR 08	ASI 05
5	14 APR 08	ASI
6	19 JUNE 08	ASI 16

**MURPHY KELLER
EDUCATION CENTER**


**HEIFER
INTERNATIONAL
CENTER**

LITTLE ROCK, ARKANSAS

PSRCP JOB NUMBER:
431E

CONTENTS:
LOW ROOF /
MEZZANINE
FRAMING PLAN
SHEET NUMBER:

S103

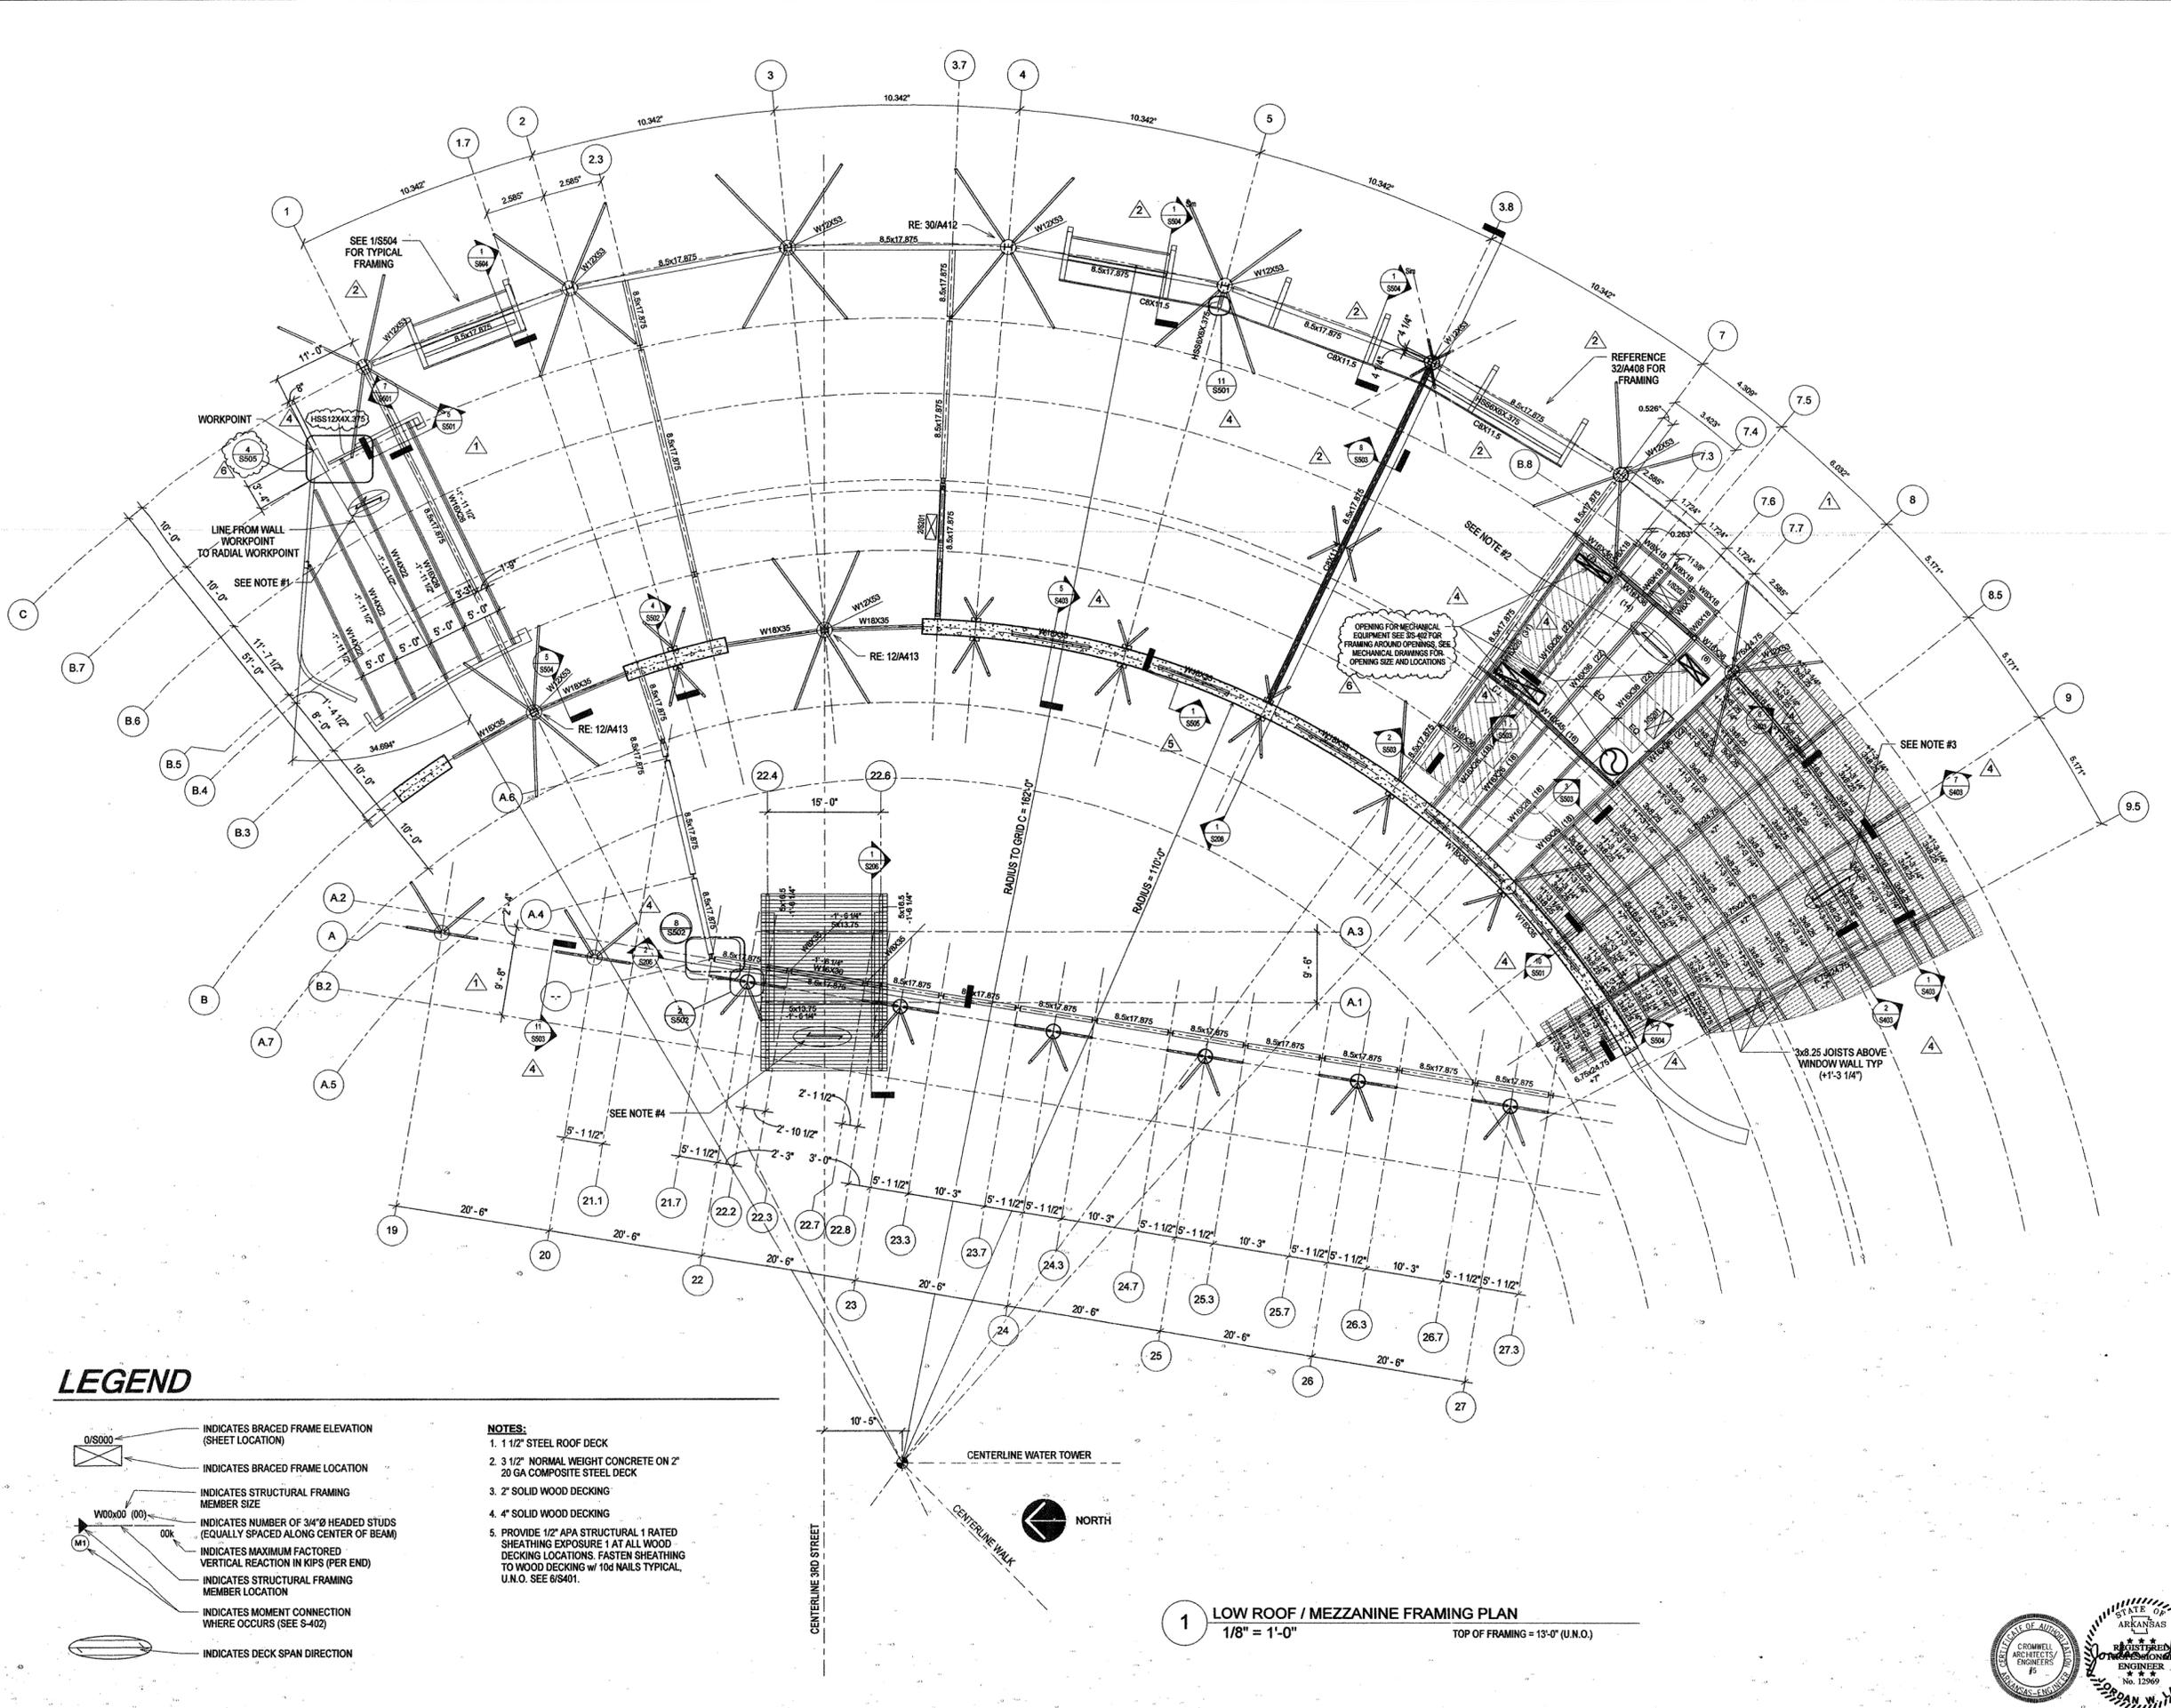

LEGEND

- INDICATES BRACED FRAME ELEVATION (SHEET LOCATION)
- INDICATES BRACED FRAME LOCATION
- INDICATES STRUCTURAL FRAMING MEMBER SIZE
- INDICATES NUMBER OF 3/4" Ø HEADED STUDS (EQUALLY SPACED ALONG CENTER OF BEAM)
- INDICATES MAXIMUM FACTORED VERTICAL REACTION IN KIPS (PER END)
- INDICATES STRUCTURAL FRAMING MEMBER LOCATION
- INDICATES MOMENT CONNECTION WHERE OCCURS (SEE S-402)
- INDICATES DECK SPAN DIRECTION

- NOTES:**
1. 1 1/2" STEEL ROOF DECK
 2. 3 1/2" NORMAL WEIGHT CONCRETE ON 2" 20 GA COMPOSITE STEEL DECK
 3. 2" SOLID WOOD DECKING
 4. 4" SOLID WOOD DECKING
 5. PROVIDE 1/2" APA STRUCTURAL 1 RATED SHEATHING EXPOSURE 1 AT ALL WOOD DECKING LOCATIONS. FASTEN SHEATHING TO WOOD DECKING w/ 10d NAILS TYPICAL, U.N.O. SEE 6/S401.

1 LOW ROOF / MEZZANINE FRAMING PLAN
1/8" = 1'-0"
TOP OF FRAMING = 13'-0" (U.N.O.)

