



4 HVAC CONDENSATE TRAP DETAIL  
SCALE: 1/8"=1'-0"

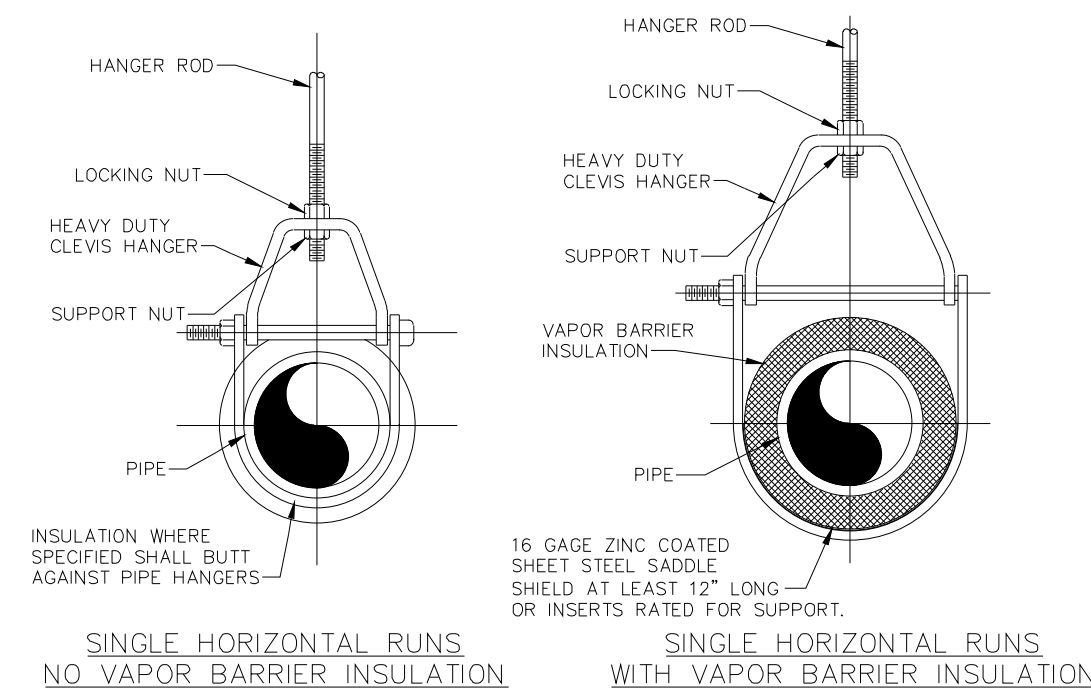


HANGER ROD SCHEDULE	
PIPE SIZE	ROD SIZE
UP TO 2"	3/8" DIA.
2 1/2" - 3"	1/2" DIA.
4" - 6"	5/8" DIA.
6" - 12"	7/8" DIA.


3 CLEVIS HANGER DETAIL  
SCALE: 1/8"=1'-0"

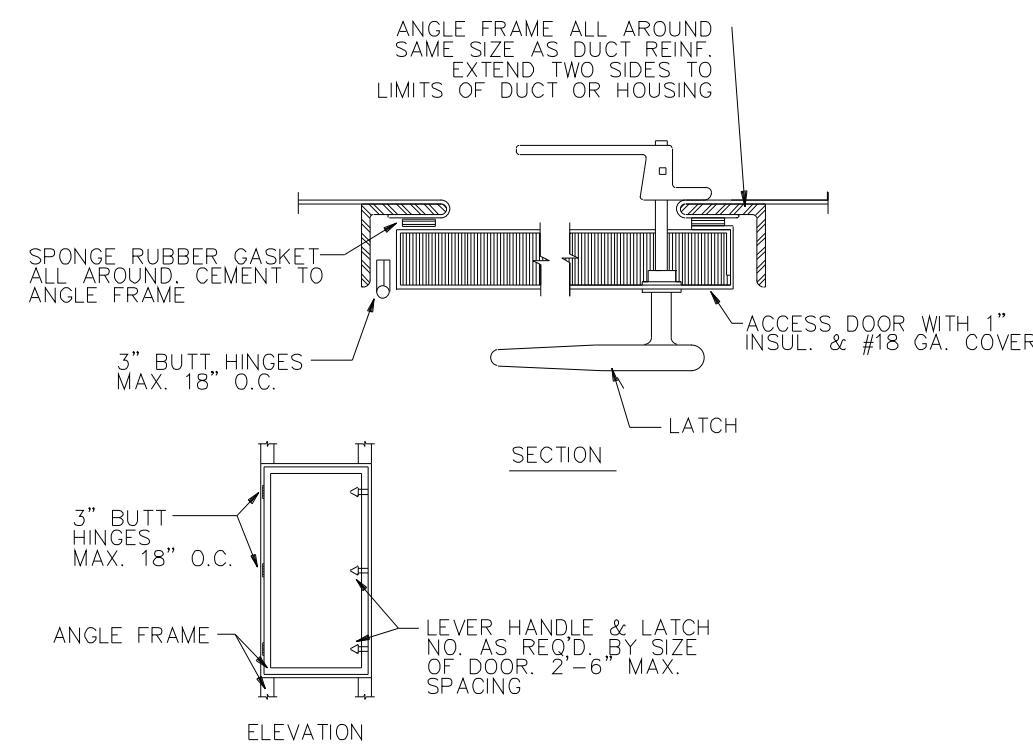


2 TYPICAL DUCT ACCESS PANEL DETAIL  
SCALE: 1/8"=1'-0"

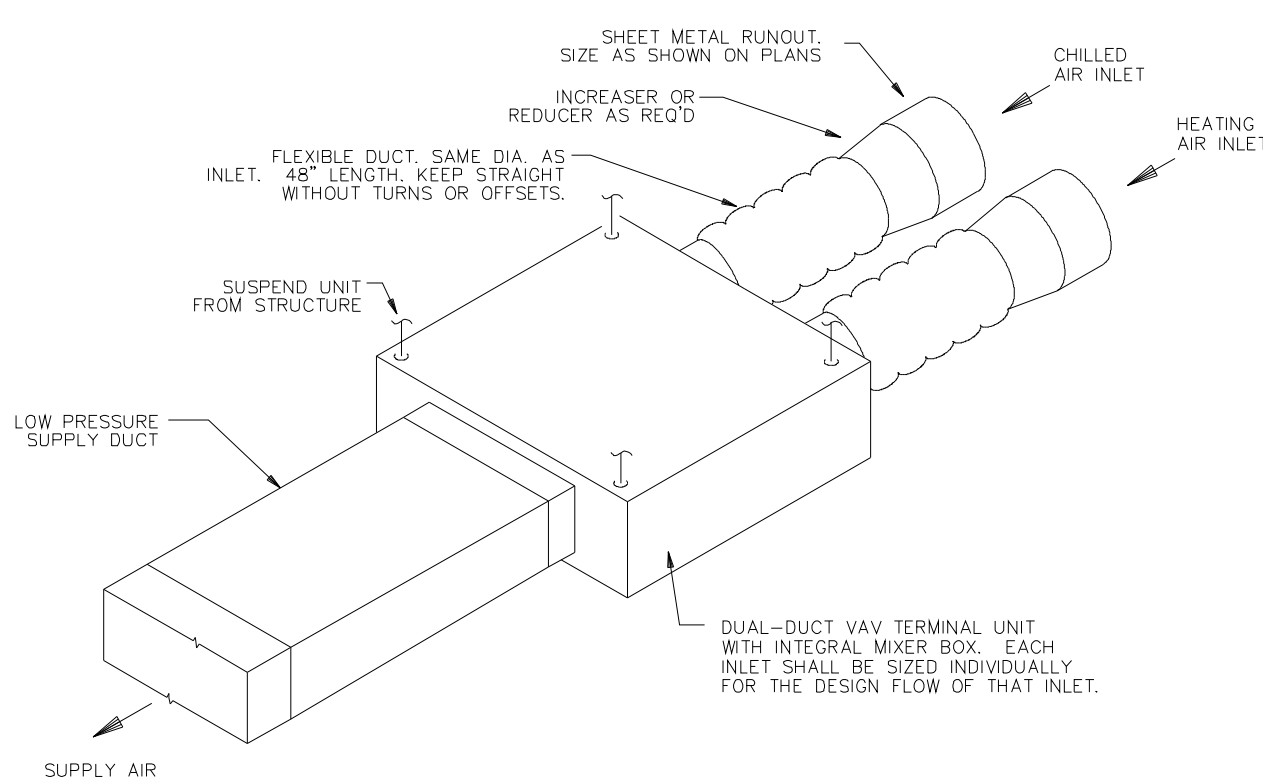


1 TYPICAL DUAL-DUCT TERMINAL UNIT DETAIL  
SCALE: 1/8"=1'-0"

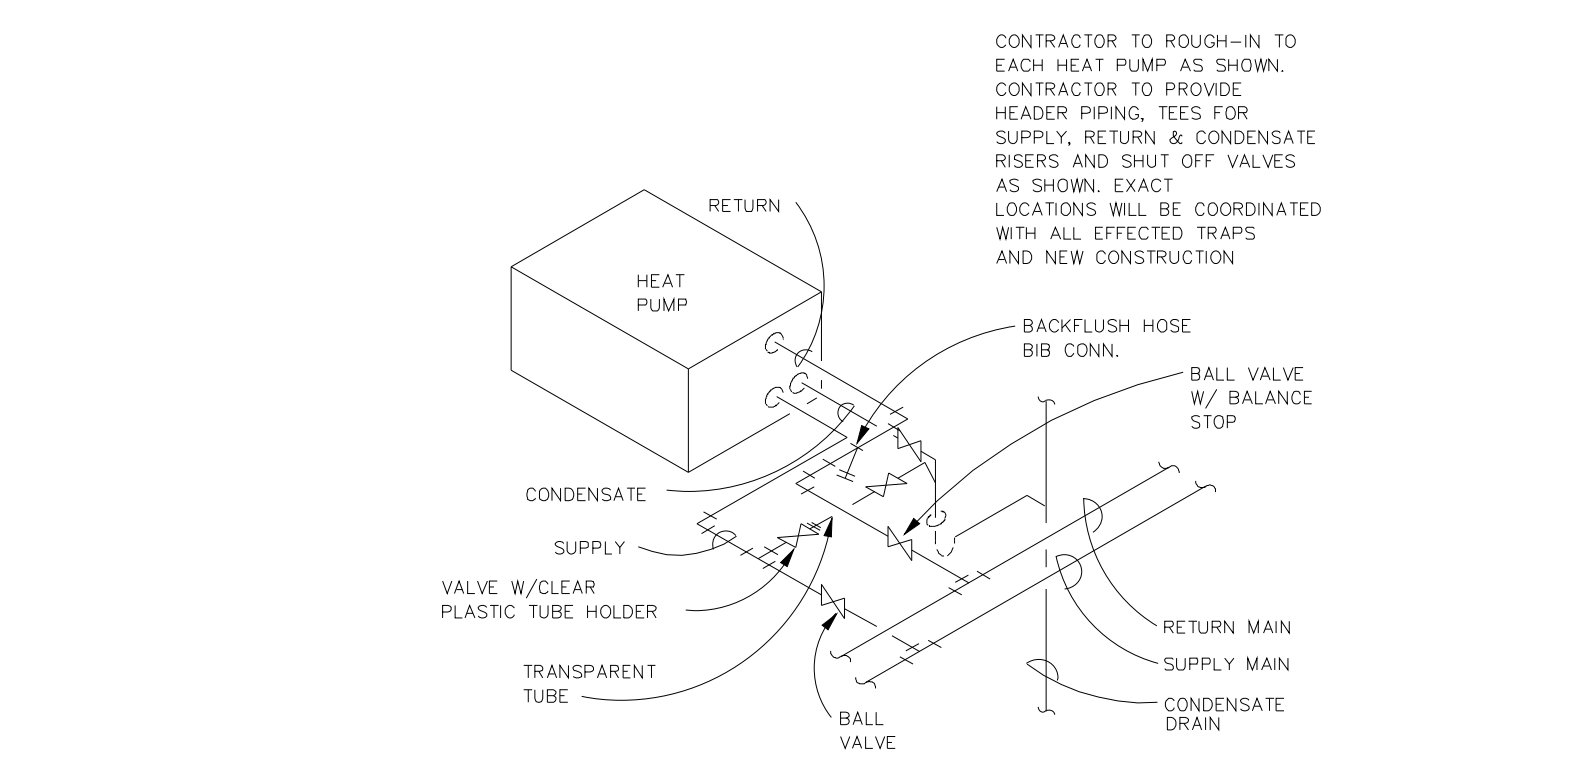


9 TYPICAL HEAT PUMP CONNECTIONS  
SCALE: 1/8"=1'-0"

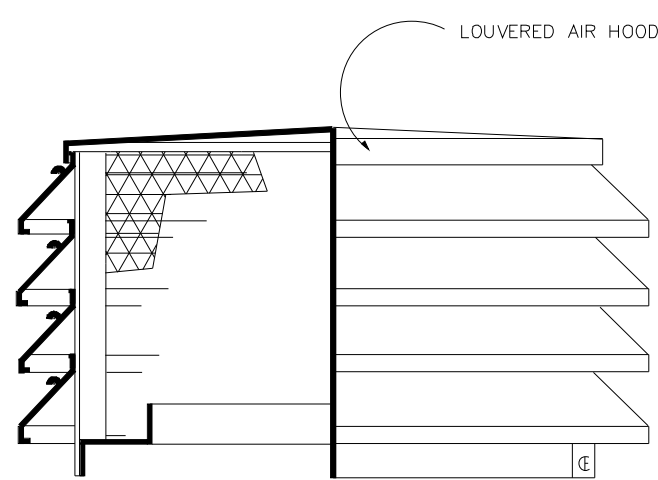


8 FRESH-AIR INTAKE HOOD  
SCALE: 1/8"=1'-0"

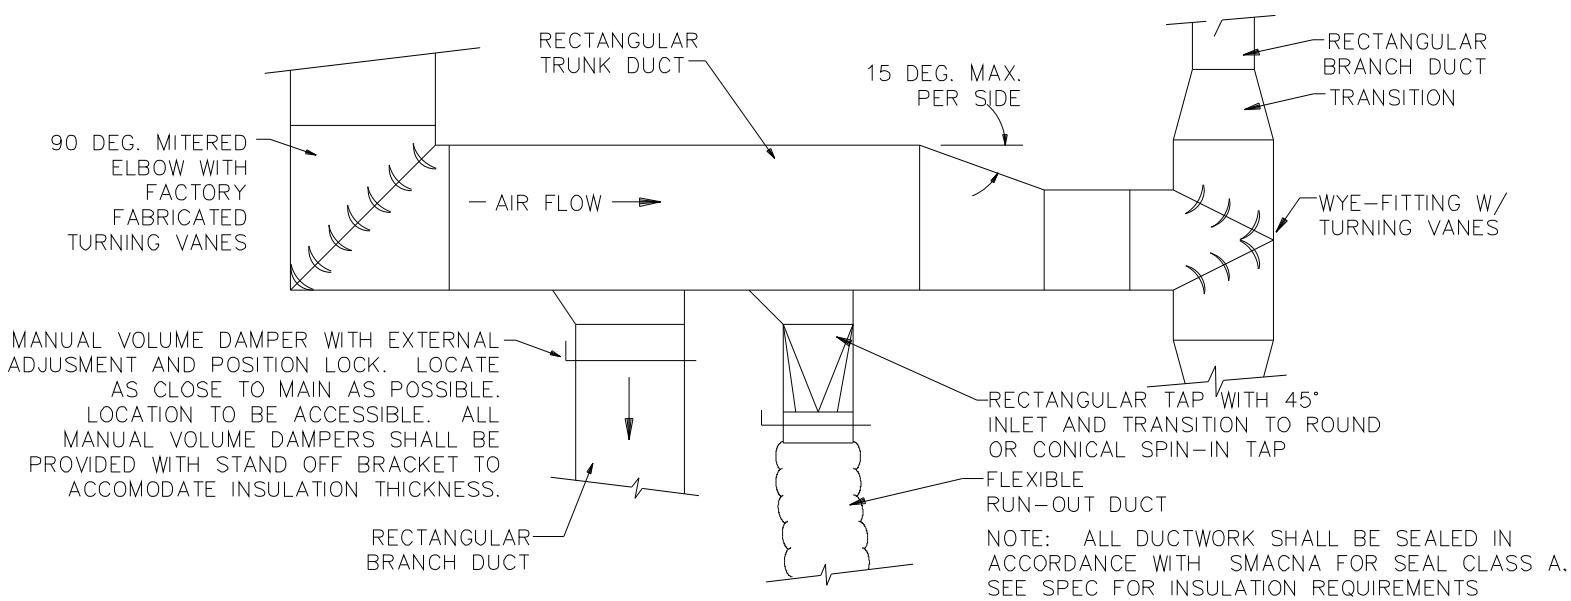


7 TYPICAL LOW PRESSURE DUCT CONNECTION DETAIL  
SCALE: 1/8"=1'-0"

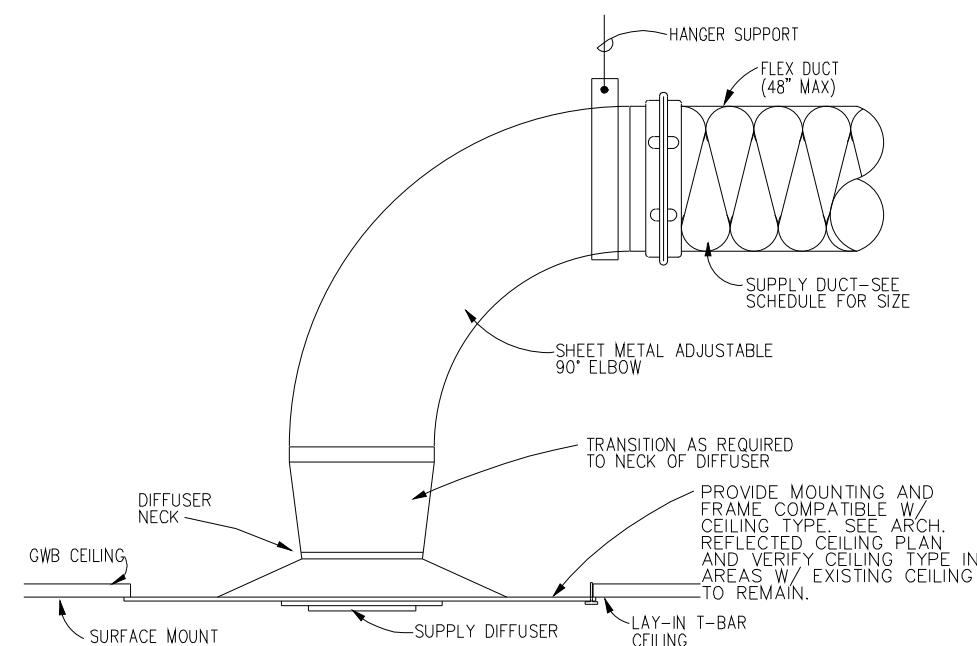

6 TYPICAL DIFFUSER/DUCT CONNECTION DETAIL  
SCALE: 1/8"=1'-0"

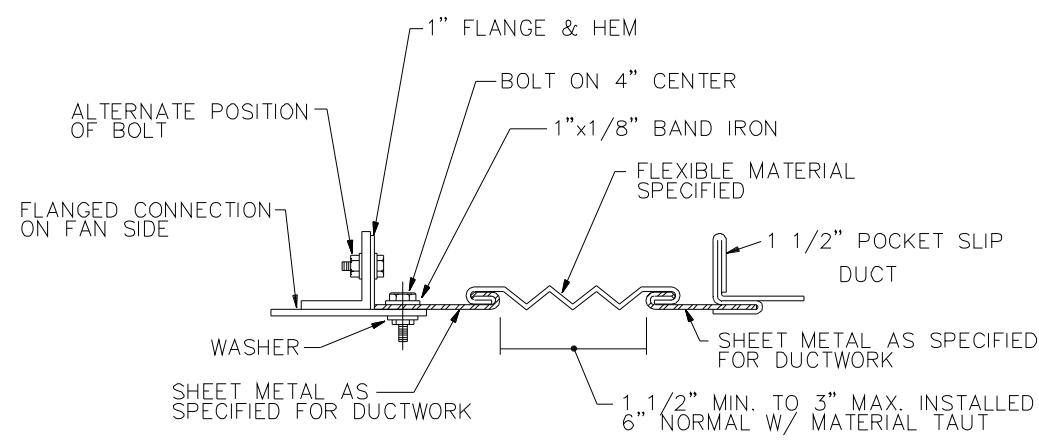

5 TYPICAL FLEX DUCT CONNECTION DETAIL  
SCALE: 1/8"=1'-0"

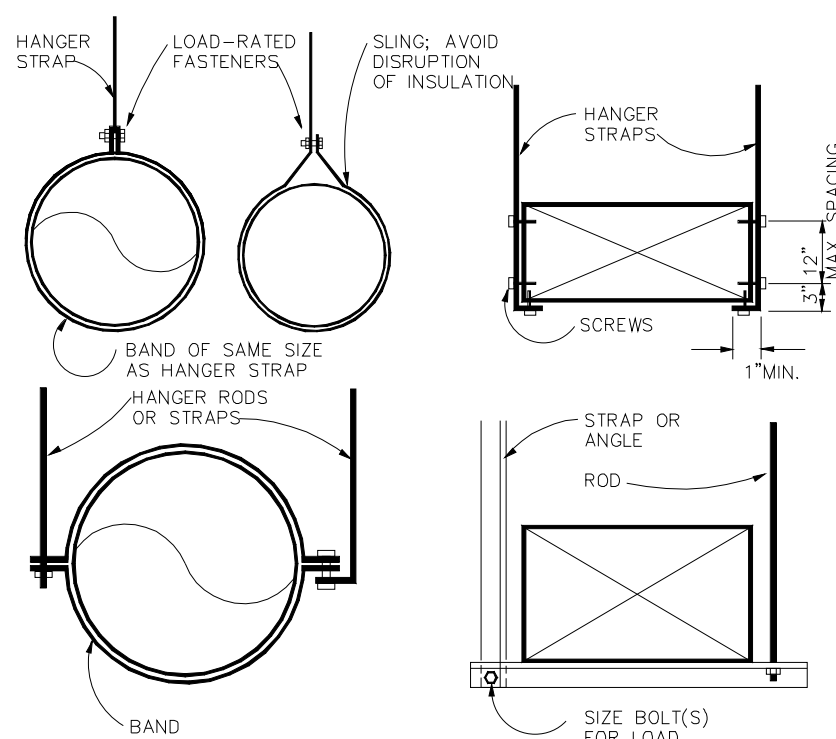

10 LOW PRESSURE DUCT SUPPORTS  
SCALE: 1/8"=1'-0"