
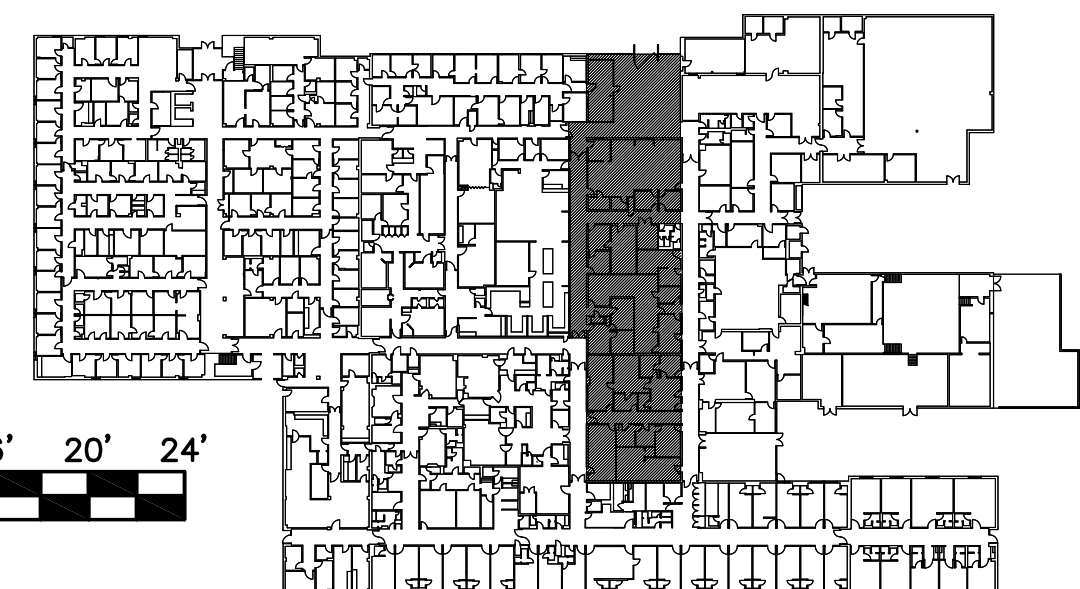


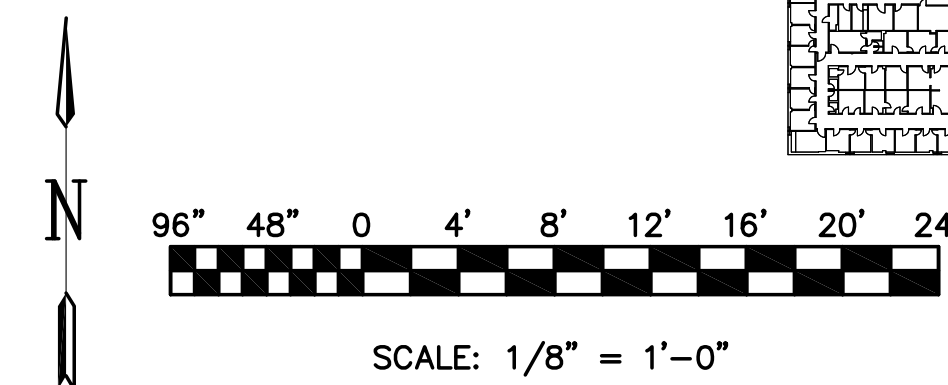

**MATCH LINE**

MECHANICAL DEMOLITION PARTIAL PLAN  
SCALE: 1/8" = 1'-0"

[illegible]

SHEET TITLE  
MECHANICAL DEMOLITION  
PLAN

DRAWN BY <b>BMS</b>	LEAD DESIGNER <b>JCF</b>
TECH REVIEWER <b>JCF</b>	PROJECT NUMBER <b>NKAK 06-8006 4A</b>
DESIGNED BY <b>JCF</b>	SHEET
DATE <b>13 MAY 2009</b>	<b>M-101</b>
SCALE <b>AS SHOWN</b>	<b>29 OF 51</b>