


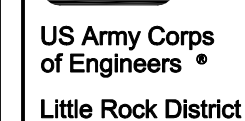

INTEGRATE AIR HANDLING UNITS AND VAV TERMINALS INTO EXISTING DDC CONTROL SYSTEM. PROVIDE VAV SYSTEM WITH CRITICAL ZONE RESET CONTROLS.

⊕ HVAC NOTES BY SYMBOL

1. PROVIDE 24/12 TAP AND TRANSITION TO CONNECTION AT FPVAV.
2. FIELD COORDINATE EXACT TEMPERATURE SENSOR LOCATION WITH OWNER.

[illegible]

DESIGNED BY:	JFLS	DATE:	10 DECEMBER 2015
DRAWN BY:	LSTWN	SOLICITATION NO.:	W9127S-15-R-0005
CHECKED BY:	JFLS	CONTRACT NO.:	W9127S-15-R-0002
SUBMITTED BY:	LST Consulting Engineers, PA	FILE NUMBER	
PLOT SCALE:	1"= 1'-0"	PLOT DATE:	10 DEC 2015
FILE NAME:	MARCH E1	SIZE:	



REPAIR OF BUILDING INFRASTRUCTURE SYSTEMS
19th MEDICAL GROUP
1090 ARNOLD DRIVE
LITTLE ROCK AIR FORCE BASE, AR 72099-5057

PARTIAL 1ST FLOOR MECHANICAL PLAN

SHEET
IDENTIFICATION
M-102