



804 West Curtis Drive, Suite H
Midwest City, OK 73110
phone: 405.869.9212
fax: 405.869.9222
www.fpm-group.com


RECORD
DRAWINGS
MARCH 2007

[illegible]REPAIR MEDICAL CENTER PH B
LITTLE ROCK AFB, ARKANSAS

HVAC DEMOLITION PLAN

DRAWN BY MJG	LEAD DESIGNER AM
TECH REVIEWER OD	PROJECT NUMBER NKAK 05-8004A
DESIGNED BY OD	SHEET MO.11
DATE 1-21-08	
SCALE 1/8"=1'-0"	23 OF 39

OPTION #1

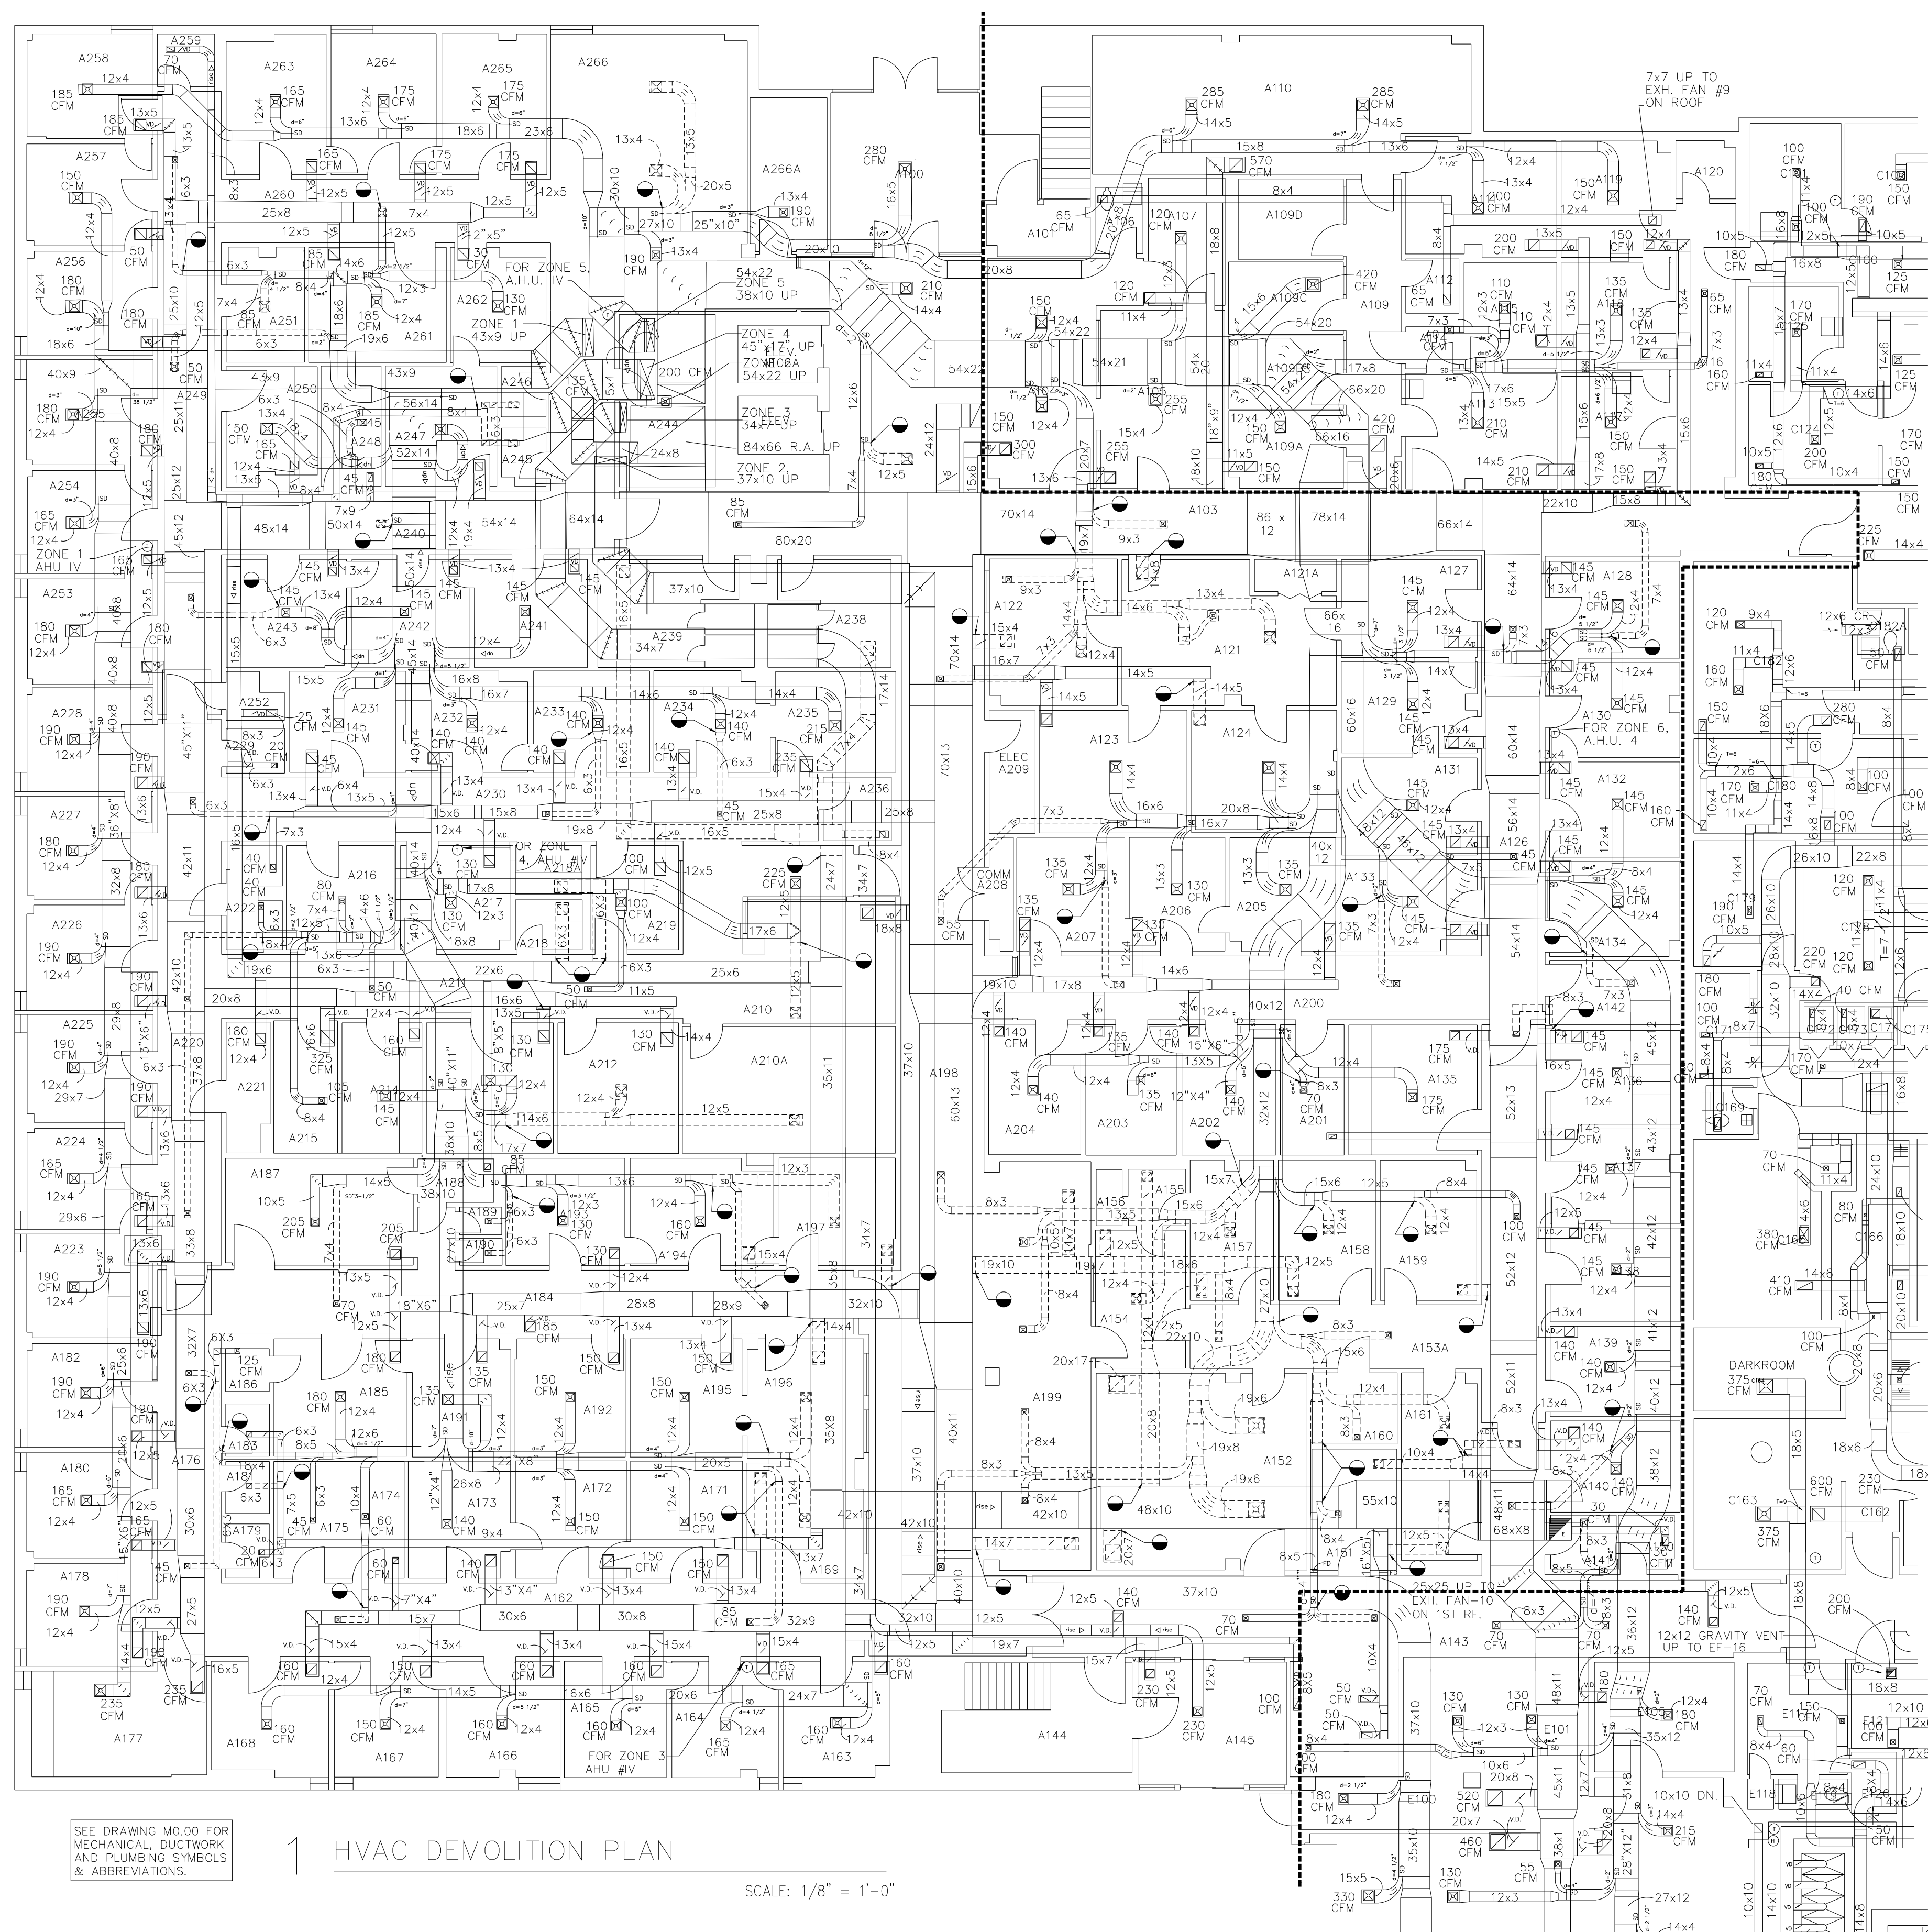

SEE DRAWING MO.00 FOR
MECHANICAL, DUCTWORK
AND PLUMBING SYMBOLS
& ABBREVIATIONS.

1 HVAC DEMOLITION PLAN

SCALE: 1/8" = 1'-0"

