

REVISIONS	AS-BUILT	DATE	APPROVED	SYMBOL	AMENDMENT	DESCRIPTION
1	ISSUED FOR FINAL WORK PLAN	10/31/2003				
2	ISSUED FOR CONSTRUCTION	10/14/2003				
3	ISSUED FOR CONSTRUCTION	10/14/2003				

DESIGNED BY: DATE: 09/04/2003	PROJECT NO: 6503	CHECKED BY: DRAWING CODE:	REVIEWED BY: SOLICITATION NUMBER:
U.S. ARMY ENGINEERING AND SUPPORT CENTER CORPS OF ENGINEERS HUNTSVILLE, ALABAMA			
EARTHTECH	FLM Design		

RENOVATE CLINIC
BUILDING 1090
LITTLE ROCK AFB, ARKANSAS
**LEVEL ONE ZONE A
RETURN AIR DUCT PLAN
AS-BUILT**

SHEET
REFERENCE
NUMBER:
M1.13
SHEET X OF XX

1 PARTIAL PLAN OF AREA 'C' AND 'D' IN ZONE B

SCALE 1/8" = 1'-0"


2 ZONE A PLAN

SCALE 1/8" = 1'-0"

NOTES:

1. SEE DRAWING M1.11 FOR SUPPLY AND EXHAUST AIR SYSTEM
2. SEE DRAWING M4.11 & M4.12 FOR TYPICAL SECTIONS & DETAILS
3. SEE DRAWING M6.11 FOR EQUIPMENT SCHEDULES.

PROJECT RENOVATE CLINIC BUILDING 1090 LITTLE ROCK AFB, ARKANSAS	DRAWING TITLE
DRAWING APPLIES TO CONTRACT DOCUMENTS, SHEETS: M1.13	
PROJ. NO. 02209800 DR. BY ST	DATE 10/14/03 CHK. BY ST
EARTHTECH	FLM Design
SD-1	SUPPLEMENTAL DRAWING NO.
39	SHEET OF

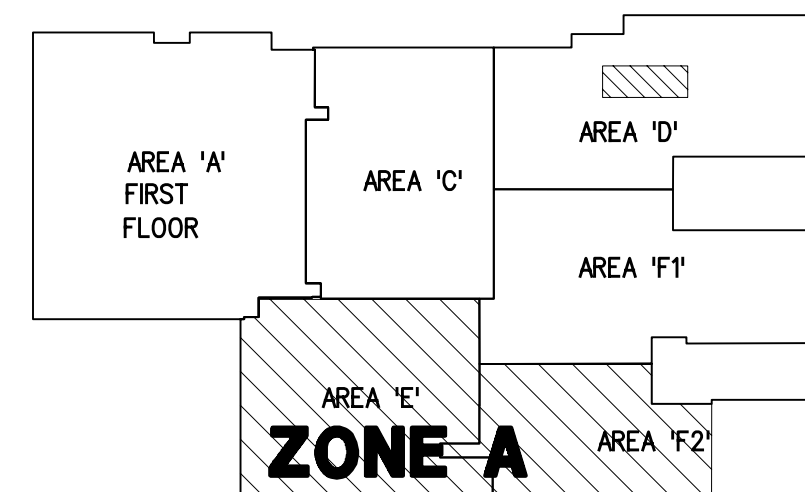

KEY PLAN

N.T.S.

SCALE