

REVISIONS	DATE	DESCRIPTION	BY	APP'D
1	10/14/2003	ISSUED FOR FINAL WORK PLAN	AS-BUILT	
2	10/14/2003	ISSUED FOR FINAL WORK PLAN	AS-BUILT	
DESIGNED BY: DATE: 09/04/2003	PROJECT NO: 6503	CHECKED BY: DRAWING CODE:	REVIEWED BY: SOLIDATION NUMBER:
U.S. ARMY ENGINEERING AND SUPPORT CENTER CORPS OF ENGINEERS HUNTSVILLE, ALABAMA			
EARTHTECH			


RENOVATE CLINIC
BUILDING 1090
LITTLE ROCK AFB, ARKANSAS

ZONE A

REHEAT COILS PIPING PLAN


AS-BUILT

SHEET
REFERENCE
NUMBER:
M2.11
SHEET X OF XX

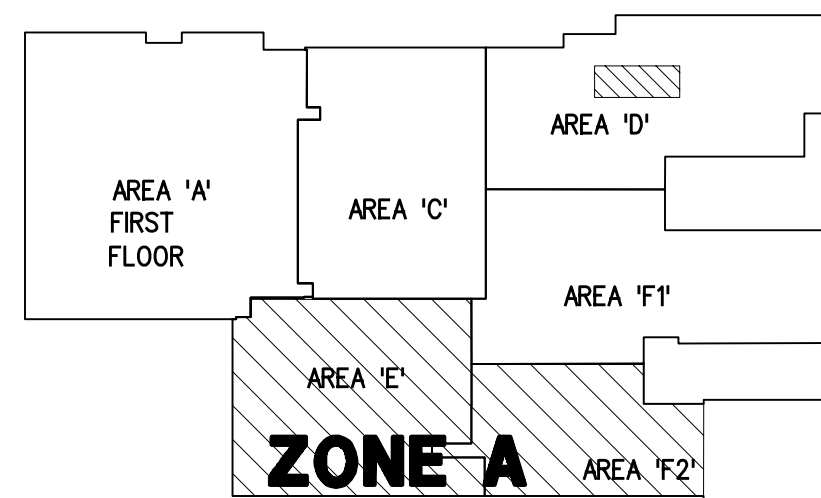


KEY PLAN
N.T.S.

SCALE

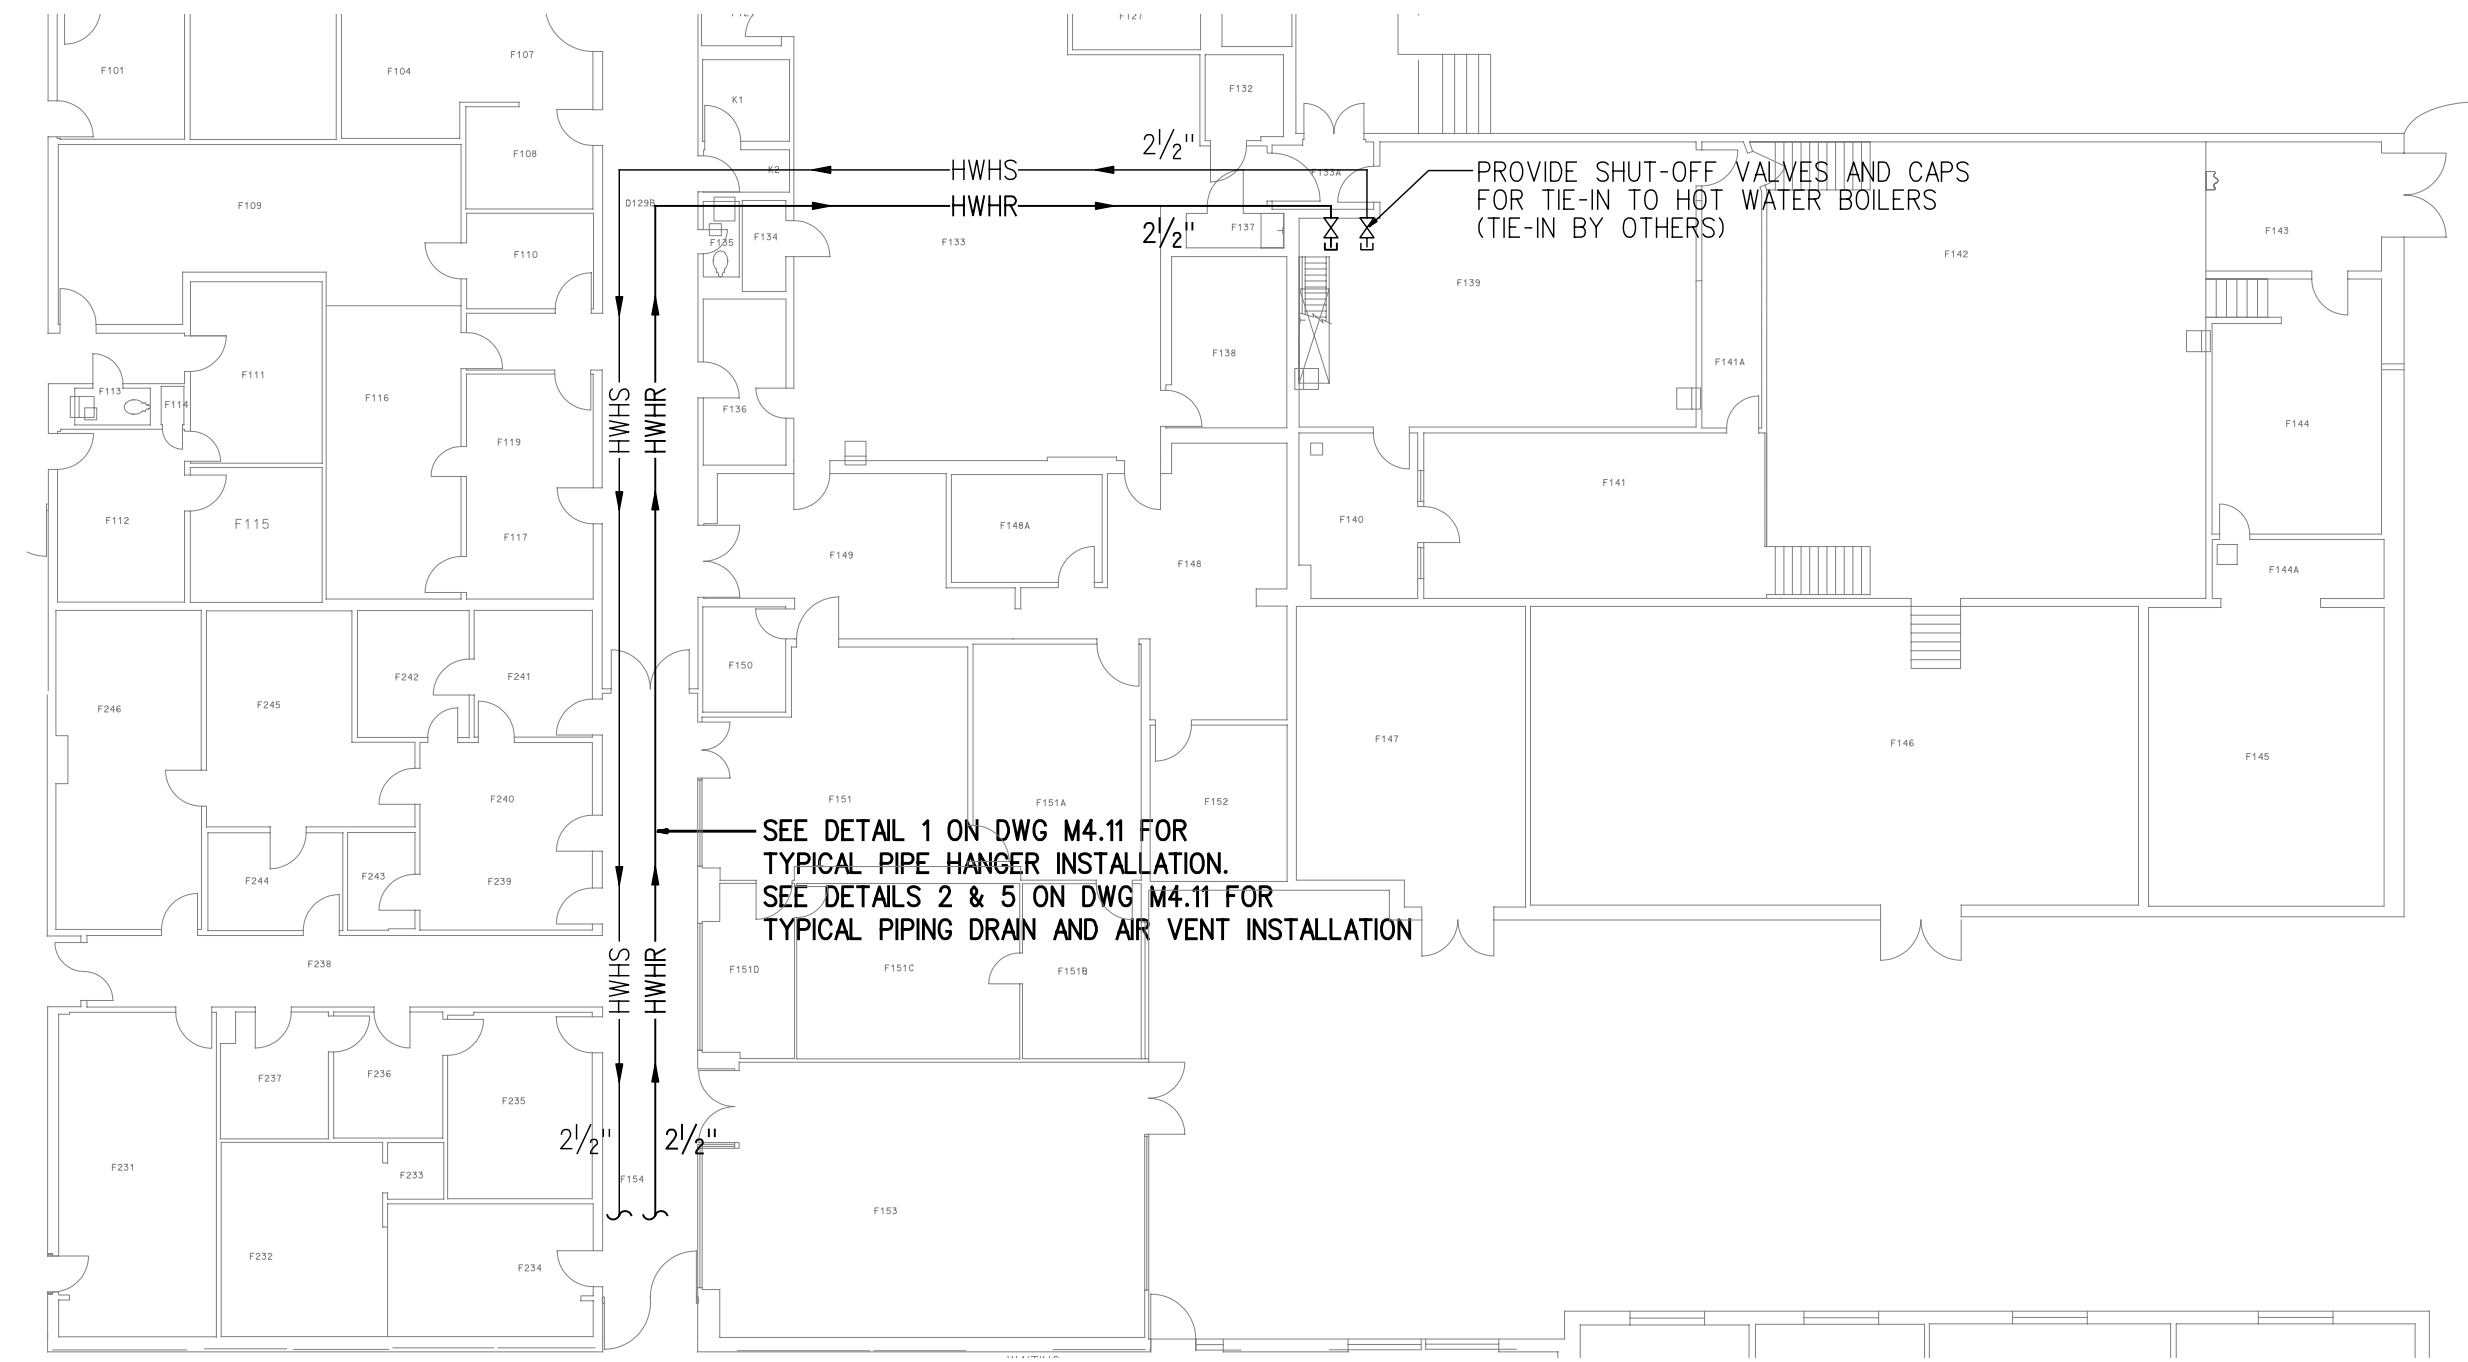


1 PARTIAL PLAN OF AREA 'F' IN ZONE A

SCALE 1/8" = 1'-0"

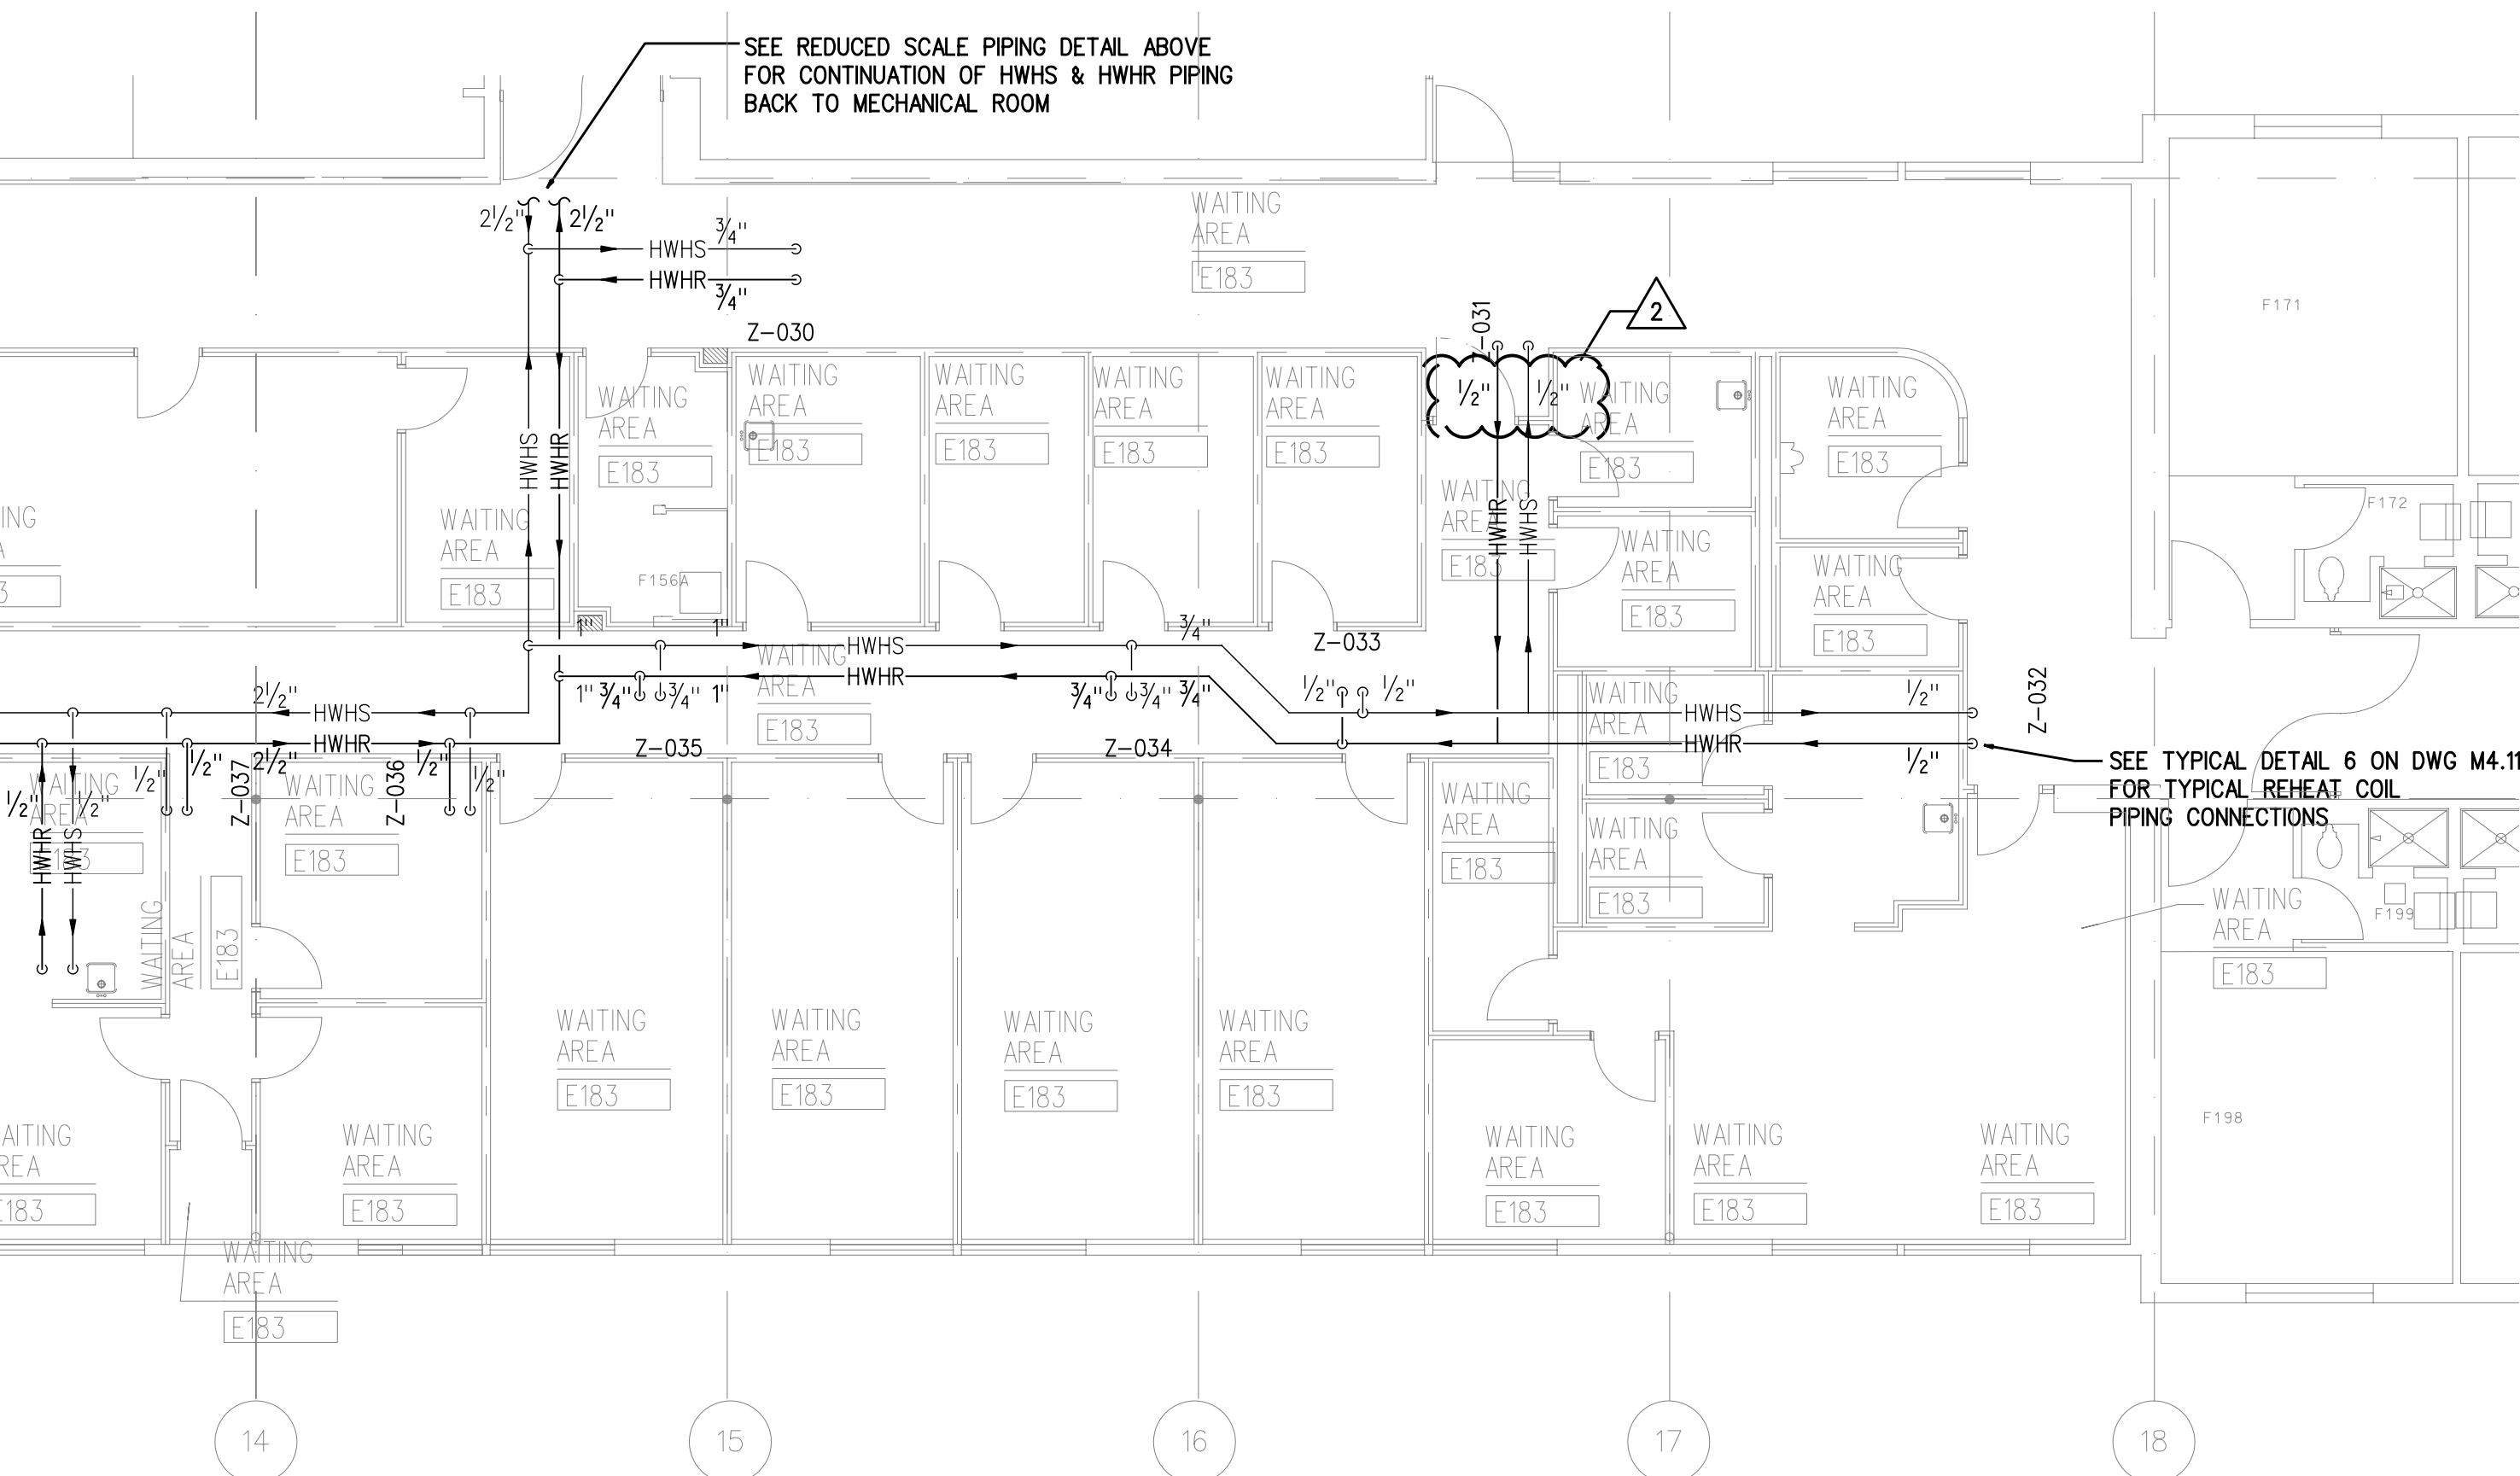

SEE TYPICAL DETAIL 6 ON DWG M4.11
FOR REPEAT COIL
PIPING CONNECTIONS.

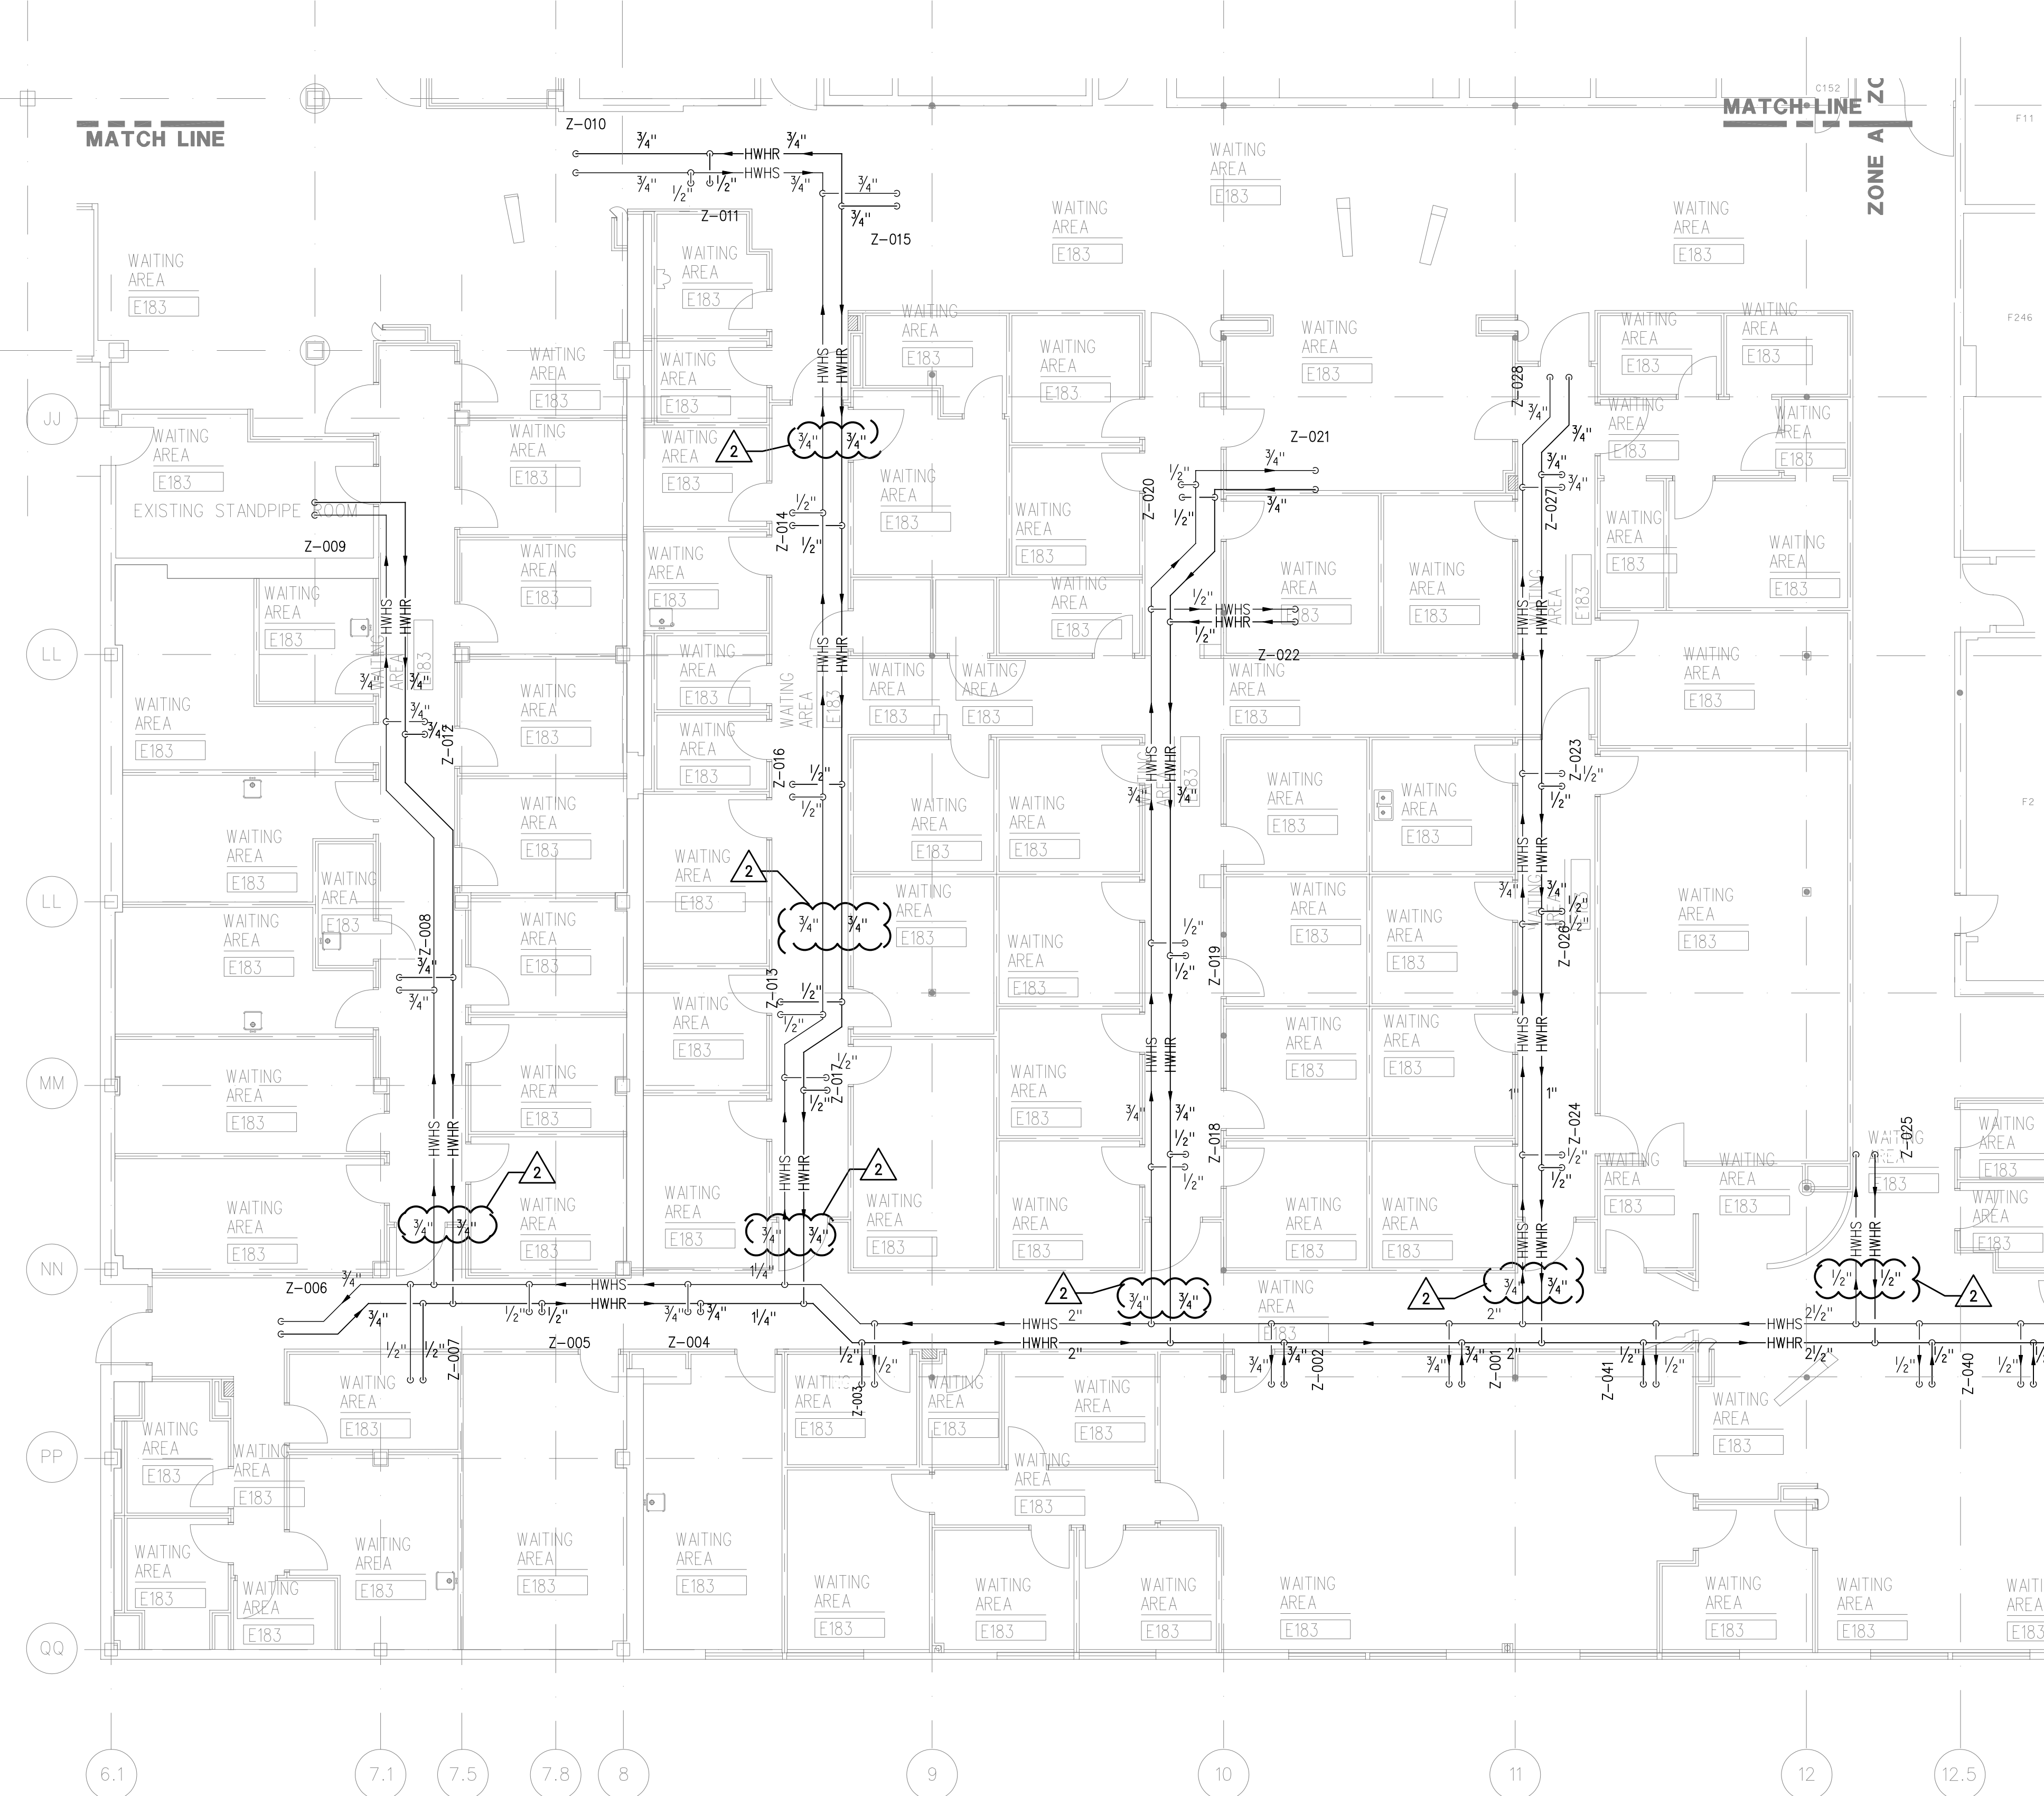

MATCH LINE

ZONE A

MATCH LINE

2 ZONE A PLAN

SCALE 1/8" = 1'-0"

NOTES

1. SEE DWGS M4.11 AND M4.12 FOR TYPICAL INSTALLATION DETAILS