


- ① SEE SPACE SCHEDULES THIS SHEET FOR AIR BALANCE DATA FOR SUPPLY, RETURN AND EXHAUST SYSTEMS. NOTE THAT AFTER EXISTING ROOF MOUNTED UNITS HAVE BEEN REPLACED PROVIDE AIR BALANCE. PROVIDE COMPLETE AIR BALANCE DATA FOR REVIEW. NOTE THAT PRESSURE RELATIONSHIPS AS INDICATED ON THE SCHEDULES MUST BE BALANCED.
- ② NOTE THAT THE DUCT ROUTING AND SIZE AS INDICATED ON THIS DRAWING HAS BEEN FIELD VERIFIED.
- ③ THE EXISTING DOUBLE DUCT MIXING BOXES SHALL BE MODIFIED TO PROVIDE SEPARATE CONTROL OF THE HEATING AND COOLING CONTROL DAMPERS. CONTROLS CONTRACTOR SHALL REMOVE EXISTING CONTROL OPERATORS AND PROVIDE SEPARATE CONTROL DAMPER OPERATORS TO CONVERT THE EXISTING BOXES TO VARIABLE VOLUME OPERATION. CONTROLS CONTRACTOR SHALL PROVIDE VAV CONTROLS TO PROPORTION EACH DAMPER TO VARY EITHER HEATING OR COOLING AIR AS REQUIRED BY THE RESPECTIVE TEMPERATURE SETPOINTS. MINIMUM COOLING AIR FLOW SHALL ONLY BE ALLOWED TO MAINTAIN A MINIMUM AIR FLOW AS INDICATED IN THE AIR BALANCE DATA. CONTROLS SHALL BE PROVIDED WITH ADJUSTMENT TO ALLOW OPERATOR TO REDUCE THE INDICATED MINIMUM AIR FLOW TO ANY ZONE. COORDINATE WITH THE INSTALLATION OF THE NEW DUAL DUCT AIR HANDLING UNIT S-4.

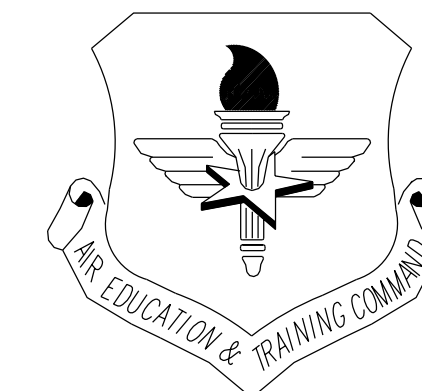

LITTLE ROCK A.F.B.  
ARKANSAS

**MTE** MIKE TRUSTY  
ENGINEERING  
PHONE: (501)224-9013  
FAX: (501)421-0151  
miketrusty@msn.com

[illegible]

PROJECT TITLE  
REPAIR & RENOVATE MEDICAL CLINIC PH V  
LITTLE ROCK AIR FORCE BASE  
JACKSONVILLE, ARKANSAS  
CHANGE ORDER TO PHASE V - 100% SUBMITTAL

PARTIAL FIRST FLOOR  
MECHANICAL PLAN  
S-4 - SUPPLY COOLING DUCT

DRAWN BY GMT	LEAD DESIGNER GMT
TECH REVIEWER	PROJECT NUMBER NKAK #06-8006-
DESIGNED BY GMT	SHEET <b>M-201</b>
DATE <b>DEC. 3, 2010</b>	
SCALE AS SHOWN	<b>6</b> OF <b>21</b>

AS-BUILT