


- ① SEE SPACE SCHEDULES THIS SHEET FOR AIR BALANCE DATA FOR SUPPLY, RETURN AND EXHAUST SYSTEMS. NOTE THAT AFTER EXISTING ROOF MOUNTED UNITS HAVE BEEN REPLACED PROVIDE AIR BALANCE. PROVIDE COMPLETE AIR BALANCE DATA FOR REVIEW. NOTE THAT PRESSURE RELATIONSHIPS AS INDICATED ON THE SCHEDULES MUST BE BALANCED.
- ② NOTE THAT THE DUCT ROUTING AND SIZE AS INDICATED ON THIS DRAWING HAS BEEN FIELD VERIFIED.

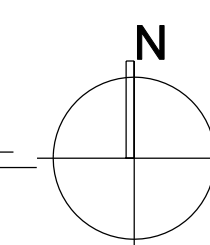

**MTE** MIKE TRUSTY  
ENGINEERING  
PHONE: (501)224-9013  
FAX: (501)421-0151  
miketrusty@msn.com

<b>PROJECT TITLE</b> REPAIR & RENOVATE MEDICAL CLINIC PH V LITTLE ROCK AIR FORCE BASE JACKSONVILLE, ARKANSAS  CHANGE ORDER TO PHASE V – 100% SUBMITTAL						
<b>DRAWN BY</b> GMT	<b>LEAD DESIGNER</b> GMT					
<b>TECH REVIEWER</b>	<b>PROJECT NUMBER</b> NKAK#06–8006–5					
<b>DESIGNED BY</b> GMT	<b>SHEET</b>					
<b>DATE</b> DEC. 3, 2010	<b>M-204</b>					
<b>SCALE</b> AS SHOWN	<b>9 OF 21</b>					
		No.	Revision / Issue	Date	BY	APPROD