


NOTE
1. SEE MECHANICAL - HVAC LEGEND
SHT. MH9.

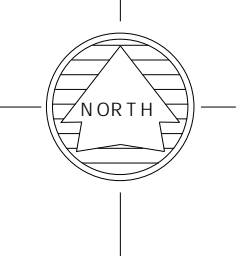

LITTLE ROCK A.F.B.
ARKANSAS

COMMANDER	
CIVIL ENGINEER	CHIEF OF DESIGN
CHIEF ENGINEER	BIO ENVIRONMENTAL ENG
BASE COMMUNICATIONS	COMMUNITY PLANNER
CHIEF OF OPERATIONS	CORROSION ENG
CONSTRUCTION MGR	FIRE CHIEF
ENVIRON. PROT. ENG	SAFETY
ENERGY COORD	USING AGENCY
SECURITY POLICE	G.C. REVIEWER

No.	Revision/Issue	Date	By	APPD

PROJECT TITLE

LITTLE ROCK A.F.B.
BUILDING 1090
PLANS

SHEET TITLE

AREA "A"
MECHANICAL-HVAC
PLAN

DRAWN BY KAS	LEAD DESIGNER —
TECH REVIEWER —	FILE LOCATION FILENAME
DESIGNED BY —	PROJECT NUMBER —
DATE 6/23/98	SHEET —
SCALE 1/8" = 1'-0"	MH1 of 54

