


SECOND FLOOR
MECHANICAL PLAN
RETURN DUCT

M-302

12 OF 21

AS-BUILT

- ① SEE SHEETS M-305 AND M-306 FOR AIR BALANCE DATA FOR SUPPLY, RETURN AND EXHAUST SYSTEMS. NOTE THAT AFTER EXISTING ROOF MOUNTED UNITS HAVE BEEN REPLACED PROVIDE AIR BALANCE. PROVIDE COMPLETE AIR BALANCE DATA FOR REVIEW. NOTE THAT PRESSURE RELATIONSHIPS AS INDICATED ON THE SCHEDULES MUST BE BALANCED.
- ② NOTE THAT THE DUCT ROUTING AND SIZE AS INDICATED ON THIS DRAWING HAS BEEN FIELD VERIFIED.

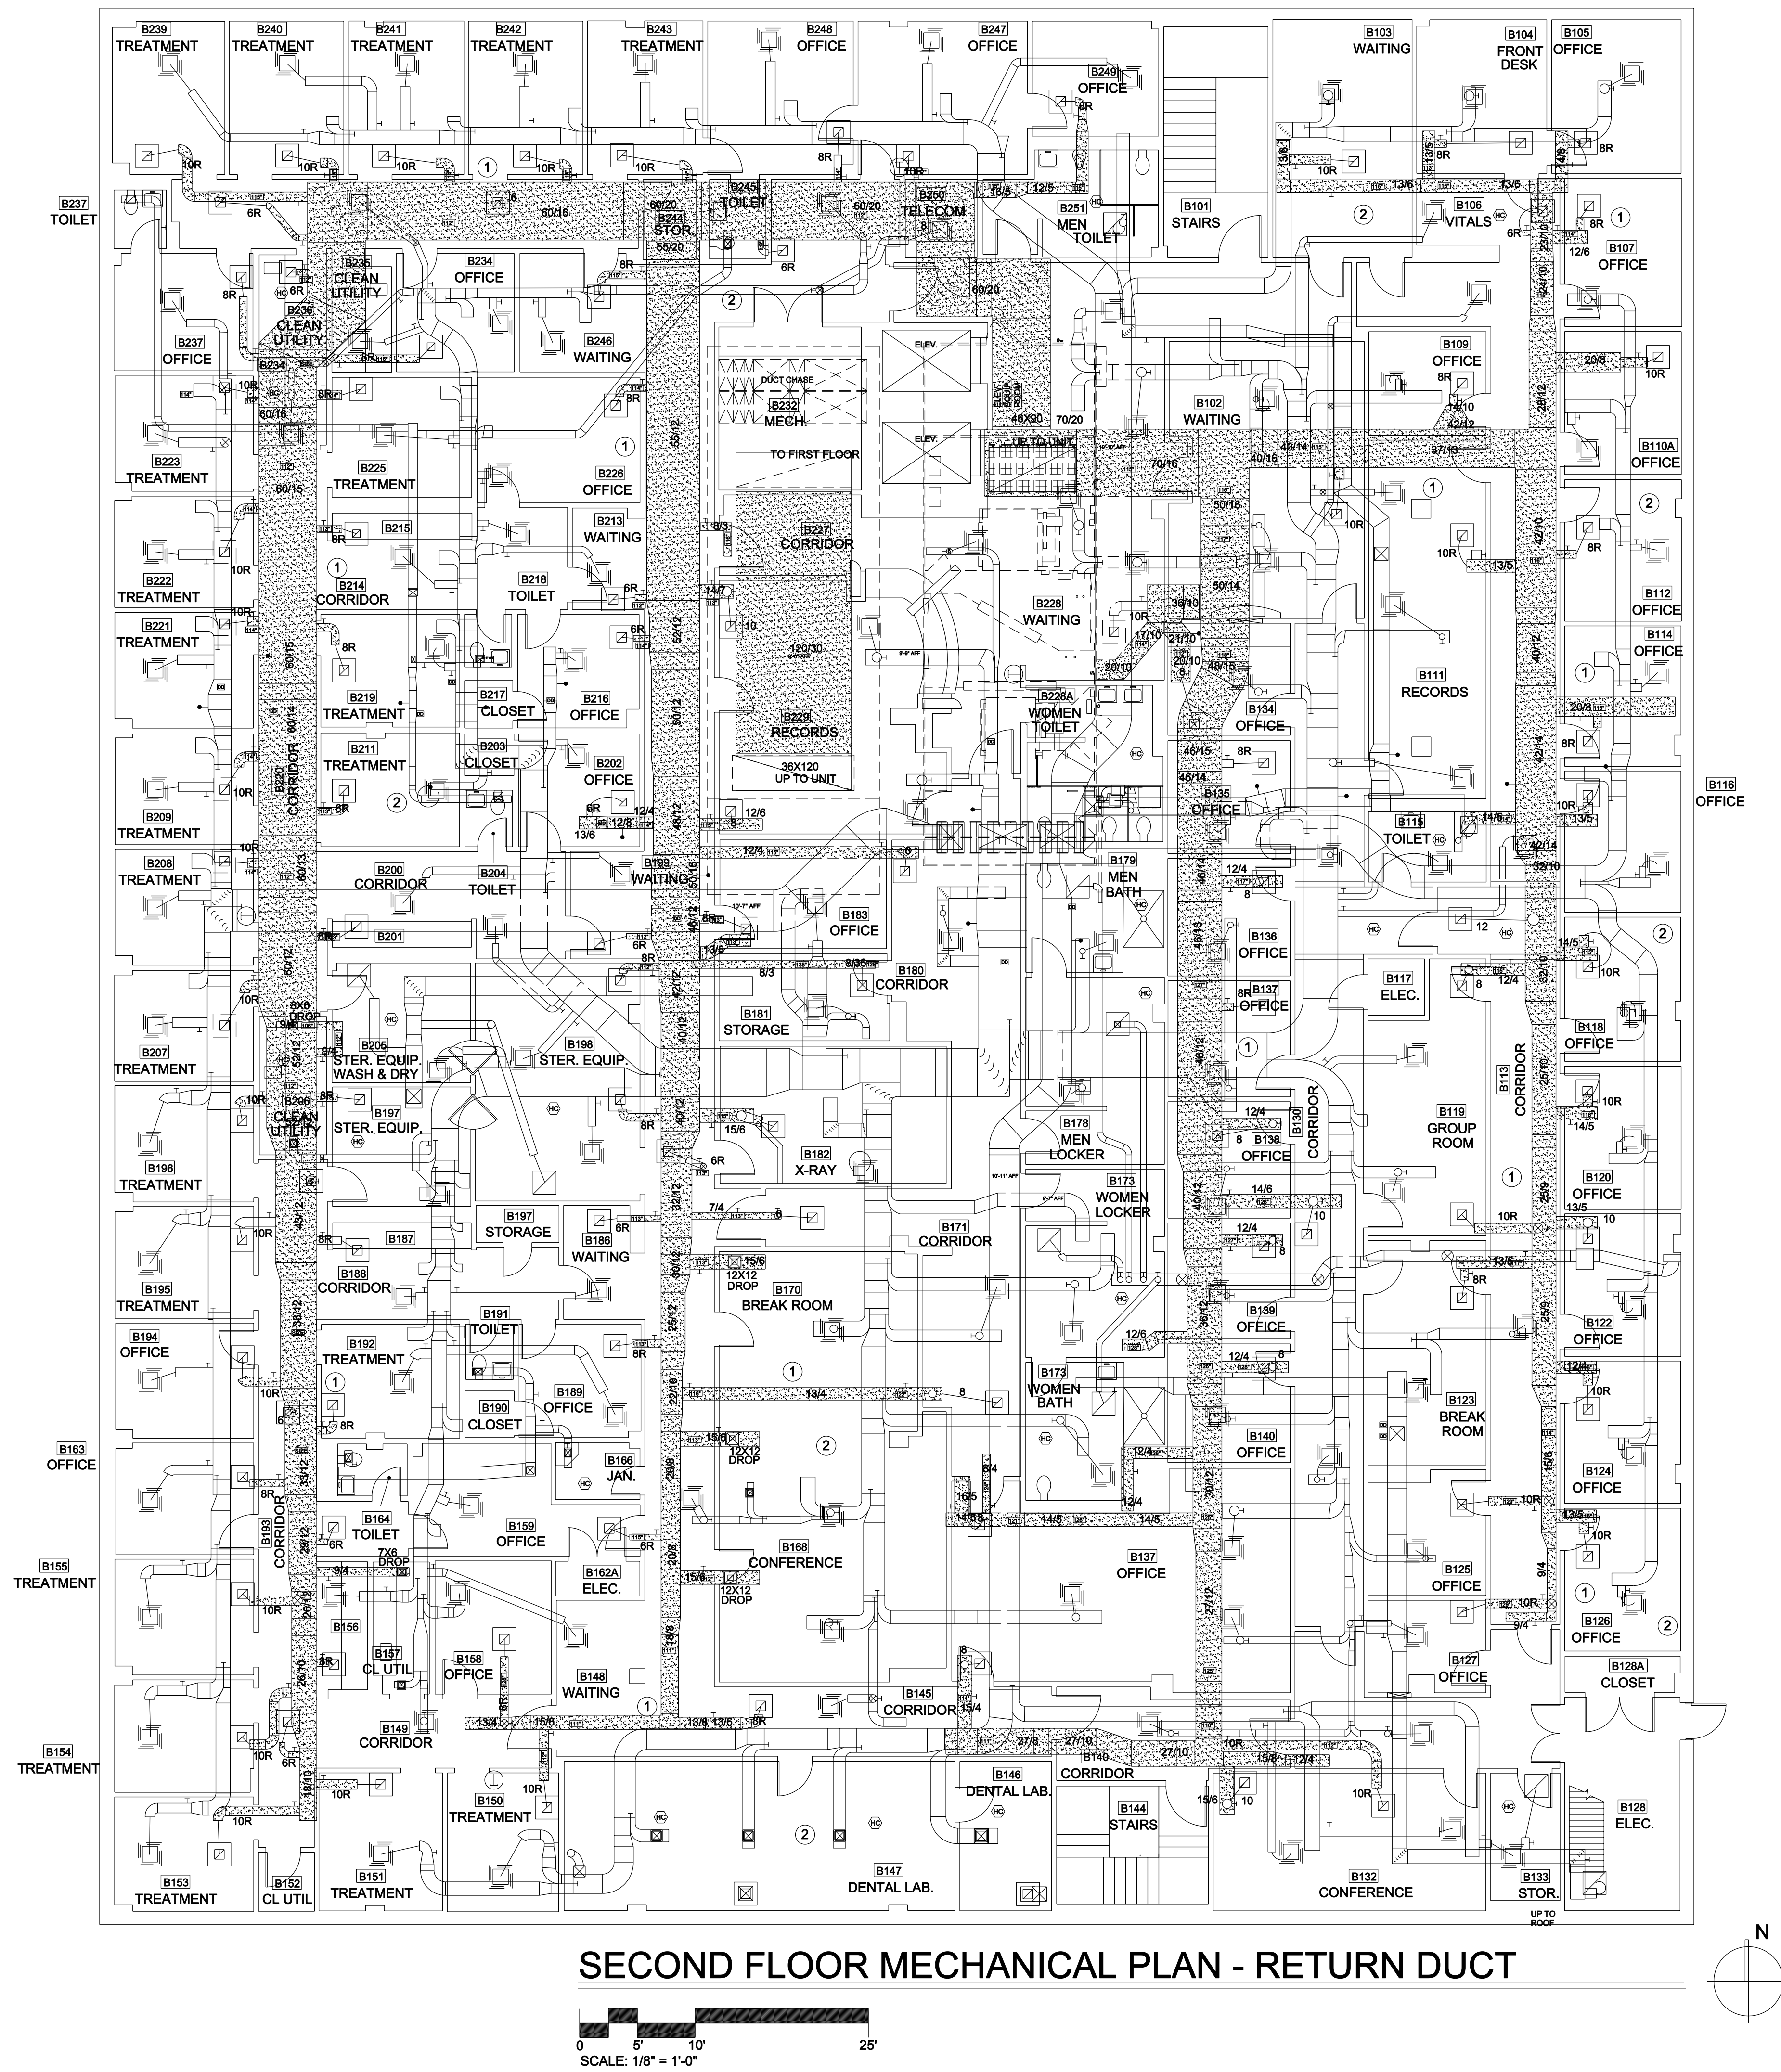

LEGEND	
	EXHAUST GRILLE
	RETURN GRILLE
	SUPPLY GRILLE
	HARD CEILING AREA
	DAMPER LOCATION (BY COLOR)
	ABOVE FINISHED FLOOR HEIGHT (BY COLOR)
	SMOKE DAMPER LOCATION
	DUCT DETECTOR LOCATION
	EXHAUST DUCT
	SUPPLY DUCT
	RETURN DUCT
	HEAT DUCT
	FLEX DUCT (BY COLOR)
	THERMOSTAT LOCATION
	DIGITAL CONTROLLER
	FIRE DAMPER
	PICTURE LOCATION