

LITTLE ROCK A.F.B.
ARKANSAS




1010 Battery St.
Little Rock, AR
72202

501-376-3633

www.GarverUSA.com

CROMWELL
ARCHITECTS ENGINEERS

101 SOUTH SPRING ST
LITTLE ROCK AR 72201
TELEPHONE 501-372-2900
FACSIMILE 501-372-0482

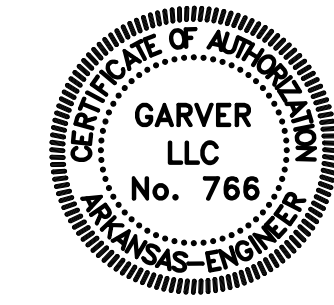

| | | | |
|---|--|---|--|
| PROJECT TITLE REPAIR & RENOVATE MED. CLINIC PH IV A LITTLE ROCK AIR FORCE BASE JACKSONVILLE, ARKANSAS | | SHEET TITLE MECHANICAL ROOF INSTALLATION PLAN | |
| DRAWN BY BMS | LEAD DESIGNER JCF | M-202 | |
| TECH REVIEWER JCF | PROJECT NUMBER NKAK 06-8006 4A | | |
| DESIGNED BY JCF | SHEET | | |
| DATE 13 MAY 2009 | | | |
| SCALE AS SHOWN | | 31 of 51 | |

MECHANICAL ROOF INSTALLATION PLAN