




1. SEE SILVER PACKAGE UNIT SCHEDULE, SHT. MH9 FOR MORE INFORMATION.

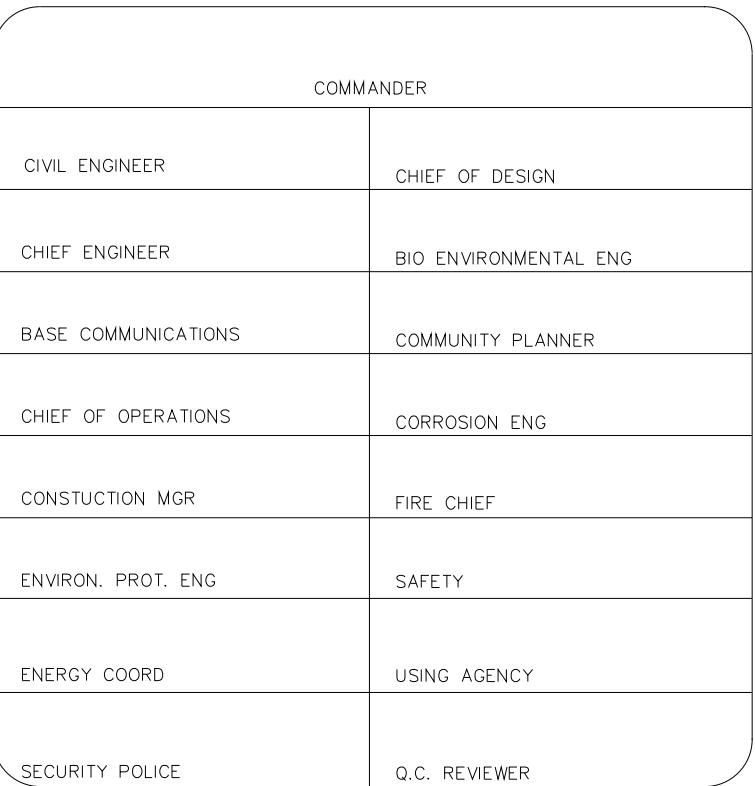

PROJECT TITLE

LITTLE ROCK A.F.B.
BUILDING 1090
PLANS

DRAWN BY KAS	LEAD DESIGNER —
TECH REVIEWER —	FILE LOCATION FILENAME
DESIGNED BY —	PROJECT NUMBER —
DATE 6/23/98	SHEET
SCALE 1" = 20'-0"	MH8 of 54