






 











CEILING LEGEND


LEGEND


	F5: 1X4 FLUORESCENT TROFFER OR WALL WASHER
	F2: 2X4 FLUORESCENT TROFFER
	2X2 FLUORESCENT TROFFER
	F8: INCANDESCENT OR FLUORESCENT FIXTURE - RECESSED
	F10: INCANDESCENT OR FLUORESCENT LIGHT FIXTURE - WALL MOUNTED
	EXIT LIGHT
	UNIVERSAL-MOUNTED DIRECTIONAL ARROWS AS SHOWN ON DRAWINGS
	PENDANT FLUORESCENT FIXTURE
	SEMI-RECESSED DOWN LIGHT FIXTURE
	F18: PENDANT LIGHT FIXTURE
	RADIAL DIMENSION CENTER MARK
	x INDICATES A CHANGE IN CURVE DIMENSION
	 CEILING MOUNTED LIGHT M7405


 SUPPLY DIFFUSERS 2' X 2' OR 1' X 1'


 EXHAUST DIFFUSERS 2' X 2' OR 1' X 1'


 **GYP-SUM BOARD**


 CURTAIN TRACK A5180. REFER TO
CEILING DETAIL #3 ON SHEET A5.20


 SIDE FOLDING SECURITY GATE TRACK

 **SPEAKER**

 OPEN CELL CEILING SYSTEM, W/ 8"x8" LAY-IN
PANEL CELLS

 EGG CRATE LENS

 SUSPENDED ACOUSTICAL CEILING SYSTEM

 FIRE SPRINKLER

ABBREVIATIONS

A.F.F.	AT
ACT	ABOVE FINISHED FLOOR
ADMIN	ACOUSTICAL TILE
ALT	ADMINISTRATION
APPOINT	ALTERNATE
BIO	APPOINTMENT
CFT	BIOLOGICAL
COLL	CERAMIC FLOOR TILE
COMM	COLLECTION
CPT	COMMUNICATION
DIA	CARPET
DIV.	DIAMETER
E	DIVISION
EIFS	ELECTRICAL
ELEC	EXTERIOR INSULATION FINISH SYSTEM
ENG	ELECTRIC
ENT	ENGINEERS
ENVR	EAR, NOSE AND THROAT
EQ.	ENVIRONMENTAL
ETC	EQUAL
EXT.	ETCETERA
F	EXTERIOR
GWB	FEMALE
GYP BD	GYPSUM WALL BOARD
HM	GYPSUM BOARD
IMMUN	HOLLOW METAL
INT.	IMMUNIZATION
LG	INTERIOR
M	LONG
M	MALE
N/A	MECHANICAL
NCOIC	NOT APPLICABLE
NFPA	NON-COMMISSIONED OFFICER IN CHARGE
O.C.	NATIONAL FIRE PROTECTION AGENCY
OPP.	ON CENTER
P	OPPOSITE
P	PAINT
PED	PLUMBING
PREP	PEDIATRIC
ROP	PREPARE
REQ'D	REFLECTED CEILING PLAN
SIM.	REQUIRED
SPEC	SIMILAR
STC	SPECIFICATION
SV	SOUND TRANSMISSION COEFFICIENT
TYP.	SHEET VINYL
VCT	TYPICAL
W/	VINYL COMPOSITION TILE
WD	WITH
	WOOD

MATERIAL SYMBOLS

MATERIAL	SYMBOL
CONCRETE	
CONCRETE BLOCK	
DIMENSION LUMBER	
FINISH LUMBER	
BATT INSULATION	
RIGID INSULATION	
ACOUSTICAL TILE	
GYPSUM WALL BOARD / PLASTER	
GLAZING (PLAN)	
GLAZING (ELEVATION)	
EXISTING CONSTRUCTION TO REMAIN	
NEW CONSTRUCTION	
EXISTING CONSTRUCTION TO BE DEMOLISHED	


ARCHITECTURAL SYMBOLS



NORTH REFERENCE

5 TITLE


INTERIOR ELEVATION

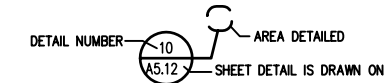

DETAIL REFERENCE (ON PLAN)




PARTITION TYPE IDENTIFICATION

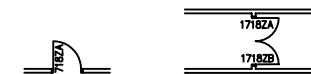

DOORS ARE TO RECEIVE THE NUMBER OF ROOM WHICH IT SERVES. IF MORE THAN ONE DOOR SERVES A ROOM A LETTER DESIGNATION FOLLOWS THE DOOR NUMBER.



NEW DOOR

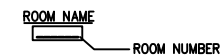

ROOM IDENTIFICATION

5 TITLE

DETAIL, SECTION OR ELEVATION

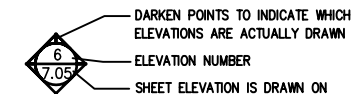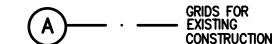ELEVATION REFERENCE (ON PLAN)

A-R ARE NORTH/SOUTH COLUMN GRID LINES.


1-9 DESIGNATES EAST/WEST CONCRETE
COLUMN GRID LINES.

STRUCTURAL GRIDS

(8'-6")

CEILING ELEVATION HEIGHT
ABOVE FINISHED FLOOR

ELEVATION MARKS

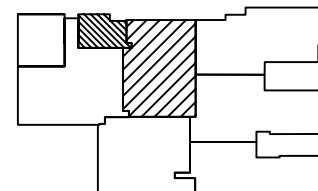

**LITTLE ROCK A.F.B.
ARKANSAS**

[illegible]

PROJECT TITLE
REPAIR MEDICAL CENTER PH 3
LITTLE ROCK AFB, ARKANSAS

ARCHITECTURAL SYMBOLS

DRAWN BY RJR	LEAD DESIGNER AM
TECH AM	PROJECT NUMBER NKAK 06-8001
DESIGNED BY AM	SHEET
DATE 8-11-06	A0.00
SCALE N/A	4 of 37