




LITTLE ROCK A.F.B.
ARKANSAS

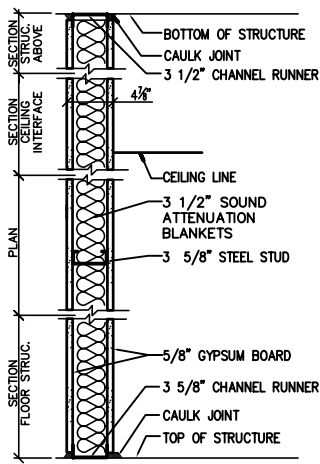


FIRE RESISTANCE RATING : NONE
STC RATING : 45-50

PARTITION TYPE 1

FIRE RESISTANCE RATING : 1 HOUR
STC RATING : 45-50
UL ASSEMBLY DESIGN NO. U465

PARTITION TYPE 1C


N.T.S.

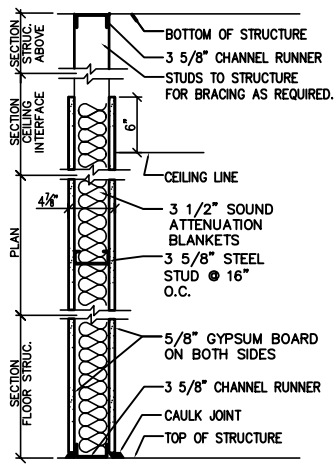

FIRE RESISTANCE RATING : NONE
STC RATING : 40

PARTITION TYPE 1B


N.T.S.

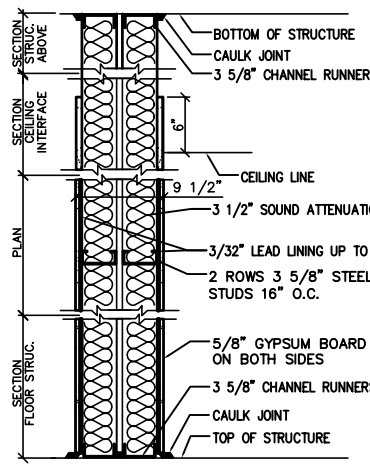

FIRE RESISTANCE RATING : NONE
STC RATING : 40

PARTITION TYPE 2


N.T.S.

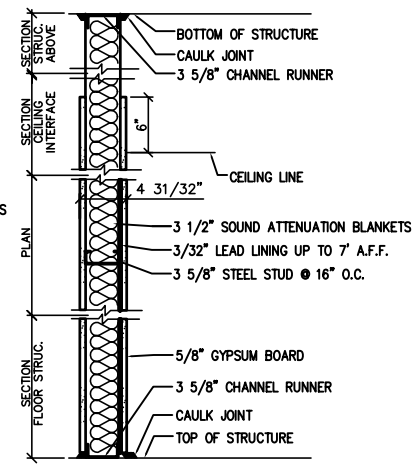

FIRE RESISTANCE RATING : NONE
STC RATING : 40

PARTITION TYPE 3


N.T.S.

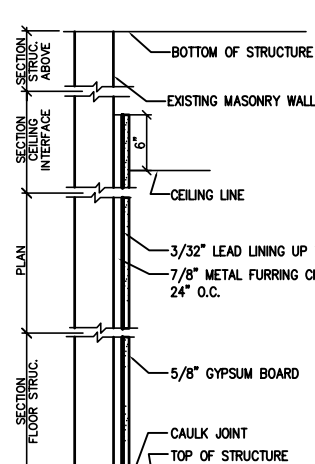

FIRE RESISTANCE RATING : NONE
STC RATING :

PARTITION TYPE 4

N.T.S.

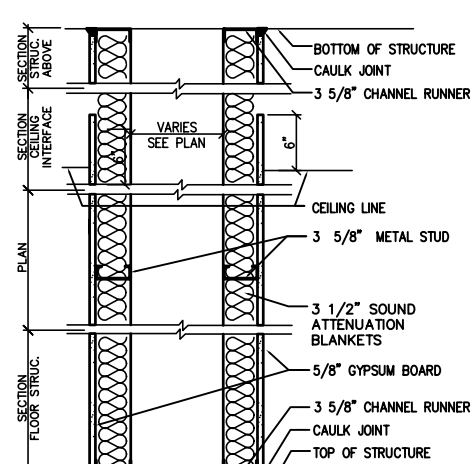


FIRE RESISTANCE RATING : NONE
STC RATING : 50

PARTITION TYPE 5

N.T.S.

GENERAL NOTES:


1. FIRE RESISTANCE RATING SHOWN FOR ONE HOUR PARTITIONS APPLY WHERE NOTED ON FLOOR/FIRE CODE PLANS. IF PARTITION IS NON-RATED CONSTRUCTION FROM FLOOR TO STRUCTURE ABOVE THIS IS TO PROVIDE ACOUSTICAL CONTROL. SEE "PARTITION TYPE 1" DETAIL.
2. WATER RESISTANT BOARD SUBSTITUTED FOR LAYER OF GYPSUM BOARD DIRECTLY BENEATH CERAMIC TILE WALL FINISH.
3. ALL PARTITION TYPES TO BE FIRE TAPED AND SEALED TO STRUCTURE ABOVE WHERE FIRE RATINGS ARE REQUIRED.
4. FOLLOW UL ASSEMBLY REQUIREMENTS AS NOTED.

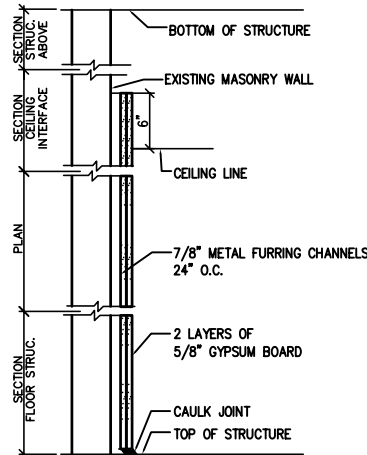

FIRE RESISTANCE RATING : NONE
STC RATING :

PARTITION TYPE 6


N.T.S.

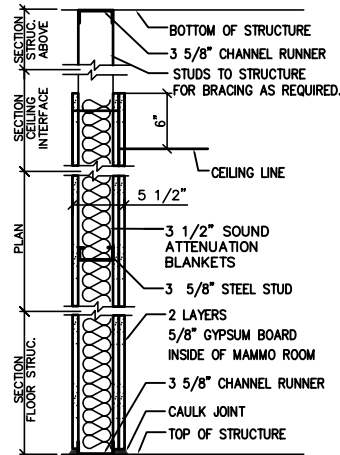

FIRE RESISTANCE RATING : NONE
STC RATING : 40

PARTITION TYPE 7

N.T.S.

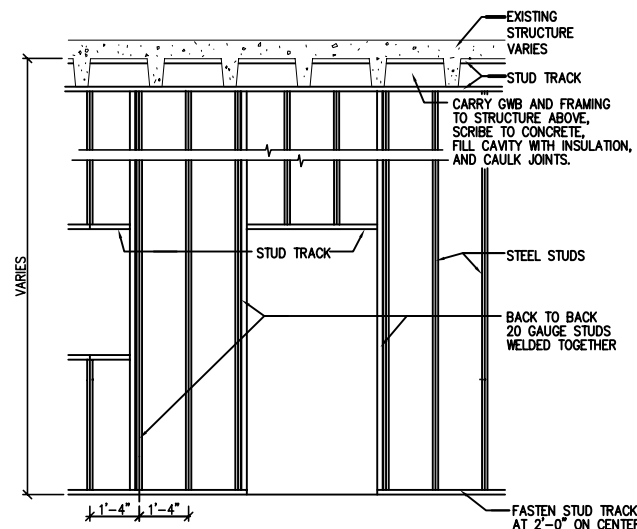


NOTE: PROVIDE BACK TO BACK CASING BEADS FROM DOOR HEAD TO STRUCTURE ON BOTH SIDES OF WALL

TYPICAL INTERIOR STUD WALL CONSTRUCTION

N.T.S.

1A WINDOW ELEVATION A


SCALE 1/2"=1'-0"

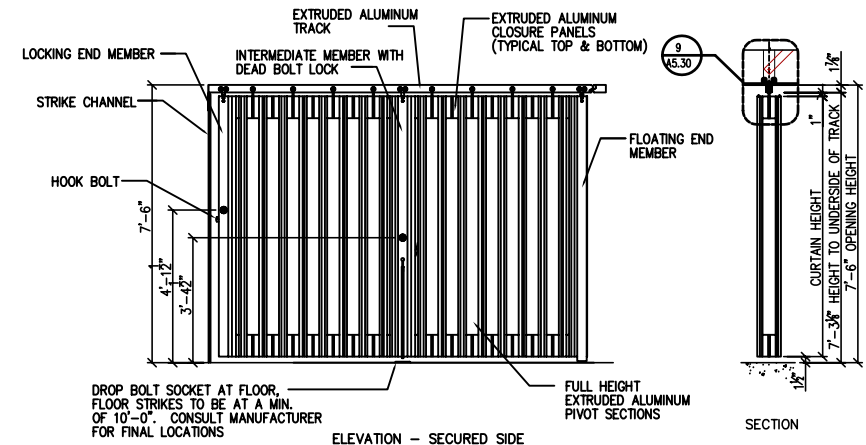

1B SHUTTER ELEVATION B


N.T.S.

NOTE:
CONSULT MANUFACTURER FOR CUSTOM
CURVED TRACK AND CLOSURES.
DIAGRAMS SHOWN FOR CONCEPT.
MANUFACTURER TO ISSUE WORKING
DRAWINGS AND ADDITIONAL SPECIFICATIONS

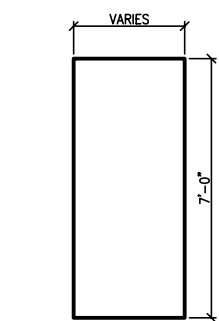


2 DOOR ELEVATION A

SCALE 1/2"=1'-0"

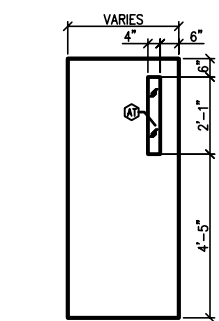


3 DOOR ELEVATION B

SCALE 1/2"=1'-0"

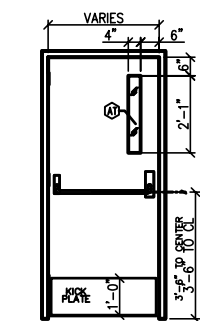


4 DOOR ELEVATION C

SCALE 1/2"=1'-0"

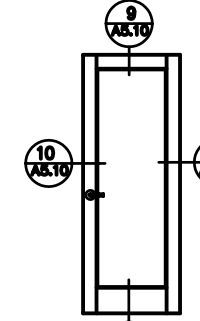


5 DOOR ELEVATION D

SCALE 1/2"=1'-0"

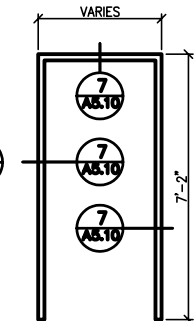


6 DOOR FRAME A

SCALE 1/2"=1'-0"

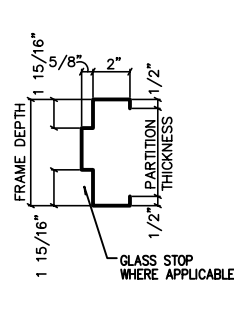


7 BUCK PROFILE

N.T.S.

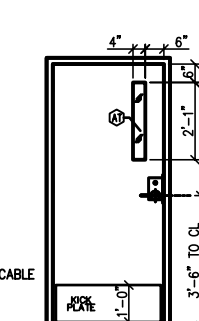


8 MORTISE LOCK

SCALE 1/2"=1'-0"

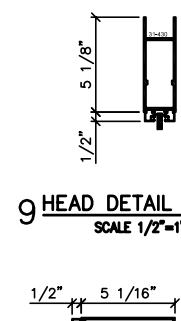


9 HEAD DETAIL

SCALE 1/2"=1'-0"

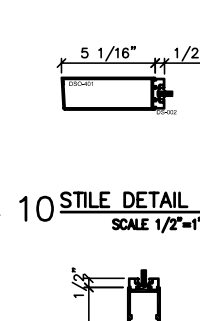


10 STILE DETAIL

SCALE 1/2"=1'-0"

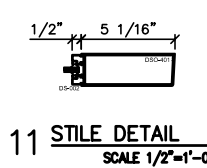


11 STILE DETAIL

SCALE 1/2"=1'-0"

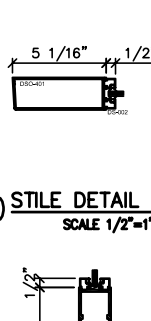

12 BOTTOM RAIL DETAIL


SCALE 1/2"=1'-0"

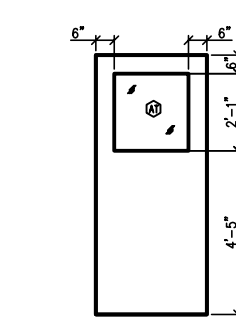

13 DOOR ELEVATION E

SCALE 1/2"=1'-0"

KEYPLAN
N.T.S.

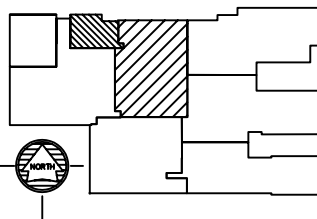

PROJECT TITLE
REPAIR MEDICAL CENTER PH 3
LITTLE ROCK AFB, ARKANSAS

SHEET TITLE
DOORS, FRAMES &
PARTITION TYPES

DRAWN BY RJR	LEAD DESIGNER AM
TECH REVIEWER AM	PROJECT NUMBER NKAK 06-8001
DESIGNED BY AM	SHEET
DATE 8-11-06	A5.10
SCALE AS NOTED	14 of 37