



Surfs
no pen
table
\$3000
\$4000

6

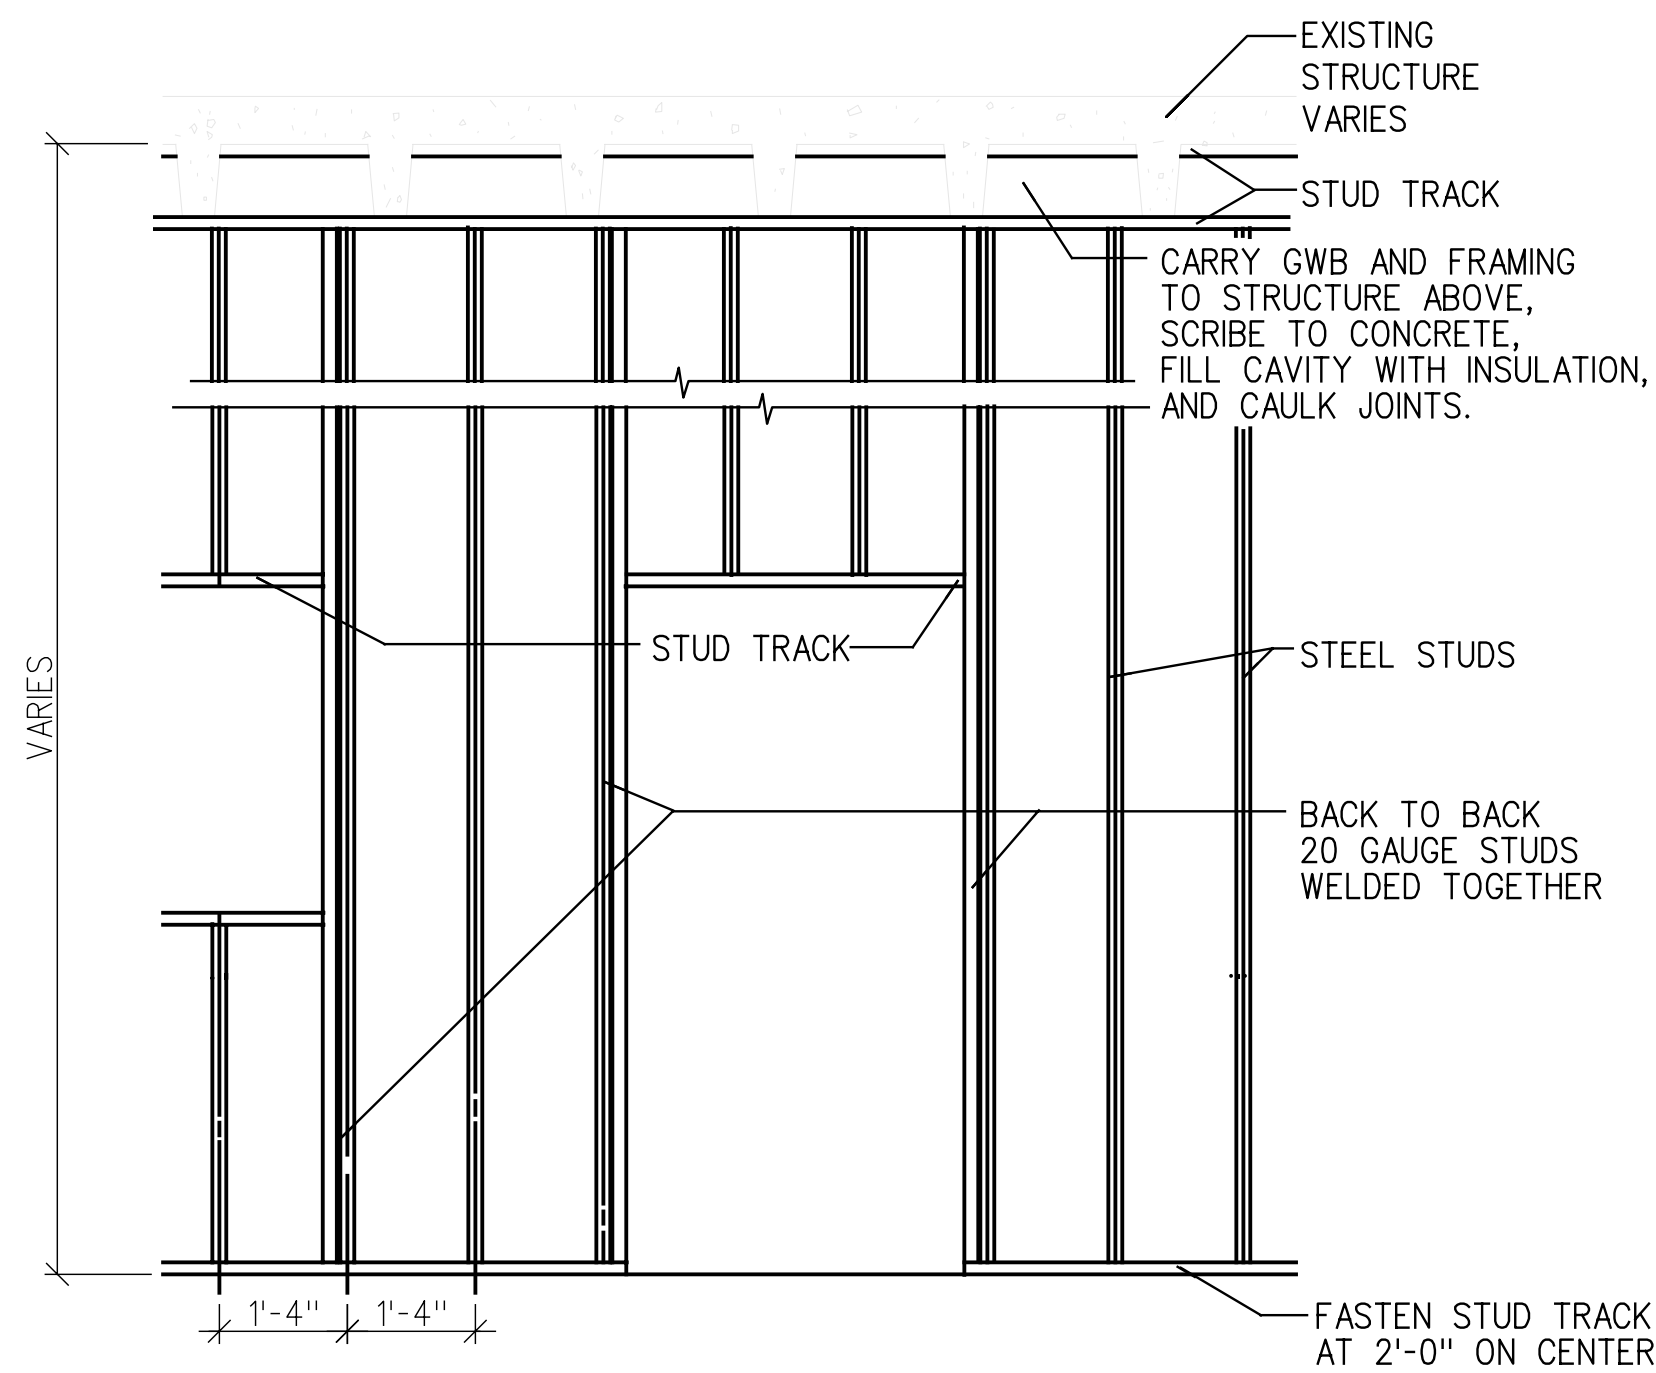

NOTE: PROVIDE BACK TO BACK CASING BEADS FROM DOOR HEAD TO STRUCTURE ON BOTH SIDES OF WALL

TYPICAL INTERIOR STUD WALL CONSTRUCTION
NOT TO SCALE

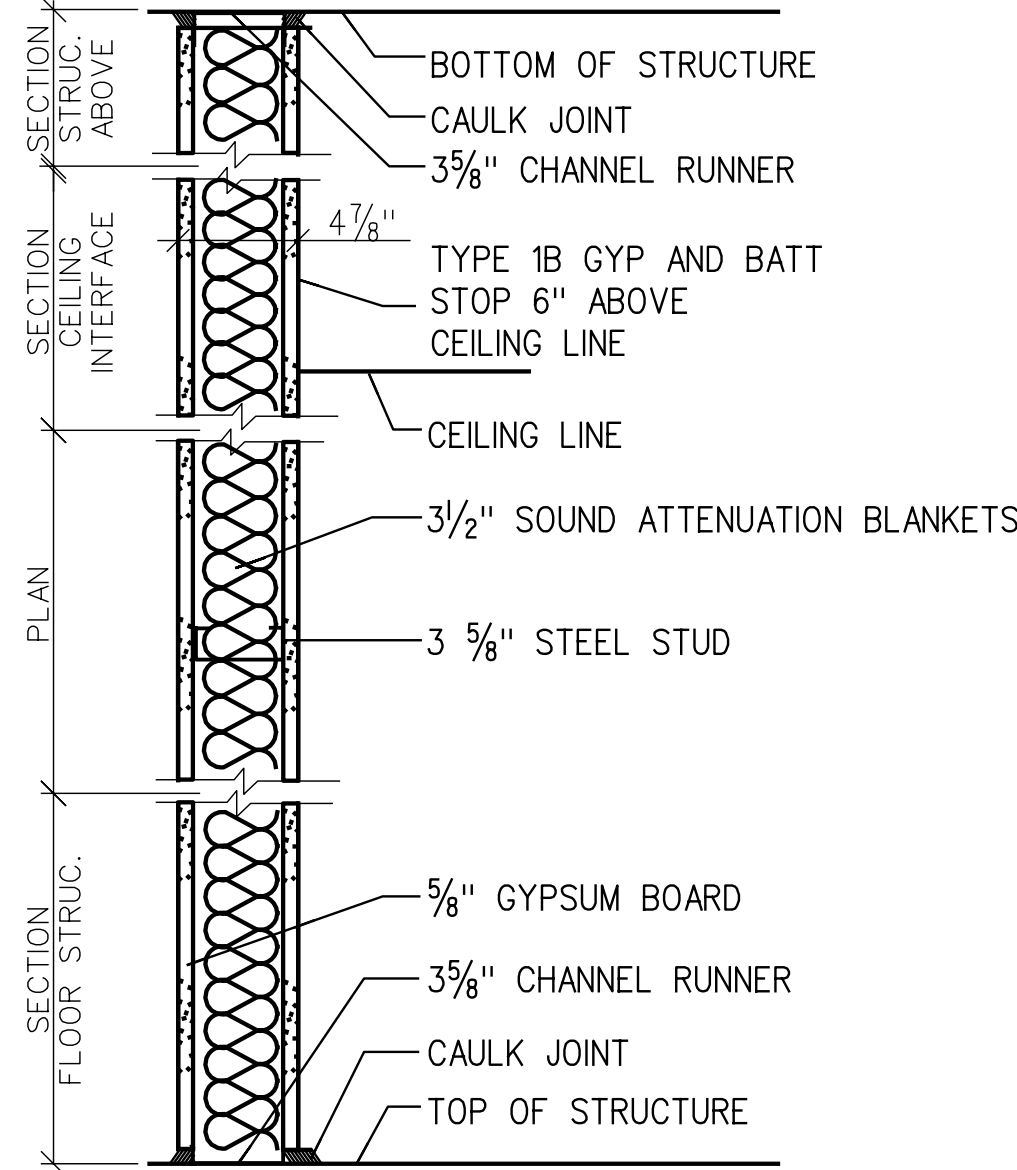


FIRE RESISTANCE RATING : NONE
STC RATING : 45-50

PARTITION TYPE 1


FIRE RESISTANCE RATING : 1 HOUR
STC RATING : 45-50
UL ASSEMBLY DESIGN NO. U465

PARTITION TYPE 1C
1 1/2" - 1'-0"

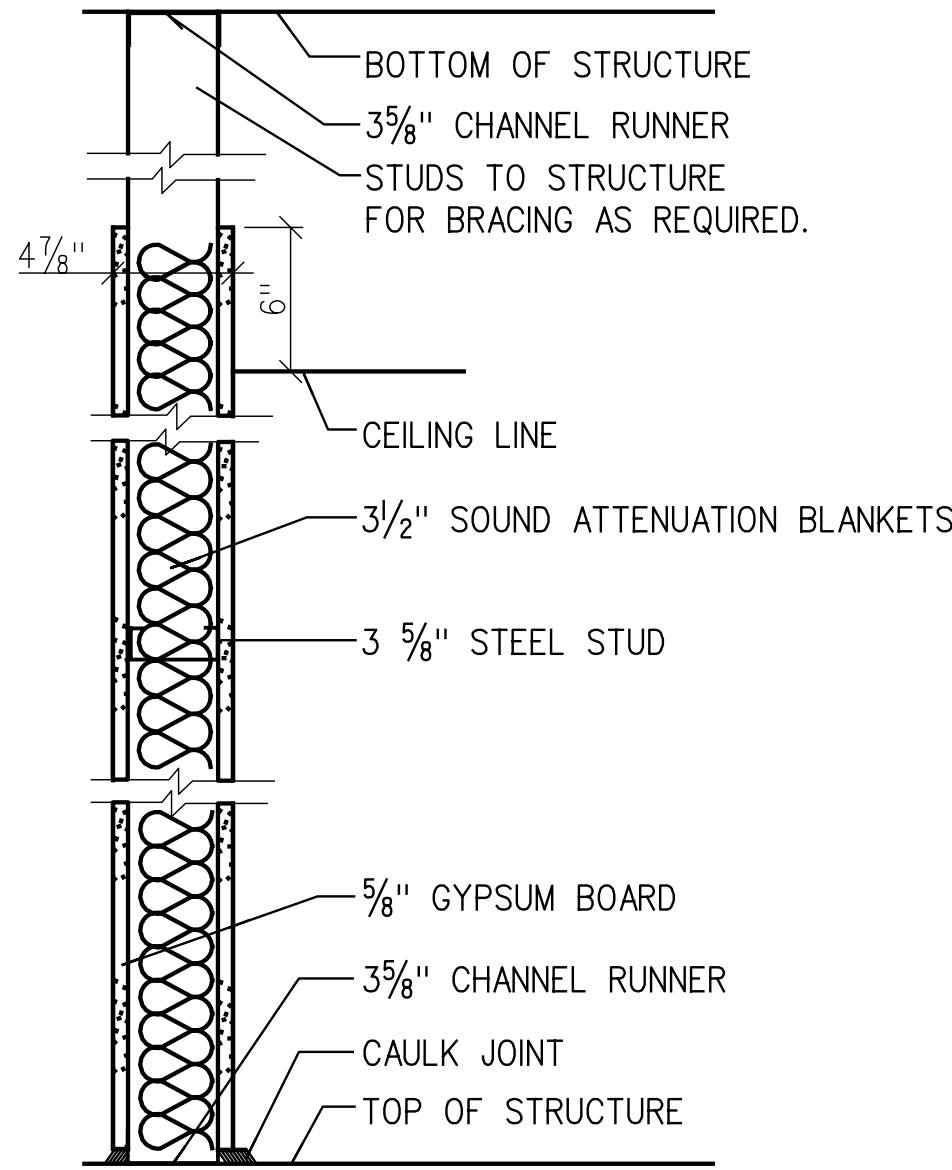


FIRE RESISTANCE RATING : NONE
STC RATING : 40

PARTITION TYPE 1B

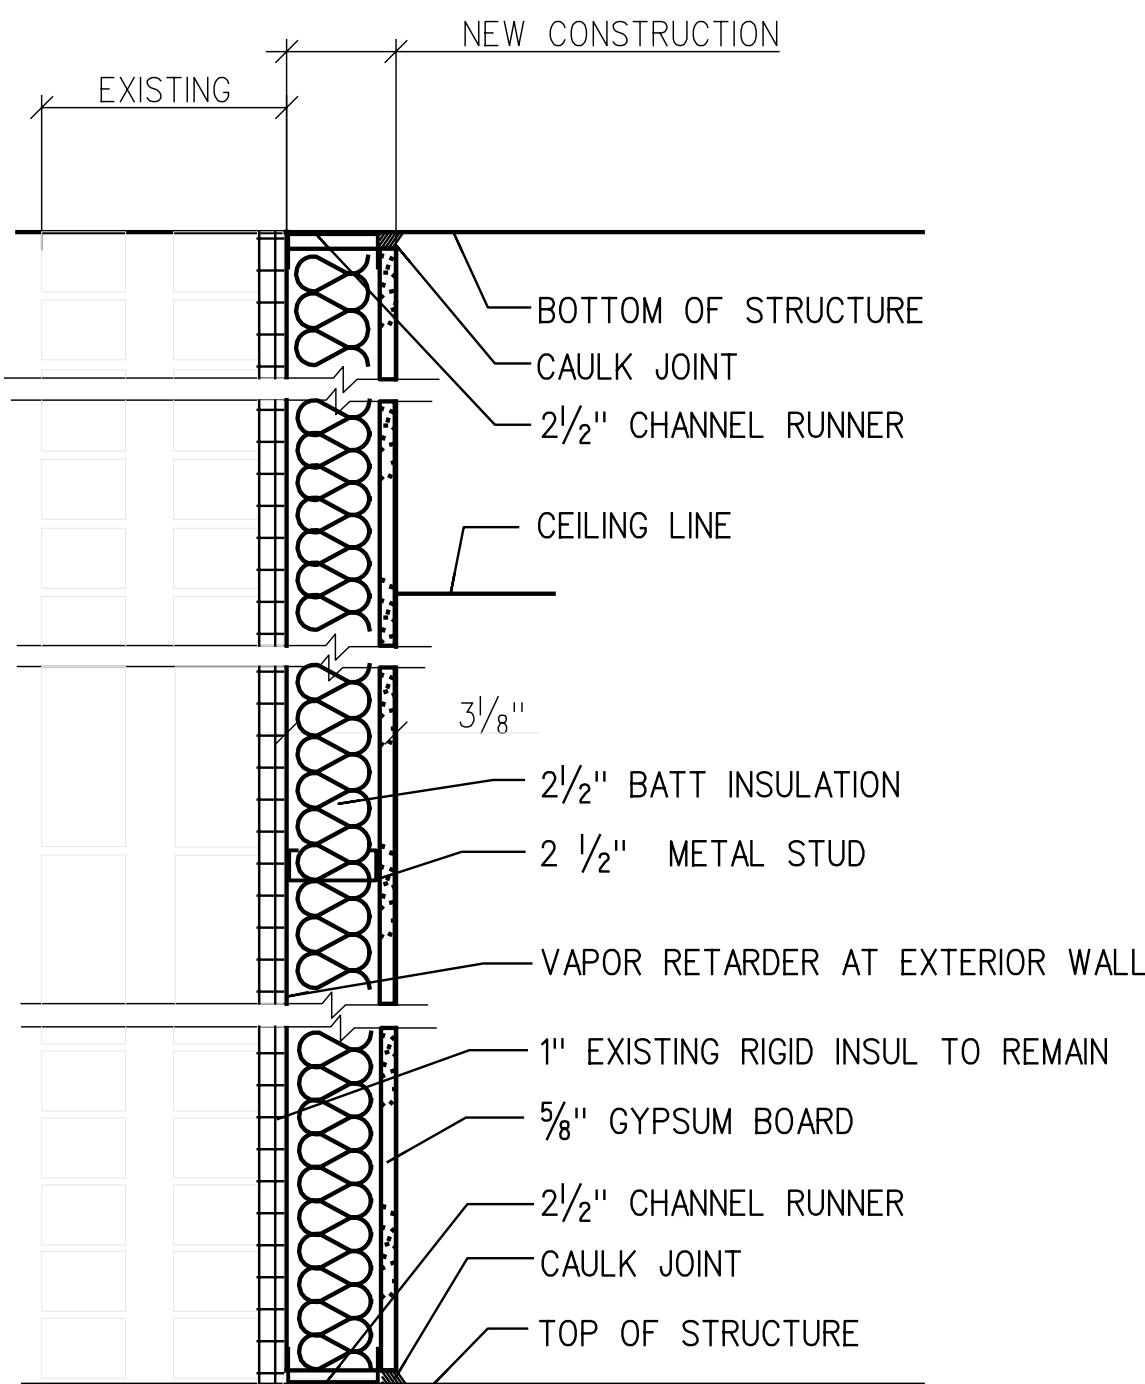


FIRE RESISTANCE RATING: NONE
STC RATING: NONE

PARTITION TYPE 2
1 1/2" - 1'-0"

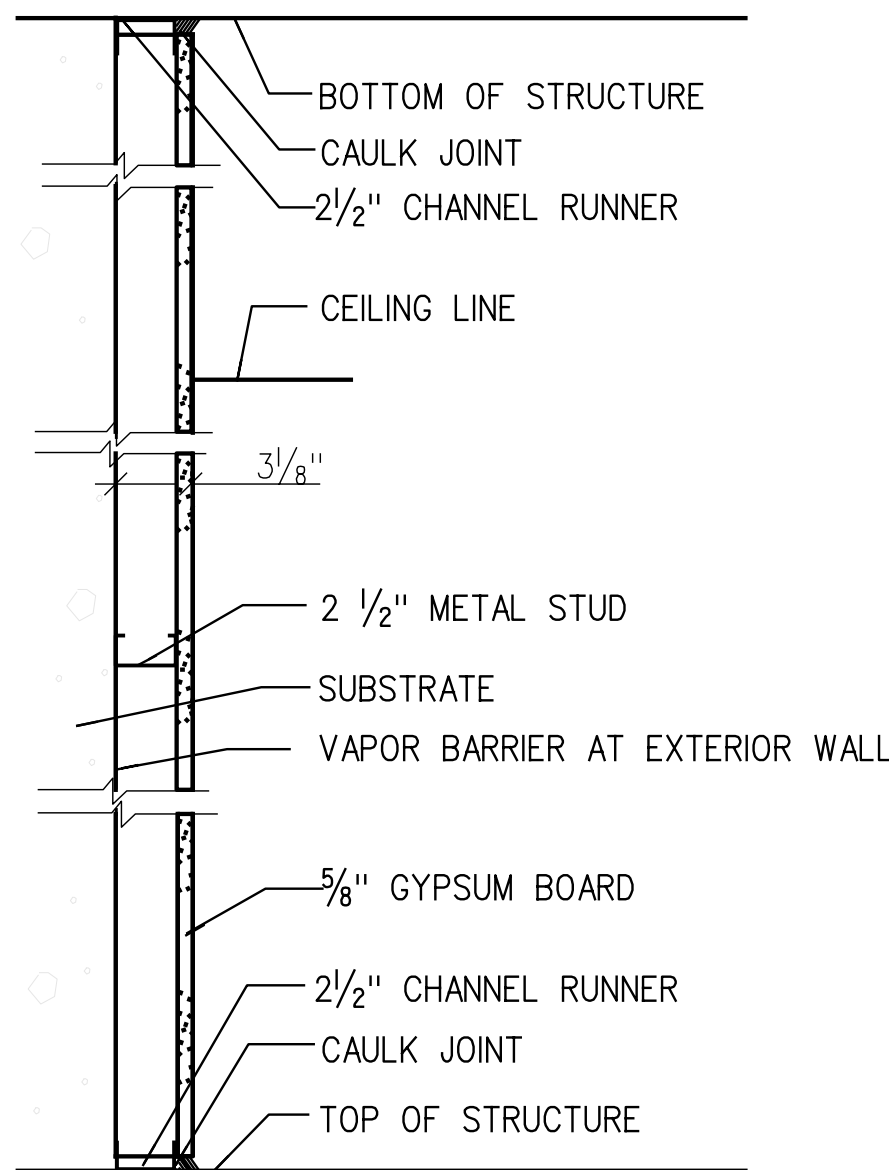


FIRE RESISTANCE RATING: NONE
STC RATING: NONE

PARTITION TYPE 3
1 1/2" - 1'-0"

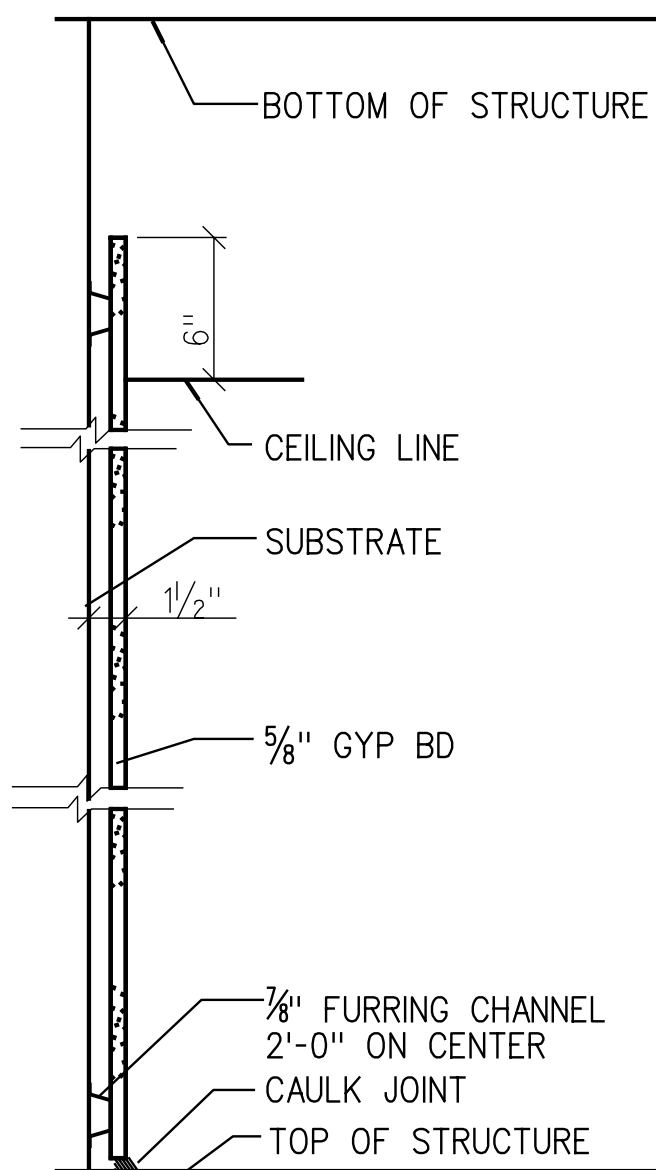


FIRE RESISTANCE RATING: NONE
STC RATING: NONE

PARTITION TYPE 4
1 1/2" - 1'-0"

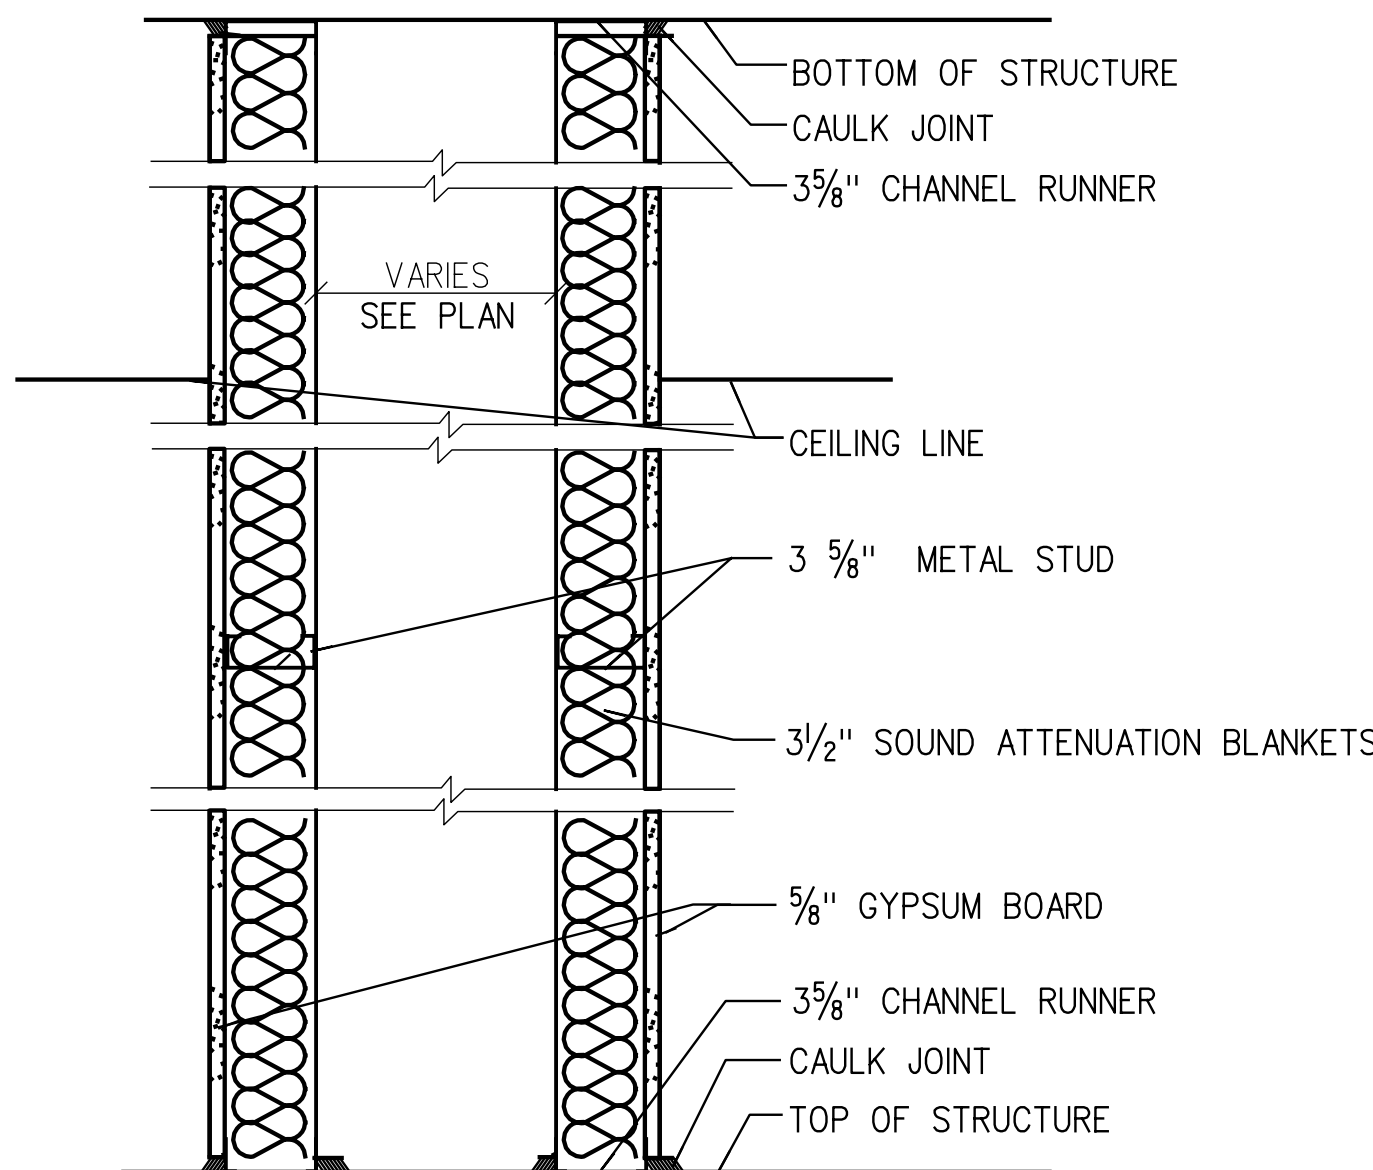

FIRE RESISTANCE RATING : NONE
STC RATING : 50

PARTITION TYPE 5
1 1/2" - 1'-0"

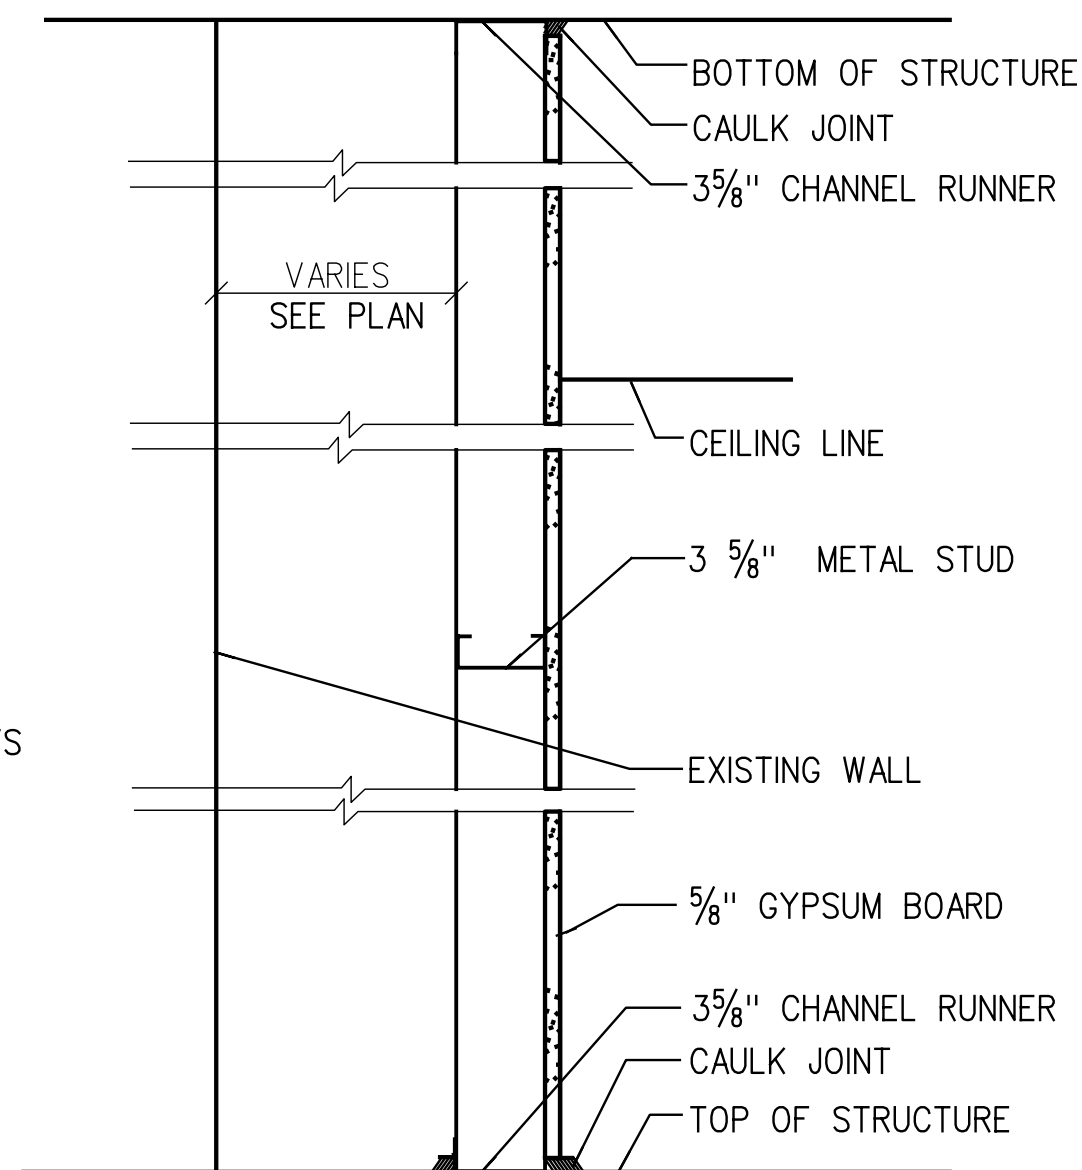

FIRE RESISTANCE RATING : NONE
STC RATING : NONE

PARTITION TYPE 6
1 1/2" - 1'-0"

GENERAL NOTES:

1. FIRE RESISTANCE RATING SHOWN FOR ONE HOUR PARTITIONS APPLY WHERE NOTED ON FLOOR/FIRE CODE PLANS. IF PARTITION IS NON-RATED CONSTRUCTION FROM FLOOR TO STRUCTURE ABOVE THIS IS TO PROVIDE ACOUSTICAL CONTROL. SEE "PARTITION TYPE 1" DETAIL.
2. WATER RESISTANT BOARD SUBSTITUTED FOR LAYER OF GYPSUM BOARD DIRECTLY BENEATH CERAMIC TILE WALL FINISH. SEE ROOM FINISH SCHEDULE A4.10, A4.11, A4.12 FOR SPECIFIC LOCATIONS.
3. ALL PARTITION TYPES TO BE FIRE TAPED AND SEALED TO STRUCTURE ABOVE WHERE FIRE RATINGS ARE REQUIRED.
4. FOLLOW UL ASSEMBLY REQUIREMENTS AS NOTED.

REVISIONS	DATE	DESCRIPTION	APPROVED
1	8/01/2005	REVISIONS AS BUILT	
2	10/31/2003	ISSUED FOR FINAL WORK PLAN	
3	10/01/2003	ISSUED FOR BID	

DESIGNED BY: DATE: 10/10/2003	DRAWN BY: PROJECT NO.: 61503	CHECKED BY: DRAWING CODE: -	REVIEWED BY: SOLICITATION NUMBER: -
U.S. ARMY ENGINEERING AND SUPPORT CENTER CORPS OF ENGINEERS HUNTSVILLE, ALABAMA		EARTHTECH 2000 Huntsville, TN 35894-0001	

RENOVATE CLINIC
BUILDING 1090
LITTLE ROCK AFB, ARKANSAS

**PARTITION TYPES
AS-BUILT**

SHEET
REFERENCE
NUMBER:
A5.10
SHEET X OF XX

6

5

4

3

2

1