



1 DETAIL AT FORM BUILD-OUT

SCALE 1 1/2"=1'-0"

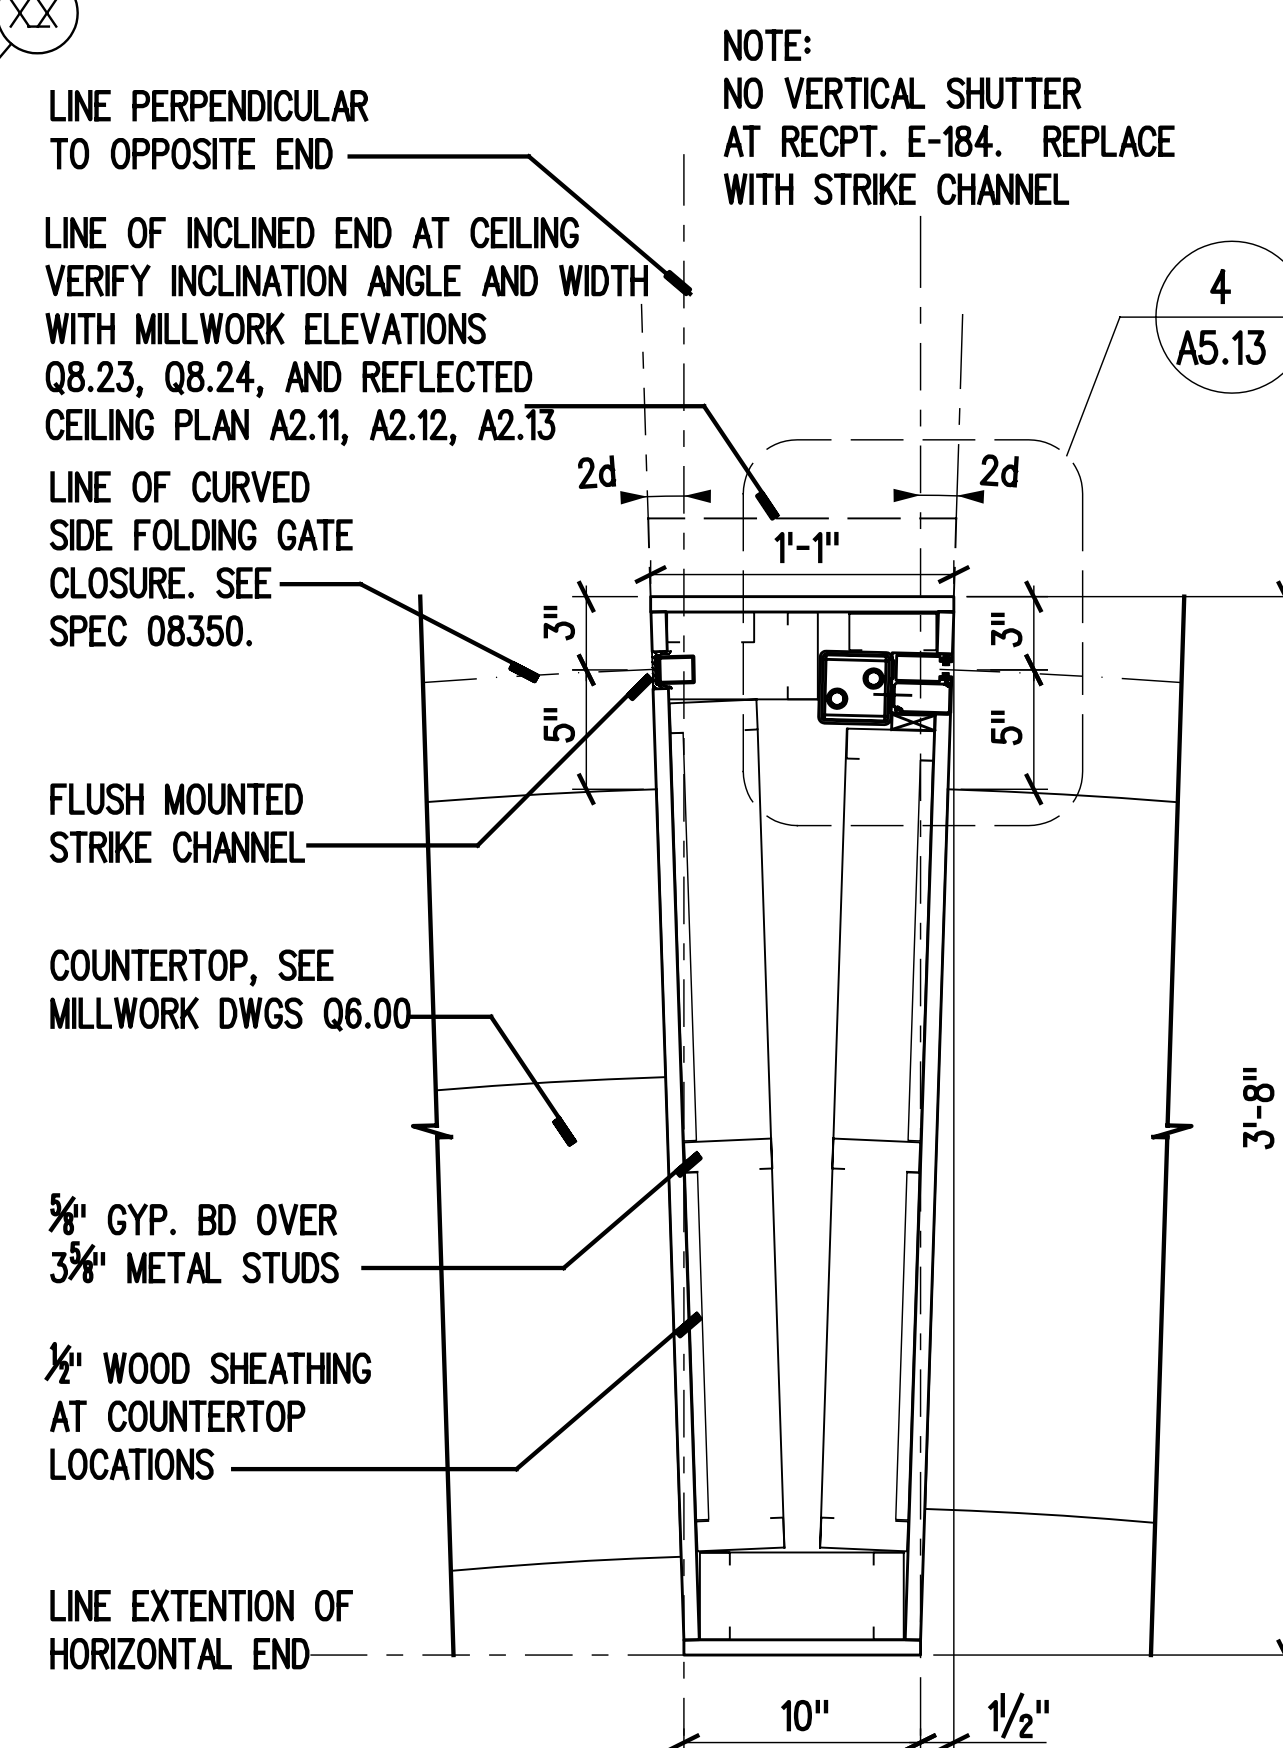


2 DETAIL AT FORM BUILD-OUT

SCALE $1\frac{1}{2}"=1'-0"$

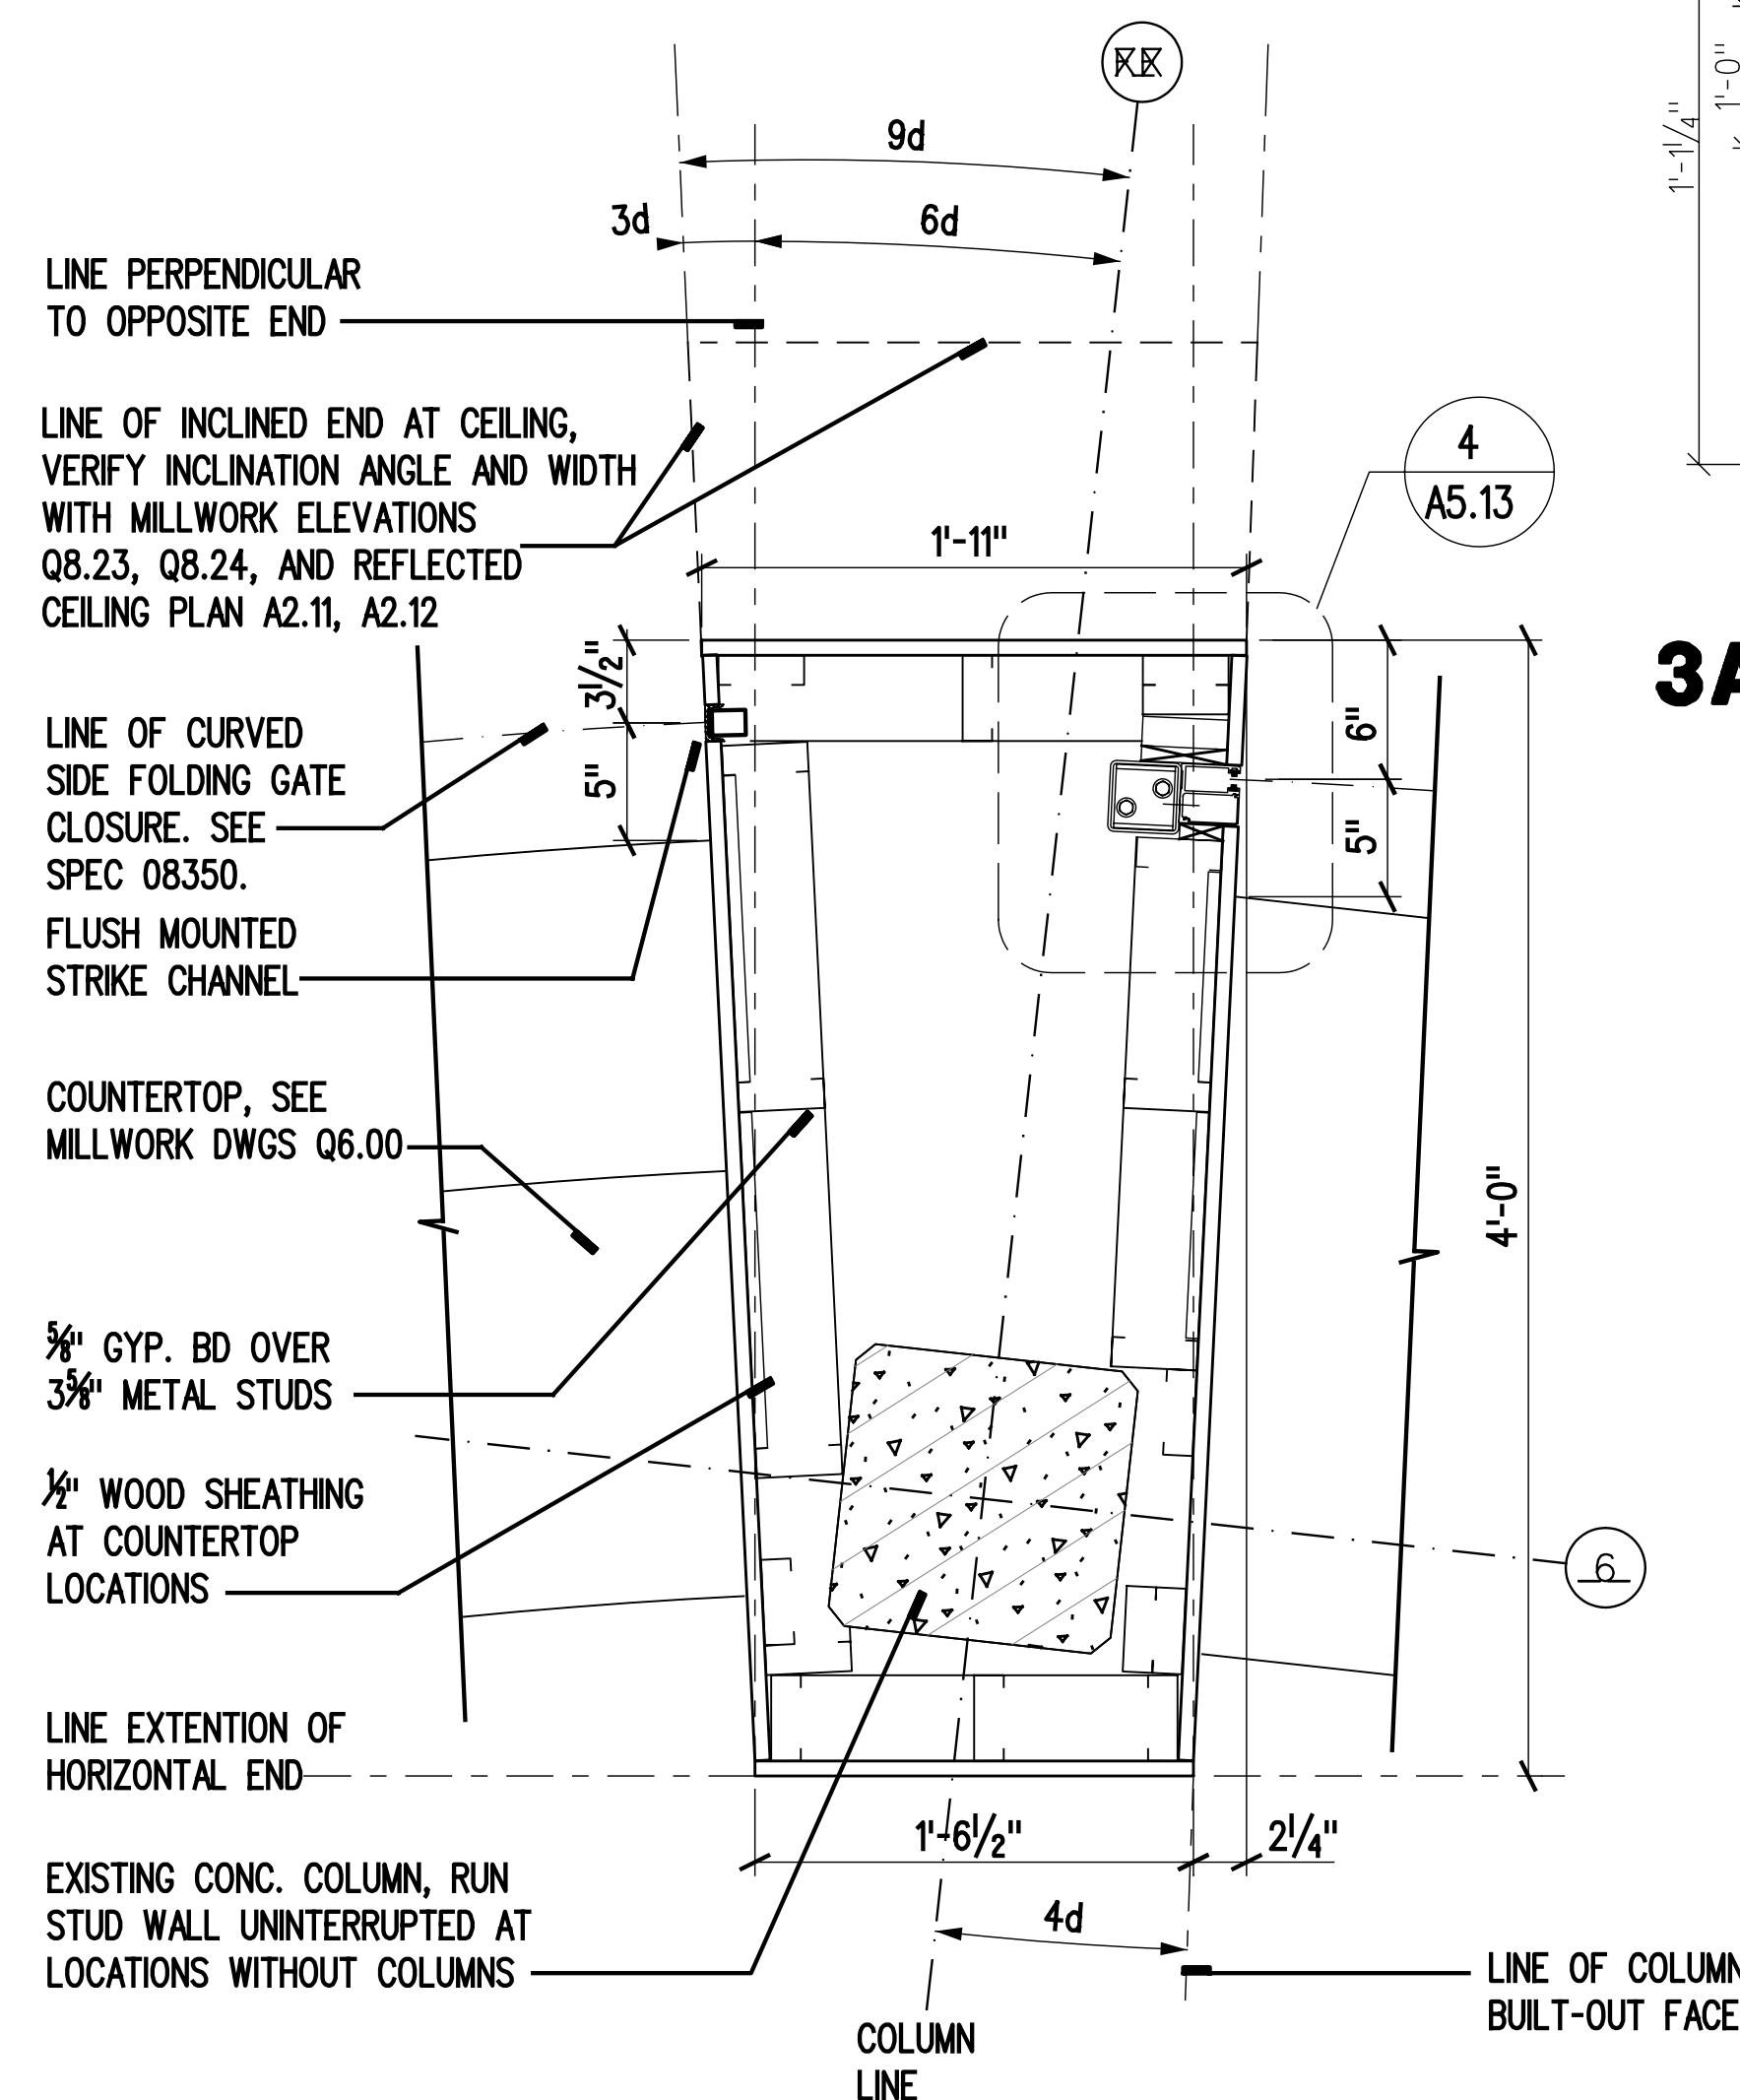


3 DETAIL AT FORM BUILD-OUT

SCALE 1 1/2"=1'-0"

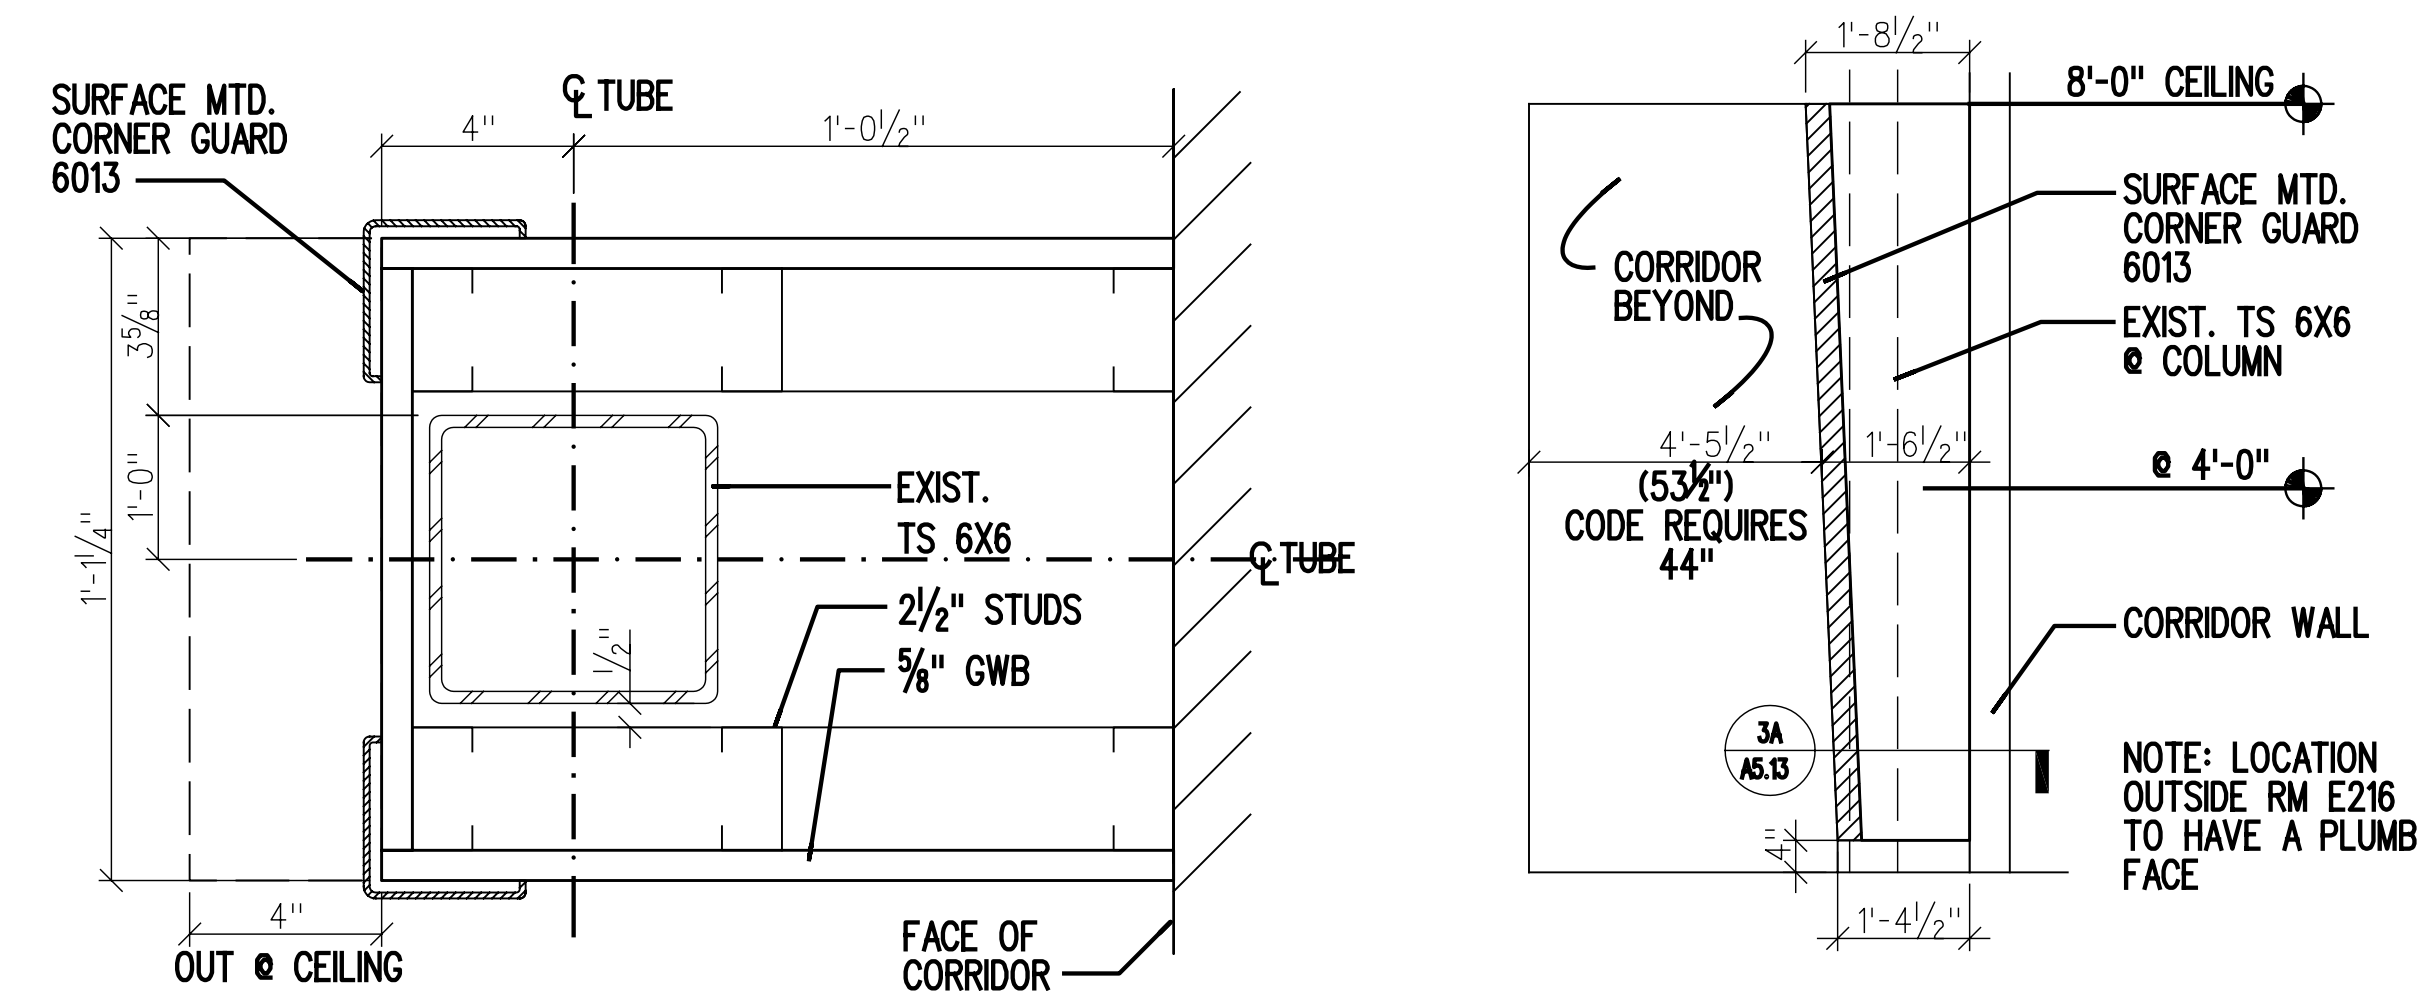


3A COLUMN DETAIL

SCALE 3"=1'-0"

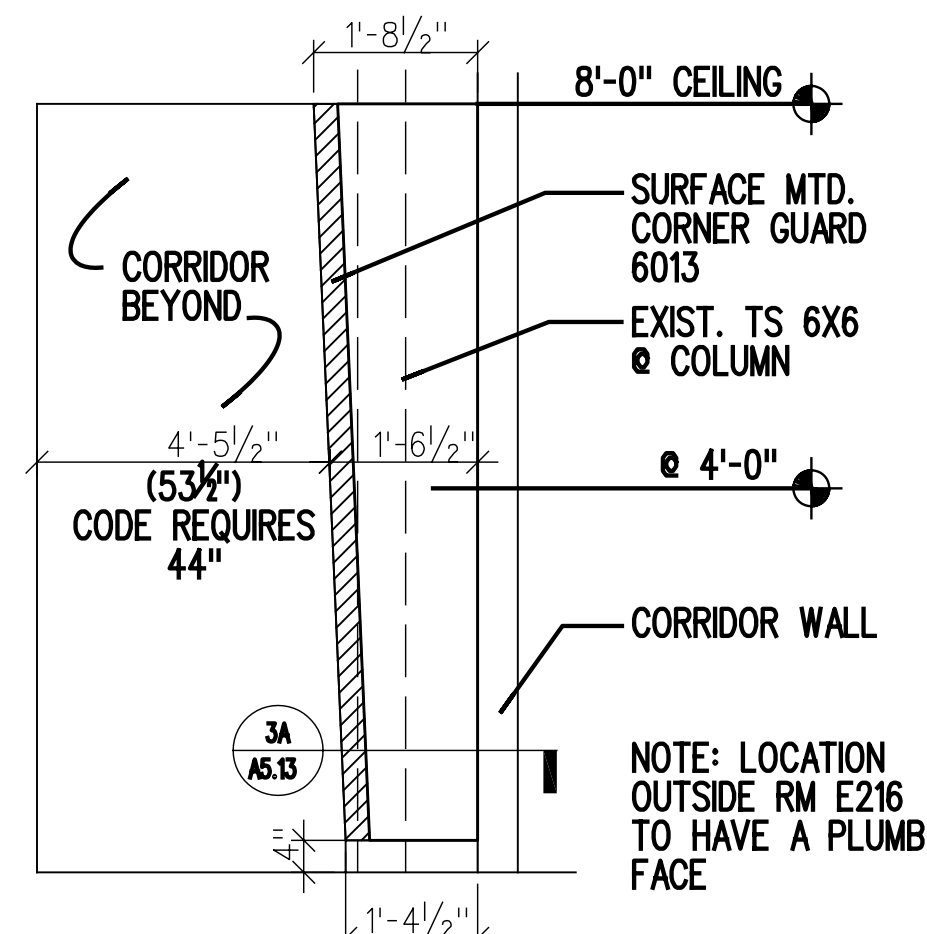

3B COLUMN ELEVATION⁴


SCALE 1/2"=1'-0"

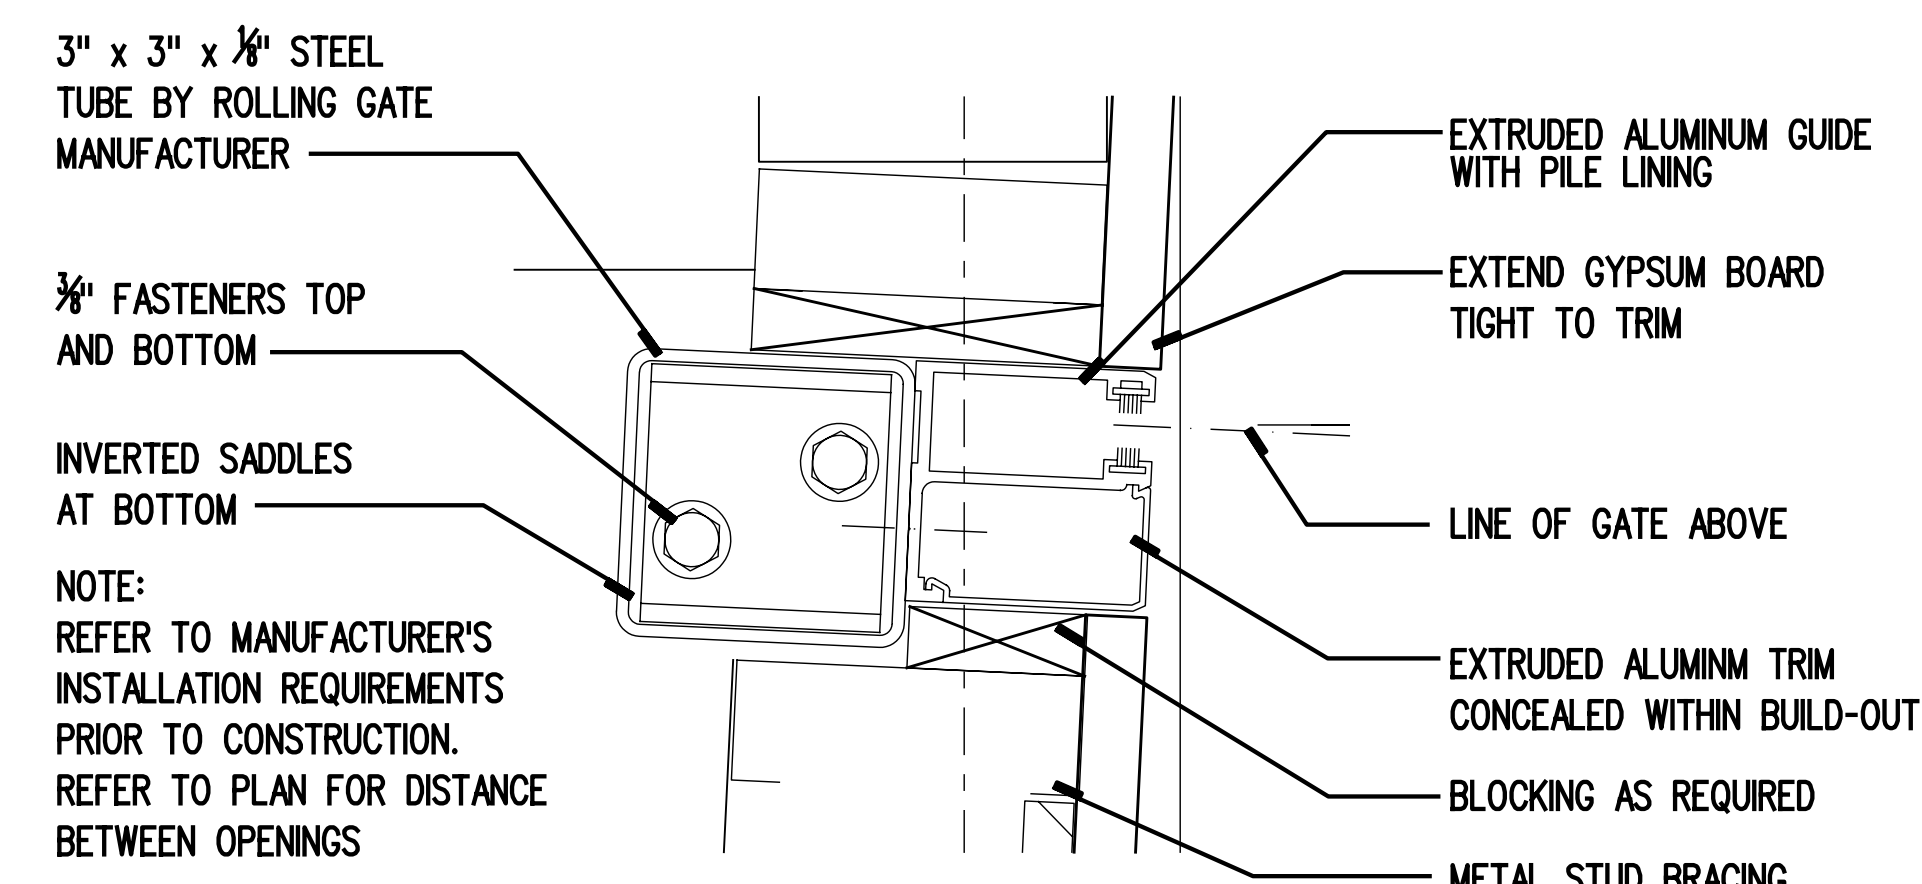

4 DETAIL AT FORM BUILD-OUT


* REFER TO SPEC SECTION 08345

SCALE 6"=1'-0'

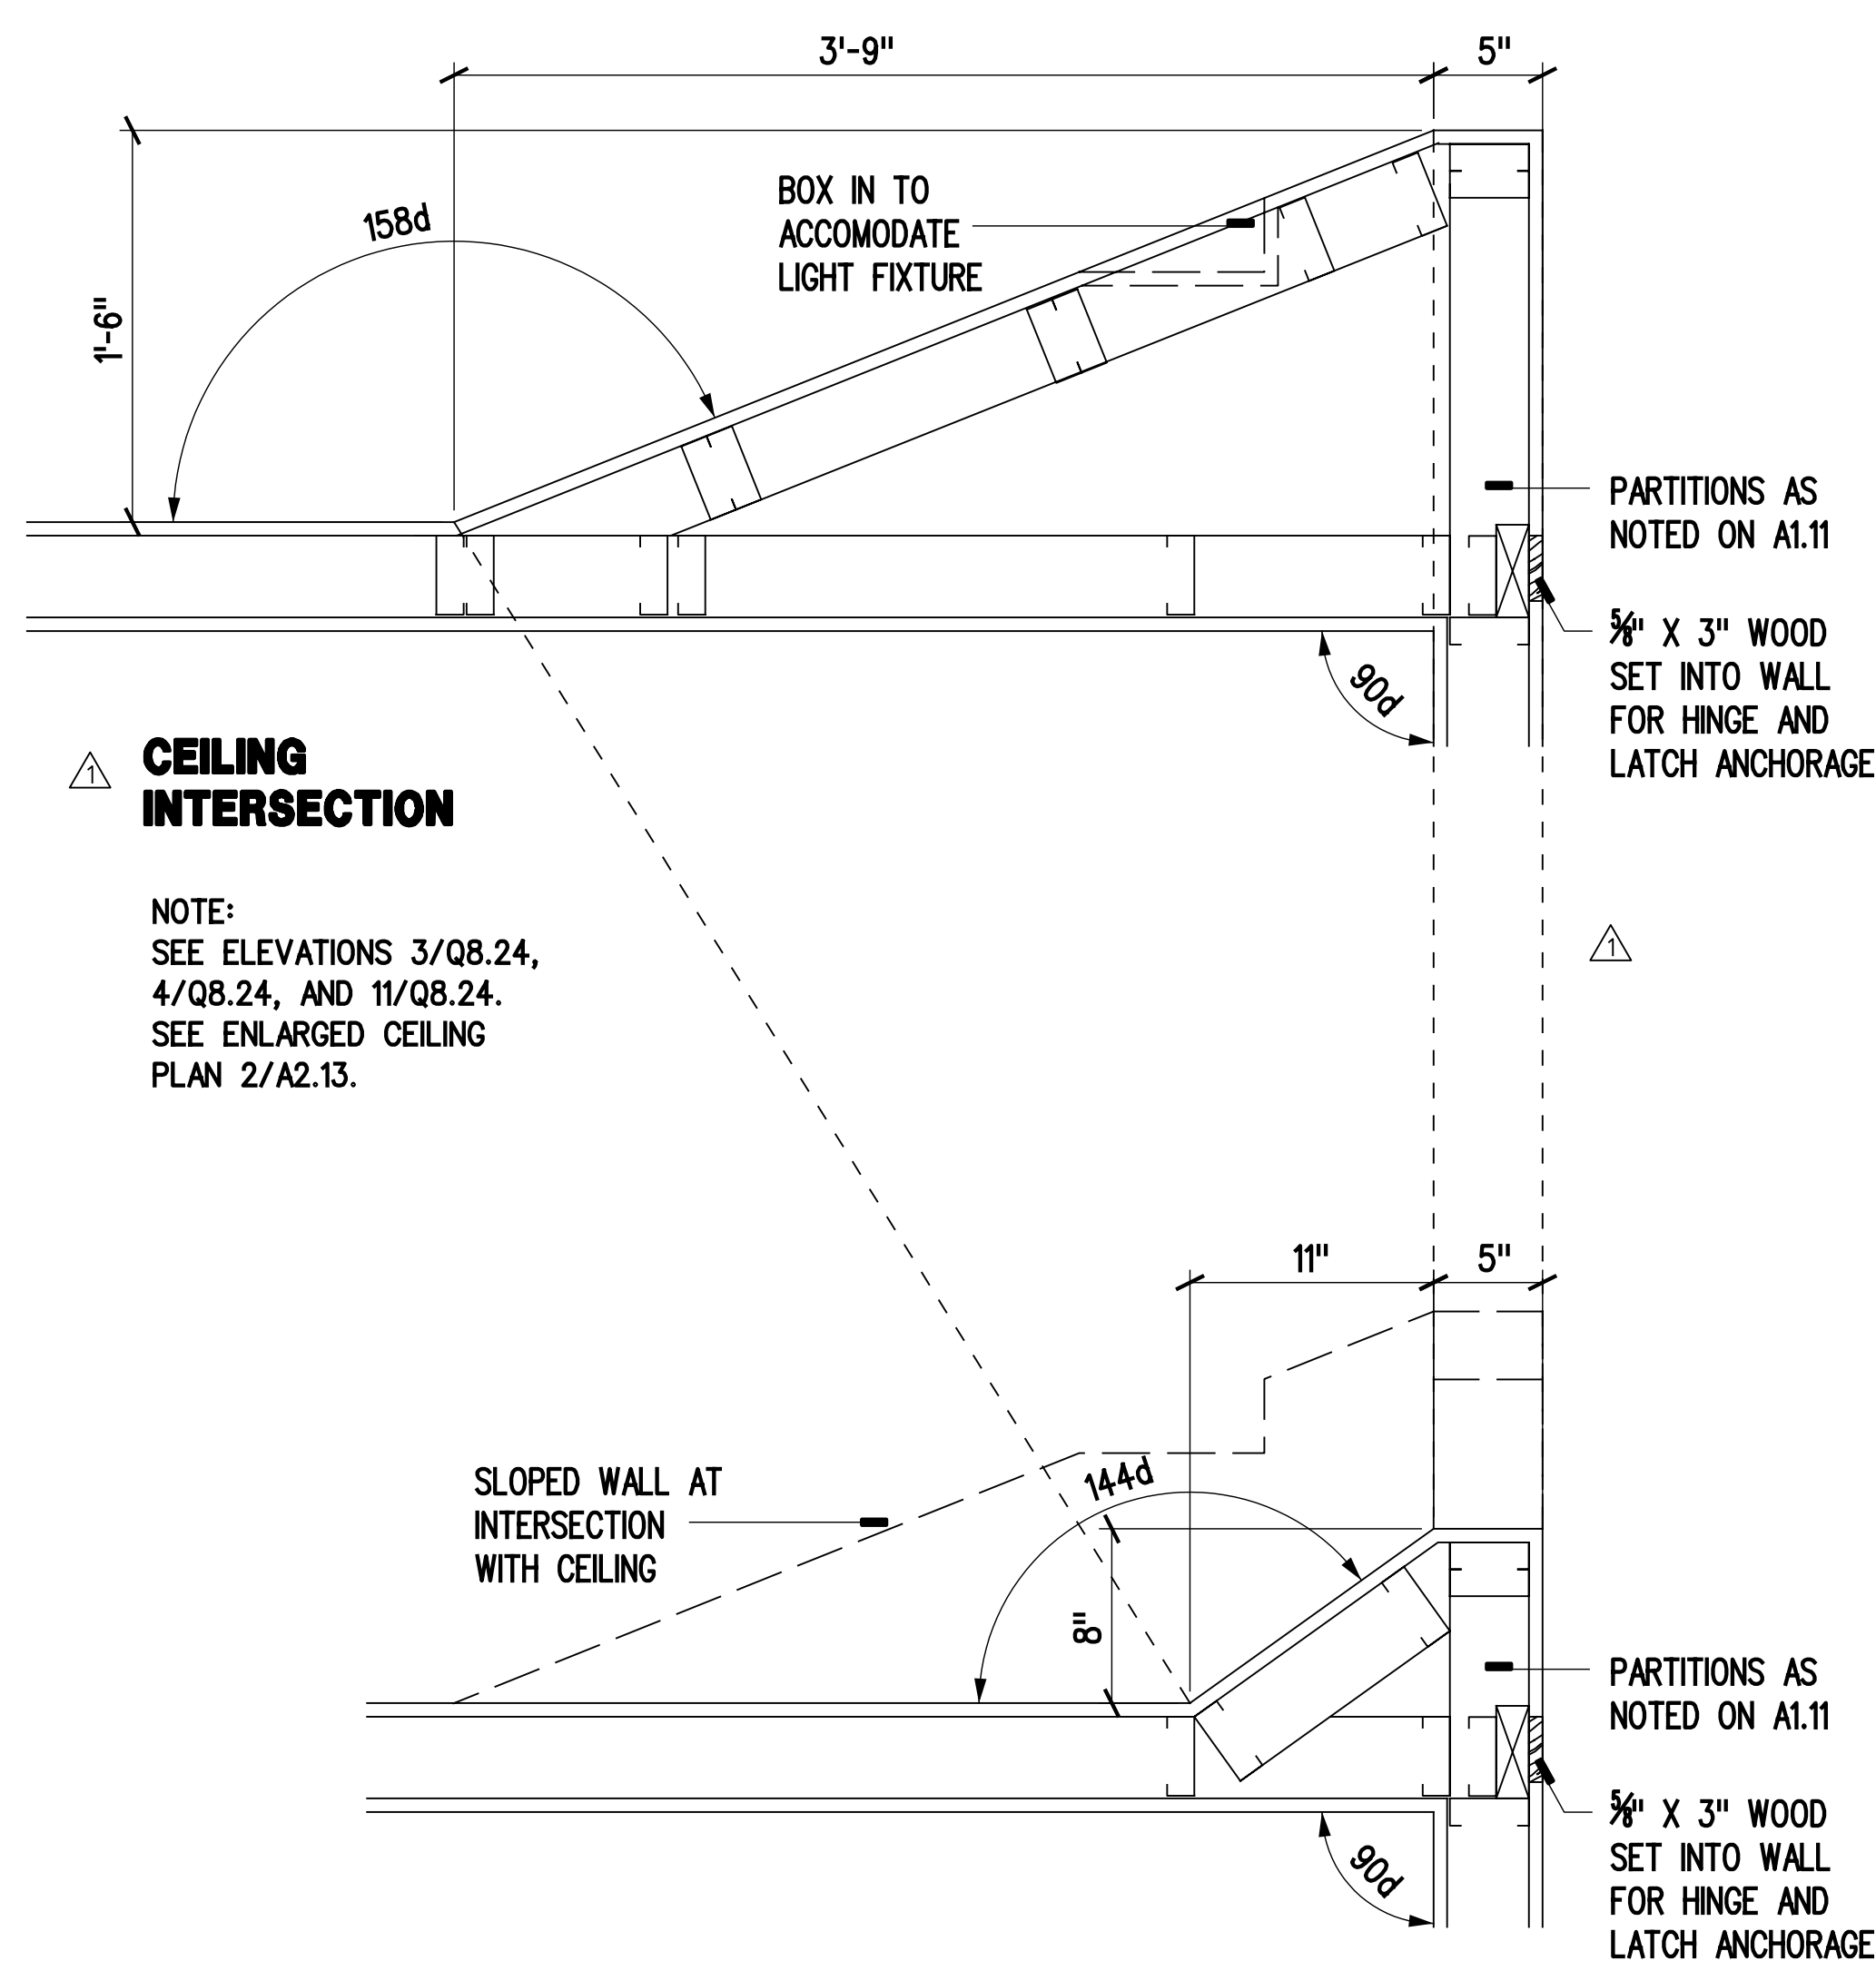


5 ANGLED SIDE WALL

SCALE 1 1/2"=1'-0"

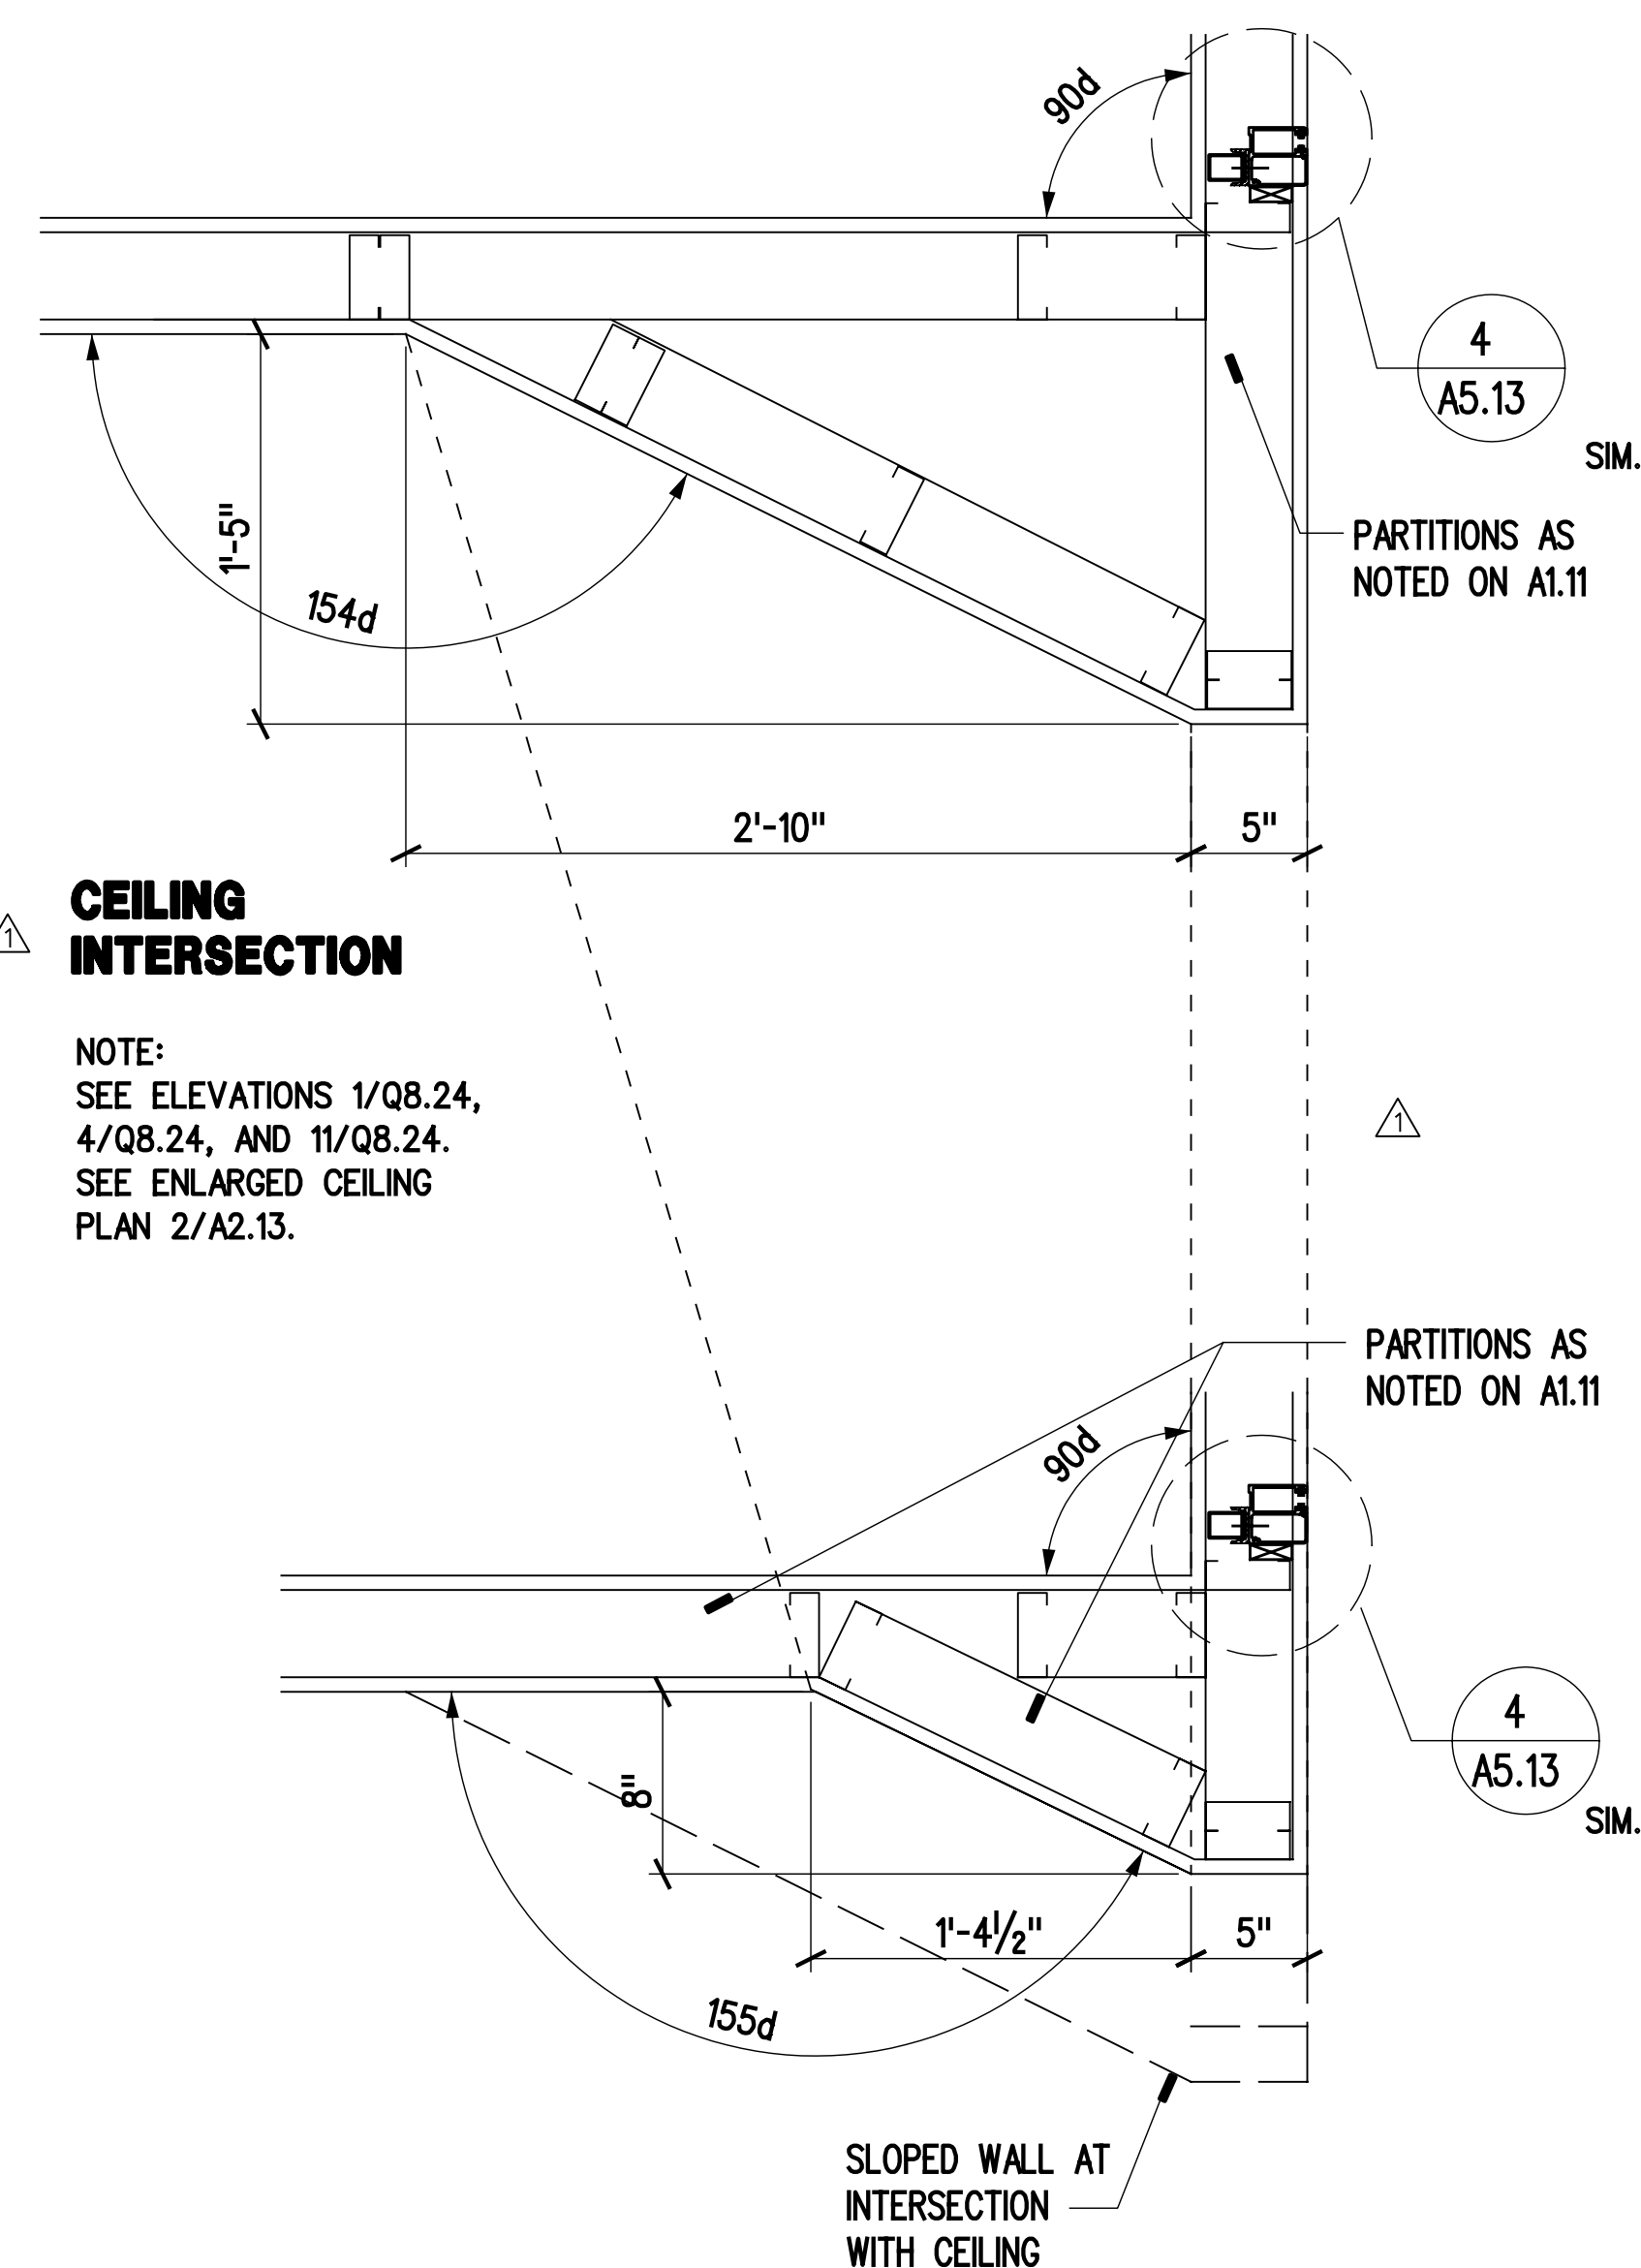


6 ANGLED SIDE WALL

SCALE 1 1/2"=1'-0"

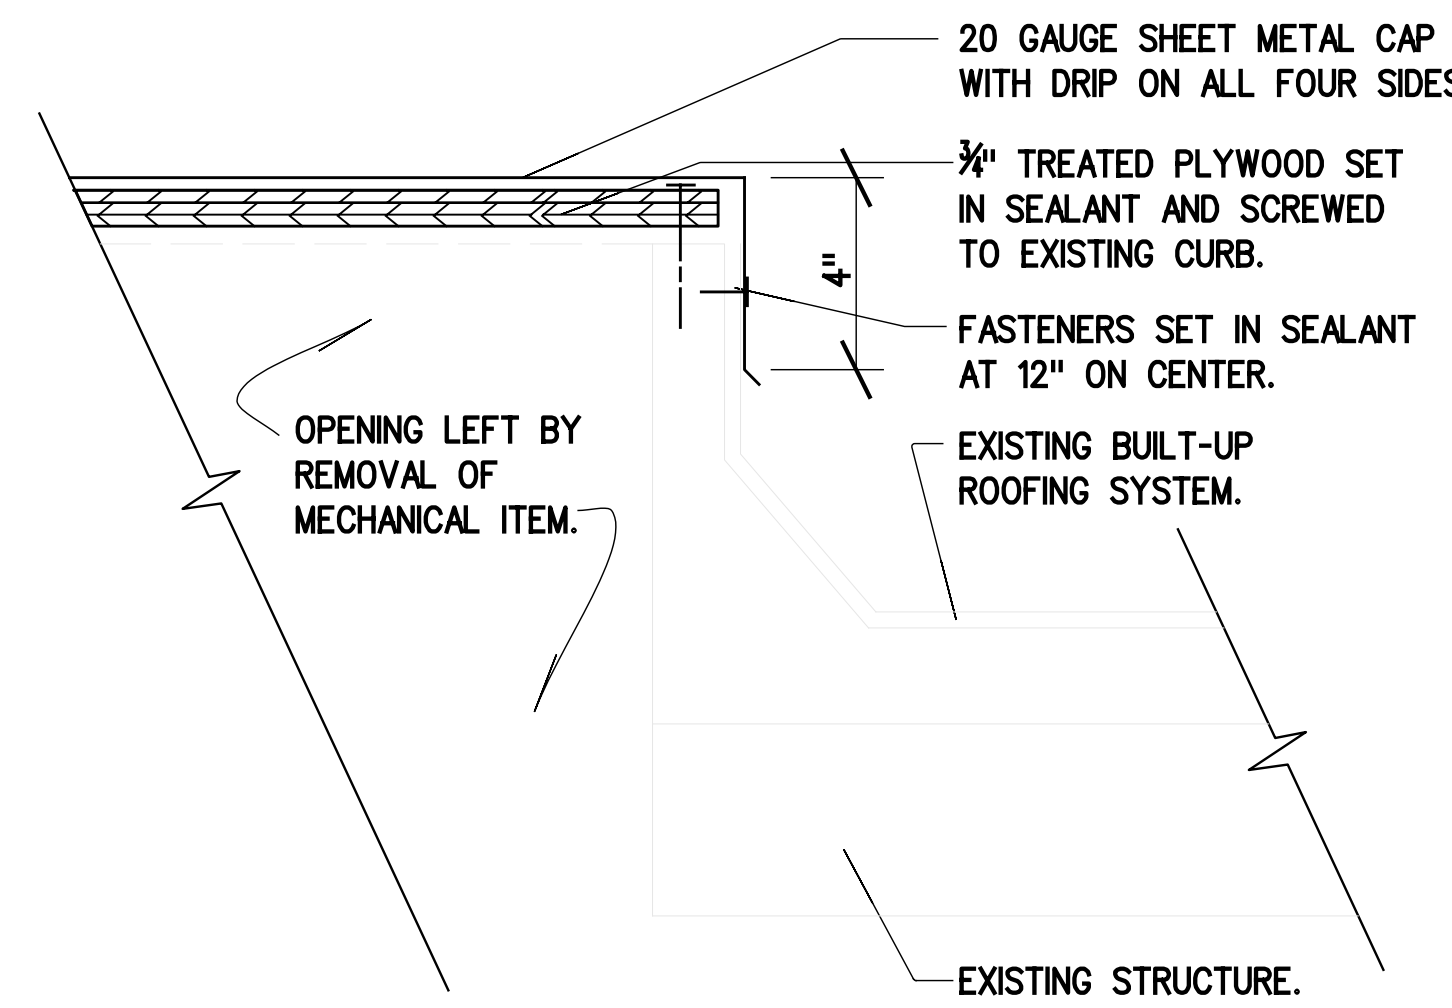

7 CURB CAP DETAIL

SCALE 3"=1'-0"

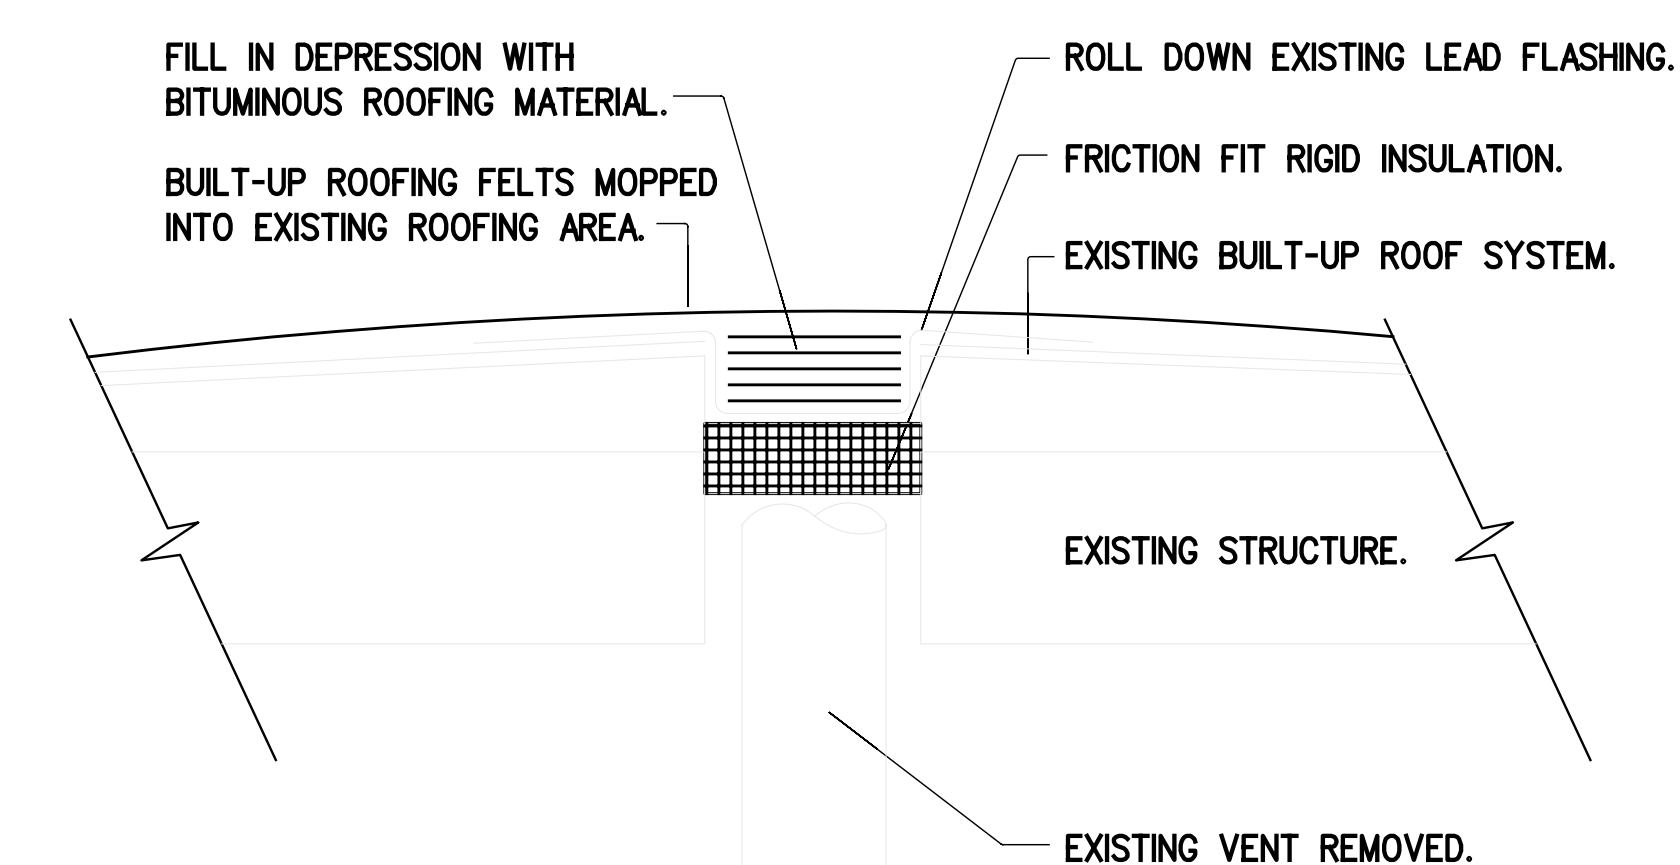

8 VENT CAP DETAIL

SCALE 3"=1'-0"