

LITTLE ROCK A.F.B.
ARKANSAS

FPM

804 West Curtis Drive, Suite H
Midwest City, OK 73110
phone: 405.869.9212
fax: 405.869.9222
www.fpm-group.com


RECORD
DRAWINGS
MARCH 2007

					APP'D
					BY
					Date
					Revision/Issue
					No.


PROJECT TITLE
REPAIR MEDICAL CENTER PH B
LITTLE ROCK AFB, ARKANSAS

SHEET TITLE
INTERIOR ELEVATIONS


DRAWN BY RJR	LEAD DESIGNER AM
TECH REVIEWER AM & YN	PROJECT NUMBER NKA05-8004A
DESIGNED BY AM & YN	SHEET
DATE 1-21-08	A3.30
SCALE AS NOTED	10 OF 39

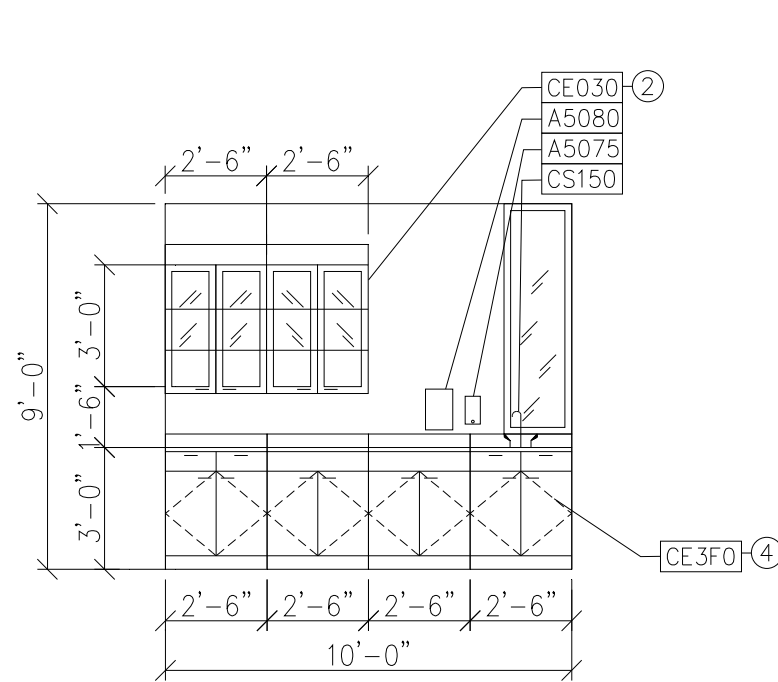


1 TREATMENT ROOM A177
** METAL CASEWORK SCALE: 1/4"=1'-0"
PROVIDE EMERGENCY EYE/FACE WASH
COUNTER TOP. SEE SHEET P1.11
FISHER HAMILTON
FINISH: G1 - DOVE GRAY

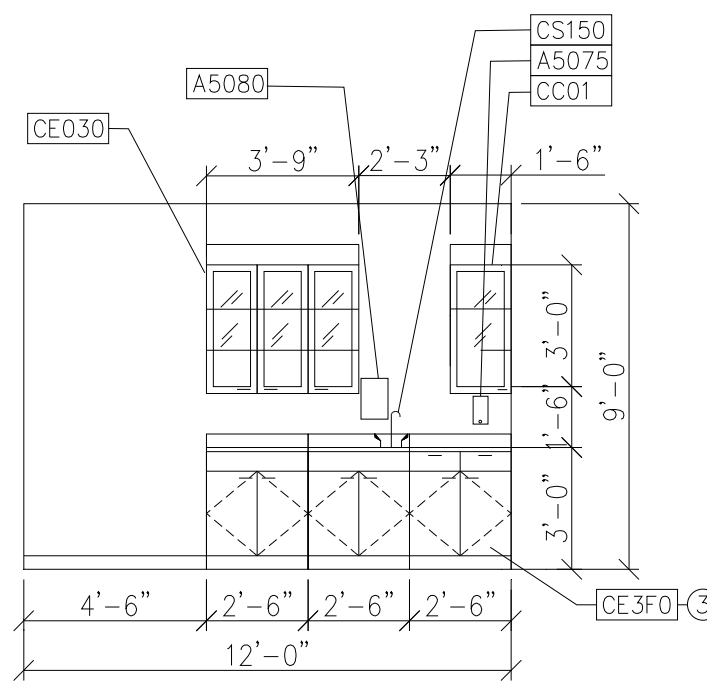


2 TREATMENT ROOM A214
** METAL CASEWORK SCALE: 1/4"=1'-0"
PROVIDE EMERGENCY EYE/FACE WASH
COUNTER TOP. SEE SHEET P1.11
FISHER HAMILTON
FINISH: G1 - DOVE GRAY

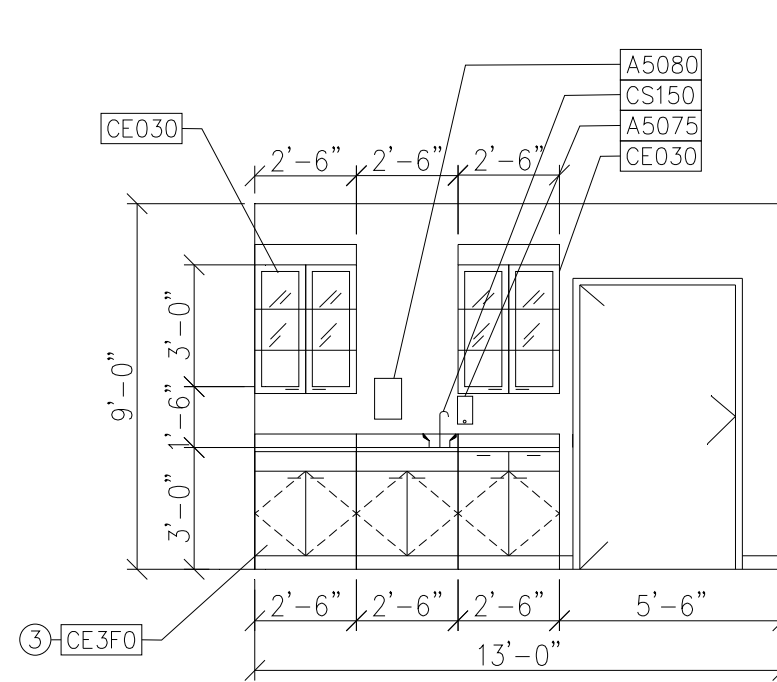


3 TREATMENT ROOM A261
** METAL CASEWORK SCALE: 1/4"=1'-0"
PROVIDE EMERGENCY EYE/FACE WASH
COUNTER TOP. SEE SHEET P1.11
FISHER HAMILTON
FINISH: G1 - DOVE GRAY

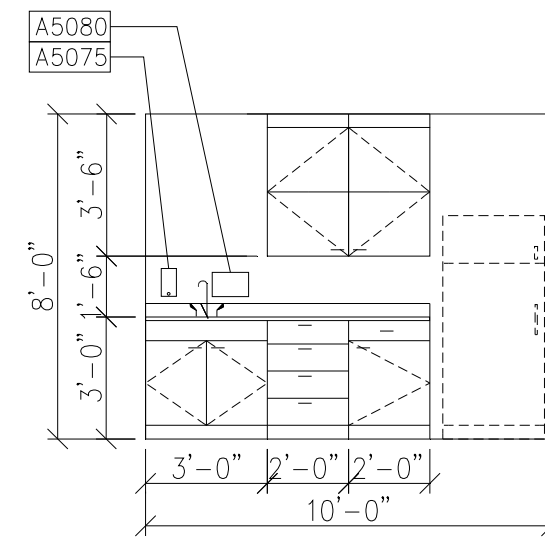


4 BREAK ROOM A250
** MILLWORK SCALE: 1/4"=1'-0"

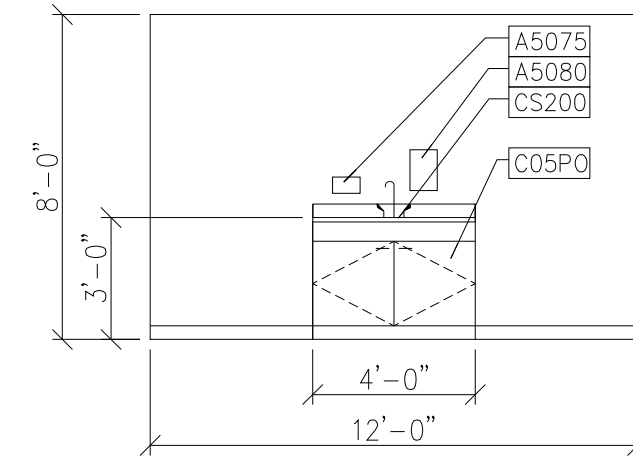


5 DIRTY UTILITY A213
** METAL CASEWORK SCALE: 1/4"=1'-0"
FISHER HAMILTON
FINISH: G1 - DOVE GRAY

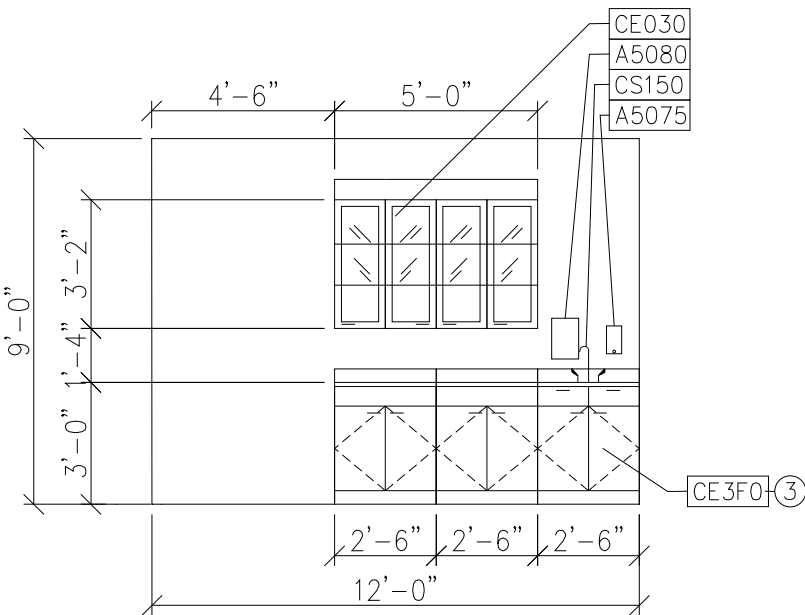


6 TREATMENT ROOM A135
** METAL CASEWORK SCALE: 1/4"=1'-0"
PROVIDE EMERGENCY EYE/FACE WASH
COUNTER TOP. SEE SHEET P1.11
FISHER HAMILTON
FINISH: G1 - DOVE GRAY

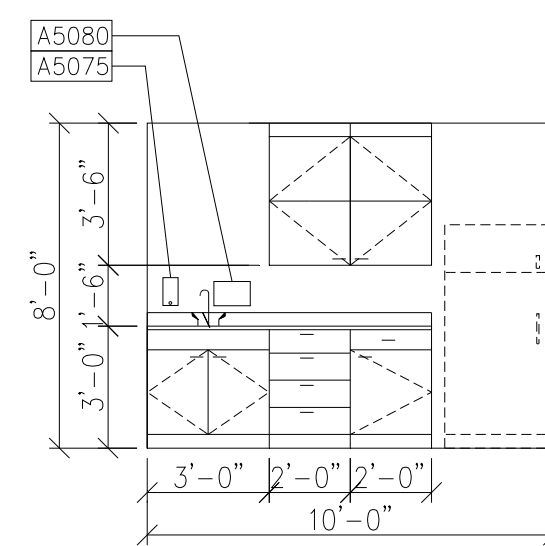


7 BREAK ROOM A187
** MILLWORK SCALE: 1/4"=1'-0"
FISHER HAMILTON
FINISH: G1 - DOVE GRAY

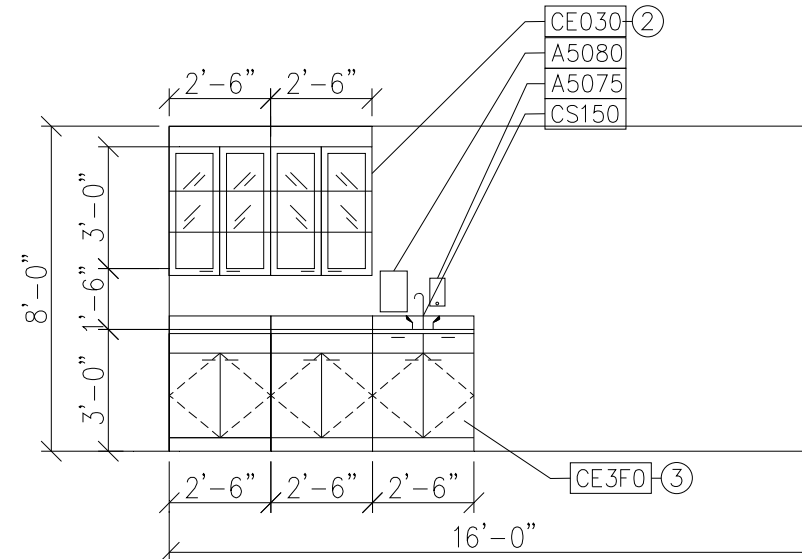


8 IMMUNIZATION ROOM A124
** METAL CASEWORK SCALE: 1/4"=1'-0"
FISHER HAMILTON
FINISH: G1 - DOVE GRAY

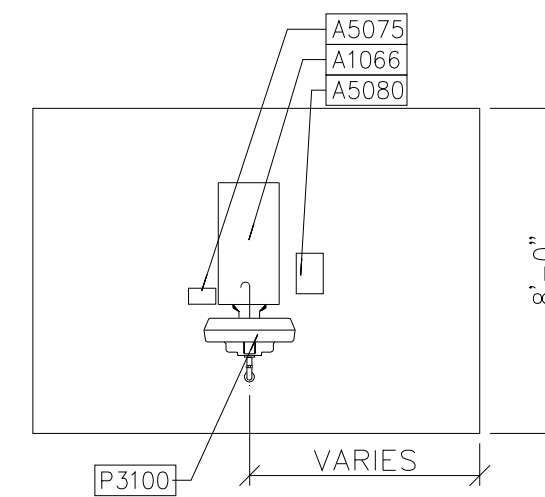


9 TYPICAL EXAM ROOM
SCALE: 1/4"=1'-0"

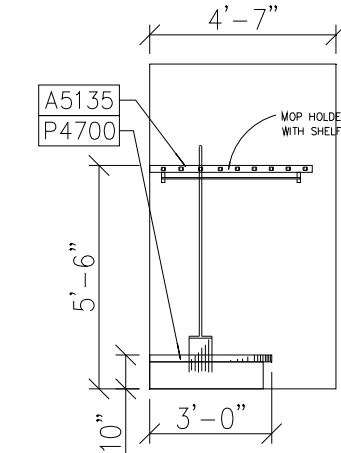


10 TYPICAL JANITOR'S CLOSET
SCALE: 1/4"=1'-0"

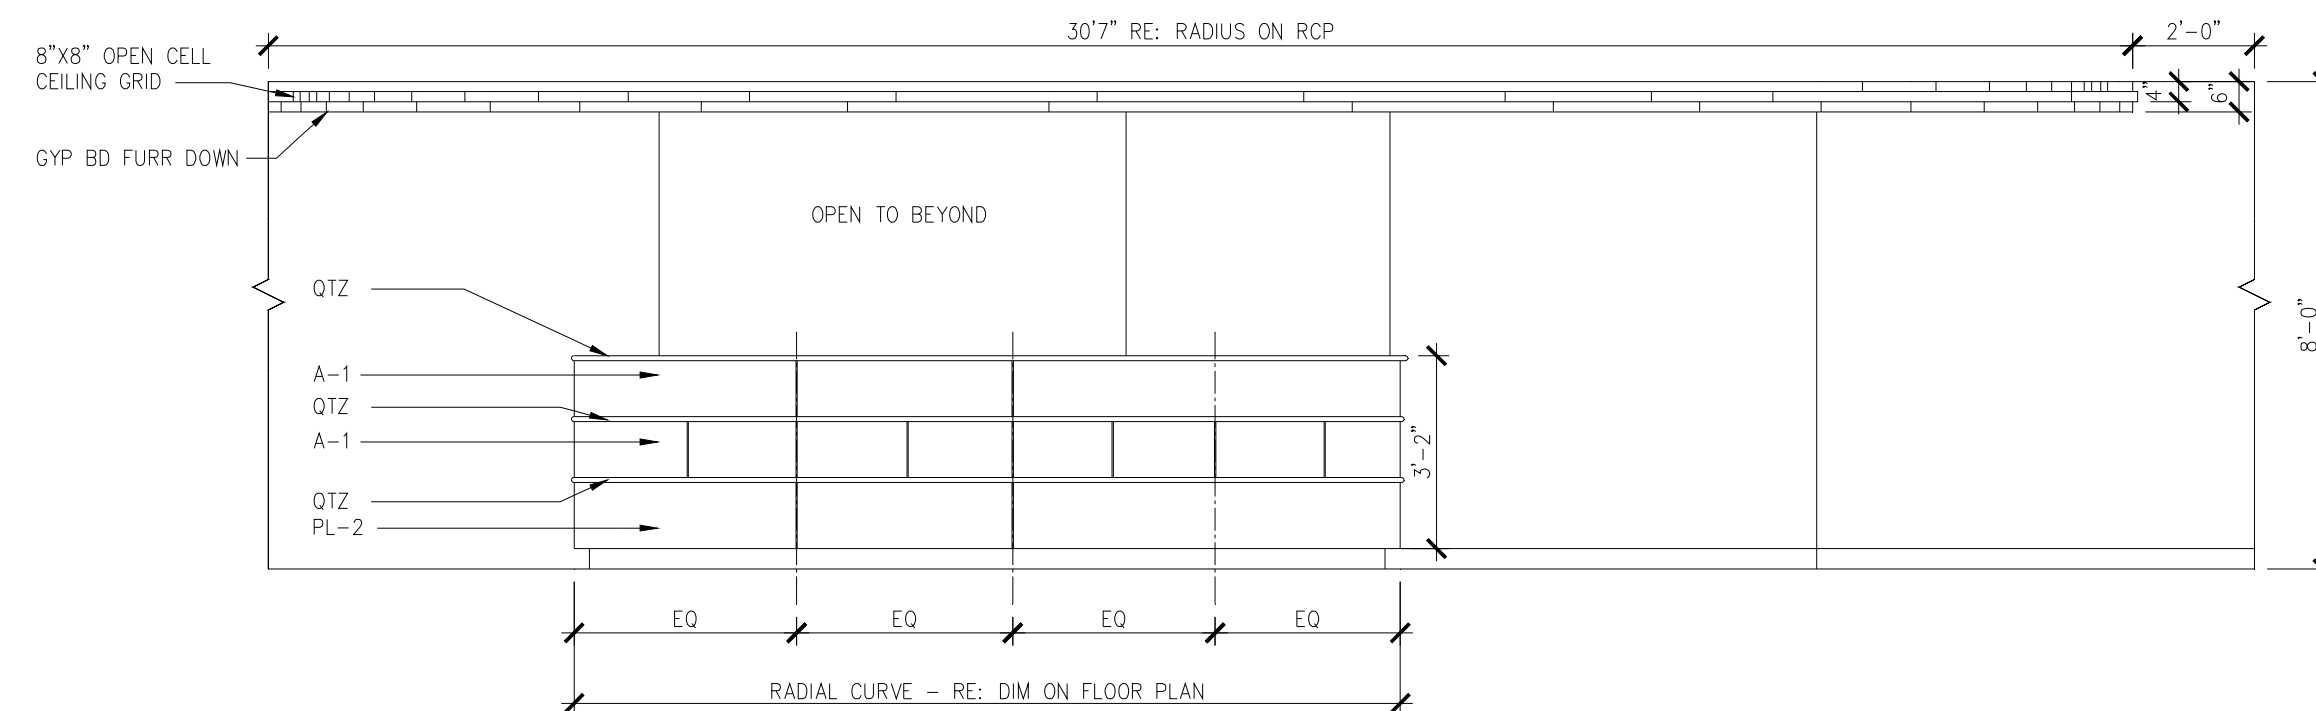


11 ELEVATION @ RECEPTION DESK A152
SCALE: 3/8"=1'-0"

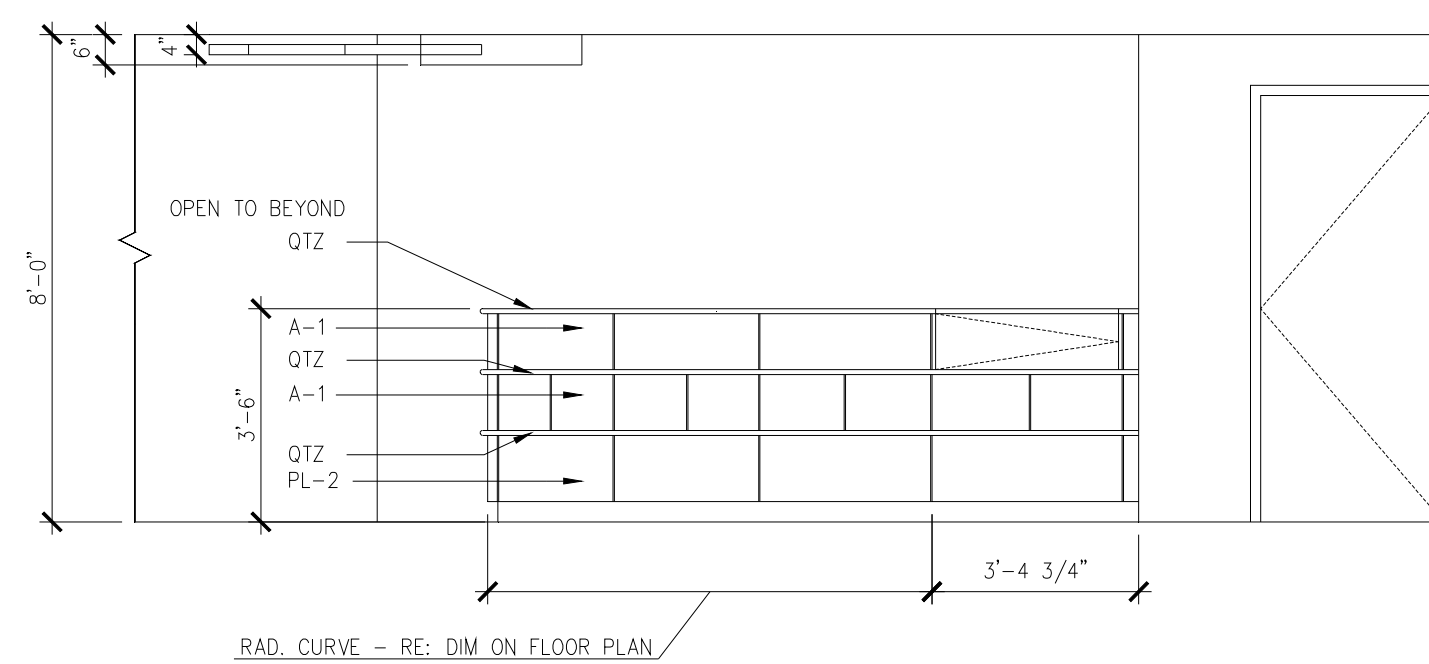


12 ELEVATION @ RECEPTION DESK A152A
SCALE: 3/8"=1'-0"

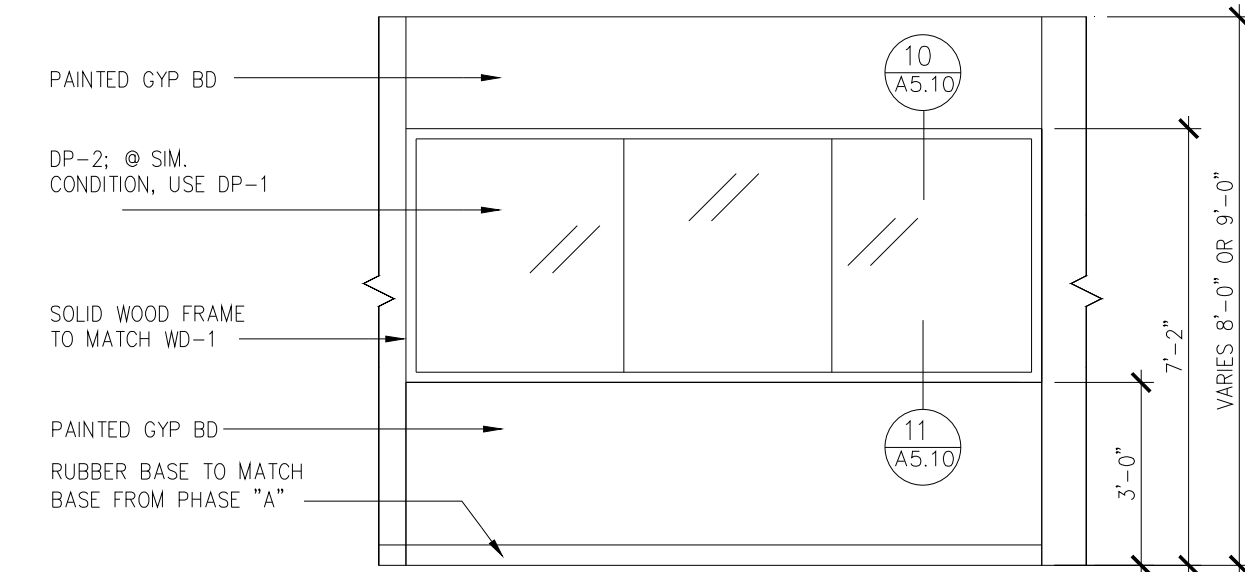

15 ELEVATION @ RECEPTION DESK A266 & A196
SCALE: 3/8"=1'-0"

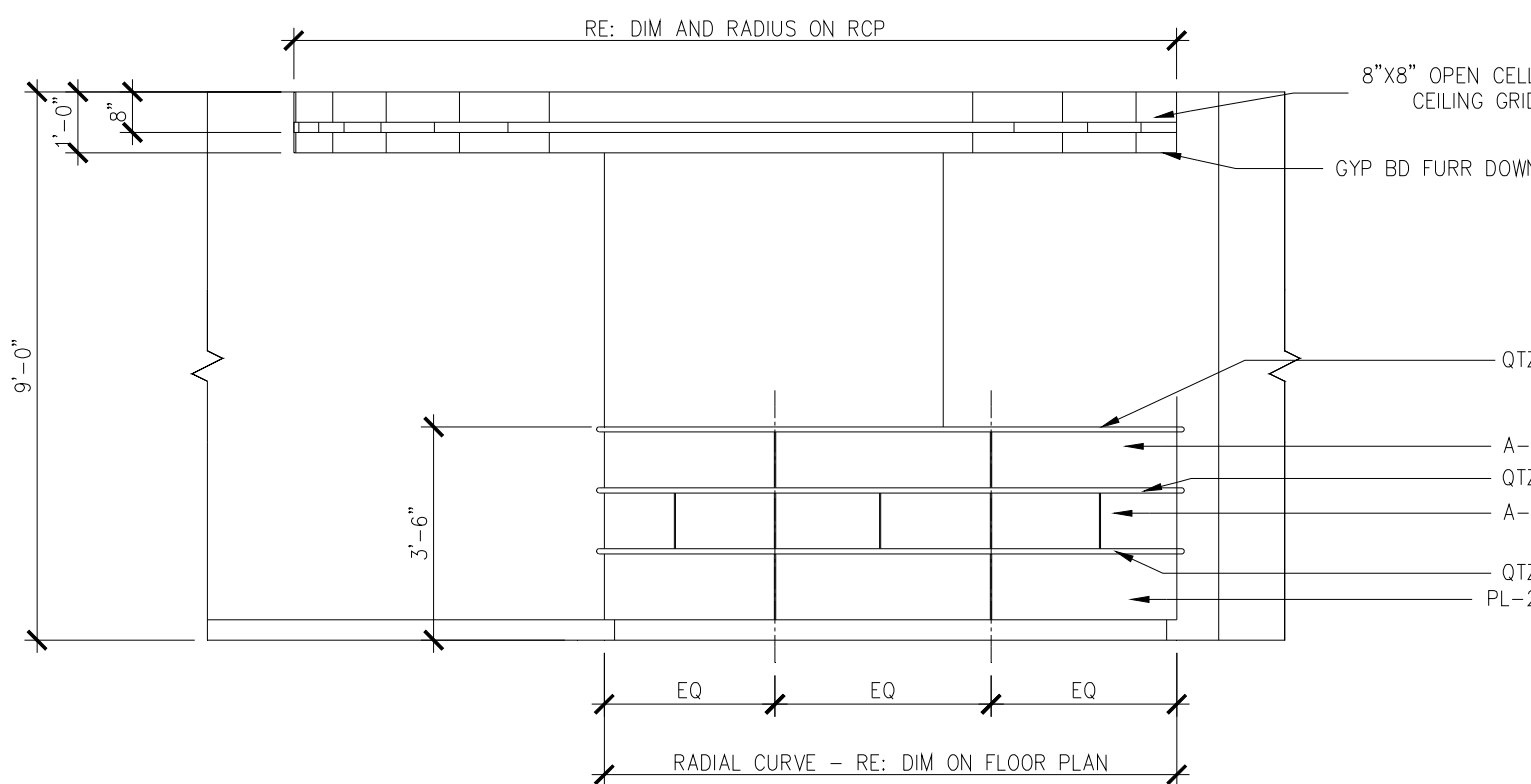

13 ELEVATION @ RECEPTION DESK A244
SCALE: 3/8"=1'-0"

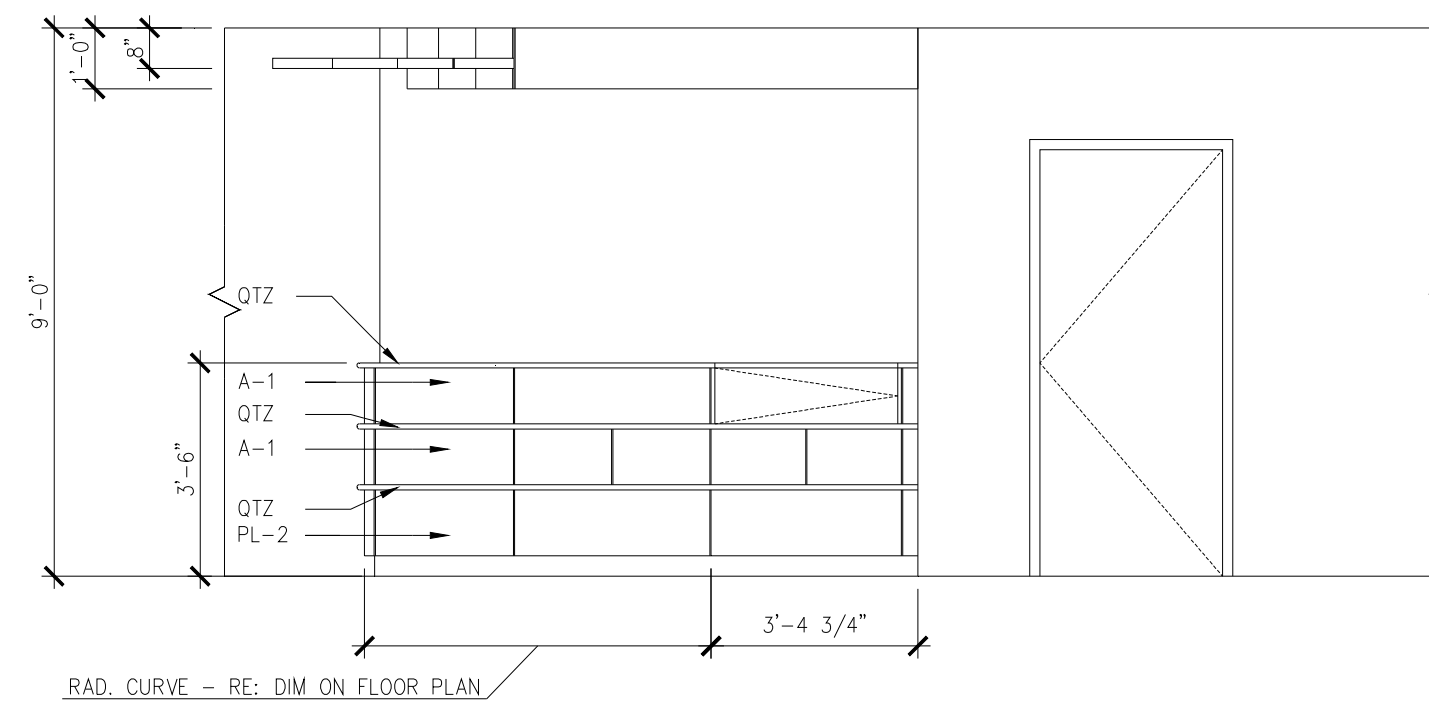

14 ELEVATION @ RECEPTION DESK A244
SCALE: 3/8"=1'-0"

KEYPLAN
N.T.S.

