


- REFLECTED CEILING PLAN NOTES AND KEYS:
- SEE FINISH SCHEDULE, DRAWING A-601, FOR CEILING HEIGHTS.
  - SUSPENDED CEILING SYSTEM WITH METAL PANEL TILES (WOOD TONE)
  - EXISTING CEILING TO REMAIN. PATCH AS REQUIRED WITH LIKE MATERIALS. PAINT PER FINISH SCHEDULE.
  - DECORATIVE ALUMINUM GRID @ 9'-6" A.F.F.
  - SUSPENDED CEILING SYSTEM WITH WOOD PANEL TILES
  - VAULTED CEILING SYSTEM WITH TRANSLUCENT PANEL WITH LIGHTING ABOVE
  - GYPSUM BOARD SOFFIT
  - MOTORIZED ROLL DOWN STAINLESS STEEL COILING DOOR - TYP. OF (4)
  - EXISTING G.W.B. SOFFIT
  - SECURITY WALL COMBINATION OF P1s METAL STUD-GYP BD-STEEL MESH BELOW WINDOW, (8) ROLL DOWN COILING DOOR AT WINDOW, AND P1s METAL STUD-GYP BD-STEEL MESH ABOVE WINDOW TO STRUCTURE
  - EXTEND EXISTING GRID AND A.C.T. CEILING
  - MILLWORK DESIGN BUILD HINGED ACCESS CEILING PANELS - CONCEALED HINGES AND LOCKING PINS - MATCH CEILING WOOD TILE LOOK - TYPICAL OF (4)

- WALL LEGEND
- EXISTING METAL STUD & GYP BD WALL TO REMAIN. PROVIDE NEW FINISHES PER SCHEDULE. WALL EXTENDS TO APPROXIMATELY 6" ABOVE CEILING
  - NEW METAL STUD & GYP BOARD WALL WITH SOUND INSULATION FULL HEIGHT TO STRUCTURE ABOVE.
  - NEW METAL STUD & GYP BOARD WITH SOUND INSULATION, EXTENDS TO APPROXIMATELY 6" ABOVE CEILING
  - NEW METAL STUD & GYP BOARD HALF WALL.
  - SECURITY WALL PER DOD STANDARDS. NEW OR MODIFIED EXISTING WALL, PER WALL TYPES ABOVE, FULL HEIGHT TO STRUCTURE. ALL OPENINGS SHALL BE PROTECTED PER DOD STANDARDS.
  - NEW C.M.U. WALL TO STRUCTURE OR TO COUNTERTOP AT PHARMACY DISPENSING COUNTER
  - WALL TYPE KEY. SEE A-501.


- CEILING LEGEND
- EXISTING CEILING TO REMAIN
  - 2x2 ACOUSTICAL TILE & METAL GRID SYSTEM. (NOTE: A.C.T. AT LOBBY D144 TO BE ENHANCED SOUND ABSORPTIVE - SEE SPECIFICATIONS)
  - GYP. BD. CEILING
  - SUSPENDED ALUMINUM DECORATIVE GRID SYSTEM (8"x8" SQUARES) SEE DETAIL 2/A-101R FOR HANGER INFORMATION TO BE USED ONLY IN LOCATIONS NOT VISIBLE FROM PUBLIC VIEW - PROVIDE STAINLESS STEEL ROD SUPPORT AND GROMMET THRU CEILING AT VISIBLE LOCATIONS
  - SUSPENDED WOOD PANEL CEILING SYSTEM OR SUSPENDED METAL PANEL CEILING SYSTEM (WOOD TONE)
  - LIGHT FIXTURE. SEE ELECTRICAL DRAWINGS
  - MECHANICAL REGISTERS. SEE MECH DRAWINGS

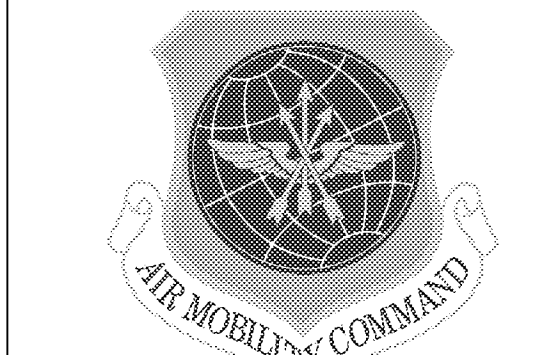

LITTLE ROCK A.F.B.  
ARKANSAS

1010 Battery St.  
Little Rock, AR 72202  
501-376-3633  
www.GarverUSA.com

**CROMWELL**  
ARCHITECTS ENGINEERS  
101 SOUTH SPRING ST  
LITTLE ROCK AR 72201  
TELEPHONE 501-372-2900  
FACSIMILE 501-372-0482

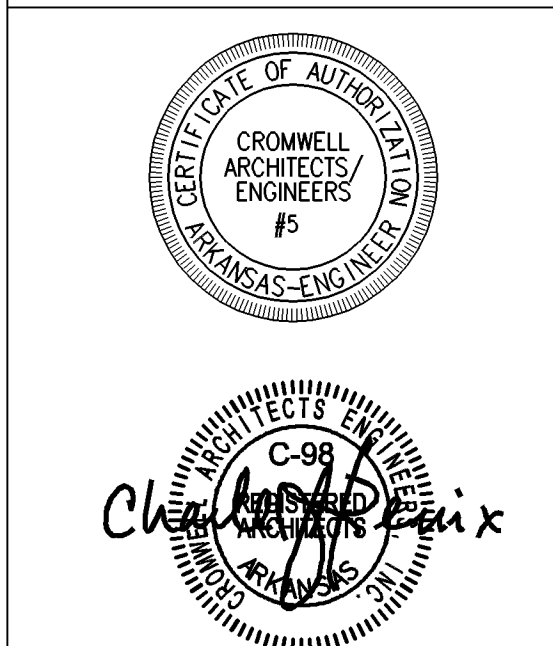

No.	Revision/Issue	Date	BY	APP'D

PROJECT TITLE  
REPAIR & RENOVATE MED. CLINIC PH IV A  
LITTLE ROCK AIR FORCE BASE  
JACKSONVILLE, ARKANSAS



SHEET TITLE  
REFLECTED CEILING PLAN -  
AREA "A"

ENTRANCE LOBBY, PHARMACY WAITING

DRAWN BY	JKL	LEAD DESIGNER	K. TAYLOR
TECH REVIEWER	JKL	PROJECT NUMBER	NKAK 06-8006 4A
DESIGNED BY	JOHN K. LAI	SHEET	A-101-R
DATE	13 MAY 2009		
SCALE			

7 of 51

1 REFLECTED CEILING PLAN - AREA "A" - ENTRANCE LOBBY, PHARMACY, PHARMACY WAITING  
1/8"=1'-0"

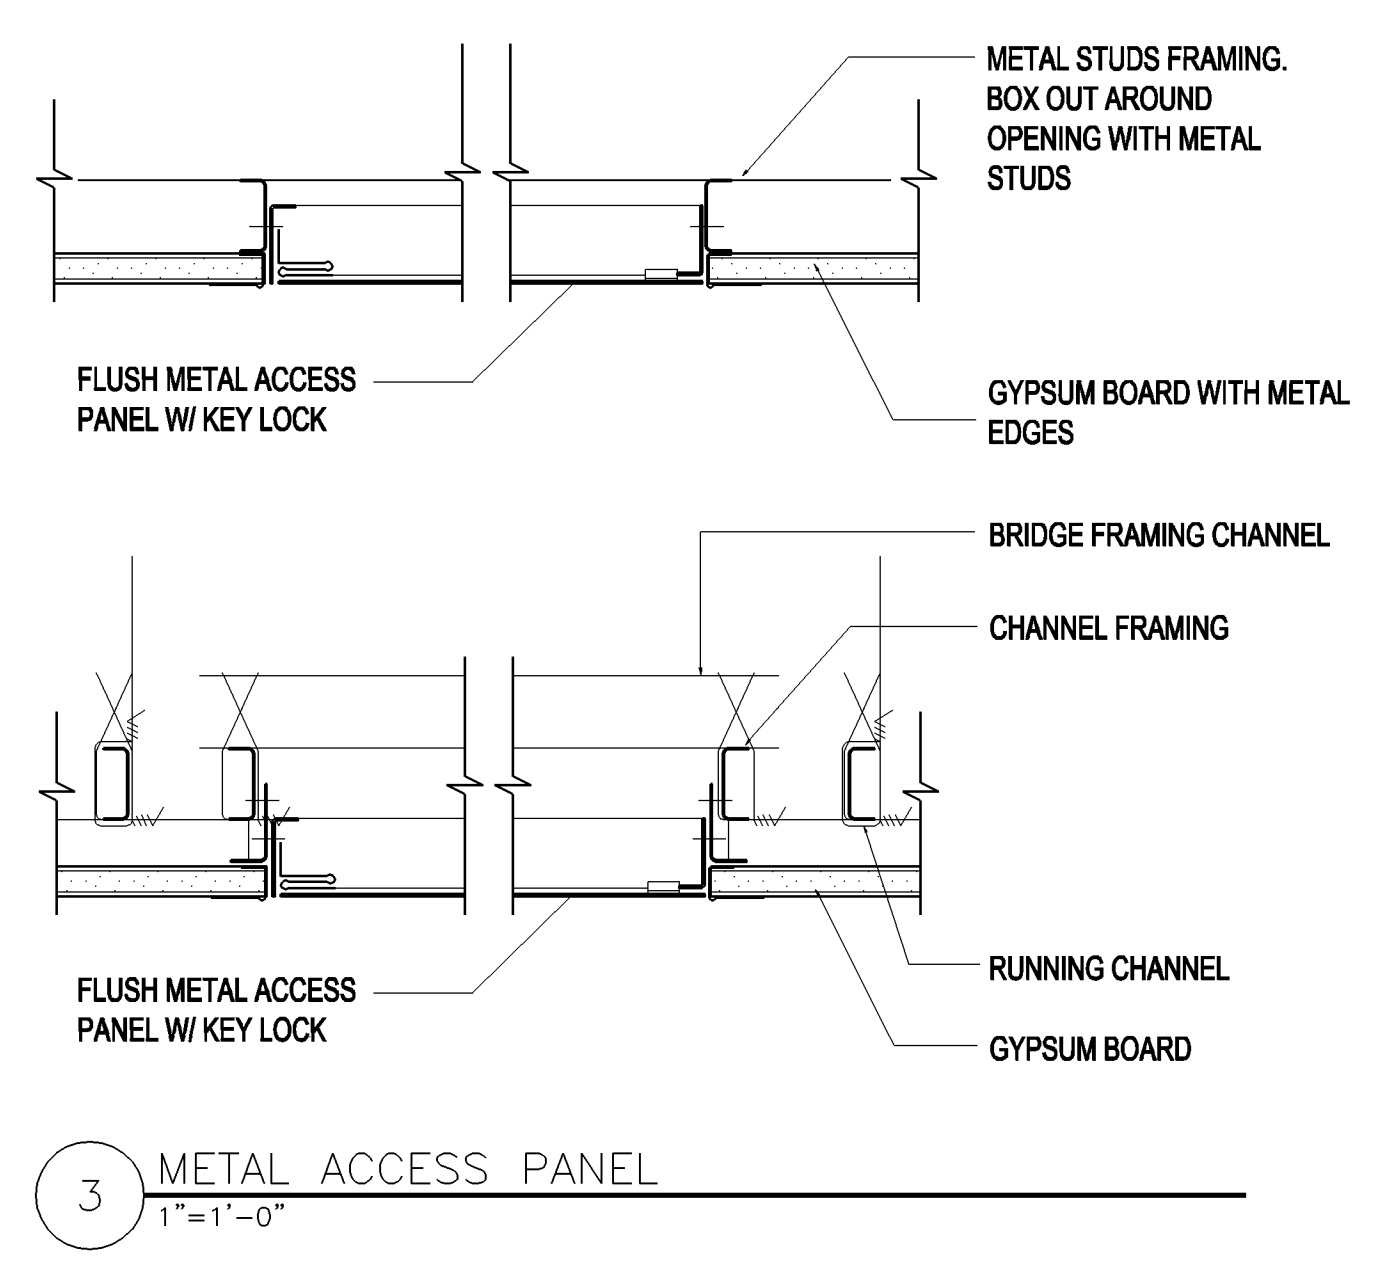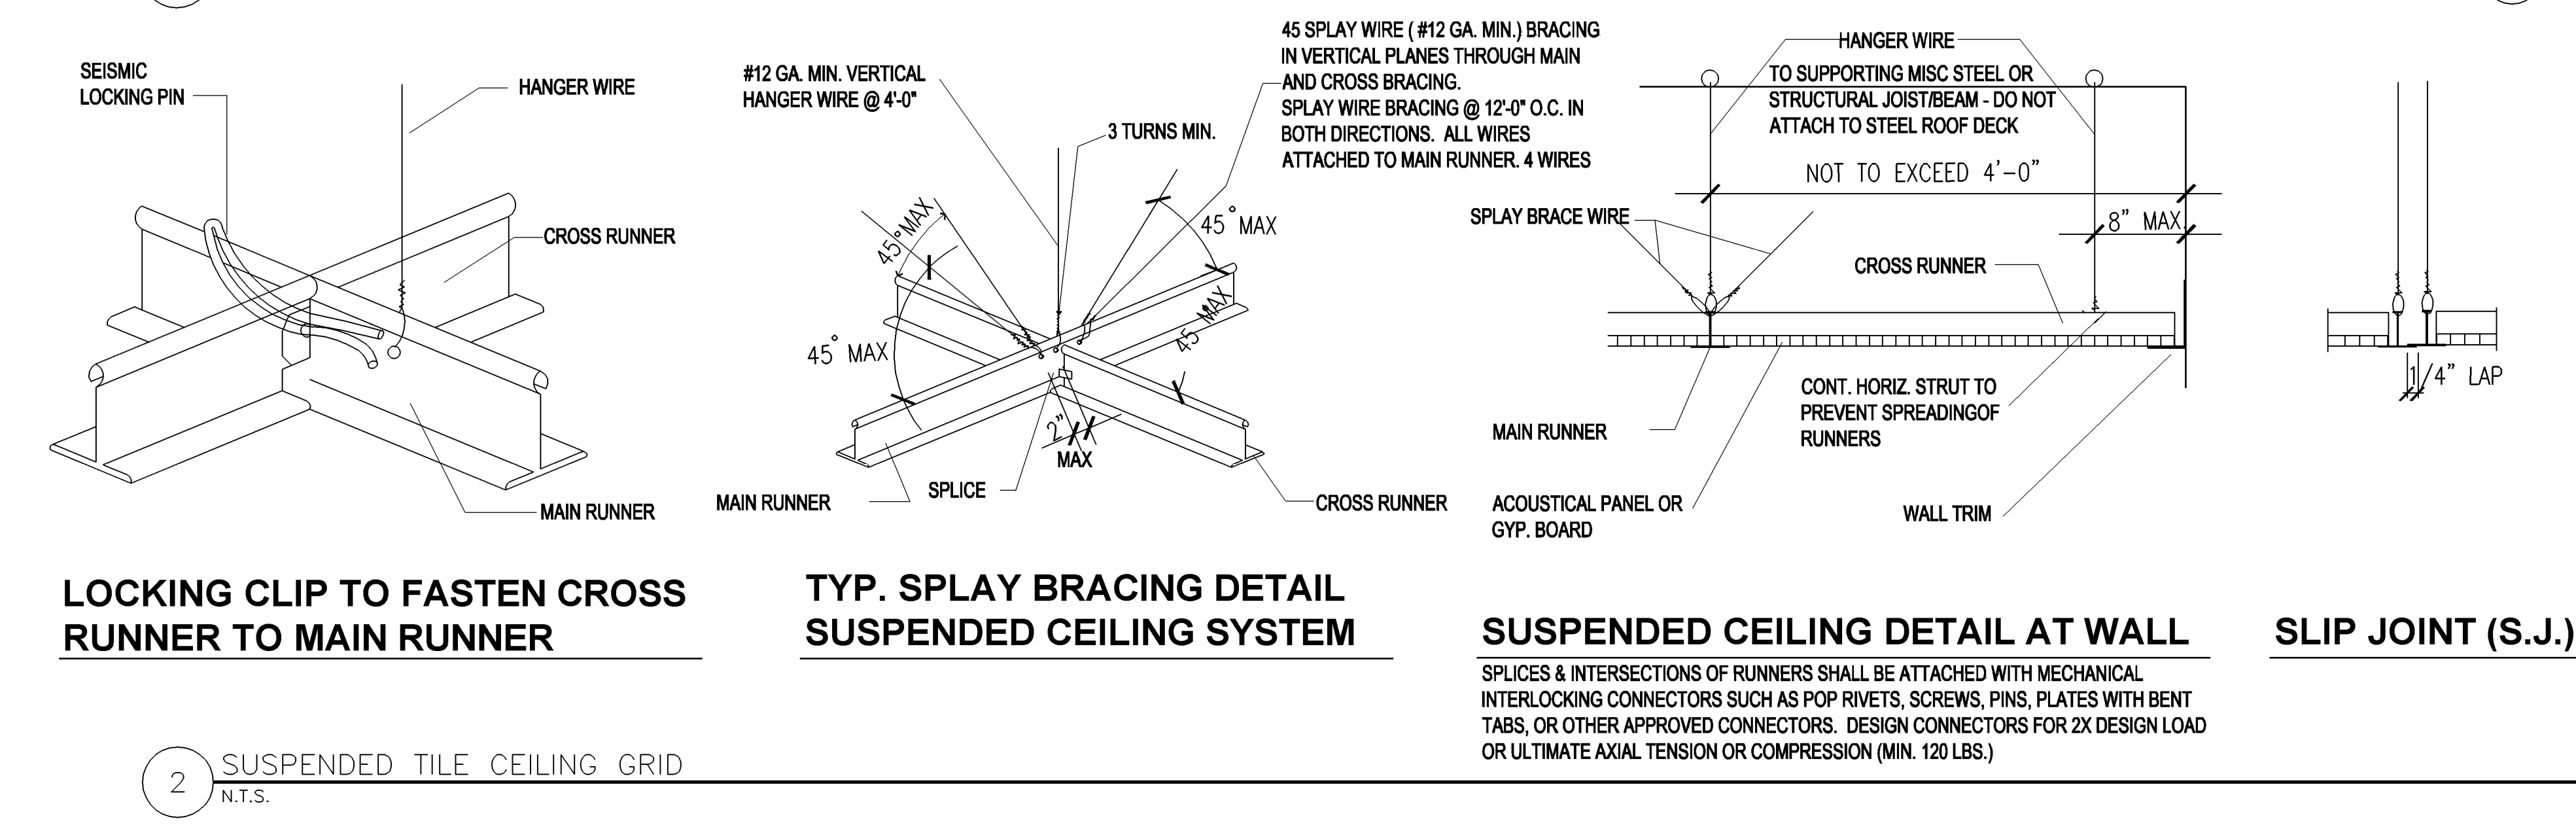

3 METAL ACCESS PANEL  
1"=1'-0"