
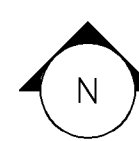


1 FLOOR PLAN – AREA "B" – RESOURCE MGMT OFFICE, IT SYSTEMS  
1/8"=1'-0"

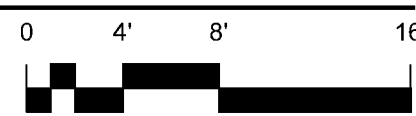

WALL LEGEND

- EXISTING METAL STUD & GYP BD WALL TO REMAIN. PROVIDE NEW FINISHES PER SCHEDULE. WALL EXTENDS TO APPROXIMATELY 6" ABOVE CEILING
- NEW METAL STUD & GYP BOARD WALL WITH SOUND INSULATION FULL HEIGHT TO STRUCTURE ABOVE.
- NEW METAL STUD & GYP BOARD WITH SOUND INSULATION. EXTENDS TO APPROXIMATELY 6" ABOVE CEILING
- NEW METAL STUD & GYP BOARD HALF WALL.
- SECURITY WALL PER DOD STANDARDS. NEW OR MODIFIED EXISTING WALL, PER WALL TYPES ABOVE, FULL HEIGHT TO STRUCTURE. ALL OPENINGS SHALL BE PROTECTED PER DOD STANDARDS. ALSO SEE GENERAL NOTE H THIS SHEET
- INTERIOR ELEVATION KEY

GENERAL FLOOR PLAN NOTES:

- A. CONTRACTOR SHALL REMOVE & REINSTALL EXISTING EMPLOYEE CARD SWIPE WHERE EXISTING DOOR FRAMES ARE REPLACED.
- B. PROVIDE NEW HANDRAIL, CRASH RAIL & CORNER GUARDS AT LOCATIONS INDICATED ON DRAWINGS I-101 & I-102. SEE FINISH SCHEDULE ON DRAWING A-601 FOR NEW FINISHES.
- C. WHERE NEW WALLS ALIGN WITH EXISTING WALLS CONTRACTOR SHALL PROVIDE STUD WIDTHS AS REQUIRED TO MATCH OVERALL EXISTING WALL THICKNESS SO THAT NEW FINISHES ALIGN FLUSH.
- D. ROOM IDENTIFICATION SIGNS SHALL BE GOVERNMENT FURNISHED AND INSTALLED.
- E. ALL ABANDON ELECTRICAL OUTLETS, SWITCHES & FIXTURES SHALL BE REMOVED. HOLES SHALL BE PATCHED TO MATCH ADJACENT MATERIAL & TEXTURE & PREPARED TO RECEIVE NEW FINISH.
- F. AT ALL EXISTING WALL CONSTRUCTION TO REMAIN CONTRACTOR SHALL REMOVE ALL FASTENERS, FILL ANY HOLES & PREPARE SURFACE TO RECEIVE NEW FINISH.
- G. REPLACE VINYL WALL COVERING, WALL BASE AND CRASH RAILS IN THEIR ENTIRETY WITH NEW TO MATCH WHERE WALL INFILL CONSTRUCTION HAS OCCURRED. PATCHED FINISHES NOT ALLOWED.
- H. AT ALL CORRIDOR WALLS, CONTRACTOR SHALL VERIFY AND BRING ALL CORRIDOR WALLS TO UNDERSIDE OF DECK, INCLUDING BUT NOT LIMITED TO PROVIDING INFILL SECURITY WALL INFILLS ABOVE NEW OR EXISTING DOOR FRAMES.
- J. NOT USED
- K. PATCH WALLS AS REQUIRED TO BRING ALL (E) ELECTRICAL & COMM. OUTLETS TO UNIFORM VERTICAL ALIGNMENT TO MEET ADA. SEE ELECTRICAL DRAWINGS.

KEYED FLOOR PLAN NOTES:


- 1 TYPICAL SYMBOL FOR NEW WALL CONSTRUCTION OR OPENING INFILL. SEE WALL LEGEND AND WALL TYPES A-102-R & A-501 FOR DESCRIPTION.
- 2 TYPICAL SYMBOL FOR EXISTING WALL CONSTRUCTION. CONTRACTOR SHALL REMOVE ALL FASTENERS, FILL HOLES & PREPARE SURFACE TO RECEIVE NEW FINISHES.
- 3 TYPICAL SYMBOL FOR EXISTING BRICK WITH NEW METAL FURRING & GYP BOARD FINISH OVER BRICK. SEE WALL LEGEND AND WALL TYPES A-501 FOR DESCRIPTION. PROVIDE FURRING TO OBTAIN OVERALL FLUSH AND SMOOTH APPEARANCE FOR FINISH WALL
- 4 THRU 15 NOT USED
- 16 VINYL WALL COVERING, CRASH RAIL AND RESILIENT BASE REPLACEMENT IN ENTIRETY AS REQUIRED FOR SMOOTH AND FLUSH ALIGNMENT BETWEEN INFILL WALL AND ADJACENT EXISTING WALL
- 17 5/8" GYP BOARD OVER EXISTING METAL STUD ON ONE SIDE ONLY SHOWN BY ARROW - SEE FINISH SCHEDULE
- 18 NEW MILLWORK. SOLID SURFACE COUNTERTOP WITH UPPER AND LOWER CABINETS (NO SINK)
- 19 PROVIDE ACOUSTICAL RESILIENT CHANNEL, ACOUSTICAL BATT FULL HEIGHT AND FULL HEIGHT 5/8" NEW GYP BD LAYER.
- 20 PROVIDE 6" METAL STUD AND FOR PLUMBING CAVITY AND PLUMBING ACCESS WALL PANEL - SEE PLUMBING DRAWING - ALIGN WALL FINISH WITH 3-5/8" STUD WALL
- 21 RECESSED FIRE EXTINGUISHER CABINET
- 22 EXISTING FIRE EXTINGUISHER CABINET TO REMAIN
- 23 SUMP PIT - SEE PLUMBING DWG



LITTLE ROCK A.F.B.  
ARKANSAS

1010 Battery St.  
Little Rock, AR  
72202  
501-376-3633  
www.GarverUSA.com

CROMWELL  
ARCHITECTS ENGINEERS  
101 SOUTH SPRING ST  
LITTLE ROCK AR 72201  
TELEPHONE 501-372-2900  
FACSIMILE 501-372-0482

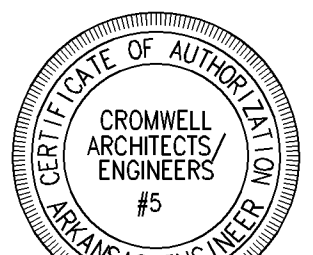

APPROVED	BY	DATE	REVISION/ISSUE	NO.

PROJECT TITLE REPAIR & RENOVATE MED. CLINIC PH IV A LITTLE ROCK AIR FORCE BASE JACKSONVILLE, ARKANSAS	SHEET TITLE FLOOR PLAN-AREA "B"
DRAWN BY JKL	LEAD DESIGNER K. TAYLOR
TECH REVIEWER JKL	PROJECT NUMBER NKAK 06-8006 4A
DESIGNED BY JOHN K. LAI	SHEET A-102-A
DATE 13 MAY 2009	
SCALE	9 of 51