


REVISIONS	DATE	DESCRIPTION	APPROVED	SYMBOL
1	8/01/2005	REVISED AS-BUILT		
2	9/27/2004	REVISED AS-BUILT		
3	10/07/2003	REVISED AS-BUILT		
4	10/07/2003	REVISED AS-BUILT		
DESIGNED BY:	DATE:	10/10/2003
DRAWN BY:	PROJECT NO.:	61503
CHECKED BY:	DRAWING CODE:	
REVIEWED BY:	SUBMITTAL NUMBER:	


U.S. ARMY ENGINEERING AND SUPPORT CENTER CORPS OF ENGINEERS HUNTSVILLE, ALABAMA	FLM Design
EARTH TECH	FLM Design

RENOVATE CLINIC
BUILDING 1090
LITTLE ROCK AFB, ARKANSAS
**CEILING DETAILS
AS-BUILT**


SHEET
REFERENCE
NUMBER:
A5.20
SHEET X OF XX

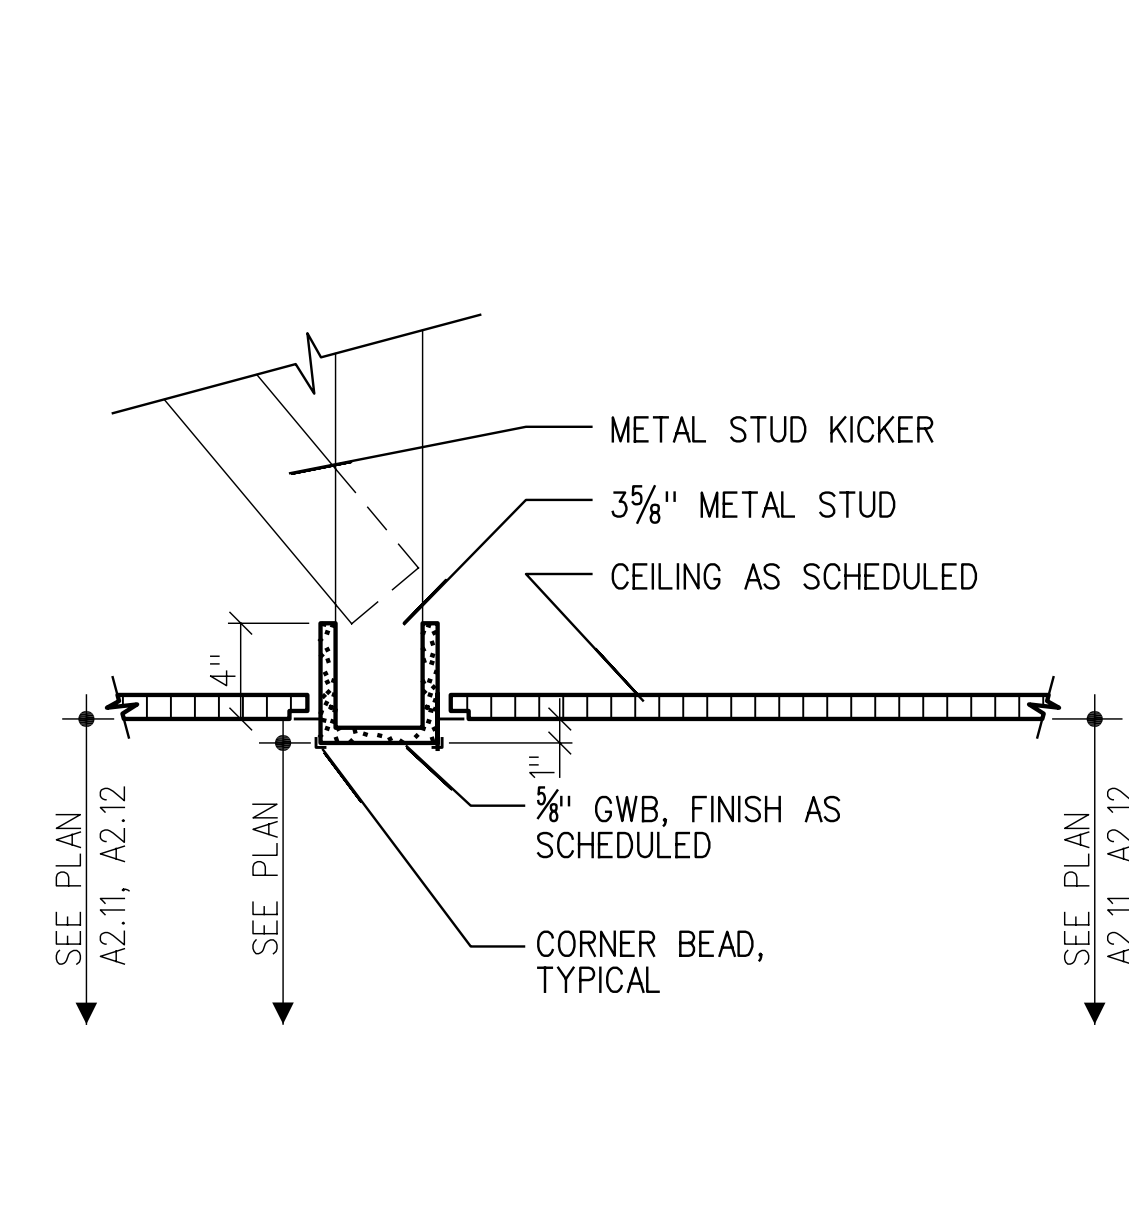


1 BULKHEAD DETAIL
* VERIFY ALL CEILING HEIGHTS WITH PLAN
1 1/2"=1'-0"

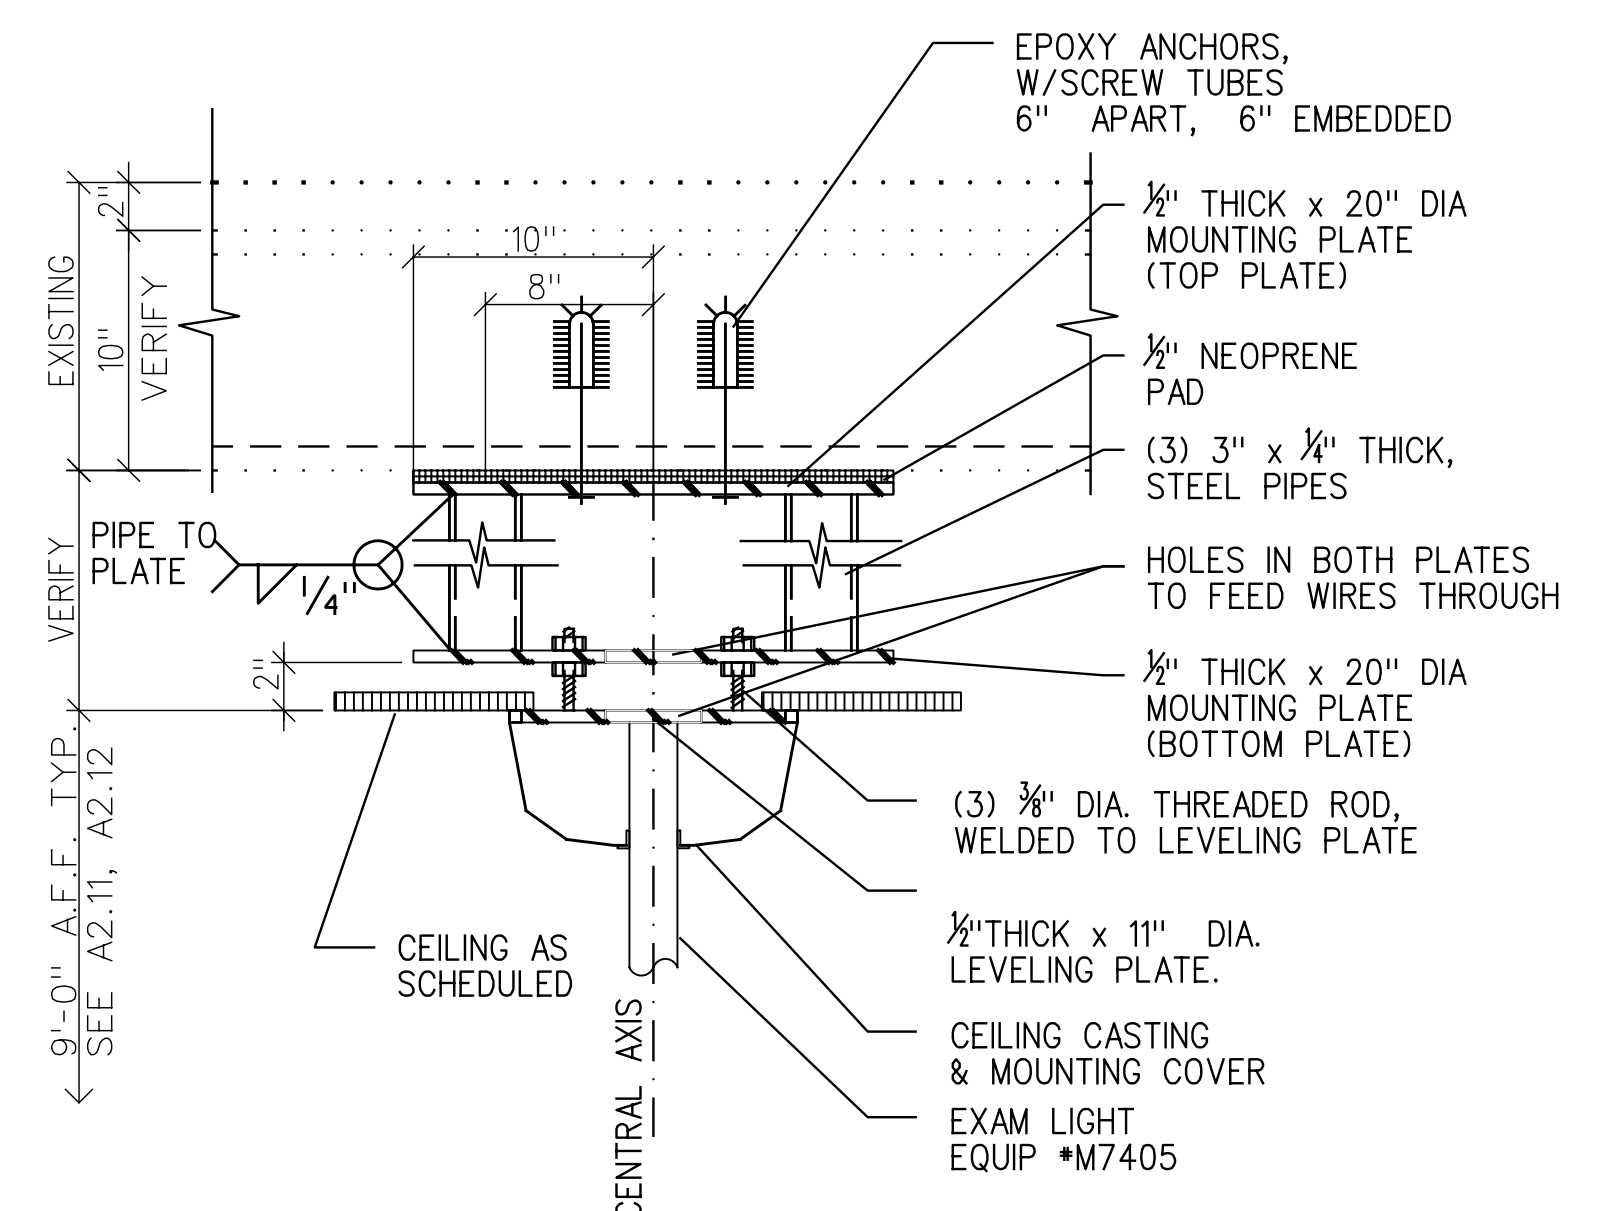


2 CEILING MOUNTED LIGHT SUPPORT DETAIL
* SEE SPEC 11750
1 1/2"=1'-0"

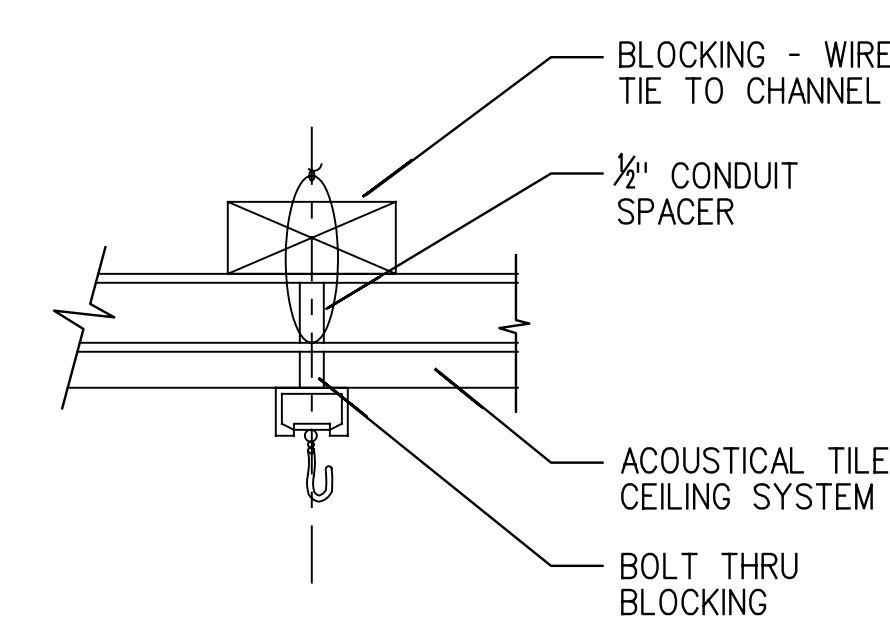


3 TYPICAL CUBICLE CURTAIN
1 1/2"=1'-0"

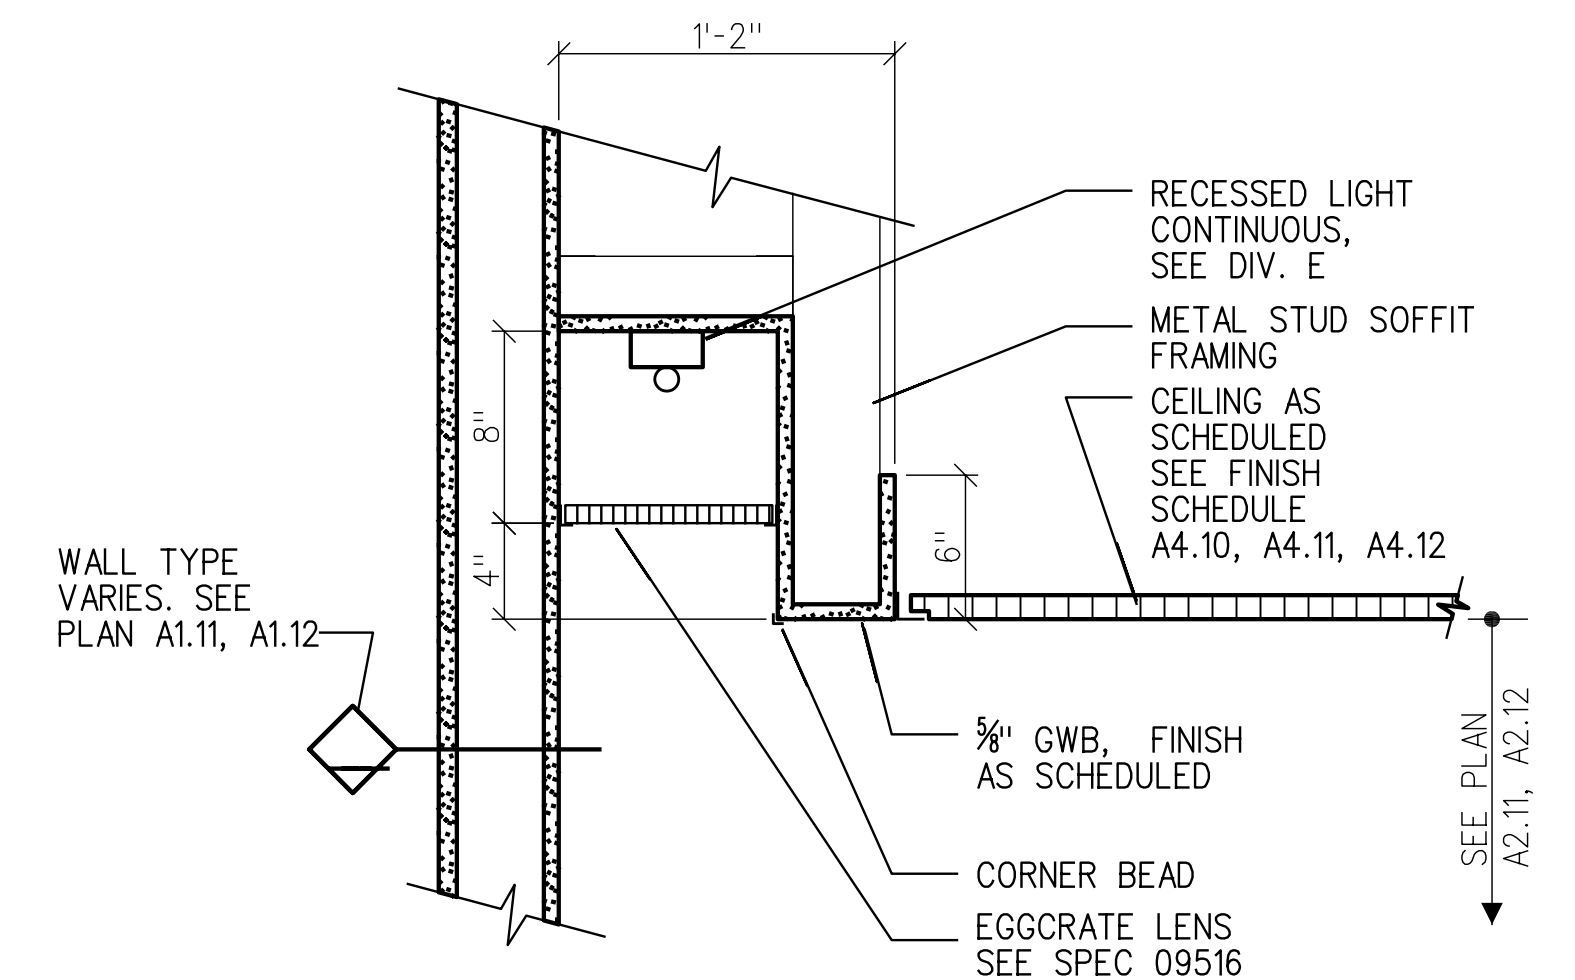


4 LIGHT DETAIL AT TOILET ROOM
1 1/2"=1'-0"

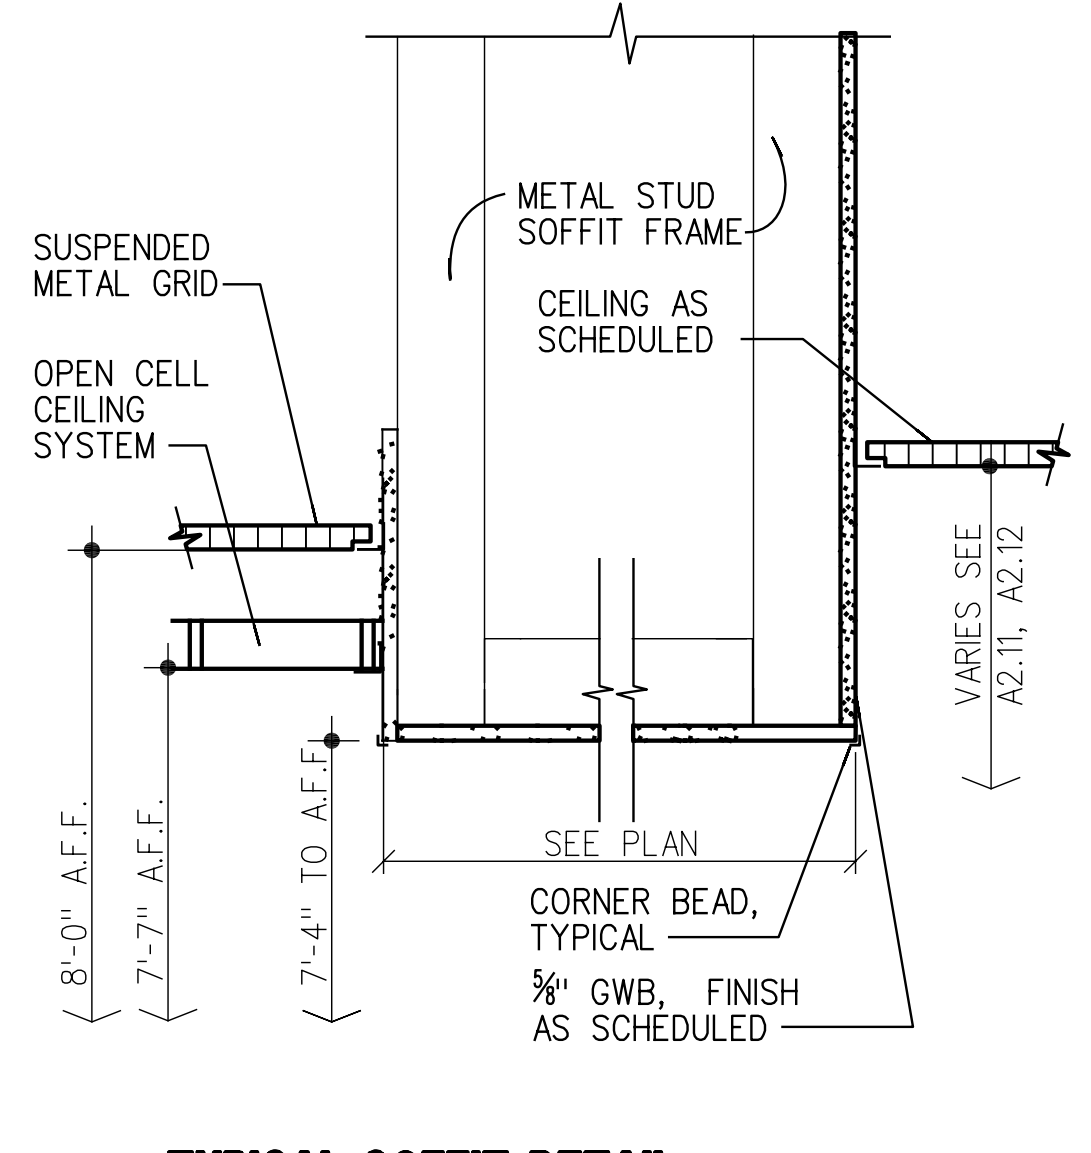


5A TYPICAL SOFFIT DETAIL AT RECEPTIONIST AREA
1 1/2"=1'-0"

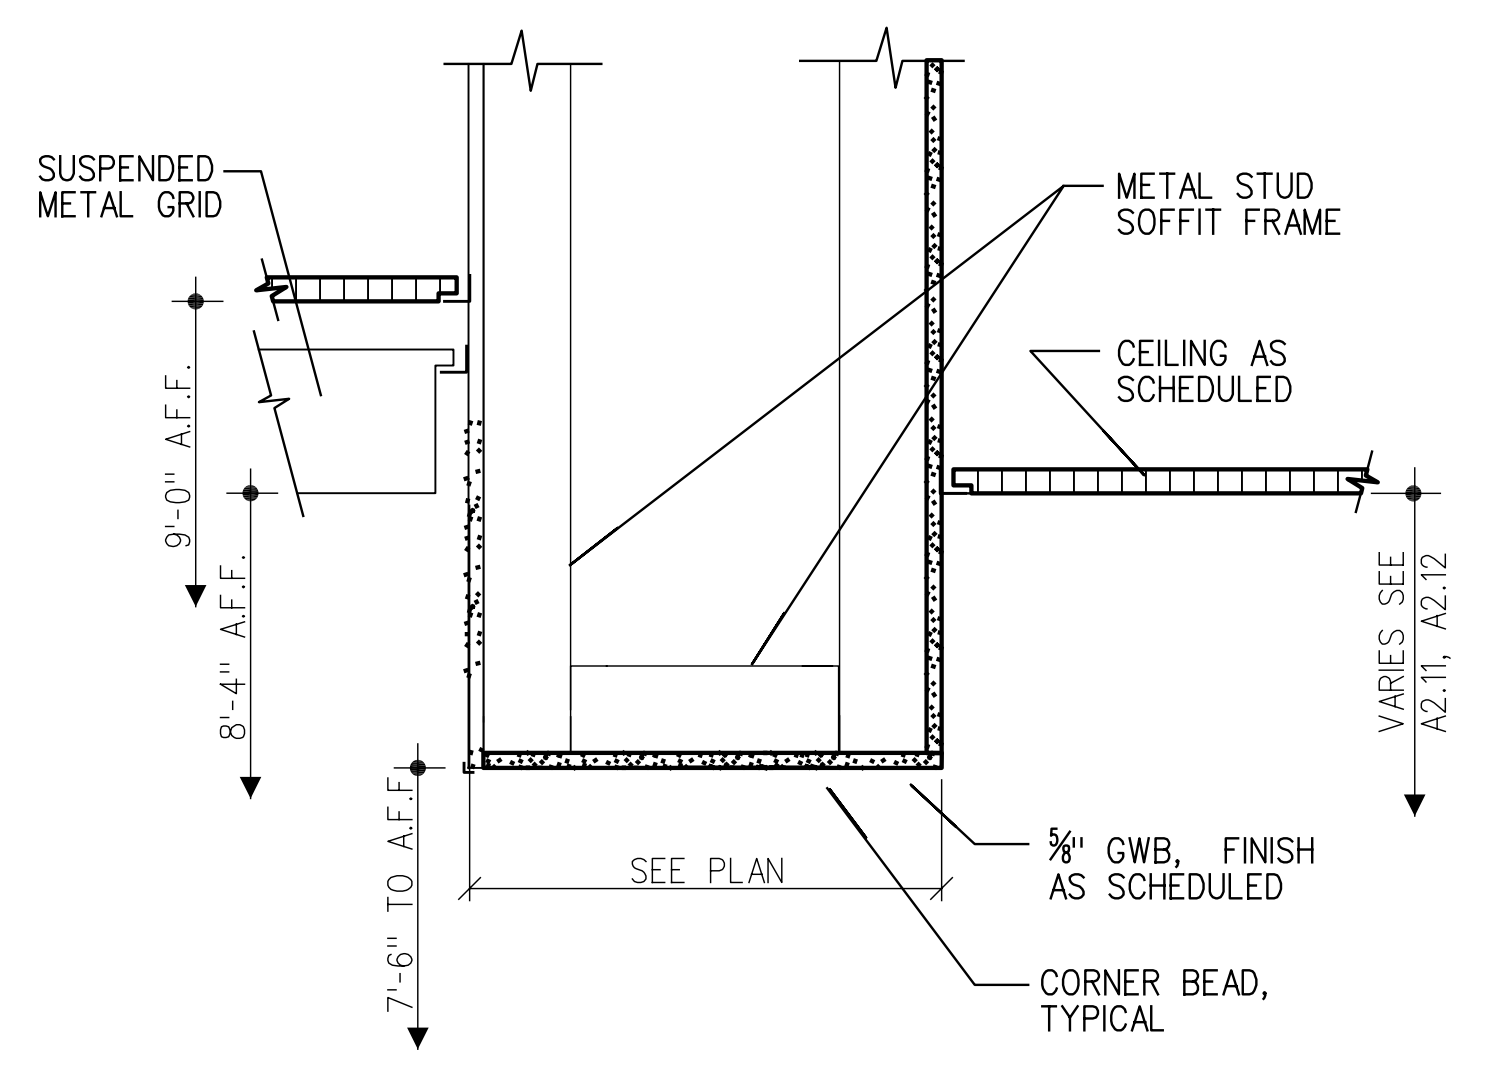


5 TYPICAL SOFFIT DETAIL AT RECEPTIONIST AREA
1 1/2"=1'-0"

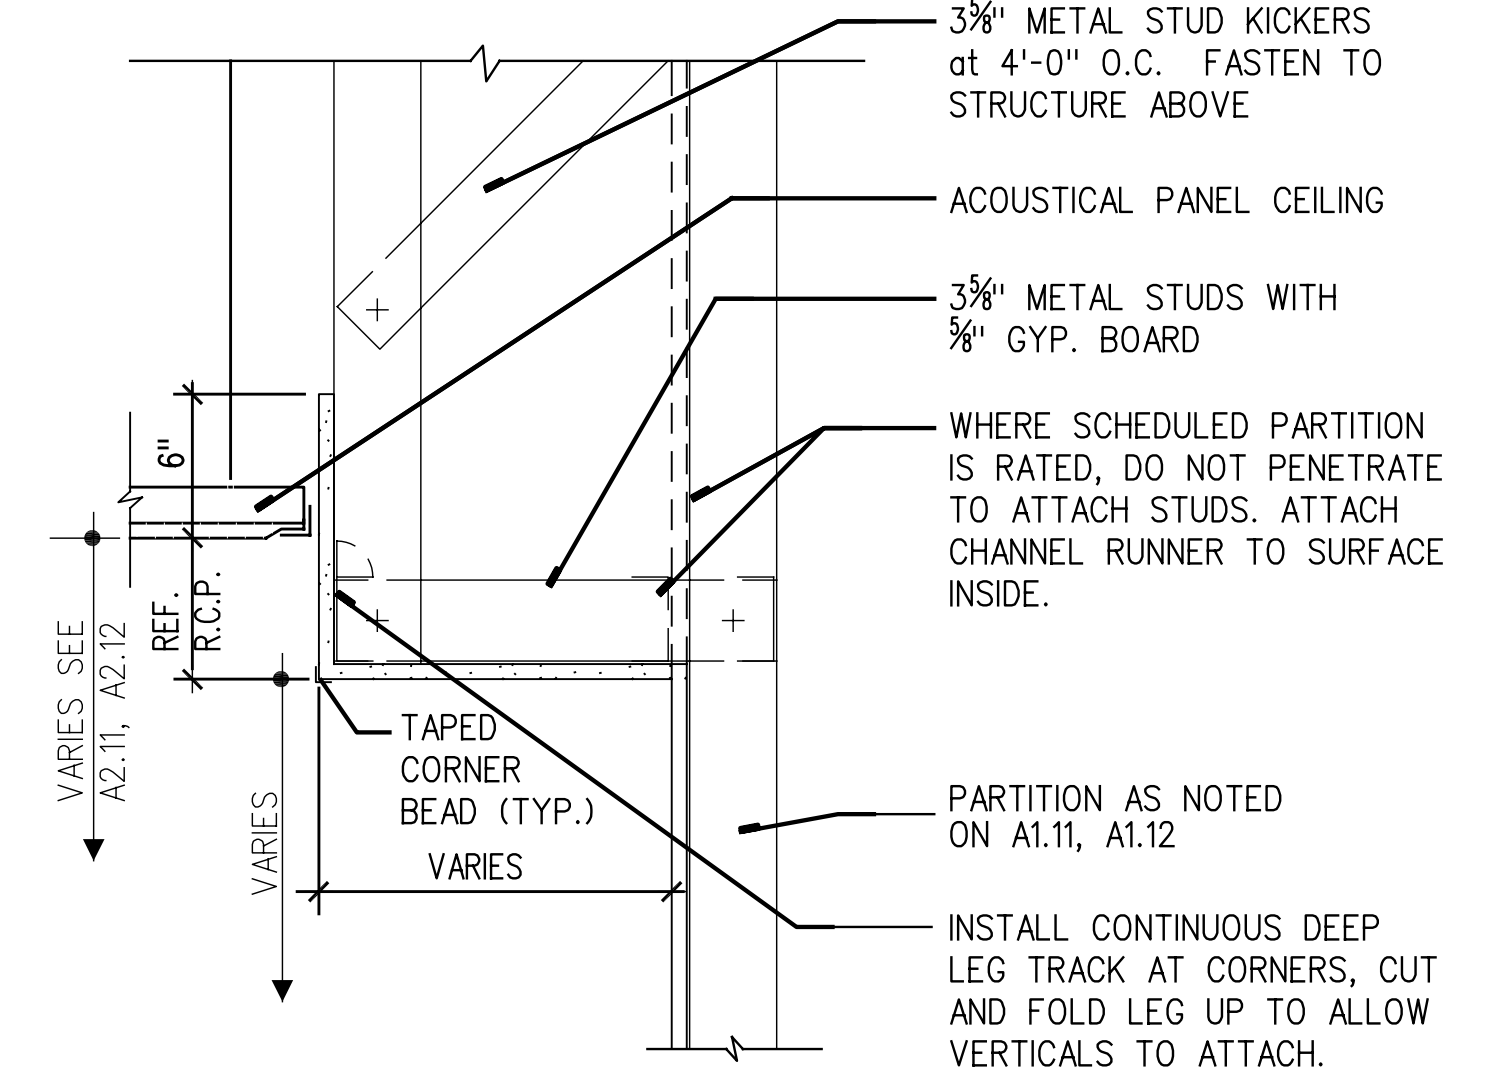


6 CEILING SECTION THROUGH SOFFIT
1 1/2"=1'-0"

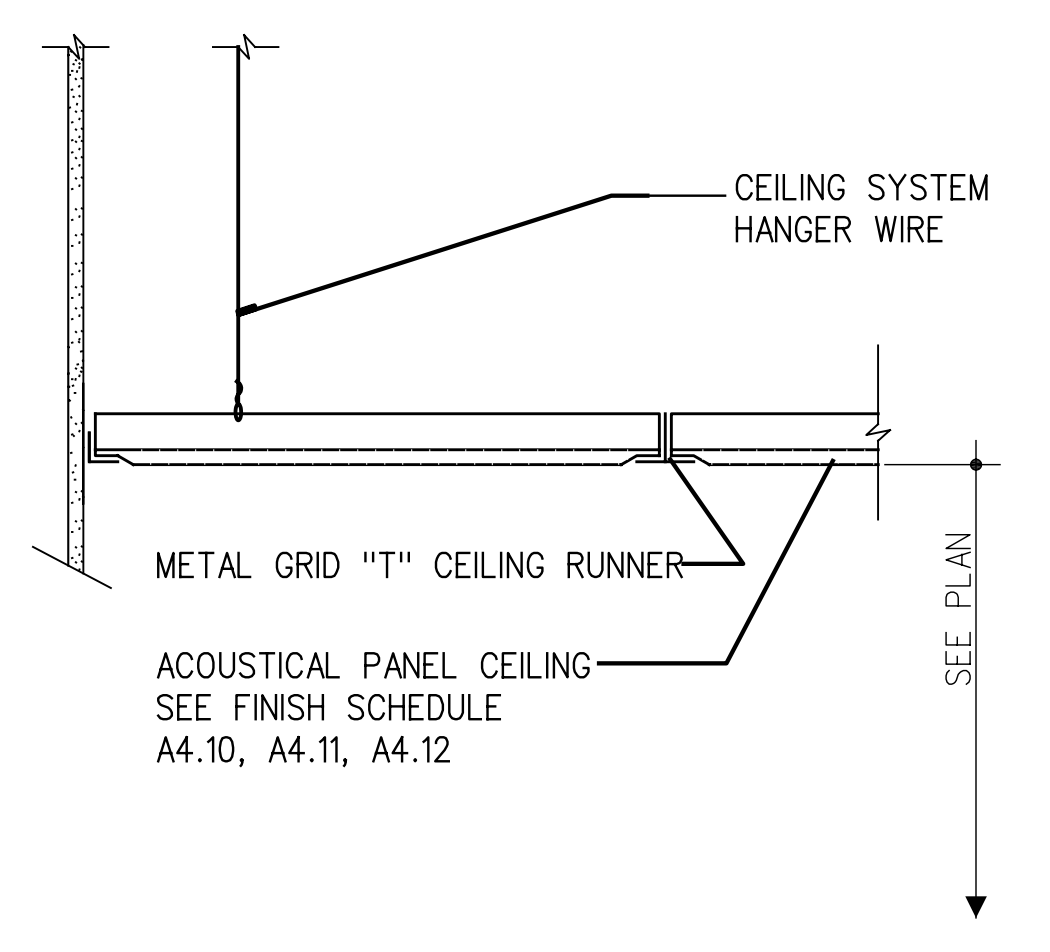


7 TYP. ACOUSTICAL PANEL CEILING DETAIL
1 1/2"=1'-0"

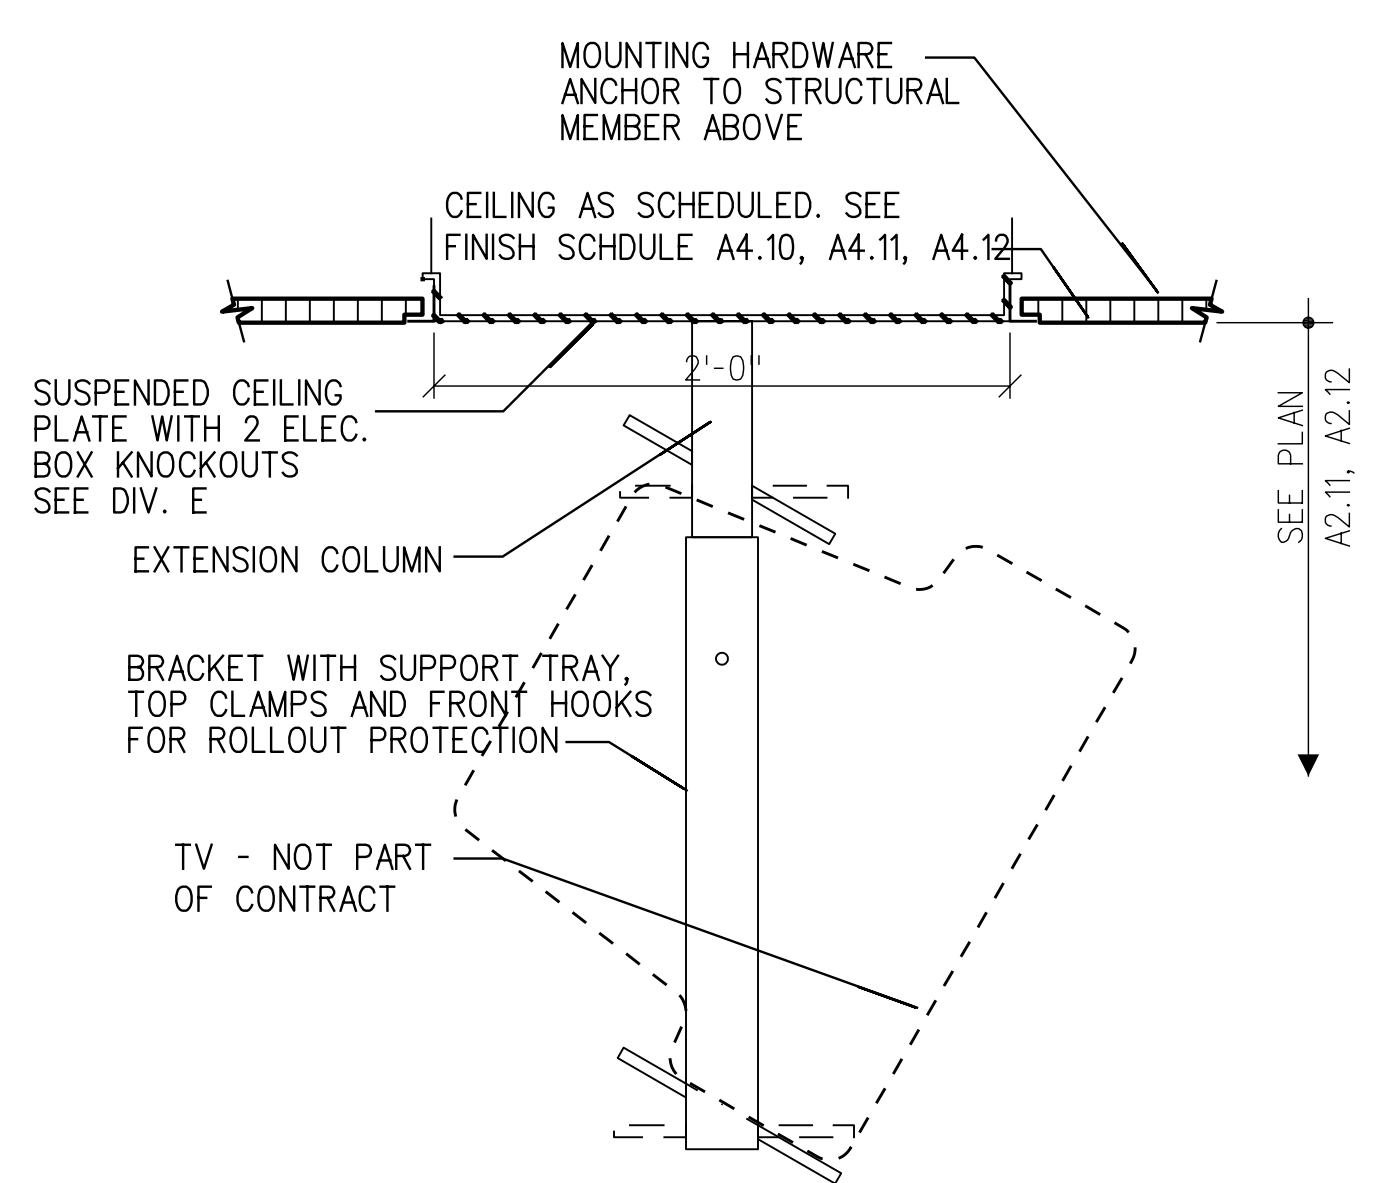


8 SUSPENDED TV CEILING MOUNTED CONNECTION
* SEE SPEC 11140
1 1/2"=1'-0"

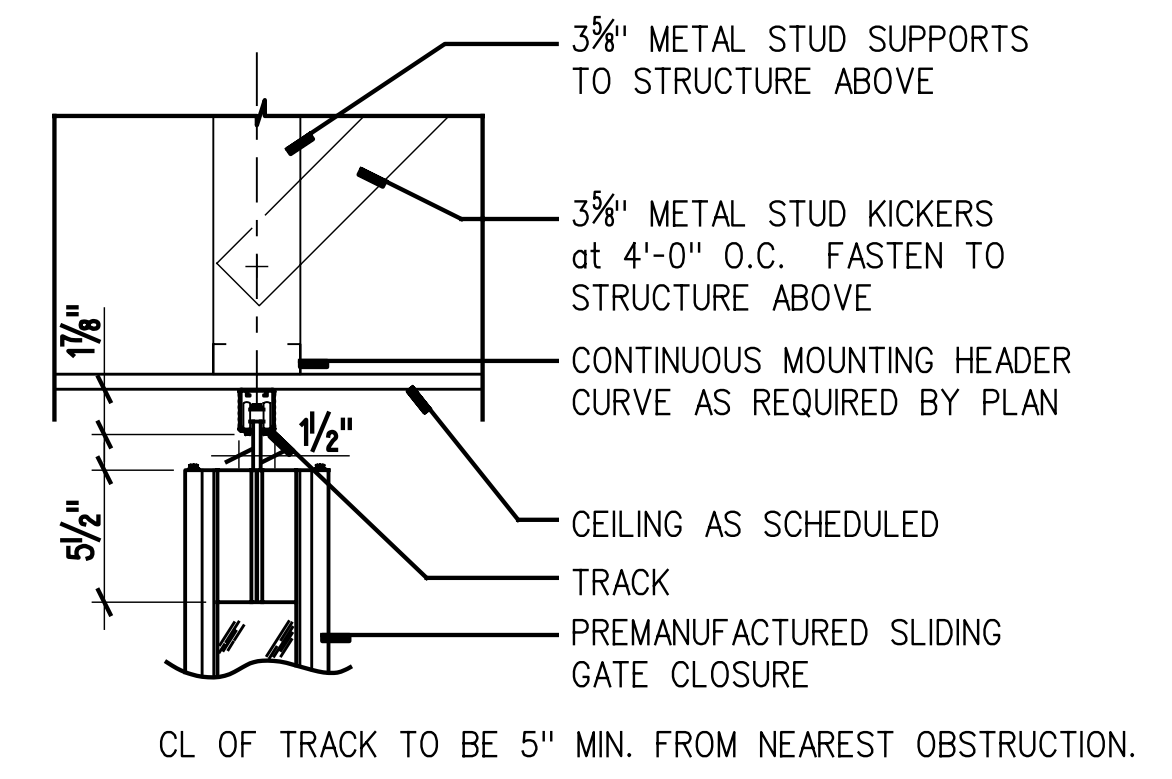


9 SECTION THROUGH TRACK, HANGER & ROLLER ASSEMBLY
* SEE SPEC 08350
1 1/2"=1'-0"

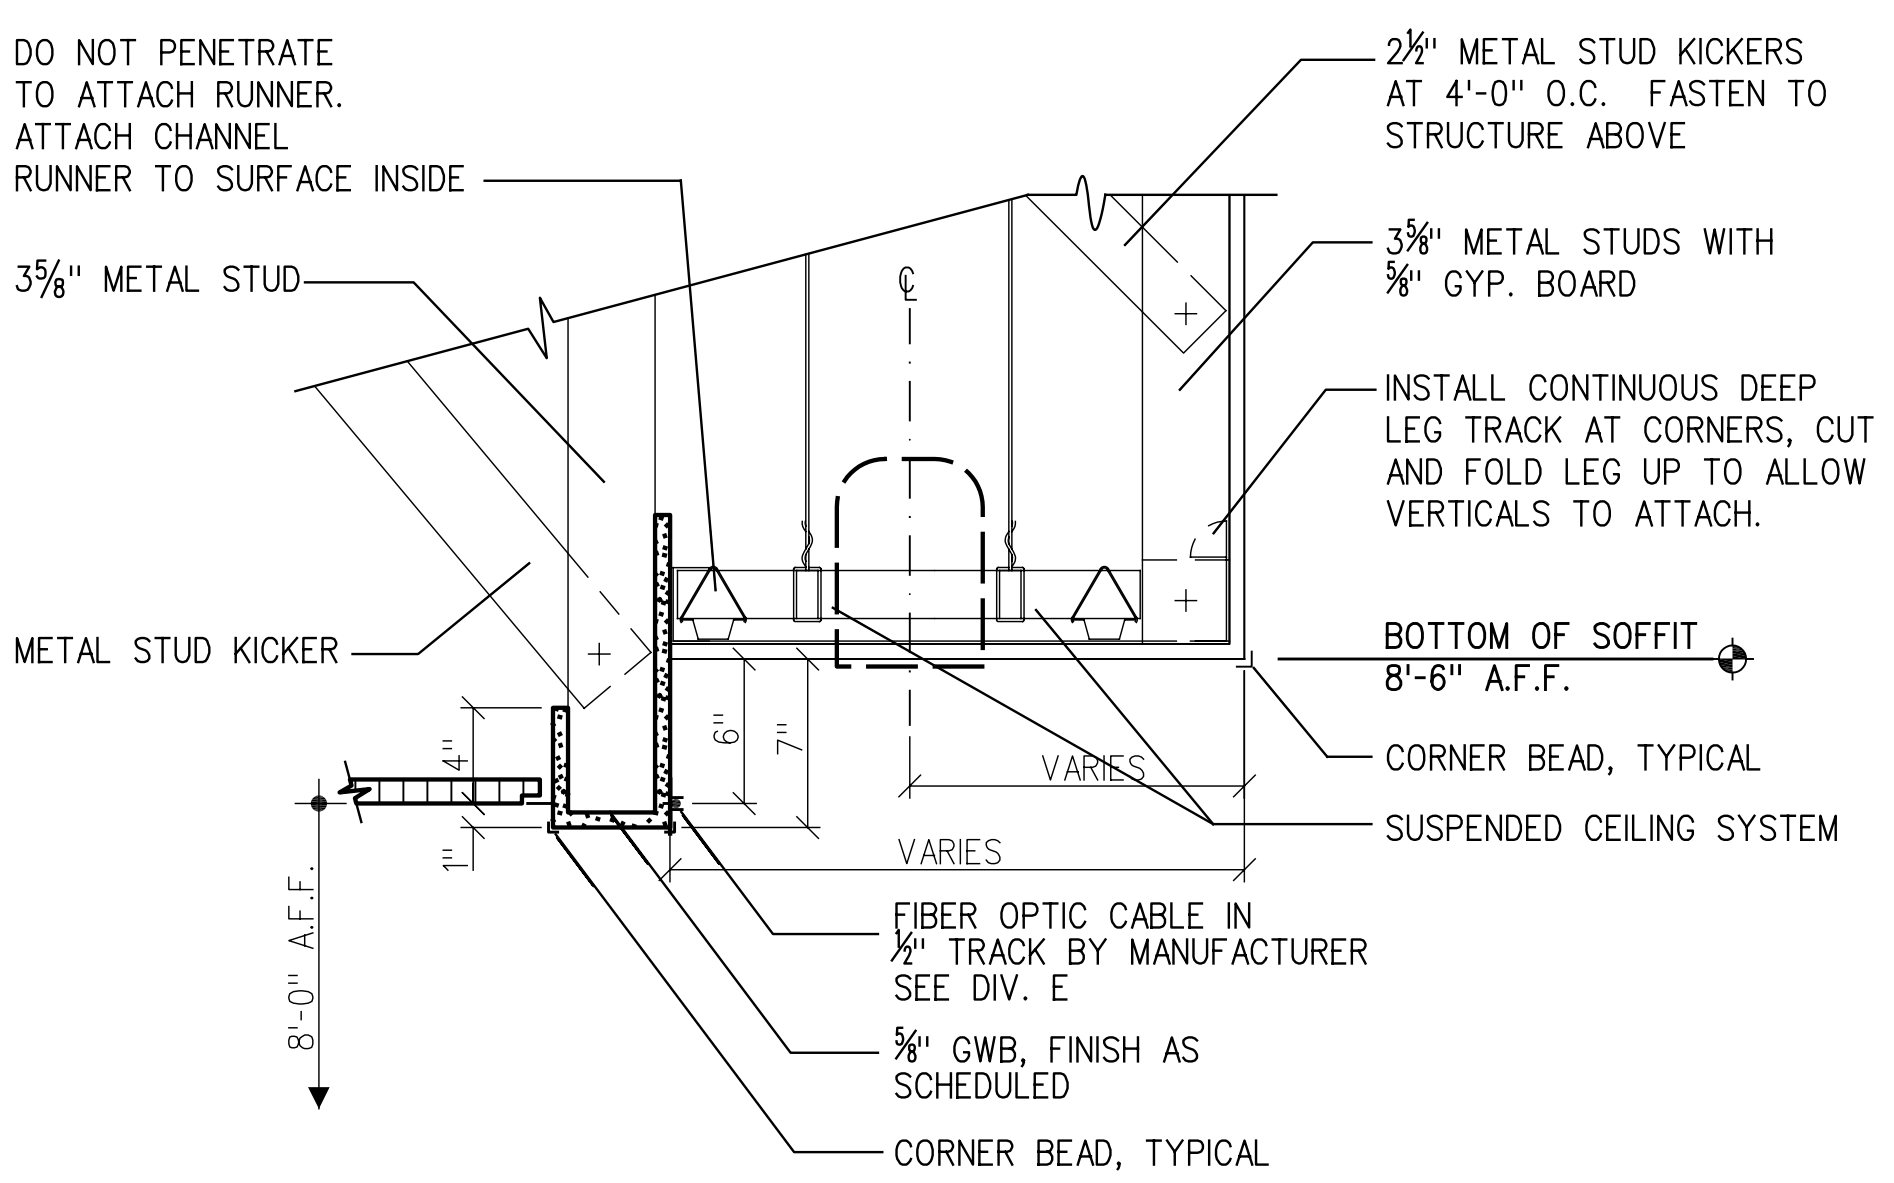


10 SECTION THROUGH BULKHEAD AND GYP. BD. SOFFIT
1 1/2"=1'-0"

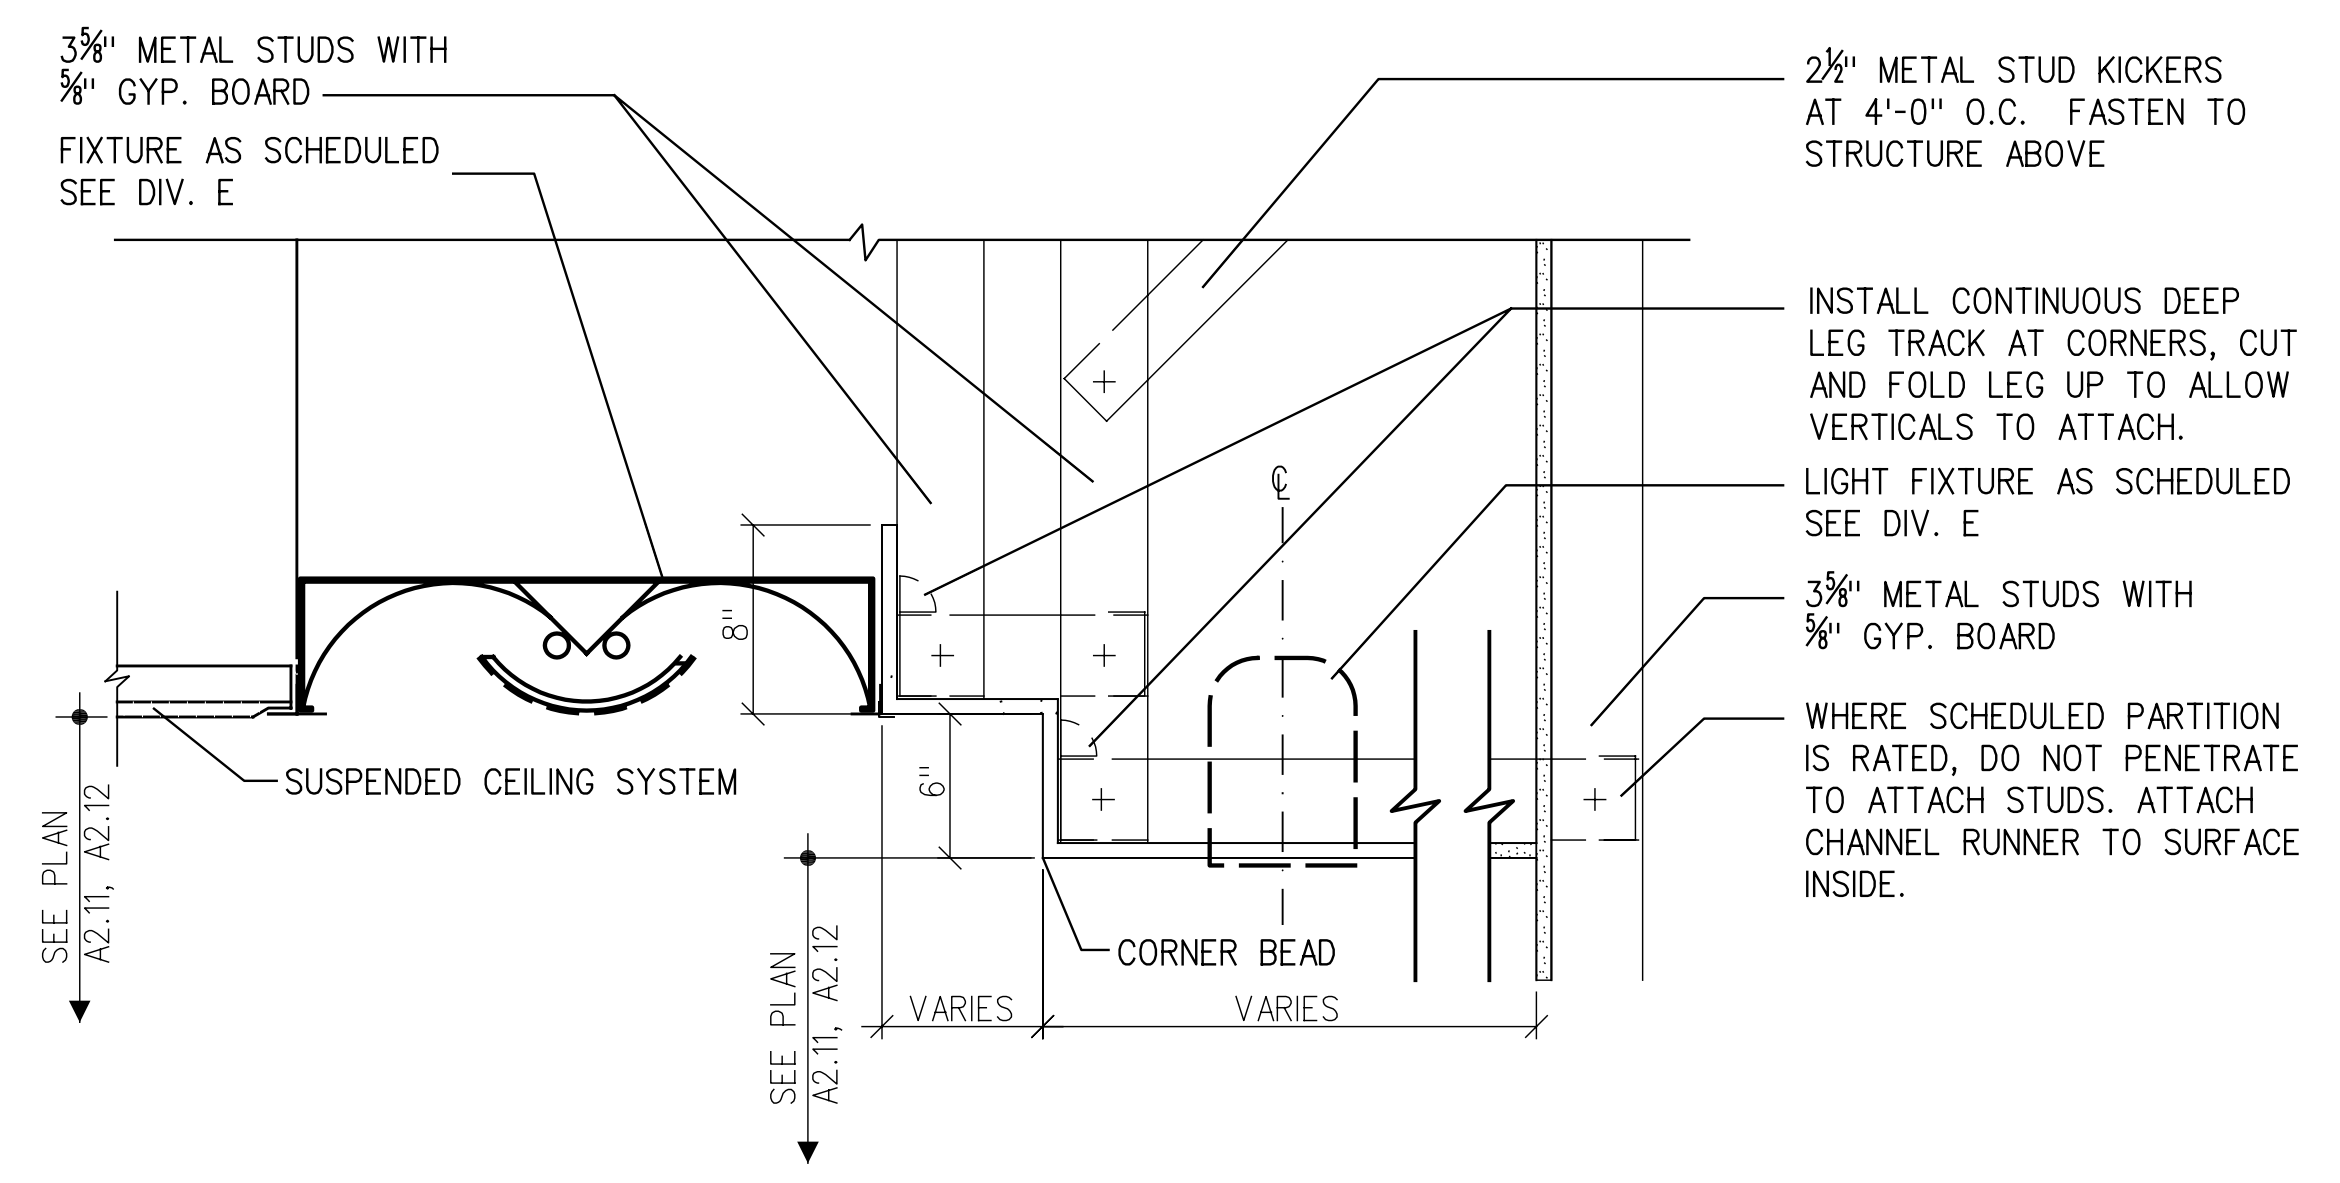


11 SOFFIT AT CORRIDOR LIGHT FIXTURE
1 1/2"=1'-0"

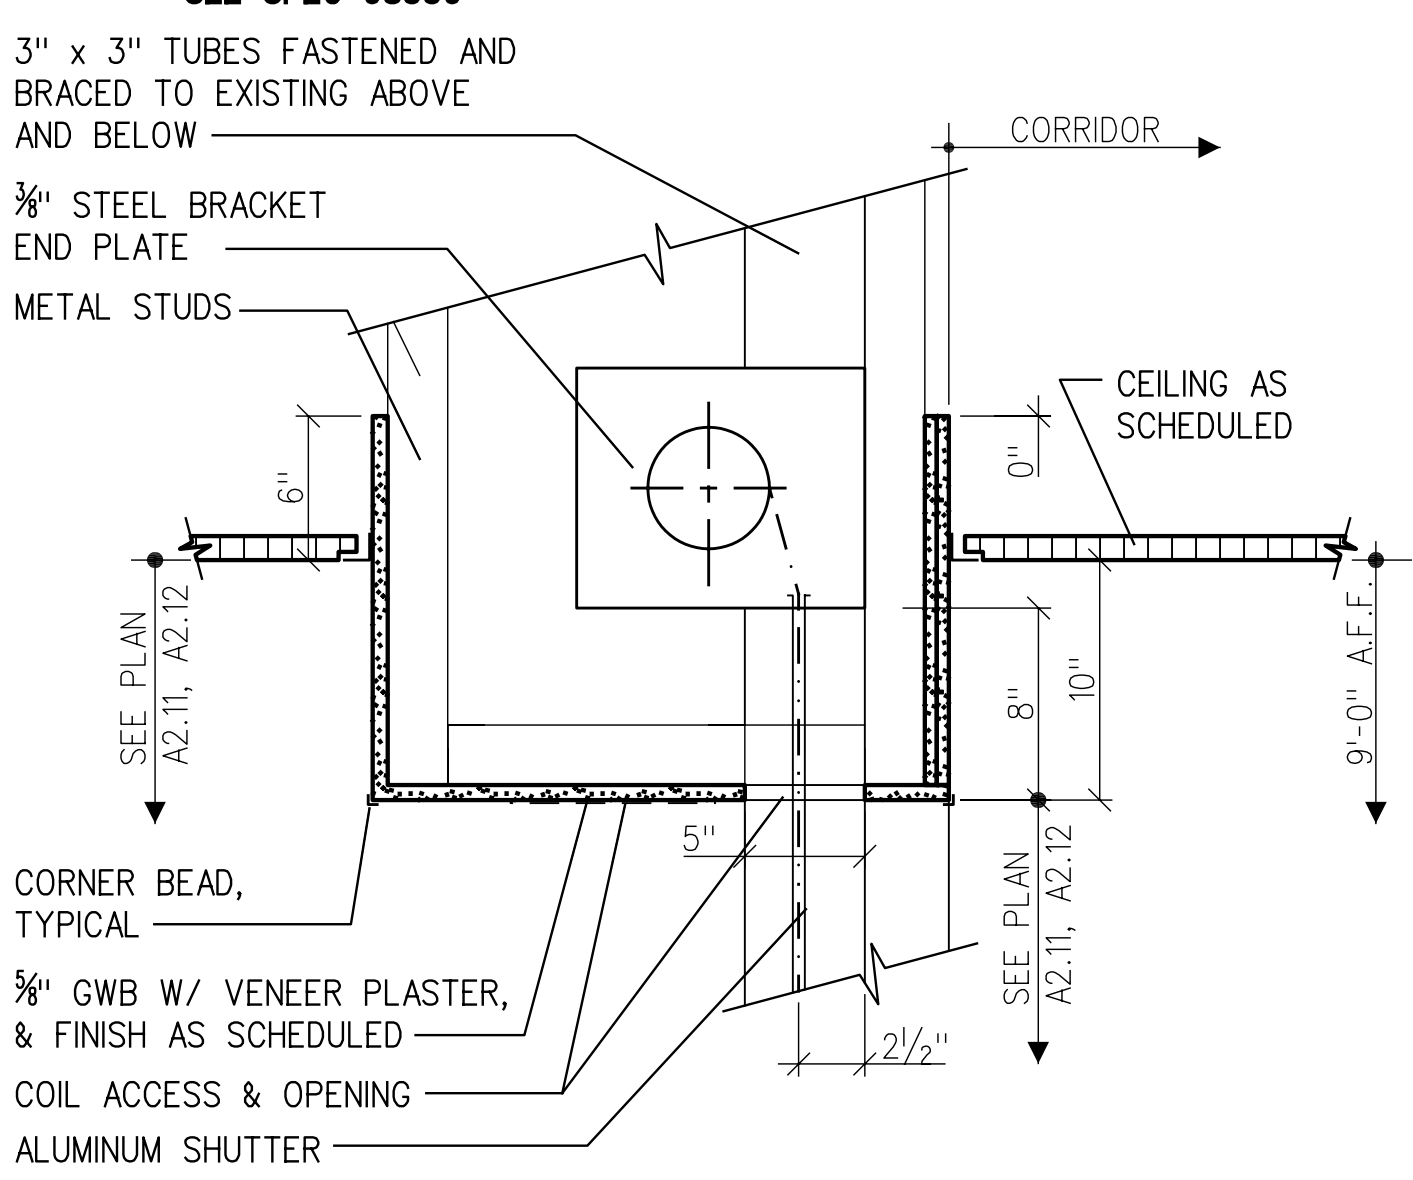

12 ALUMINUM SHUTTER (NON-RATED) SECTION
* SEE SPEC 08345
1 1/2"=1'-0"

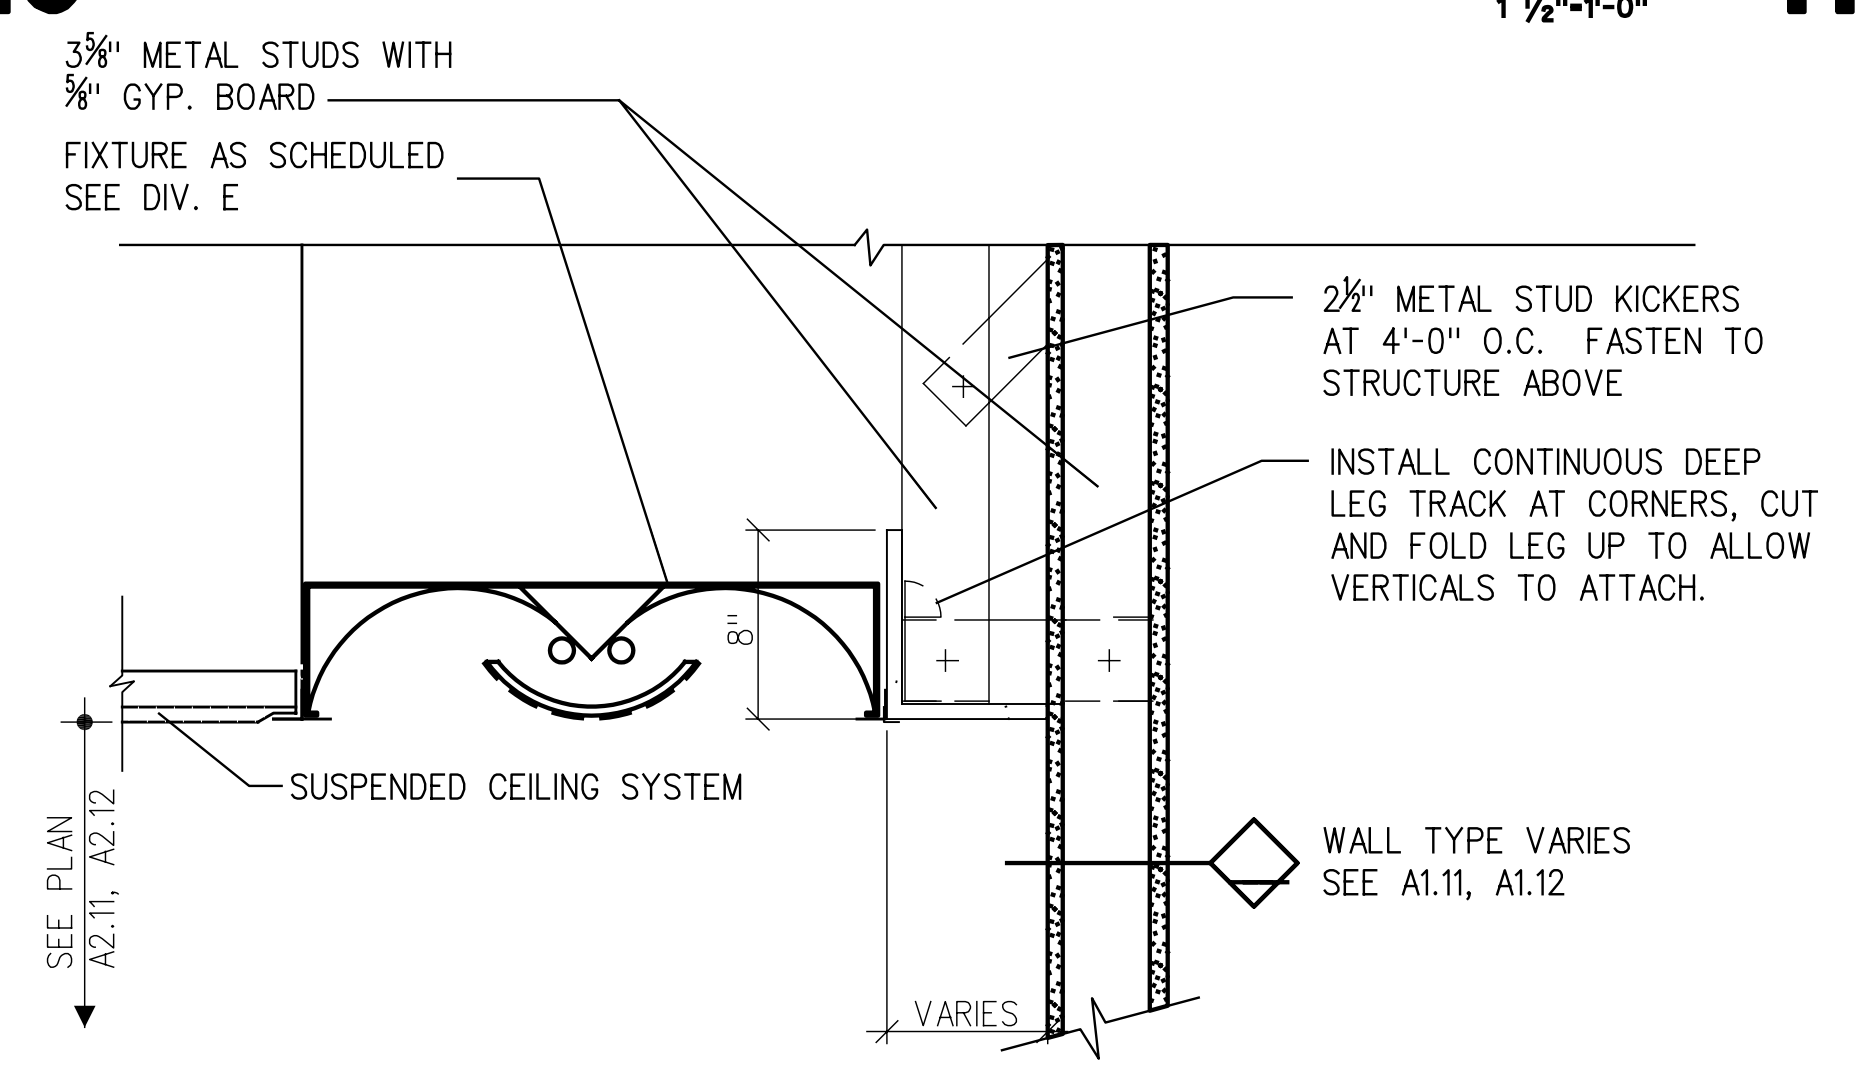

13 SOFFIT AT CORRIDOR LIGHT FIXTURE
1 1/2"=1'-0"

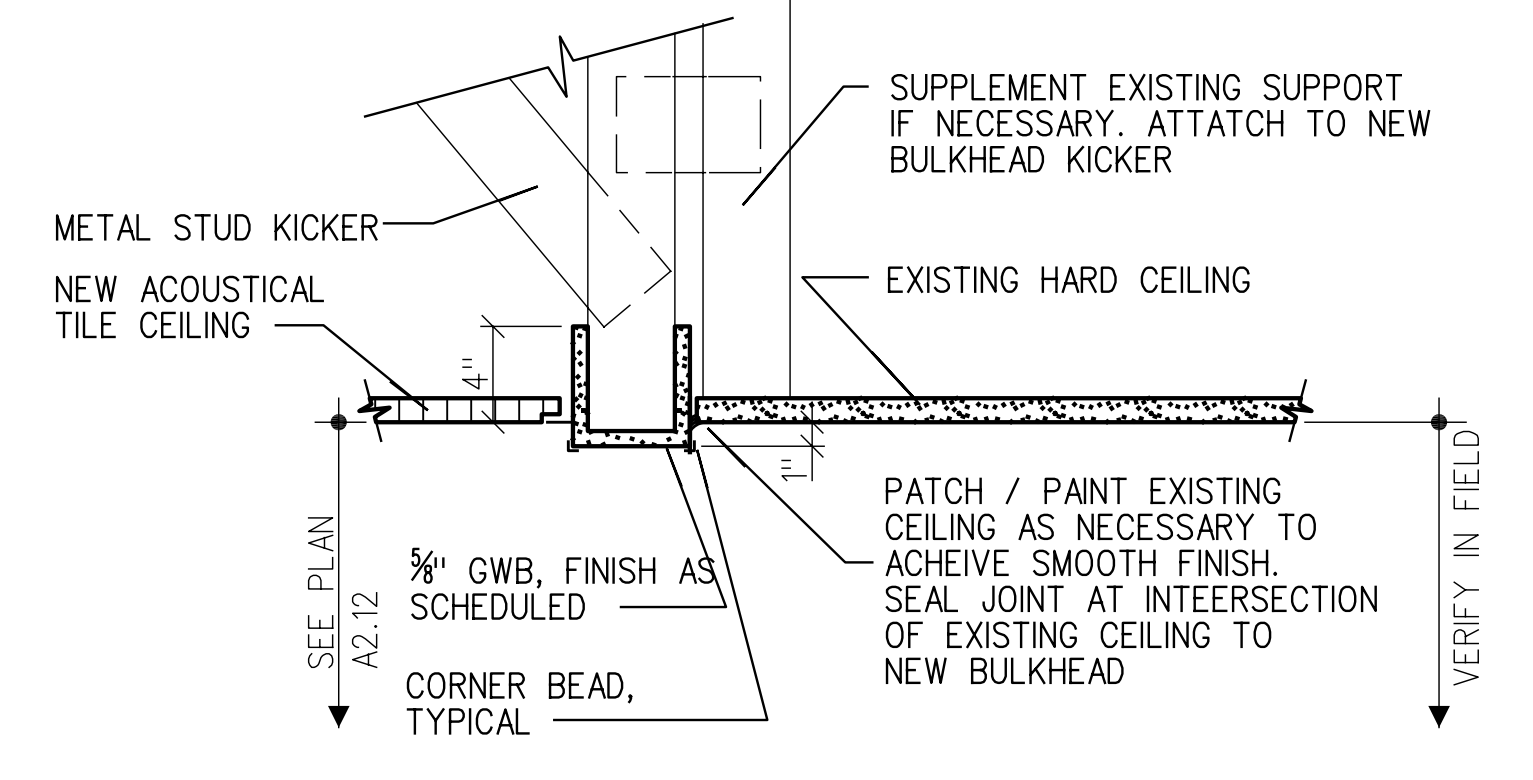

14 BULKHEAD DETAIL AT INTERSECTION WITH EXISTING
1 1/2"=1'-0"