


LITTLE ROCK A.F.B.
ARKANSAS


FPM

804 West Curtis Drive, Suite H
Midwest City, OK 73110
phone: 405.869.9212
fax: 405.869.9222
www.fpm-group.com


RECORD
DRAWINGS
MARCH 2007

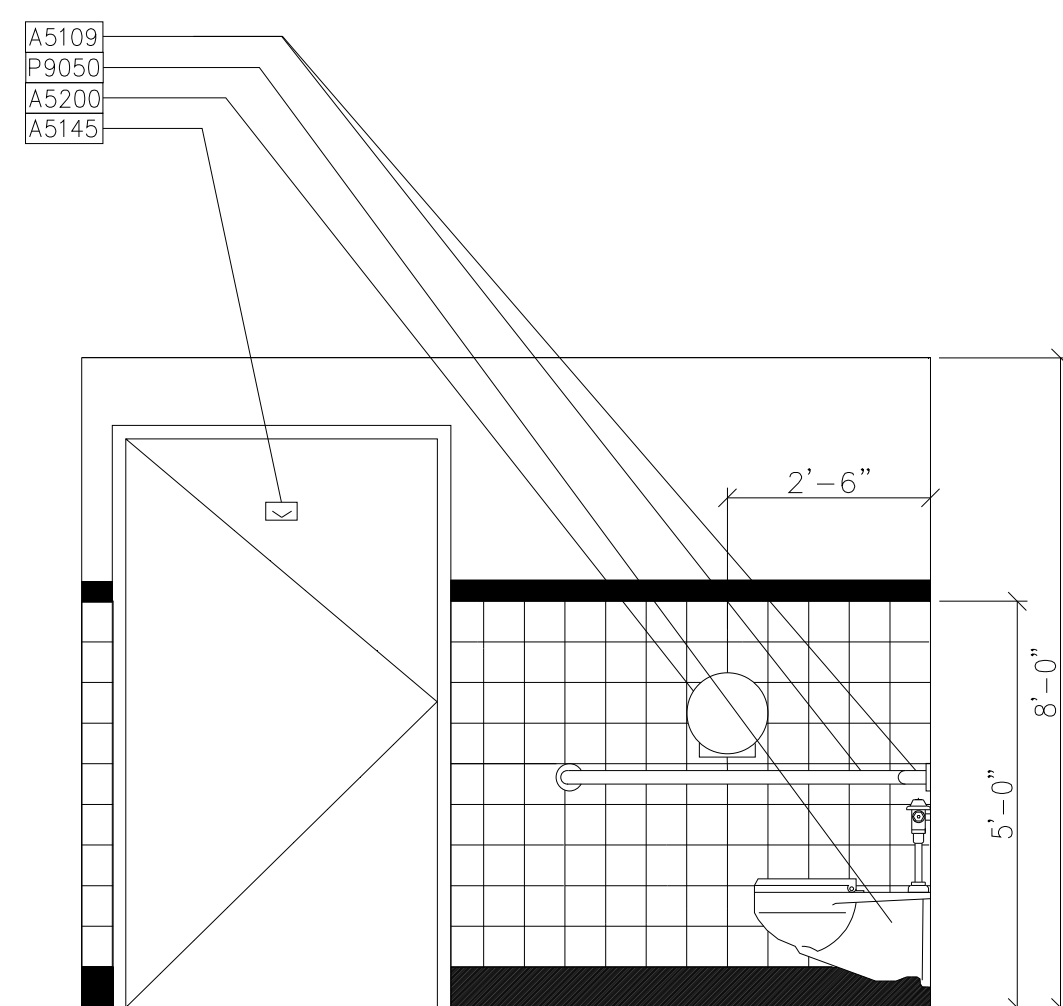


1 TOILET - A181
SCALE: 1/2"=1'-0"

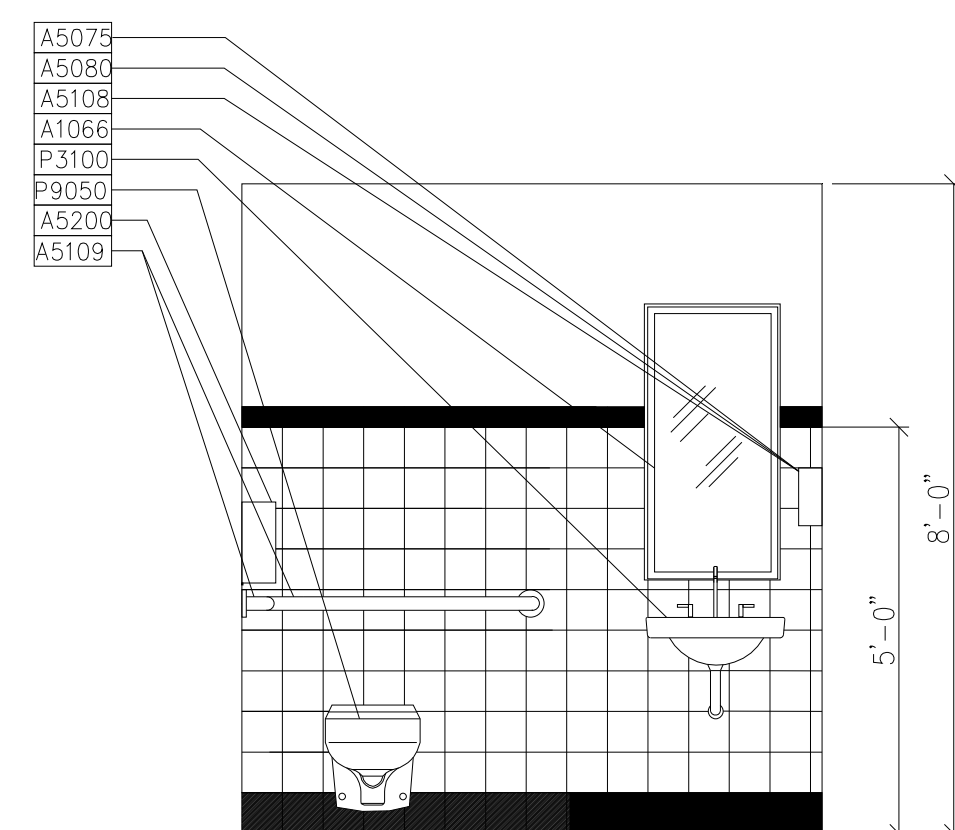


2 TOILET - A188
SCALE: 1/2"=1'-0"

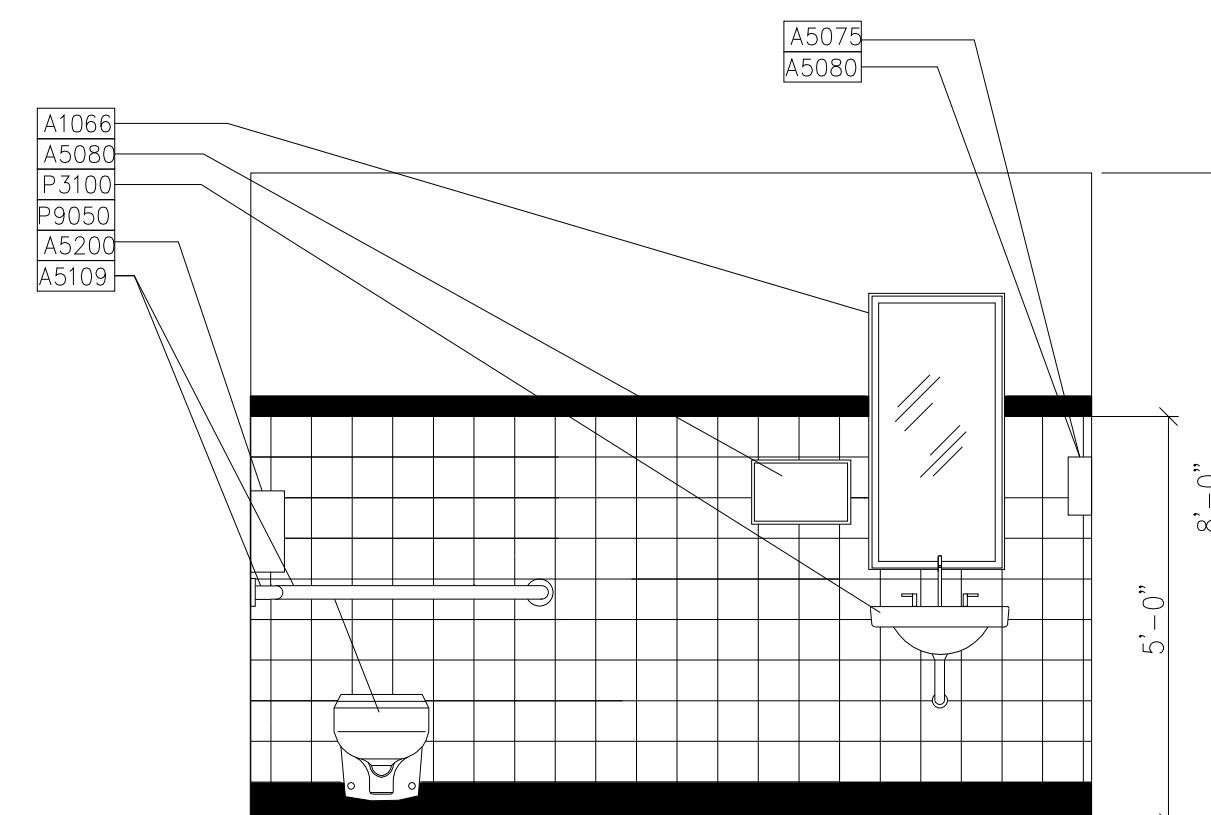


3 TOILET - A218
SCALE: 1/2"=1'-0"

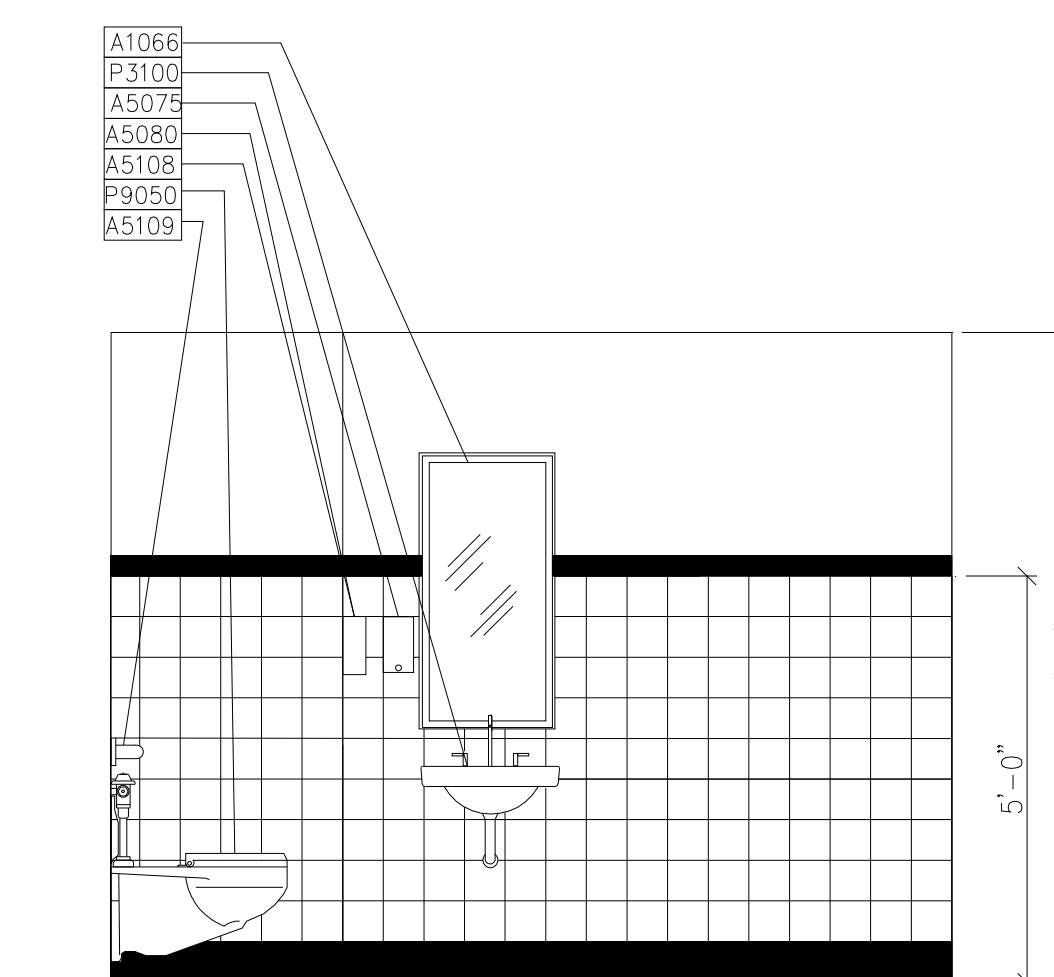

4 TOILET - A245
SCALE: 1/2"=1'-0"

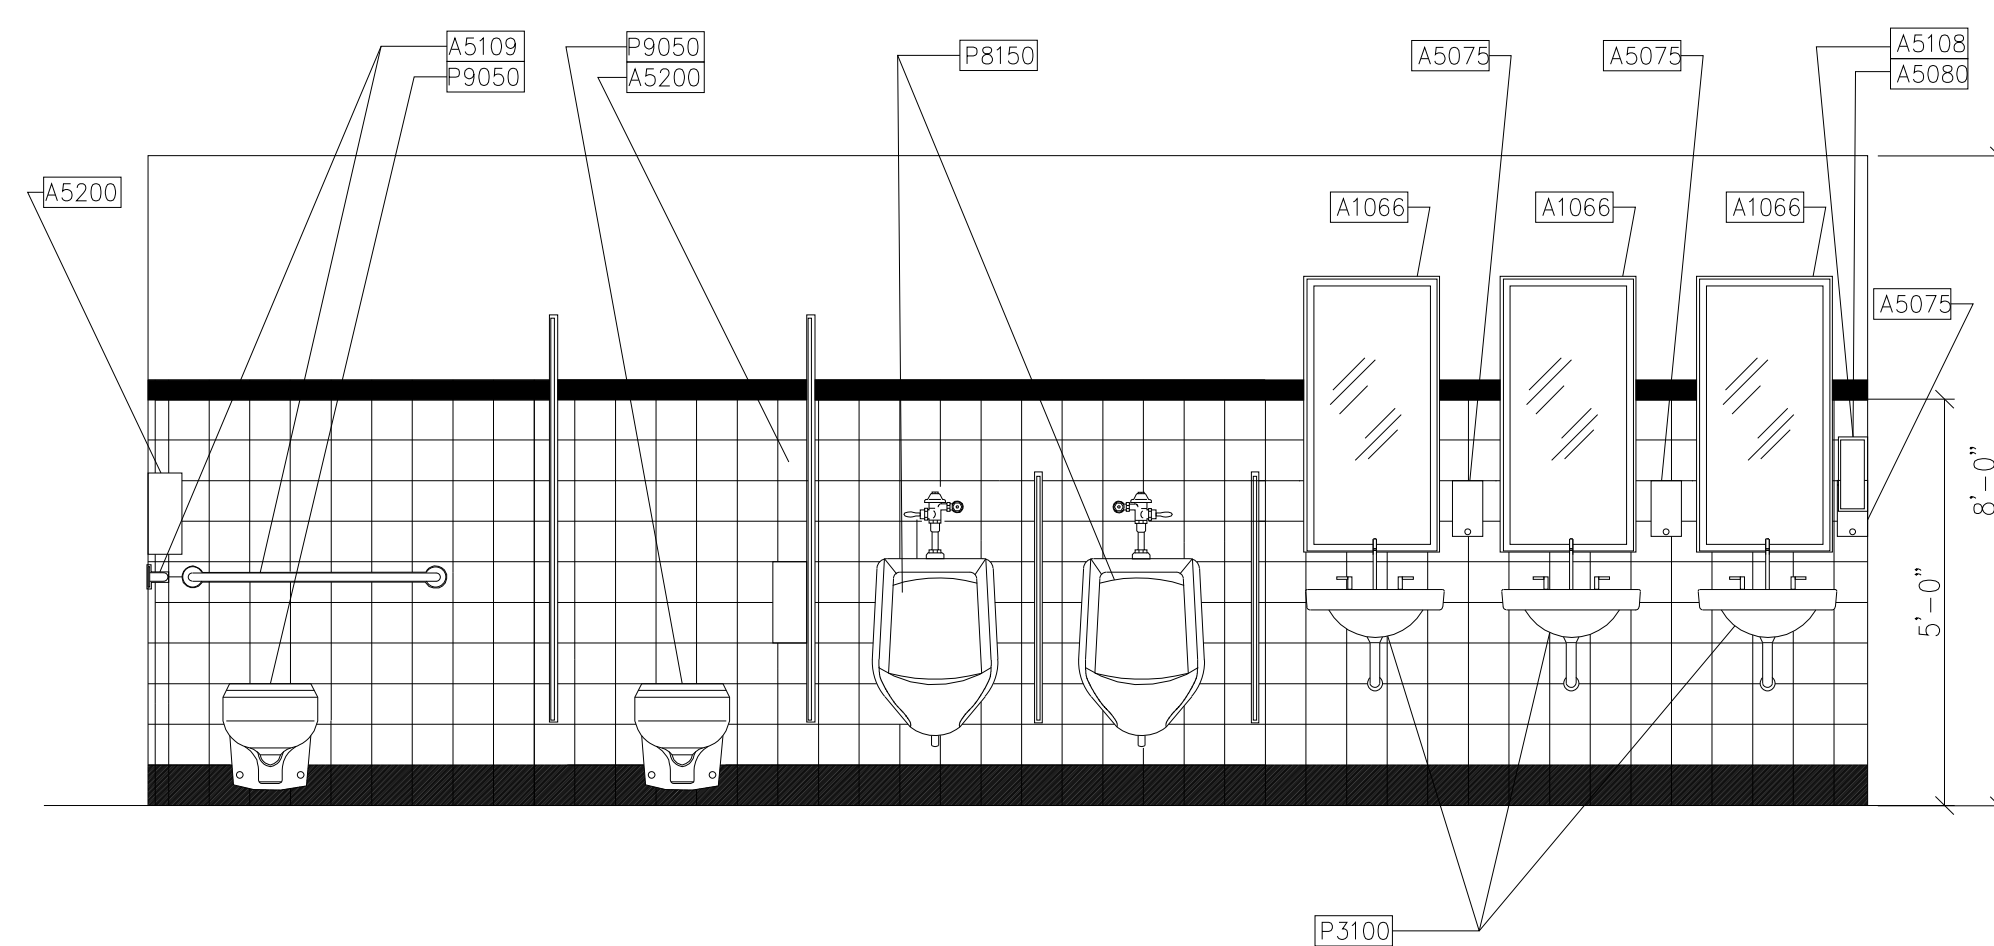

5 TOILET - A238
SCALE: 1/2"=1'-0"


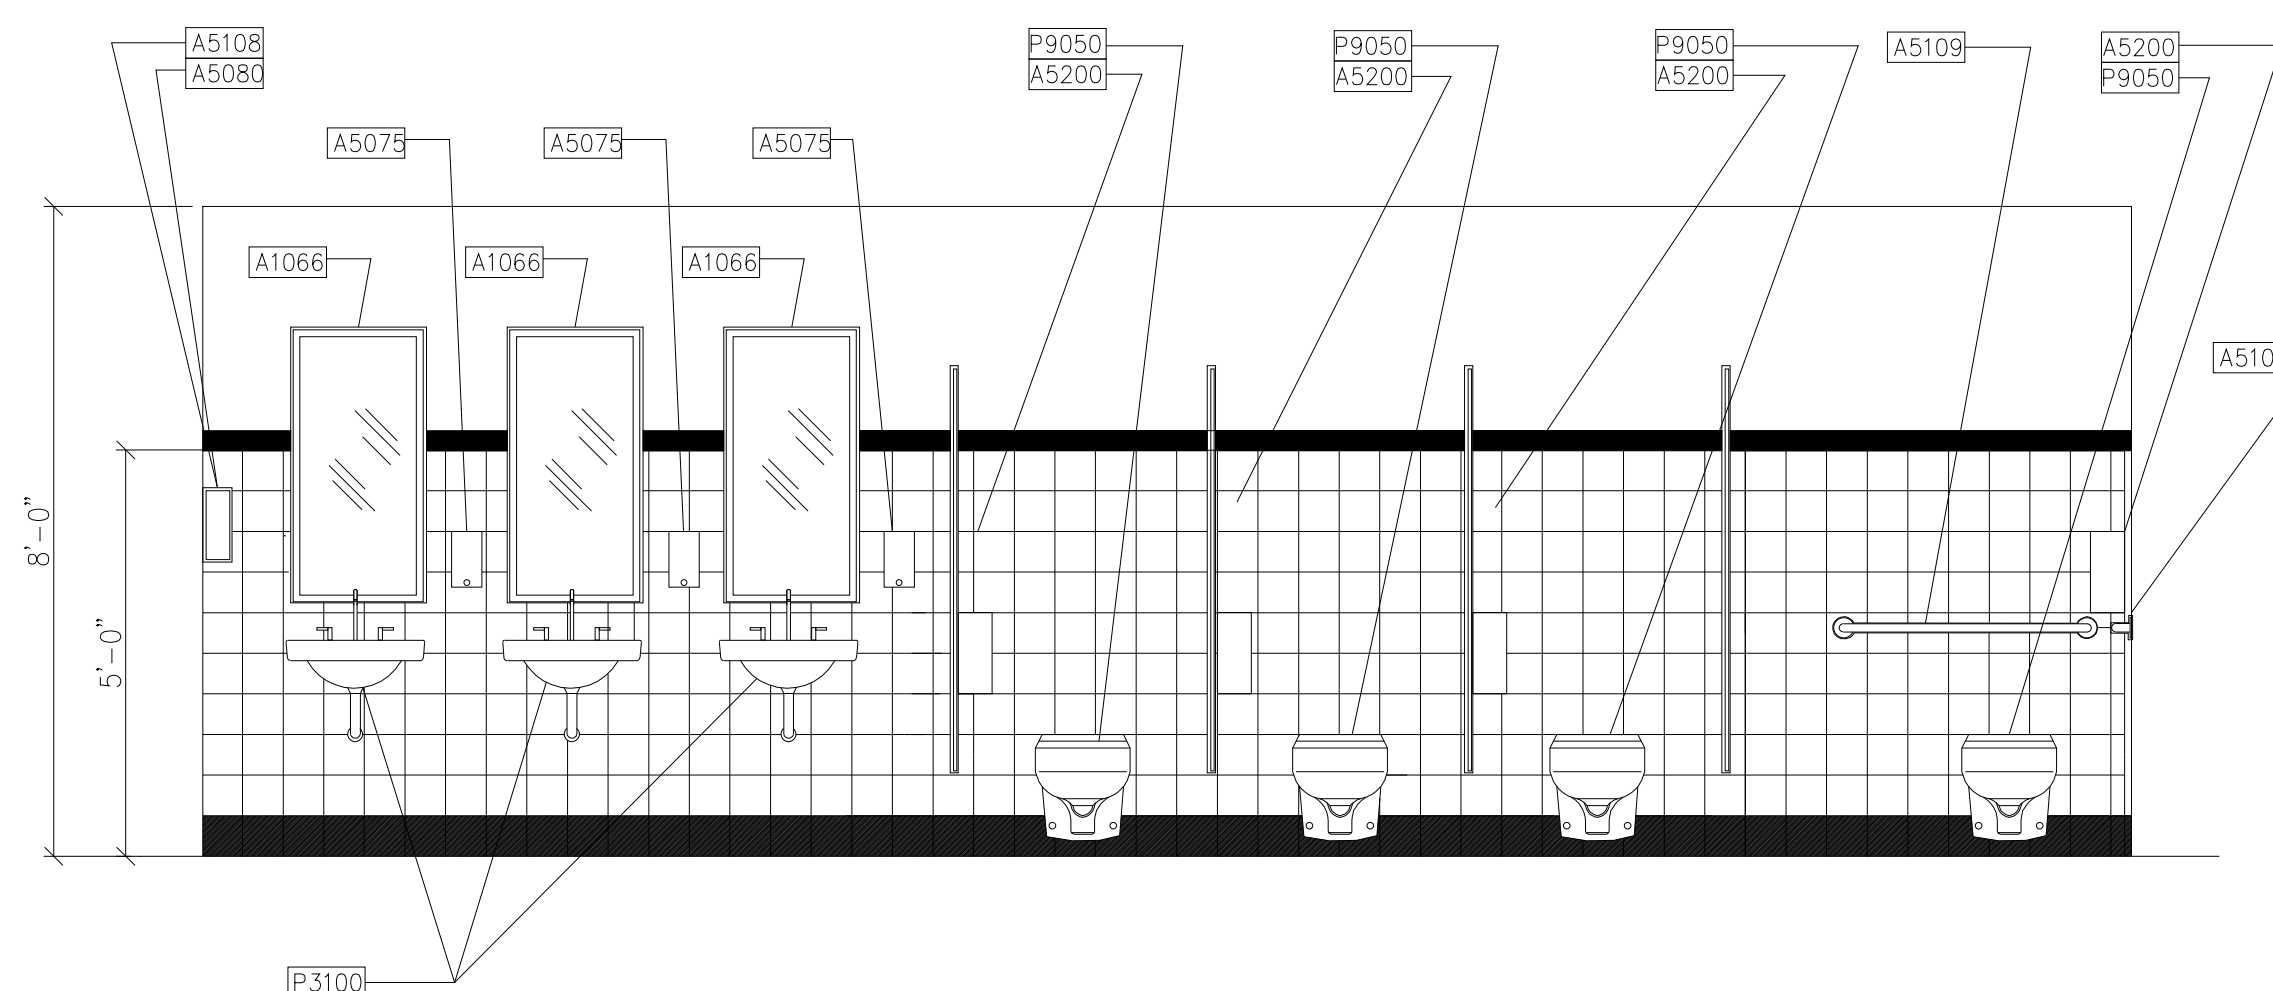


6 TOILET - A121
SCALE: 1/2"=1'-0"

NOTE:

ALSO REFER TO SHEET A3.10 FOR ACCESSORIES LEGEND

KEYPLAN
N.T.S.

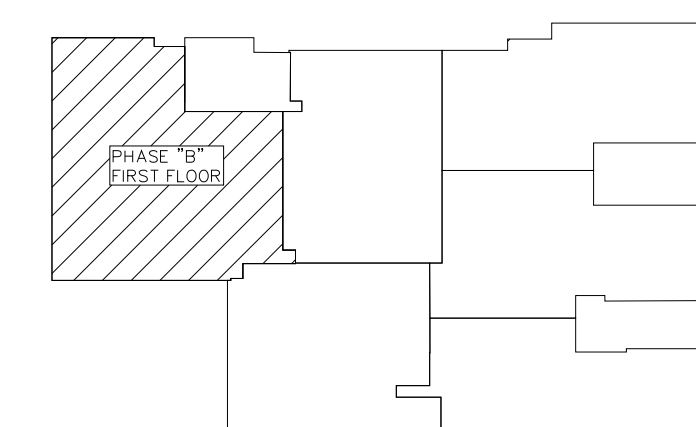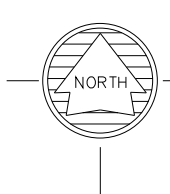

PROJECT TITLE
REPAIR MEDICAL CENTER PH B
LITTLE ROCK AFB, ARKANSAS

SHEET TITLE

| | |
|---------------------|---------------------------------|
| DRAWN BY RJR | LEAD DESIGNER AM |
| TECH REVIEWER AM | PROJECT NUMBER NKAK 05-8004A |
| DESIGNED BY AM | SHEET A3.20 |
| DATE 1-21-08 | |
| SCALE 1/2"=1'-0" | 9 OF 39 |

INTERIOR TOILET ROOM
ELEVATIONS