




LITTLE ROCK A.F.B.
ARKANSAS


FPM

804 West Curtis Drive, Suite H
Midwest City, OK 73110
phone: 405.869.9212
fax: 405.869.9222
www.fpm-group.com


RECORD
DRAWINGS
MARCH 2007

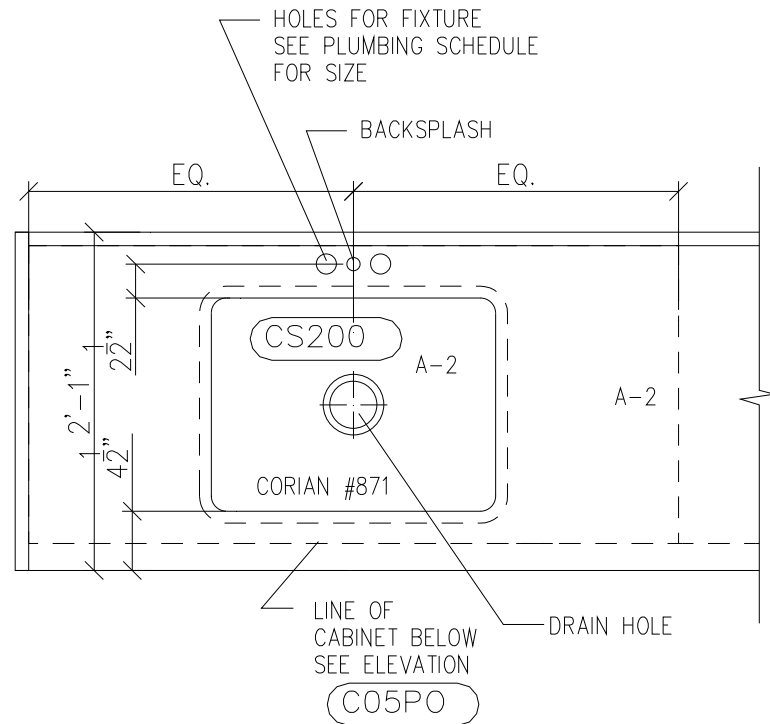


1 A213 DIRTY UTILITY
SCALE 1"=1'-0"

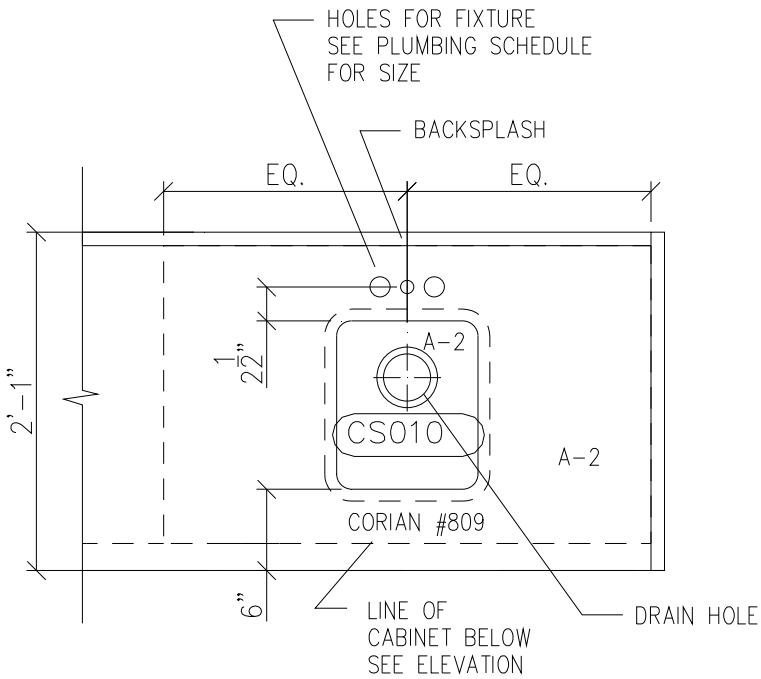

2 A250, A187 BREAK ROOM
SCALE 1"=1'-0"

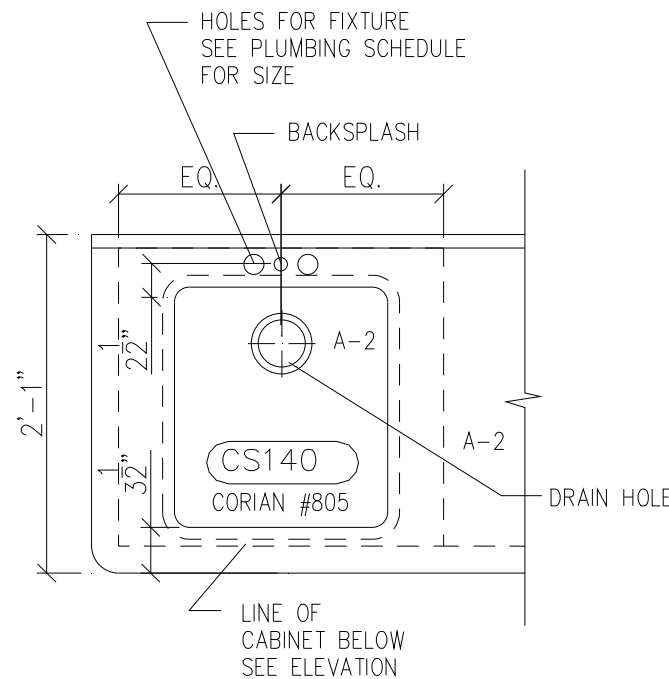


3 A124 - IMMUNIZATION ROOM
SCALE 1"=1'-0"

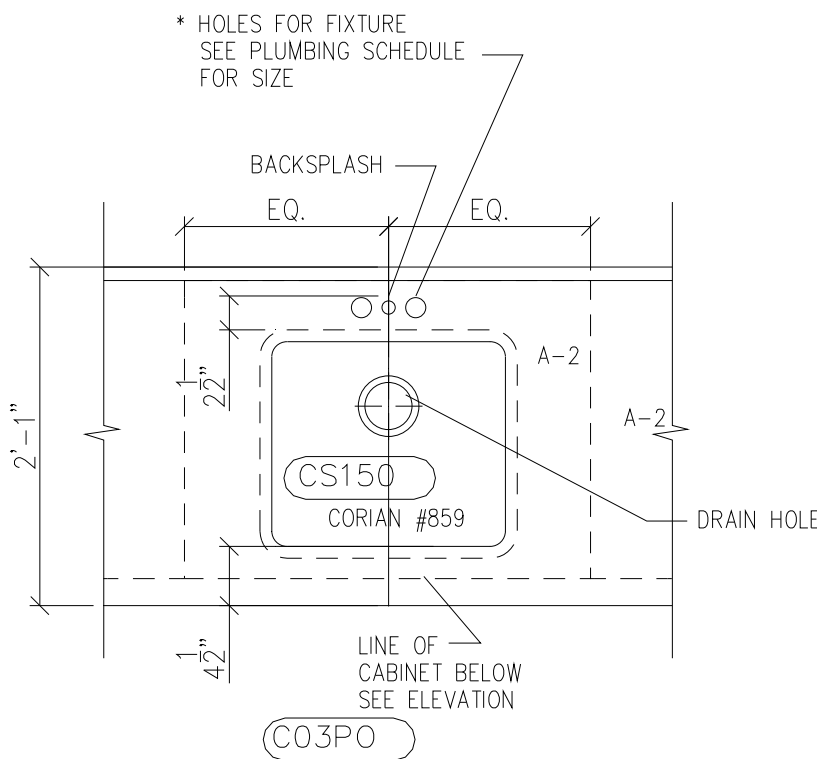



4 A177, A135, A214, A261- TREATMENT ROOM
SCALE 1"=1'-0"

* EMERGENCY COUNTERTOP EYE/FACE WASH
TO BE INSTALLED. SEE SHEET P1.11

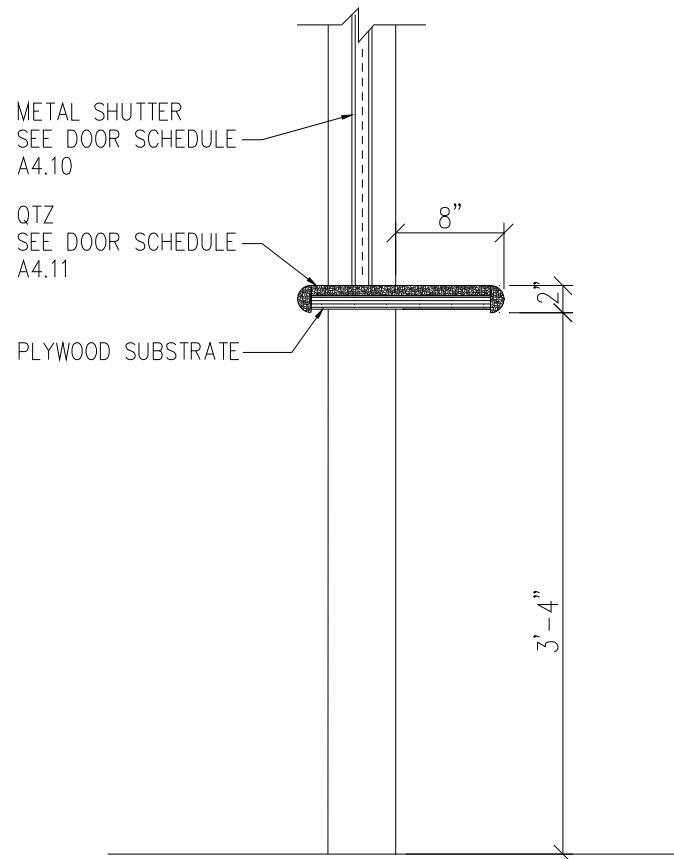

5 RECEPTION @ PHA A 219 & IMMUNIZATION 124
SCALE: 1 1/2" = 1'-0"

KEYPLAN
N.T.S.

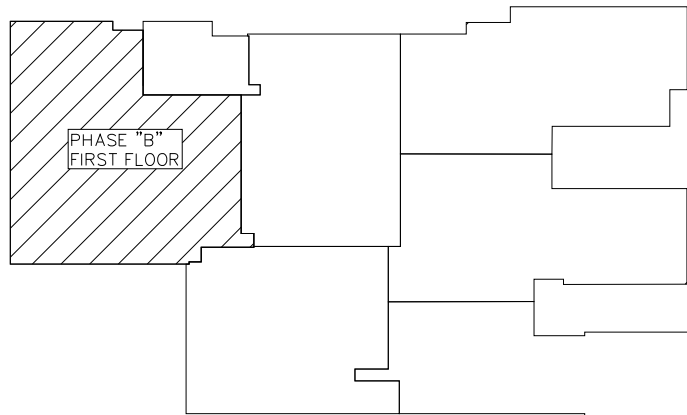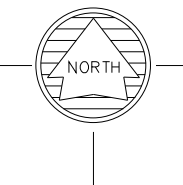

					APP'D
					BY
					Date
					Revision/Issue
					No.

PROJECT TITLE
REPAIR MEDICAL CENTER PH B
LITTLE ROCK AFB, ARKANSAS

SHEET TITLE
ENLARGED COUNTERTOP
PLANS

DRAWN BY RJR	LEAD DESIGNER AM
TECH REVIEWER AM	PROJECT NUMBER NKAK 05-8004A
DESIGNED BY AM	SHEET Q1.10
DATE 1-21-08	
SCALE 1"=1'-0"	19 OF 39