





1 EAST
CUBICLE WORKSTATION F175
** METAL CASEWORK SCALE: 1/4"=1'-0"

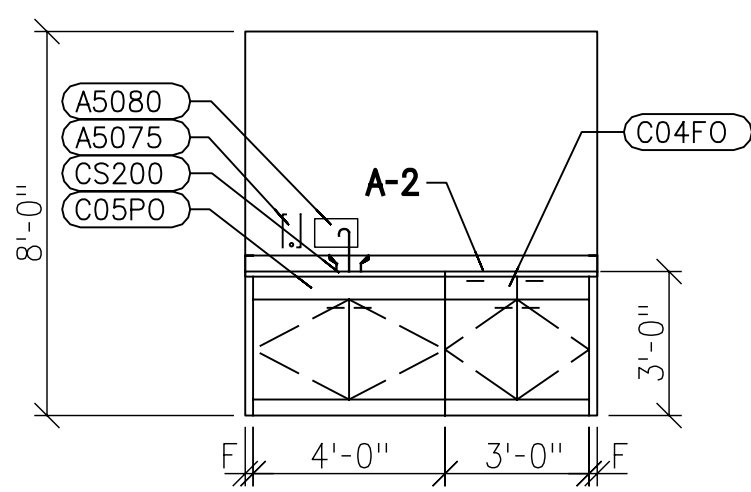


2 EAST
UTILITY ROOM F164
** METAL CASEWORK SCALE: 1/4"=1'-0"

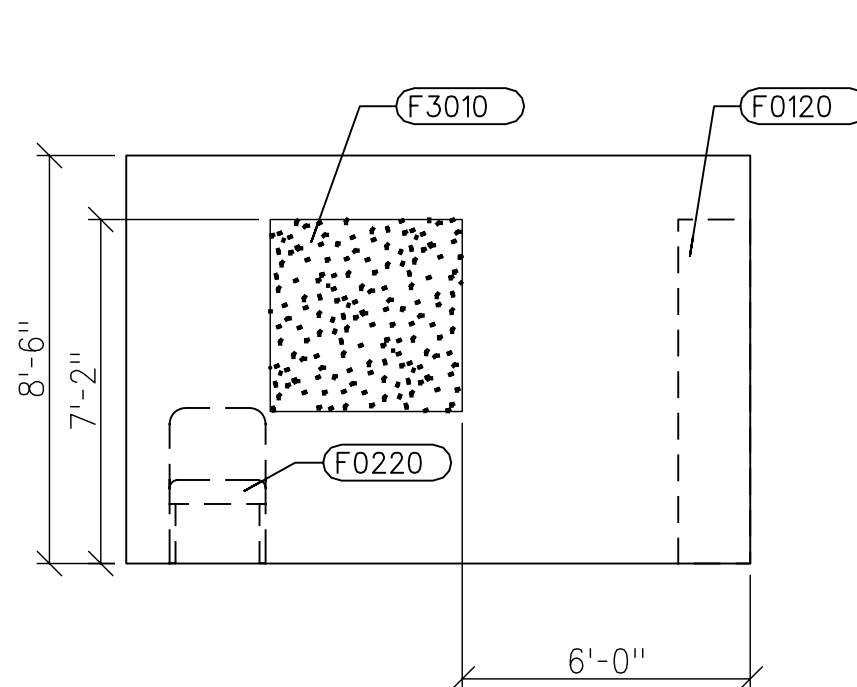


3 EAST
LOW VISION AIDS TRNG F162

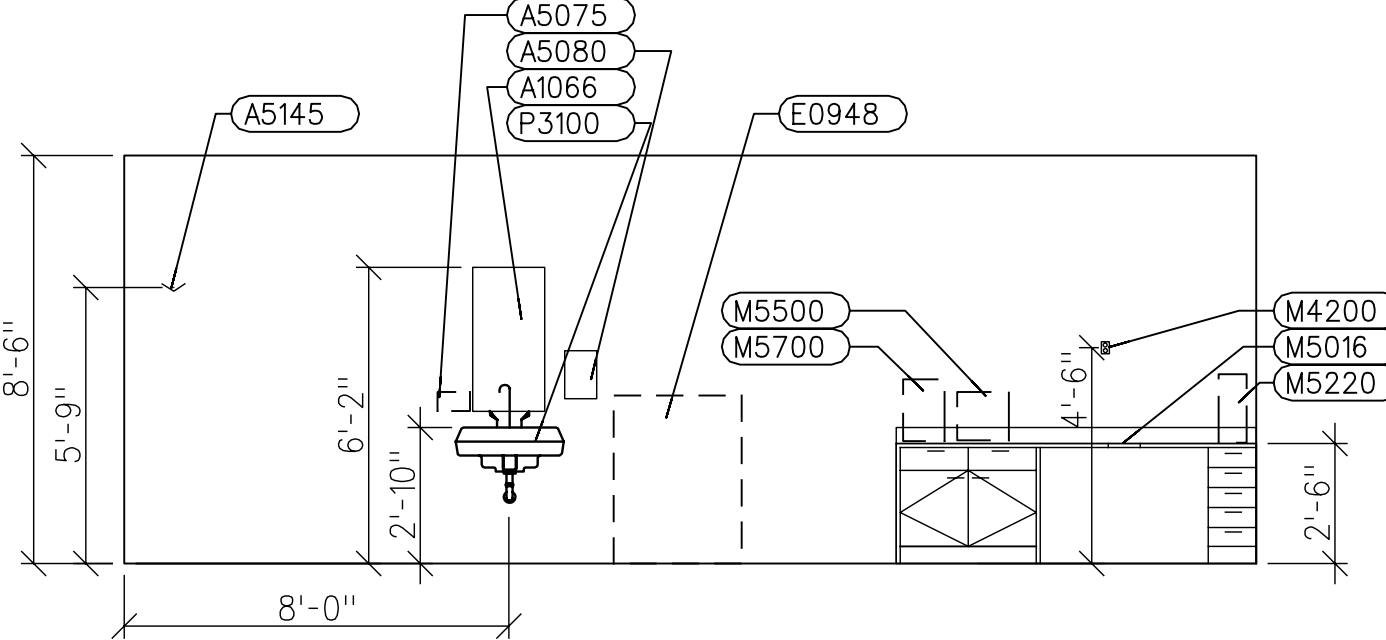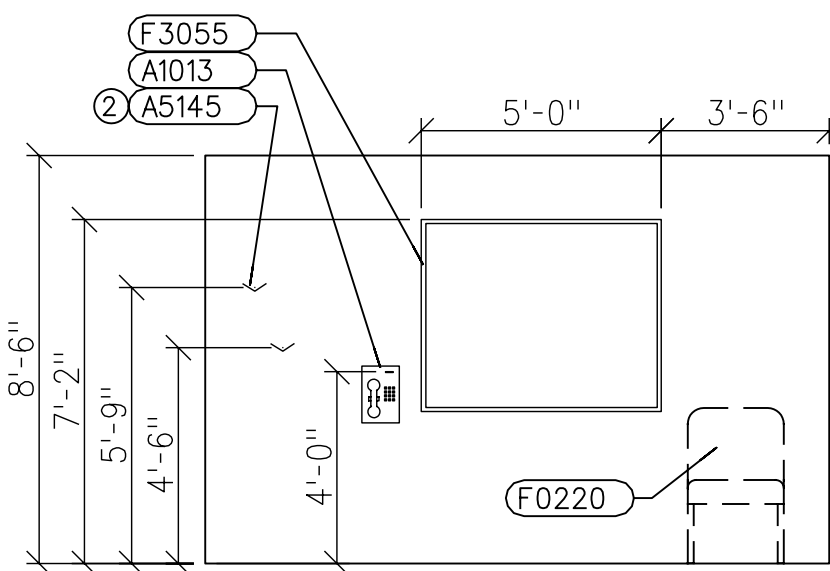



4 EAST
OPTOMETRIST EXAM / OFFICE F177, F179 SIM, F178 AND F180 MIRROR
** FOR REFRACTION DESK M5016 SEE SPEC SECTION 11980. SCALE: 1/4"=1'-0"

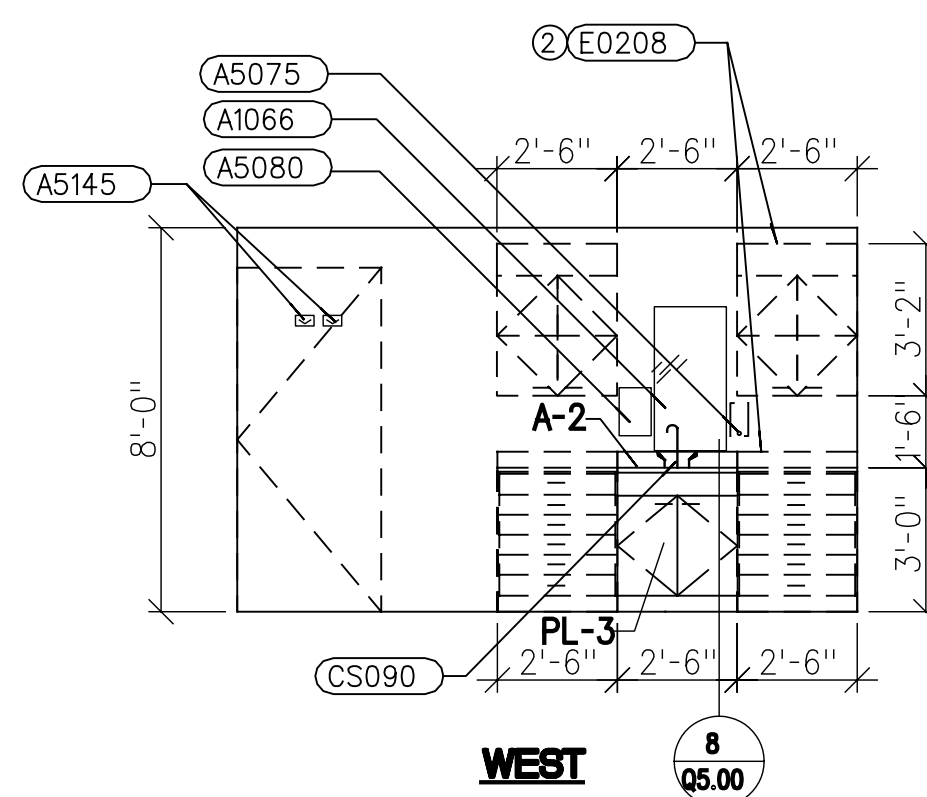


5 WEST
CONTACT LENS SPACE F160
** MILLWORK SCALE: 1/4"=1'-0"

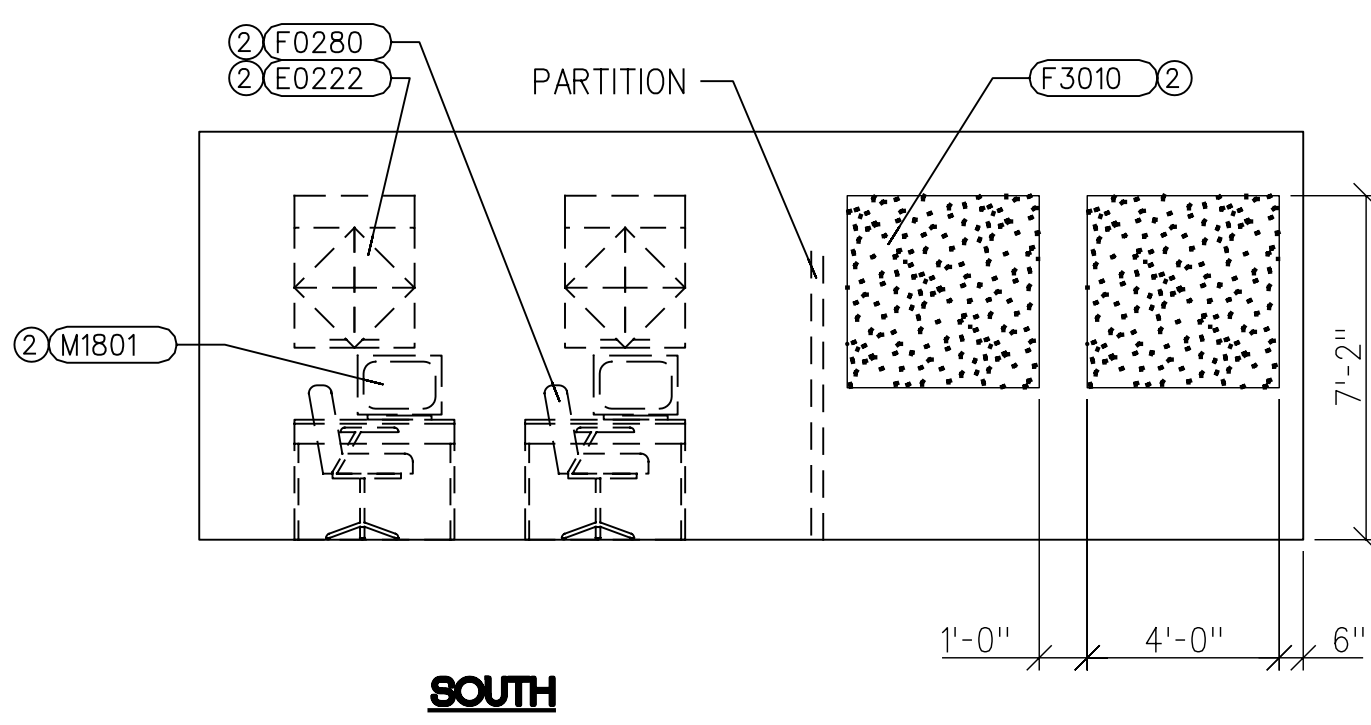


6 SOUTH
MCC WORKROOM F157

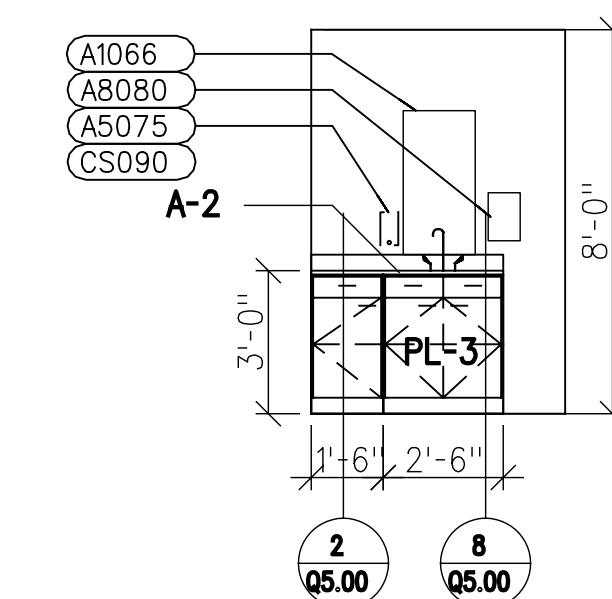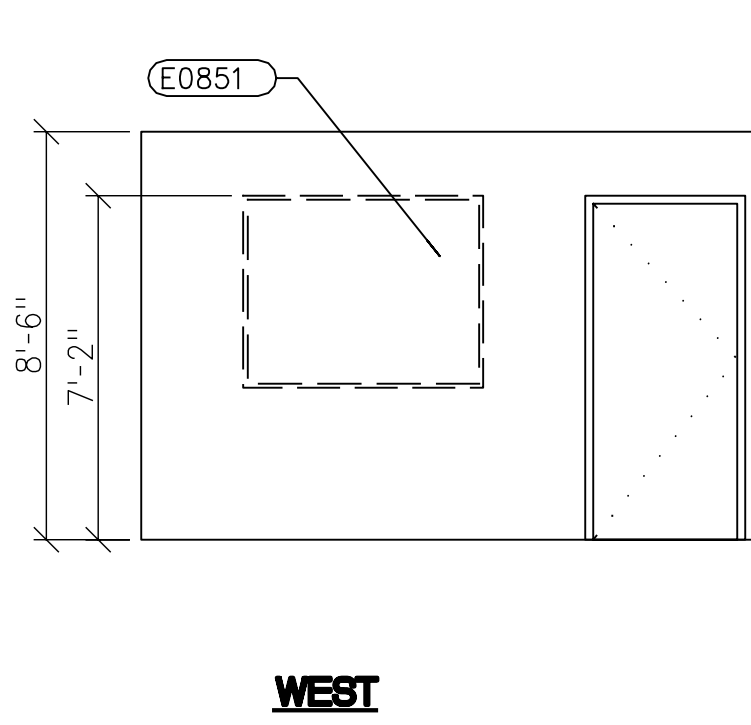


7 SOUTH
SCREEN EYE TEST F184A
** MILLWORK SCALE: 1/4"=1'-0"

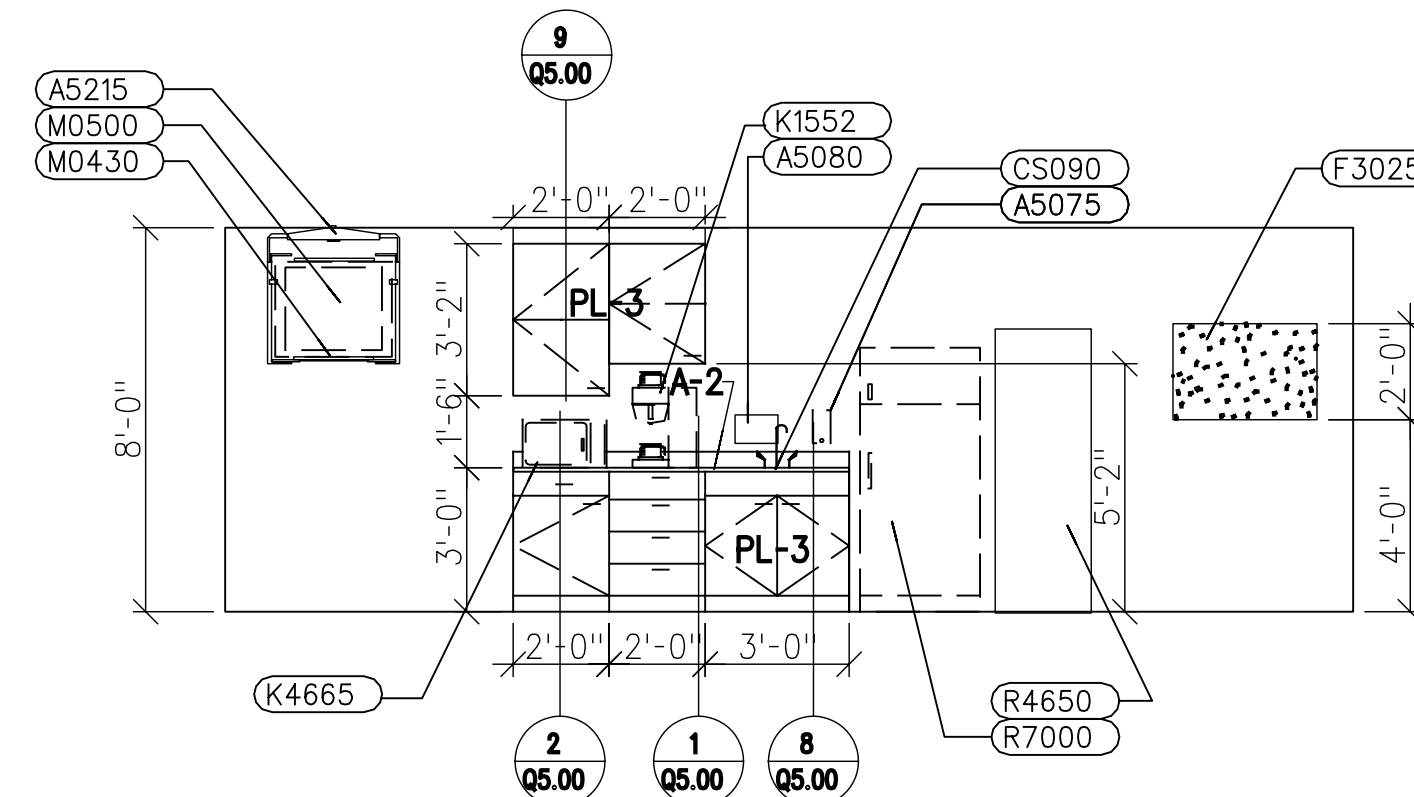


8 WEST
STAFF LOUNGE E169
** MILLWORK SCALE: 1/4"=1'-0"

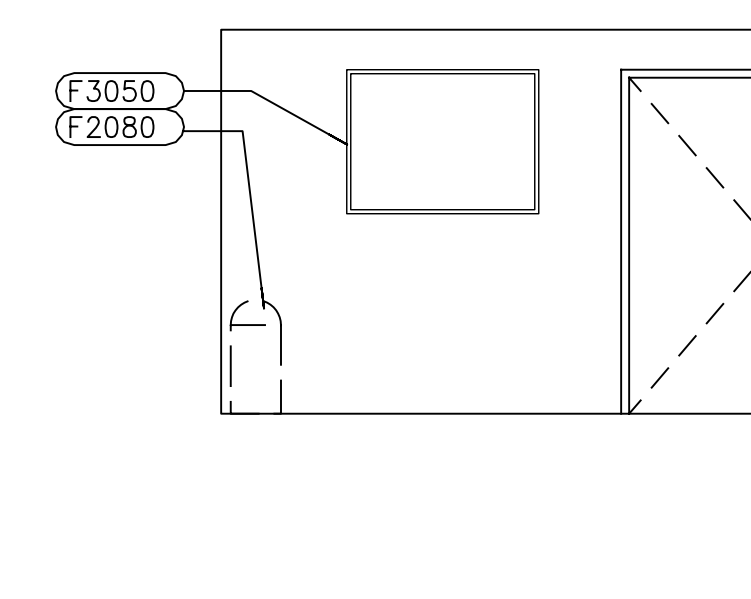


NORTH

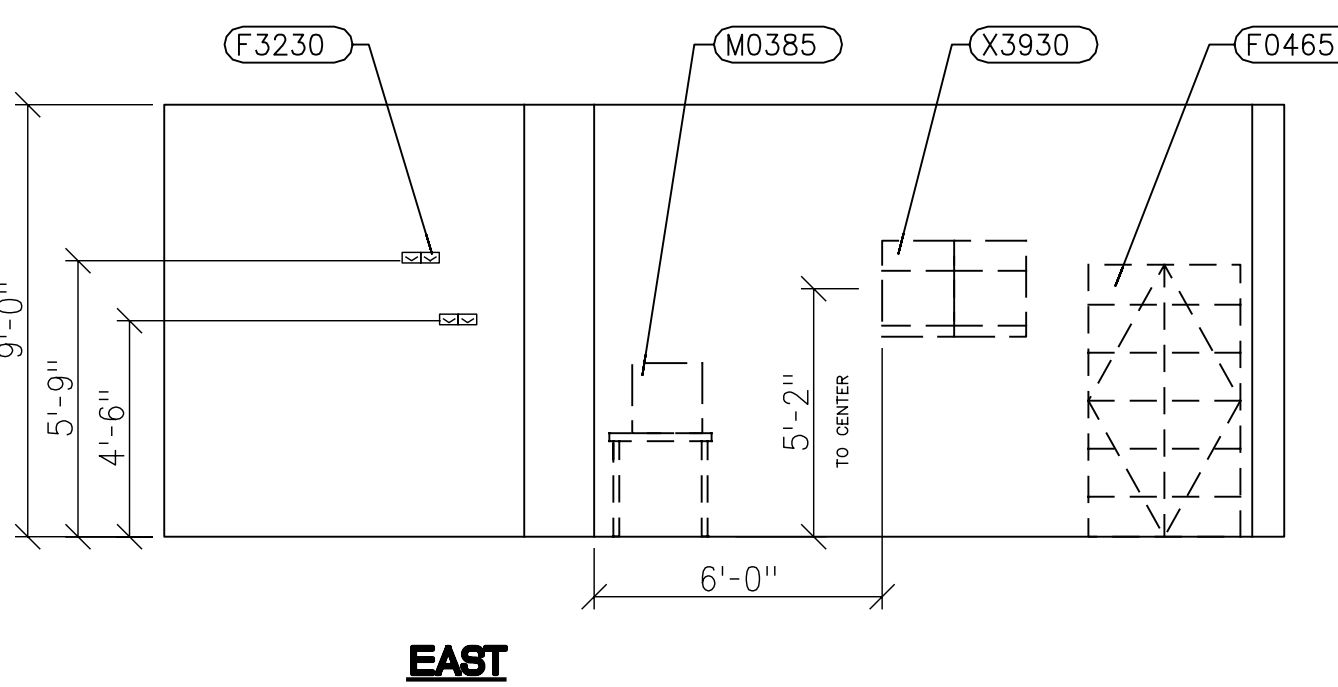


9 EAST
TRAINING / CONFERENCE E170

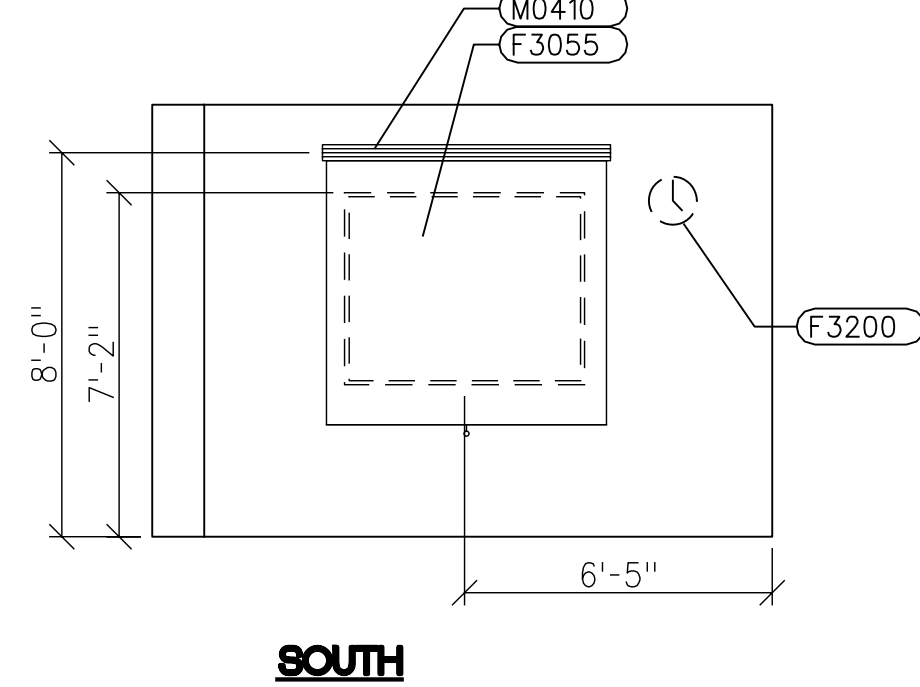


SOUTH

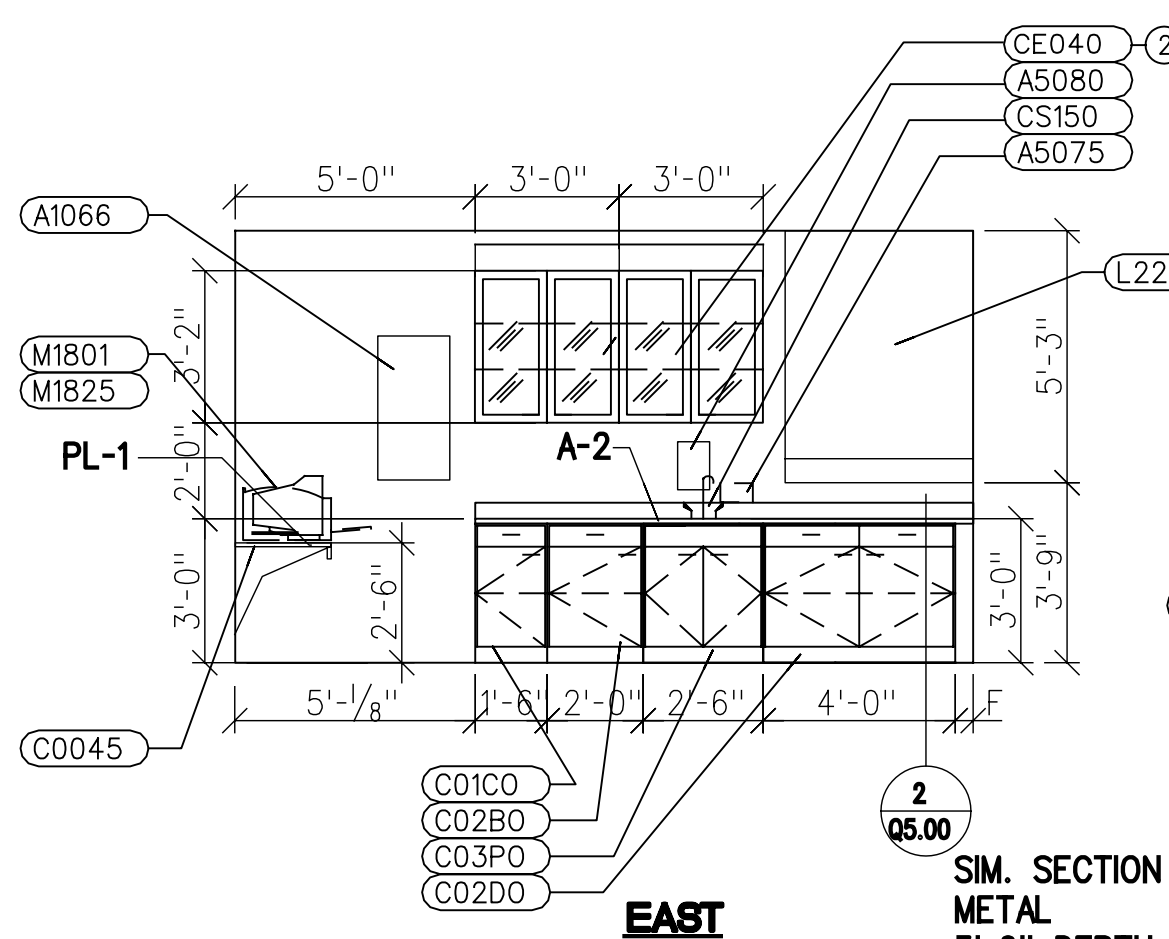


10 EAST
LAB E172
** METAL CASEWORK SCALE: 1/4"=1'-0"

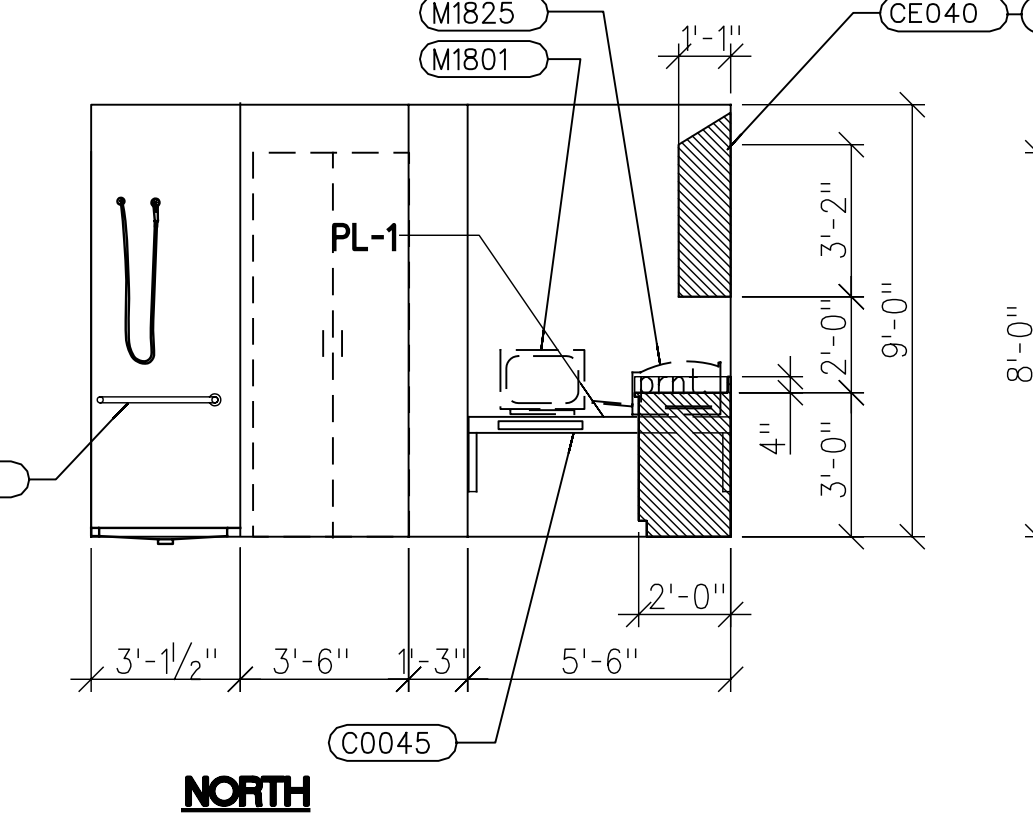


NORTH

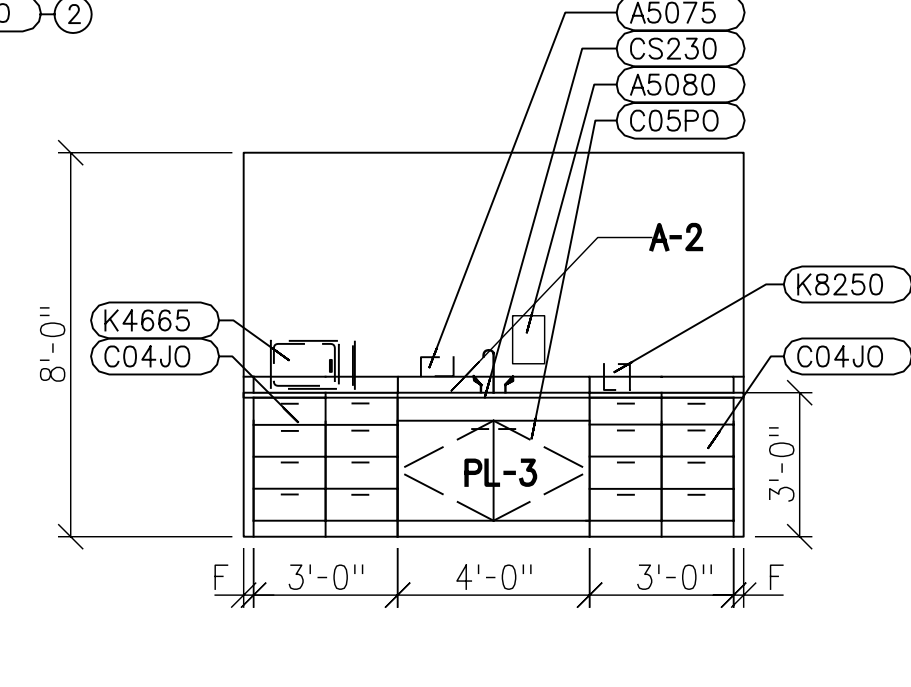


11 WEST
FOOD PROCESS E230
** METAL CASEWORK SCALE: 1/4"=1'-0"

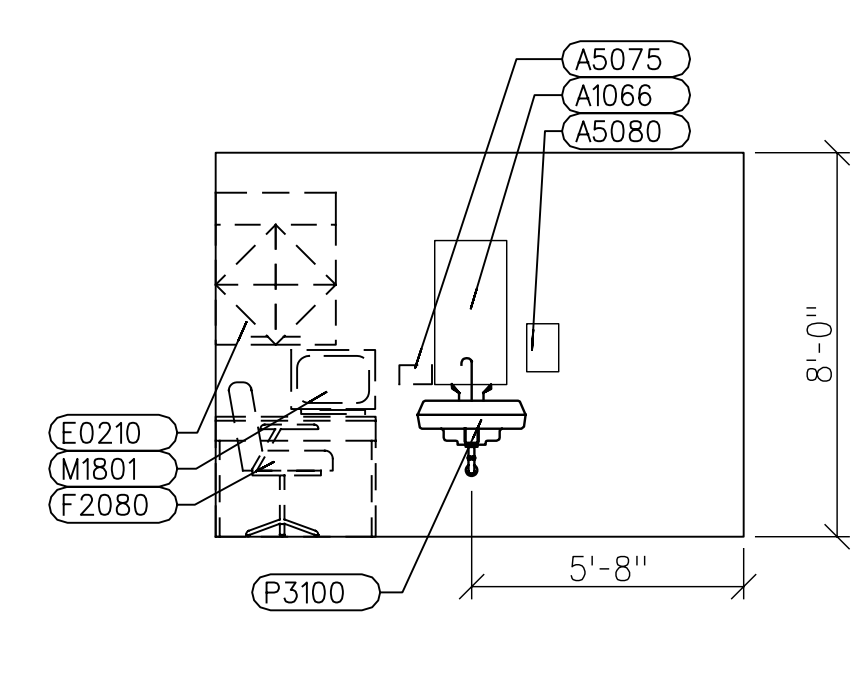


12 NORTH
EXAM ROOM E209 --SIM
SCALE: 1/4"=1'-0"

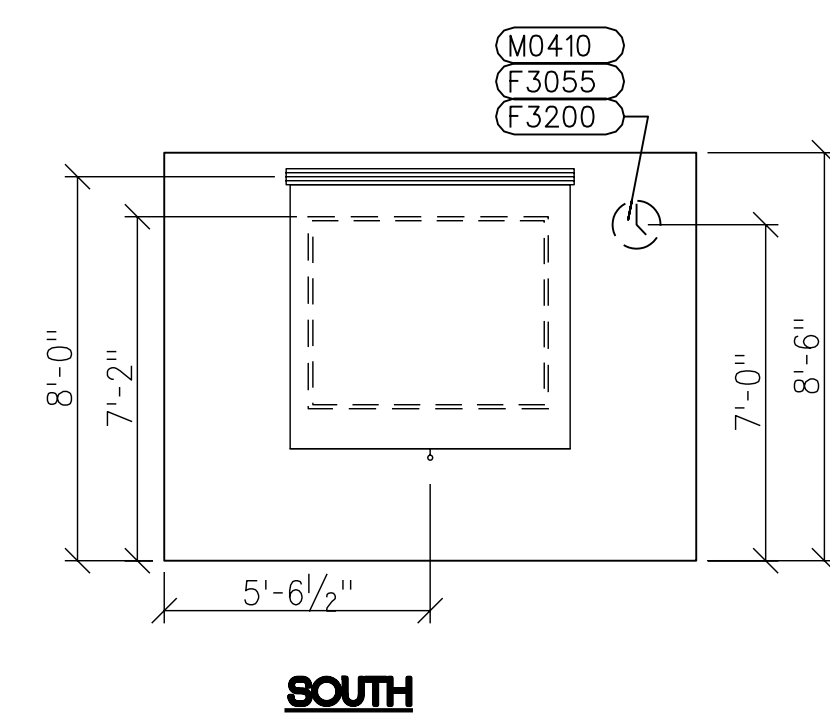


13 SOUTH
CONFERENCE E206
SCALE: 1/4"=1'-0"

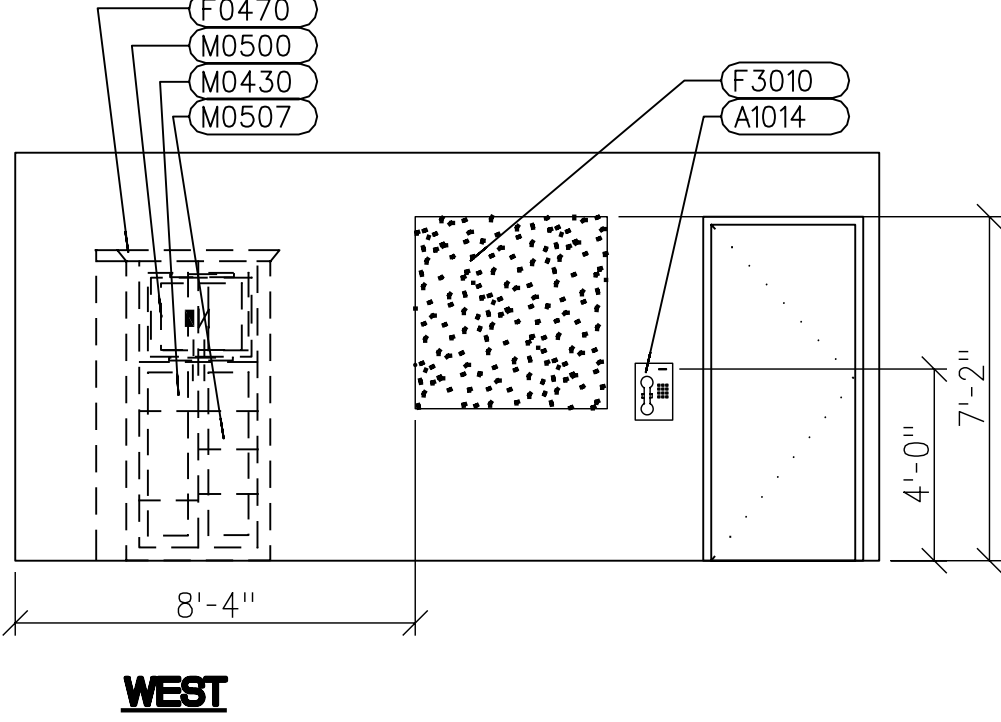


WEST

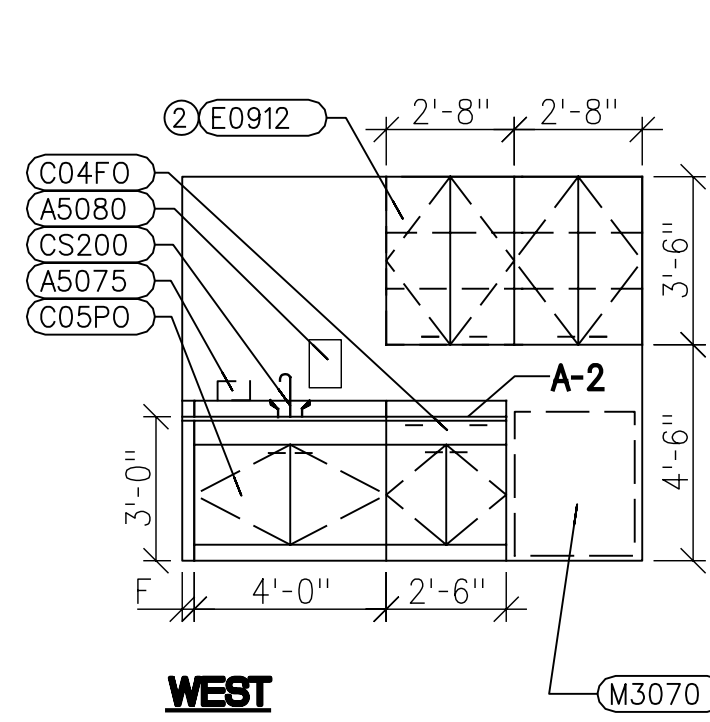


WEST

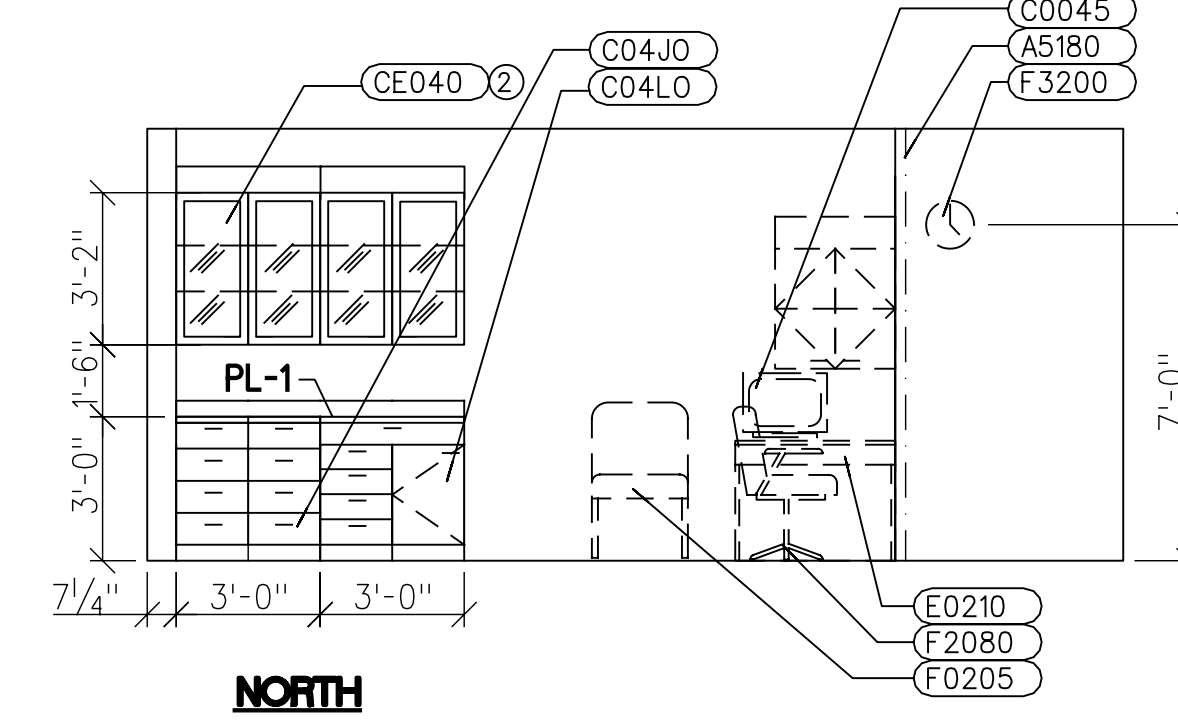

NORTH

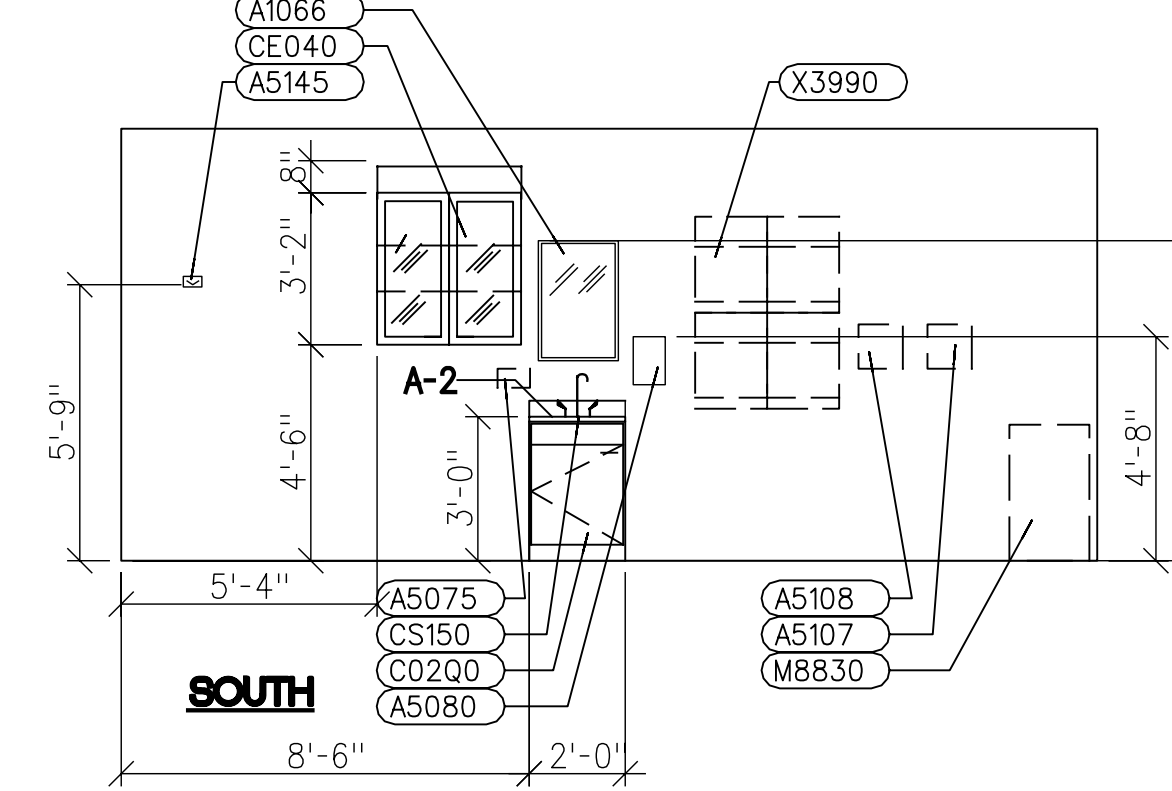

SOUTH

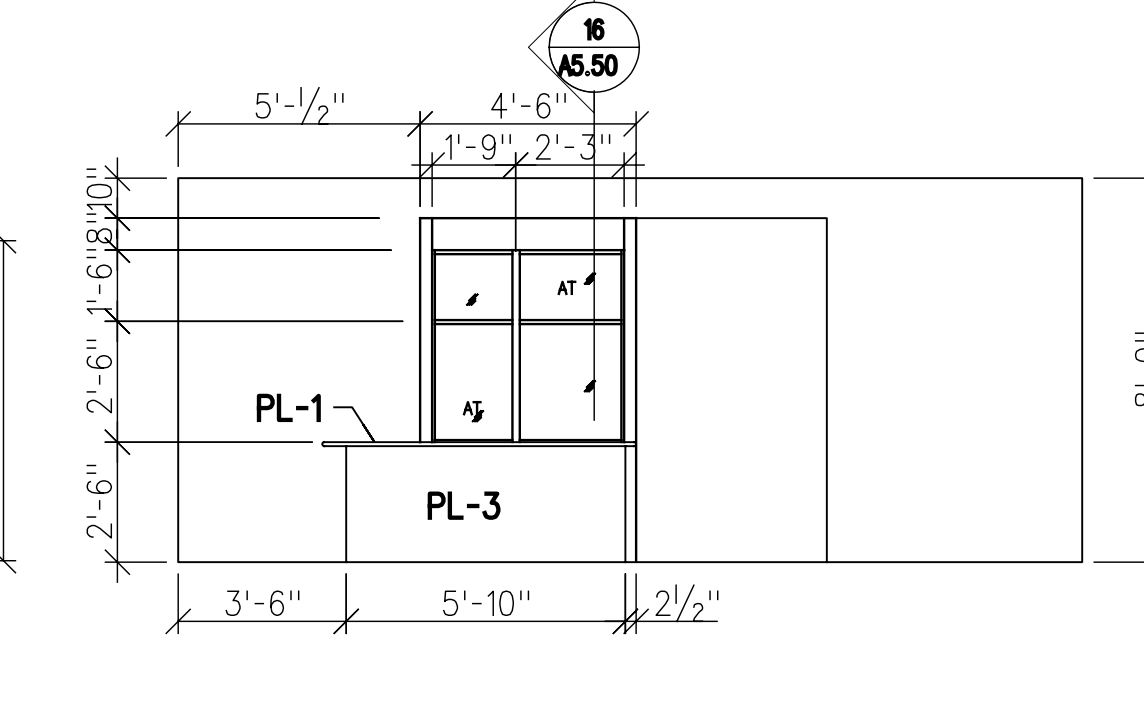

16 NORTH
FITTING AND DISPENSING F184
SCALE: 1/4"=1'-0"