

[illegible]

DESIGNED BY: JFLS		DATE: 10 DECEMBER 2015	
DWN BY: LST	CKD BY: JFLS	SOLICITATION NO.: W9127S-15-R-6005	CONTRACT NO.: W9127S-14-D-6002-0009
SUBMITTED BY: LST Consulting Engineers, PA		FILE NUMBER:	
PLOT SCALING: PLOT DATE: 1/8" = 1'-0"		10 DEC/2015	
SIZE: ARCH. E1		FILE NAME:	



U.S. ARMY CORPS OF ENGINEERS  
LITTLE ROCK DISTRICT

**REPAIR OF BUILDING INFRASTRUCTURE SYSTEMS**  
19th MEDICAL GROUP  
1090 ARNOLD DRIVE  
LITTLE ROCK AIR FORCE BASE, AR 72099-5057

FIRST FLOOR - PHASE 1 - FIBER INFRASTRUCTURE PLAN

SHEET  
IDENTIFICATION  
**E-2.01**




**1 FIRST FLOOR - PHASE 1 - FIBER INFRASTRUCTURE PLAN**  
SCALE: 1/16" = 1'-0"



**EECI**  
ENERGY ENGINEERING  
CONSULTANTS, INC.

10 CORPORATE HILL DR., STE. 100 PH: (501) 244-0511  
LITTLE ROCK, AR 72205 FX: (501) 244-0241

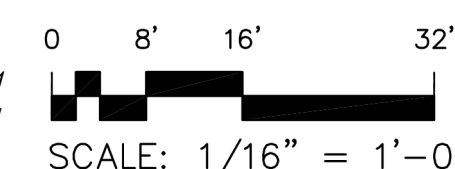

RECORD DRAWING AS-BUILT