 




LOCATION MAP		SHEET INDEX	
		E-0 COVER SHEET E-1 GENERAL NOTES, ABBREVIATIONS & SYMBOL LEGEND E1-0 1ST FLOOR ELECTRICAL REFERENCE PLAN E1-1 MAIN ELECTRICAL/MECHANICAL ROOMS PLAN E1-2 ENLARGED 1ST FLOOR ELECTRICAL ROOM PLANS E2-0 2ND FLOOR ELECTRICAL REFERENCE PLAN & ENLARGED ELEC. RM PLANS E3-0 ROOF ELECTRICAL PLAN E4-1 PARTIAL ELECTRICAL RISER DIAGRAM E4-2 PARTIAL ELECTRICAL RISER DIAGRAM E5-1 PANELBOARD SCHEDULES E5-2 PANELBOARD SCHEDULES E5-3 PANELBOARD SCHEDULES E5-4 PANELBOARD SCHEDULES E5-5 PANELBOARD SCHEDULES E5-6 PANELBOARD SCHEDULES E6-1 ELECTRICAL GROUNDING DETAILS E6-2 MAIN SWITCHGEAR & MCC ELEVATIONS	
CODE INFORMATION			
1. APPLICABLE CODES AND STANDARDS <ul style="list-style-type: none"> ◦ ACCESSIBILITY-----AMERICANS WITH DISABILITIES ACT OF 1990 ◦ BUILDING-----INTERNATIONAL BUILDING CODE 2003 ◦ ELECTRICAL-----NEC 2005, NFPA 70 ◦ MECHANICAL-----MILITARY HANDBOOK-SPEC 1191 ◦ ZONING-----NOT APPLICABLE 			

AS-BUILTS 10/4/10

<small>NOTICE: THIS IS THE PERSONAL PROPERTY OF JAMES H. RUSSELL ENGINEERING CO. AND ALL USE IS FORBIDDEN EXCEPT UPON WRITTEN CONSENT.</small>					
CAD Filename:	K:\Air Force Boses\Little Rock\I1599				
ORIGINAL P-No.	10796	DATE REVISED			
ADDITIONS AND REVISIONS					
65% DESIGN REVIEW		12/23/09			
ISSUED FOR 100% SUBMITTAL		4/9/10			
AS-BUILT		10/4/10			
DRAWN BY	JRP	JOB No.			Sheet No.
CHECKED BY	RPK				
APPROVED BY	WAW				
SCALE	NOT TO SCALE				
DATE	NOV 2009				