


PAGE BREAK

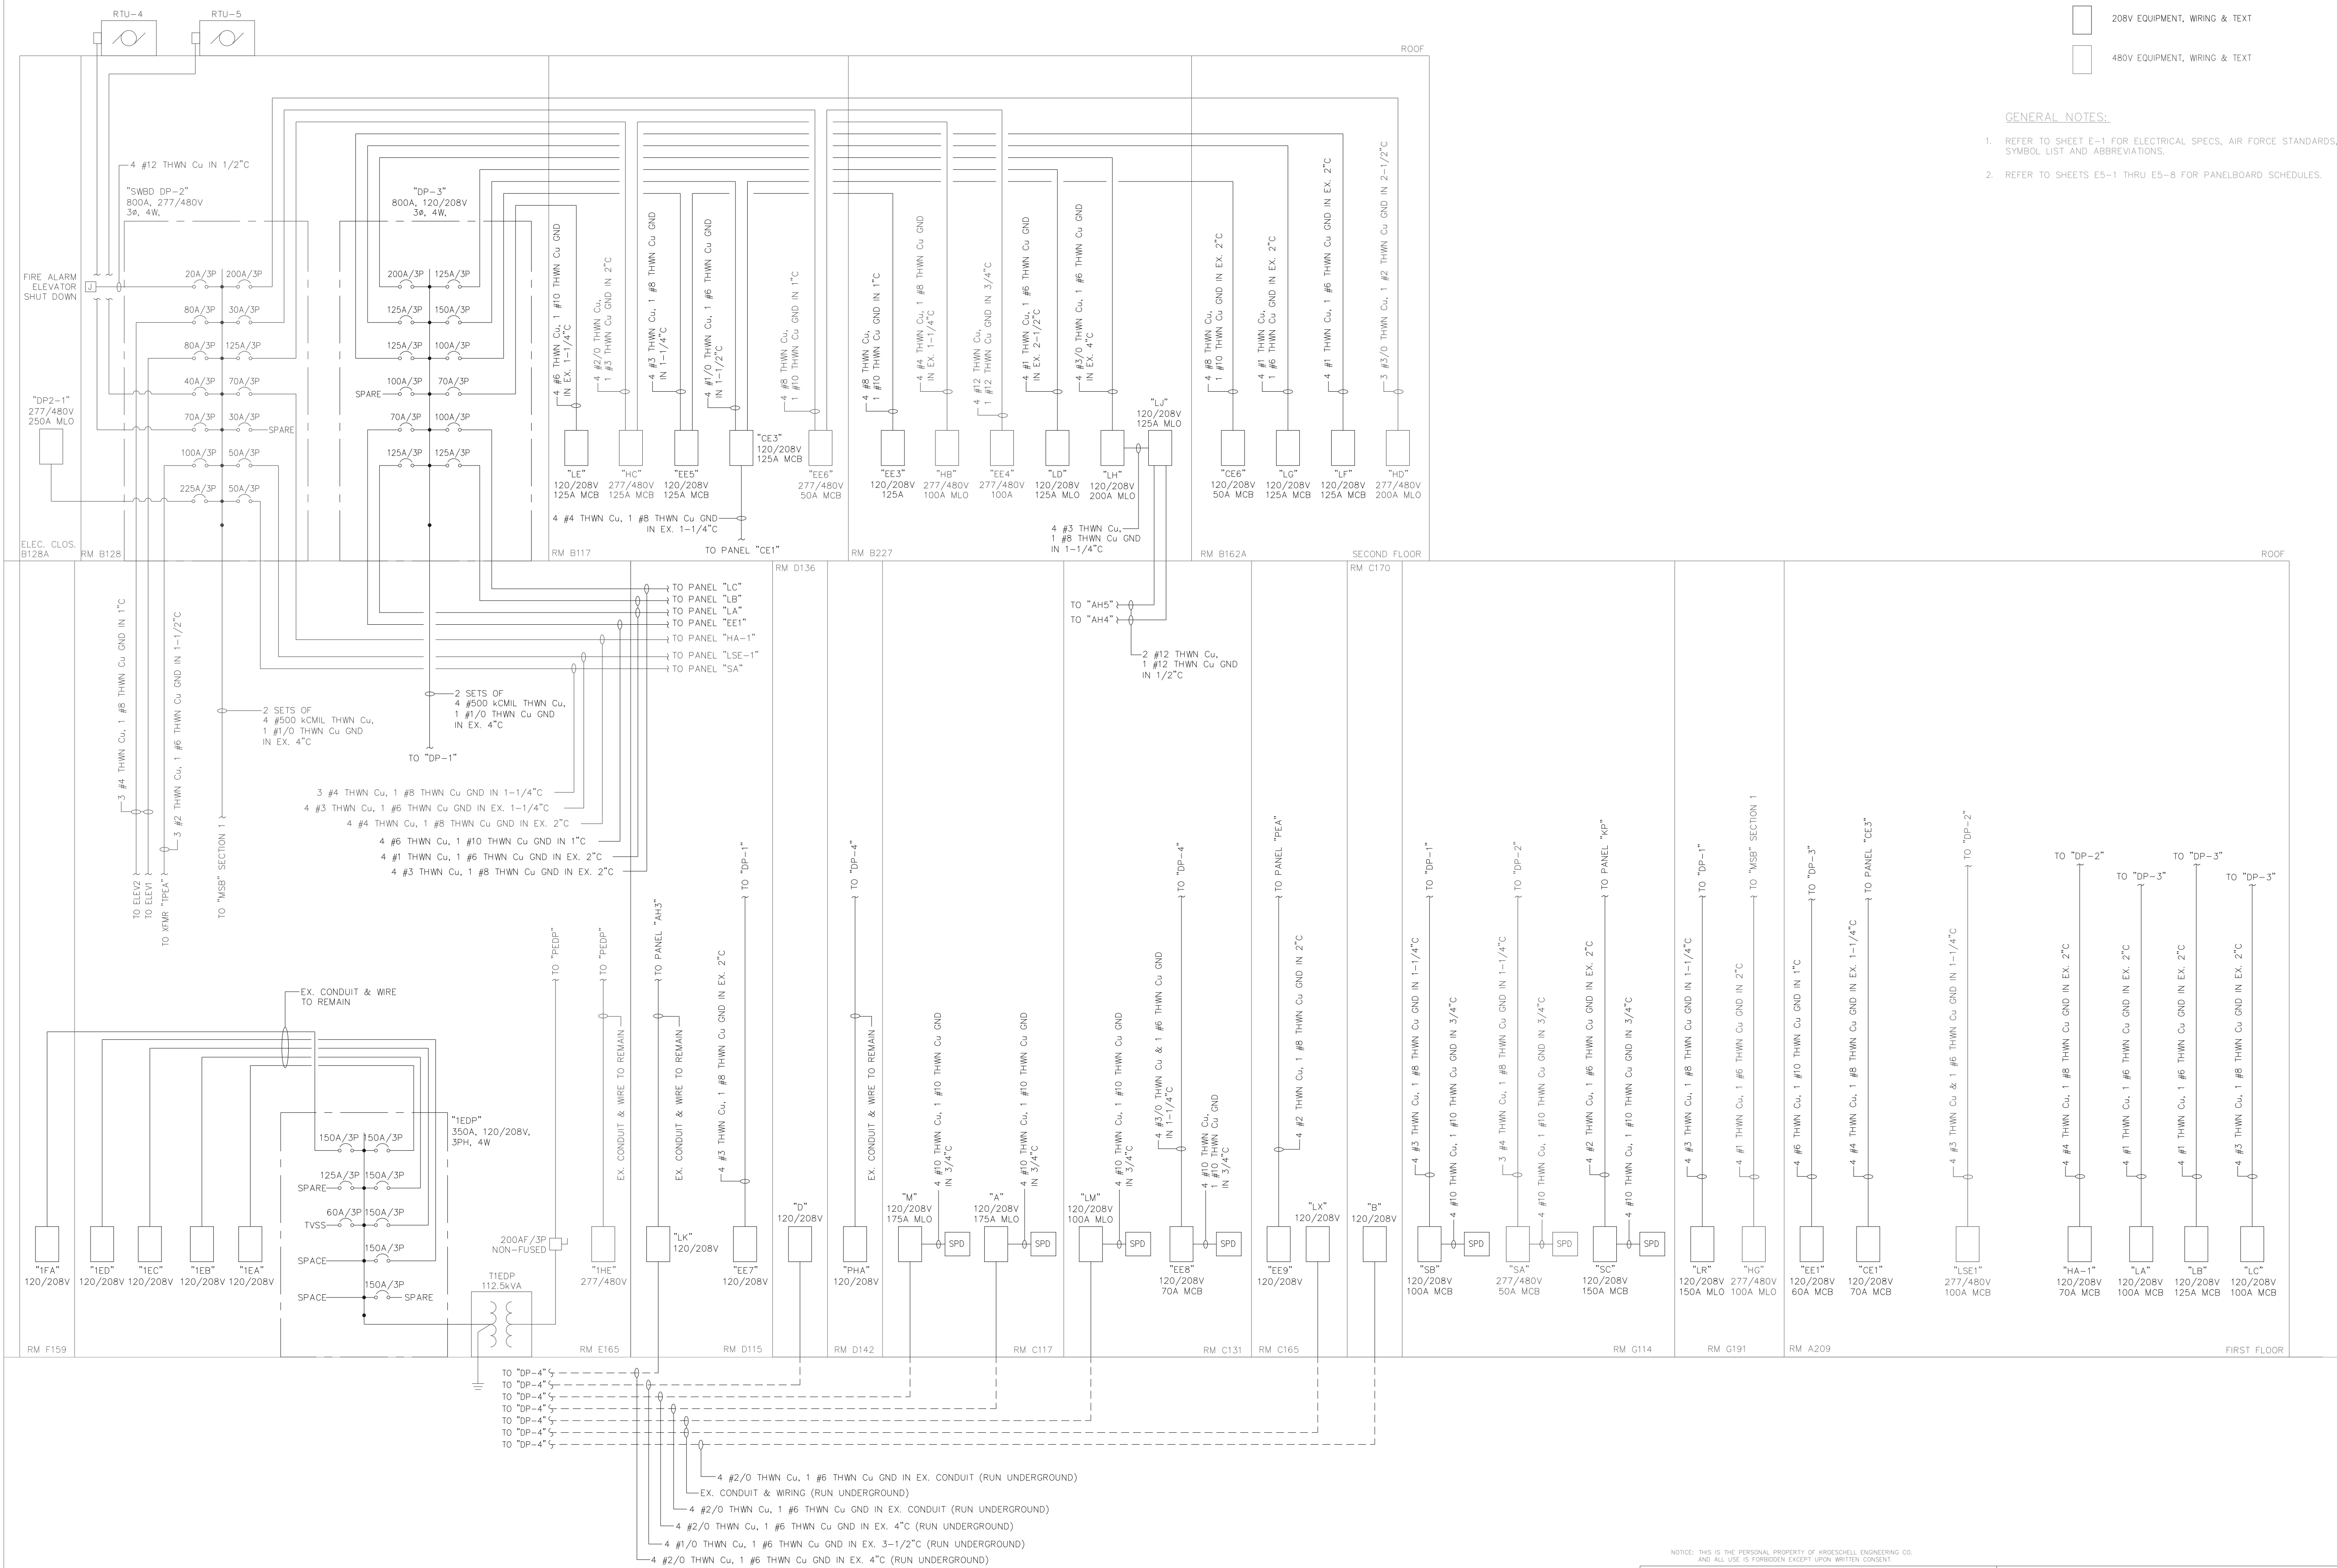

AS-BUILTS 10/4/10