

LITTLE ROCK A.F.B.
ARKANSAS

FPM

804 West Curtis Drive, Suite H
Midwest City, OK 73110
phone: 405.869.9212
fax: 405.869.9222
www.fpm-group.com

RECORD
DRAWINGS
MARCH 2007





DEMOLITION LEGEND

- EXISTING WALLS/PARTITIONS TO REMAIN
- EXISTING WALLS/PARTITIONS BEING REMOVED
- EXISTING COMM OUTLET TO BE REMOVED
- EXISTING NURSE CALL DEVICE TO BE REMOVED
- EXISTING OUTLET BOX TO BE REMOVED
- EXISTING PA SPEAKER TO BE REMOVED
- EXISTING SMOKE DETECTOR TO BE REMOVED (SEE NOTES 3 & 6)
- FIRE ALARM REMOTE ANNUNCIATOR TO BE RELOCATED
- FIRE ALARM J-BX TO REMAIN
- FIRE ALARM PULL BOX TO BE LOWERED TO 48" AFF.
- AUDIO VISUAL DEVICE TO BE REMOVED
- MAGNETIC DOOR HOLDER TO REMAIN
- ADDRESSABLE INTERFACE MODULE TO REMAIN.
- WATER FLOW SWITCH TO REMAIN.
- TAMPER SWITCH TO REMAIN.
- TV OUTLET TO BE REMOVED.

DRAWING NOTES:

1. REMOVE ALL EXISTING NURSE CALL DEVICES AND ASSOCIATED WIRING WITHIN THE PHASE "B" AREA.
2. REMOVE ALL EXISTING PA SPEAKERS, VOLUME CONTROLS AND ASSOCIATED WIRING WITHIN THE PHASE "B" AREA. RETAIN SPEAKERS AND VOLUME CONTROLS FOR REUSE.
3. REMOVE ALL EXISTING CEILING MOUNTED SMOKE DETECTORS AND ASSOCIATED WIRING TO THE FIRST J-BOX. RETAIN HOME RUN WIRING TO FACP FOR REUSE.
4. REMOVE ALL EXISTING LAN WIRING FROM OUTLET BOXES TO PATCH PANEL IN EXISTING COMM. ROOM AND TELCO ROOM (A208)
5. REMOVE/ABANDON ALL EXISTING COMM OUTLETS AND J-BOXES AS FOLLOWS:
 - A. IF OUTLET BOX IS ATTACHED TO CONCEALED CONDUIT, REMOVE COMM JACKS AND ALL WIRING AND INSTALL NEW BLANK COVER PLATE (ABANDON IN PLACE).
 - B. IF OUTLET BOX IS NOT ATTACHED TO CONCEALED CONDUIT, REMOVE BOX AND ALL WIRING AND PATCH WALL.
6. REMOVE SMOKE DETECTORS AND FIRE GATE OPERATOR LOCATED AT SLIDING WINDOWS ONLY (2 LOCATIONS, 4 DETECTORS)
7. REMOVE ALL CABLE TV OUTLETS AND ASSOCIATED WIRING BACK TO FIRST SPLITTER.
8. ANY FIRE ALARM OR PUBLIC ADDRESS DEVICES THAT ARE REMOVED, WHICH ARE NOT BEING REUSED, SHOULD BE DELIVERED TO THE LRAFB ALARM SHOP.

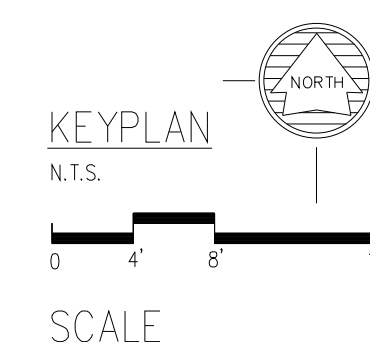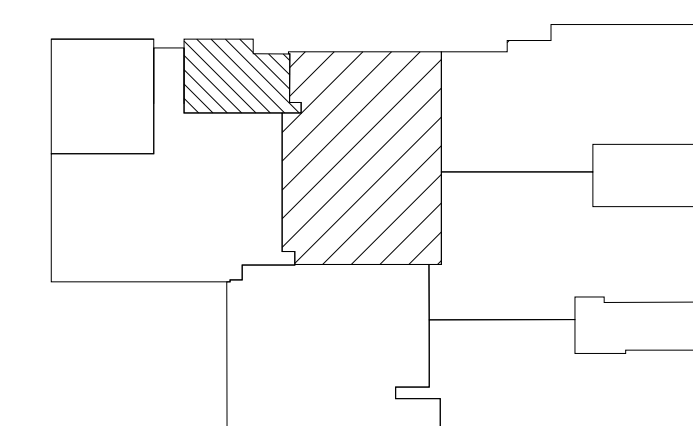

1 SYSTEMS DEMOLITION PLAN

SCALE: 1/8" = 1'-0"

No.	Revision/Issue	Date	BY	APP'D

PROJECT TITLE REPAIR MEDICAL CENTER PH B LITTLE ROCK AFB, ARKANSAS		SHEET TITLE SYSTEMS DEMOLITION PLAN	
DRAWN BY RJR	LEAD DESIGNER KF	PROJECT NUMBER NKAK 05-8004A	E0.31 33 OF 39
TECH REVIEWER KF	DESIGNED BY KF	SHEET	
DATE 1-21-08	SCALE 1/8"=1'-0"		