

| |
|---|
| |</ |
|---|

|                                   |                           |
|-----------------------------------|---------------------------|
| DESIGNED BY: DATE: 08/04/2003     | PROJECT NO. 6503          |
| DRAWN BY:                         | CHECKED BY: DRAWING CODE: |
| REVIEWED BY: SOLICITATION NUMBER: |                           |

U.S. ARMY ENGINEERING AND SUPPORT CENTER  
CORPS OF ENGINEERS  
HUNTSVILLE, ALABAMA

EARTH T E C H  
2001 Huntsville, AL 35894-0001

FLM  
FLM Design

RENOVATE CLINIC  
BUILDING 1090  
LITTLE ROCK AFB, ARKANSAS

**LEVEL ONE ZONE A  
LIGHTING DEMOLITION PLAN  
AS-BUILT**

SHEET  
REFERENCE  
NUMBER:  
**E0.11**  
SHEET X OF XX



**1 ZONE A PLAN**

SCALE 1/8" = 1'-0"

### GENERAL ELECTRICAL DEMOLITION NOTES


- REFER TO ELECTRICAL DEMOLITION DRAWINGS E0.11, E0.12, E0.21, E0.22, E0.31, E0.32.
- INFORMATION REGARDING THE EXISTING ELECTRICAL SYSTEM HAS BEEN TAKEN FROM DRAWING FURNISHED BY THE GOVERNMENT. OBTAIN COPIES OF THESE DRAWINGS TO USE AS ADDITIONAL GUIDANCE AND CLARIFICATION FOR DEMOLITION DURING THE PROJECT.
- WHERE EXISTING CONDITIONS ARE INDICATED, THE INFORMATION HAS BEEN DERIVED FROM AVAILABLE DRAWINGS AND REPRESENT THE ENGINEER'S BEST ESTIMATE OF ACTUAL CONDITIONS. ALL CASES HAVE NOT BEEN VERIFIED BY FIELD INVESTIGATIONS.
- COORDINATE THE EXTENT OF DEMOLITION WORK WITH OTHER TRADES: REFER TO ARCHITECTURAL, MECHANICAL AND PLUMBING DRAWINGS.
- PRIOR TO REMOVAL OF ANY EXISTING ELECTRICAL EQUIPMENT FIRST TRACE THE SOURCE AND ALL AFFECTED DOWNSTREAM SYSTEMS OR EQUIPMENT. UTILITY DISRUPTIONS TO OCCUPIED AREAS SHALL NOT OCCUR WITHOUT PRIOR APPROVAL OF THE CONTRACTING OFFICER.
- BEFORE BEGINNING WORK AND THROUGHOUT THE COURSE OF THE WORK, INSPECT AND VERIFY THE LOCATION AND CONDITION OF EVERY ITEM AFFECTED BY THE WORK UNDER THIS CONTRACT AND REPORT DISCREPANCIES TO THE CONTRACTING OFFICER BEFORE DOING WORK RELATED TO THAT BEING INSPECTED.
- DO NOT DRILL OR CUT EXISTING FLOOR JOISTS, BEAMS, COLUMNS, OR OTHER STRUCTURAL ELEMENTS, UNLESS SPECIFICALLY INDICATED. DRILL SLABS WHERE APPROVED. CORE DRILL CIRCULAR OPENINGS THROUGH SLABS. LINE DRILL FOR RECTANGULAR OPENINGS. MAKE OPENINGS OF PROPER SIZE FOR CONDUIT AND OTHER ITEMS PASSING THROUGH OPENINGS.
- PREPARE, SUBMIT AND RECEIVE APPROVAL OF SLEEVE AND OPENING DRAWINGS, BEFORE LOCATING SLEEVES AND OPENINGS AND BEFORE DRILLING EXISTING STRUCTURE. SHOW EACH OPENING AND SLEEVE FOR EACH AREA REQUIRING PENETRATIONS.
- SEAL ABANDONED FLOOR PENETRATIONS FLUSH TO STRUCTURAL SLAB WITH CONCRETE TO MATCH EXISTING CONSTRUCTION AND MAINTAIN A 2-HOUR FIRE RESISTANCE RATING.
- ALL ELECTRICAL SYSTEMS SERVING OCCUPIED AREAS OF THE EXISTING FACILITY SHALL REMAIN FULLY OPERATIONAL. PROTECT AND MAINTAIN THESE SYSTEMS PASSING THROUGH AND ADJACENT TO THE AREAS REQUIRING DEMOLITION WORK. WORK THAT REQUIRES DISRUPTION OF THE GOVERNMENT'S OPERATIONS SHALL BE PERFORMED DURING HOURS, INCLUDING EVENINGS AND WEEKENDS, WHICH MINIMIZE INTERRUPTION TO THE OCCUPANTS OF THE BUILDING. THE TIME SCHEDULE AND DURATION OF THIS WORK MUST CAREFULLY BE COORDINATED WITH THE GOVERNMENT AT LEAST TWO WEEKS IN ADVANCE. WHERE NECESSARY, REROUTE EXISTING UTILITIES TO SERVE OCCUPIED AREAS OR TO COORDINATE WITH NEW WORK.
- EXTREME CARE MUST BE MAINTAINED DURING DEMOLITION TO ASSURE PROTECTION OF ALL EXISTING COMMUNICATIONS CABLE AND FIBER OPTIC LINES, INCLUDING THOSE FOR TELEPHONE, NURSE CALL, "T1", FIRE ALARM, HVAC CONTROLS, AND CABLE TELEVISION SYSTEMS, ESPECIALLY THOSE WHICH ARE NOT IN CONDUIT. THE GOVERNMENT WILL IDENTIFY WHICH EXISTING CABLE IS TO BE ABANDONED; DEMOLISH ALL CABLE IDENTIFIED AS ABANDONED.

### DEMOLITION LEGEND

- EXISTING WORK TO REMAIN  
EXISTING WORK TO BE REMOVED
- EXISTING WORK TO REMAIN IS SHOWN AS SCREENED LINE WORK AND TEXT.  
EXISTING WORK TO BE DEMOLISHED IS SHOWN AS BOLD LINE WORK AND TEXT.

### KEY NOTES

- REMOVE ALL EXISTING ELECTRICAL EQUIPMENT IN THIS AREA UNLESS OTHERWISE NOTED TO REMAIN, INCLUDING LIGHTING FIXTURES, SWITCHES, SURFACE AND FLUSH DEVICES, BOXES, DEVICE PLATES, ETC. REMOVE WIRE BACK TO ACTIVE SOURCE. CUT OFF ABANDONED CONDUIT BELOW FLOOR, CAP AND PATCH.
- EXISTING LIGHTING AND SWITCHES THIS AREA TO REMAIN. REFLECT FROM NEW POWER SOURCE IF INTERRUPTED.

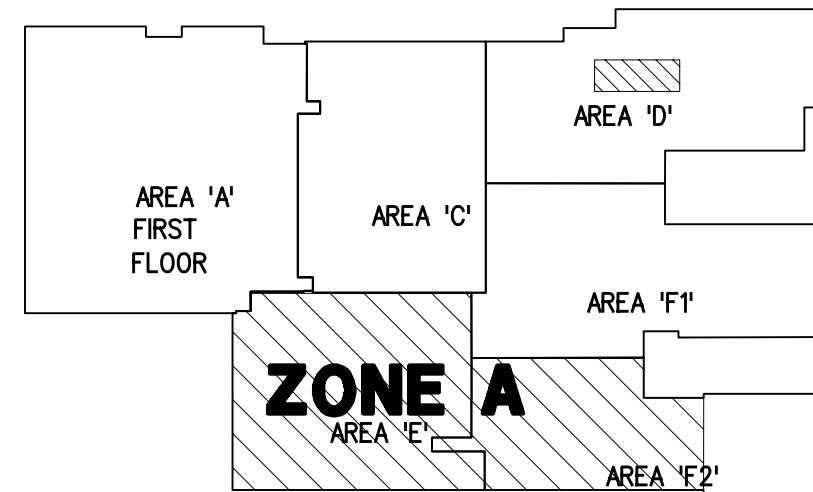

### KEY PLAN

N.T.S.

SCALE