
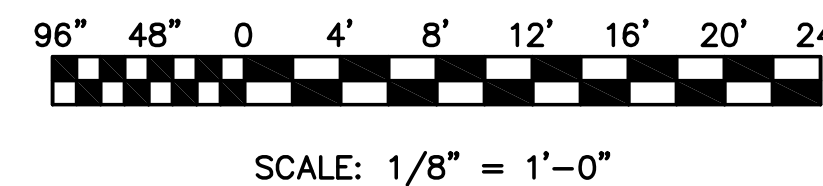





- LEGEND
-  REMOVE POWER
RECEPTACLES, AS
INDICATED.

MATCH LINE



SCALE: 1/8" = 1'-0"

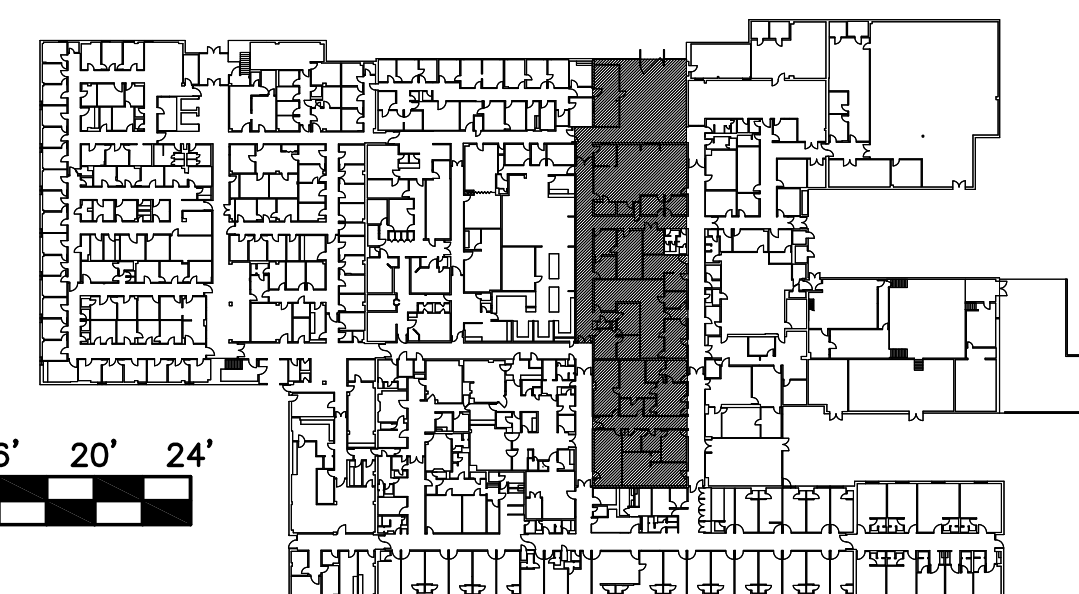

SHEET TITLE

ELECTRICAL POWER
DEMOLITION PLAN

E-101