

[illegible]

DESIGNED BY:	JFLS	DATE:	10 DEC 2015
DWN BY:	LST JFLS	SOLICITATION NO.:	W91278-15-R-0005
SUBMITTED BY:	LST Consulting Engineers, PA	CONTRACT NO.:	W91278-14-D-6002-0002
PLOT SCALE:	1/8" = 1'-0"	FILE NUMBER:	
SIZE:	ARCH-E1	PLOT DATE:	10 DEC 2015
FILE NAME:			

U.S. ARMY CORPS OF ENGINEERS
LITTLE ROCK DISTRICT



REPAIR OF BUILDING INFRASTRUCTURE SYSTEMS
19th MEDICAL GROUP
1090 ARNOLD DRIVE
LITTLE ROCK AIR FORCE BASE, AR 72099-5057

FIRST FLOOR - PHASE 4 - ACCESS CONTROLS PLAN

SHEET
IDENTIFICATION
E-5.01




10 INTERIOR DOORS
1 EXTERIOR DOORS

1 FIRST FLOOR - PHASE 4 - ACCESS CONTROLS PLAN
SCALE: 1/16" = 1'-0"



EECI
ENERGY ENGINEERING
CONSULTANTS, INC.

10 CORPORATE HILL DR., STE. 100 PH: (501) 244-051
LITTLE ROCK, AR 72205 FX: (501) 244-024

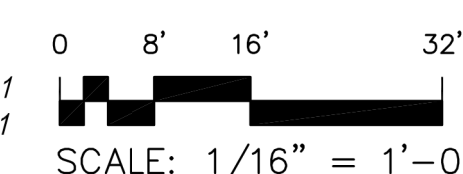

RECORD DRAWING AS-BUILT