


1 FIRST FLOOR - PHASE 5 - ACCESS CONTROLS PLAN
SCALE: 1/16" = 1'-0"

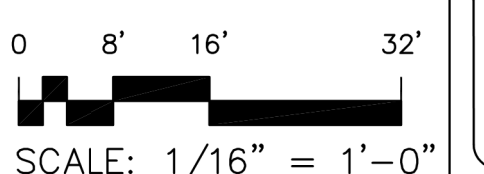

EECI
ENERGY ENGINEERING
CONSULTANTS, INC.

10 CORPORATE HILL DR., STE. 100 PH: (501) 244-0511
LITTLE ROCK, AR 72205 FX: (501) 244-0241



SHEET
IDENTIFICATION
E-6.01
OF

RECORD DRAWING AS-BUILT



12 INTERIOR DOORS
1 EXTERIOR DOORS

REPAIR OF BUILDING INFRASTRUCTURE SYSTEMS
10th MEDICAL GROUP
LITTLE ROCK AIR FORCE BASE, AR 72099-5057
FIRST FLOOR - PHASE 5 - ACCESS CONTROLS PLAN



DESIGNED BY: U.S. ARMY CORPS OF ENGINEERS
CHECKED BY: JLS
DATE: 10 DEC 2015
SOLUTION NO.: W12315-14-0005
LST
LAST MODIFIED BY: B. Engstrom, PA
W12315-14-0005-0002
FILE NUMBER:
PLOT SCALE: 1/16" = 1'-0"
10 DEC 2015
FILE NAME:
RACOLET

DATE	DESCRIPTION	MARK
10 DEC 2015	RECORD DRAWING AS-BUILT	65% REVIEW

DATE	DESCRIPTION	MARK
10 DEC 2015	RECORD DRAWING AS-BUILT	65% REVIEW

