




2 TV ANTENNA DIAGRAM

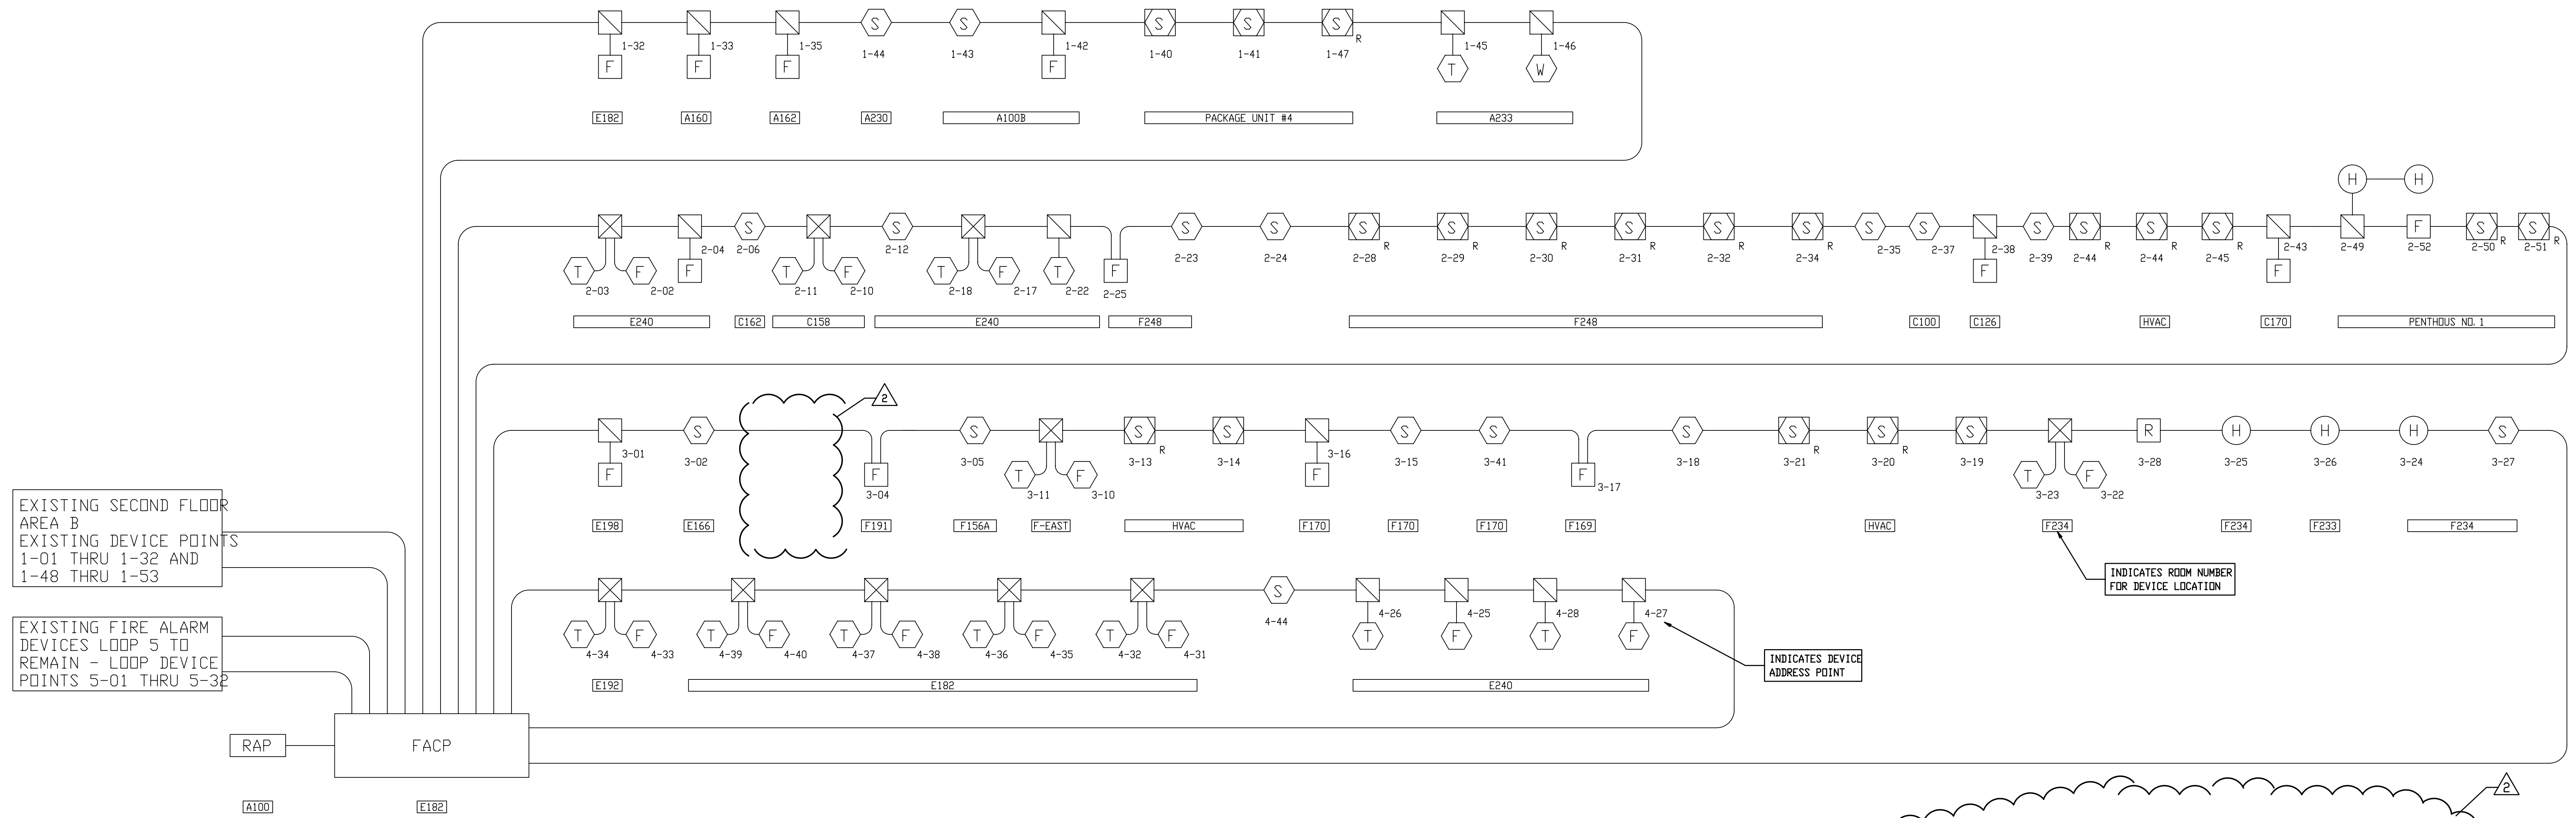


1 FIRE ALARM DIAGRAM

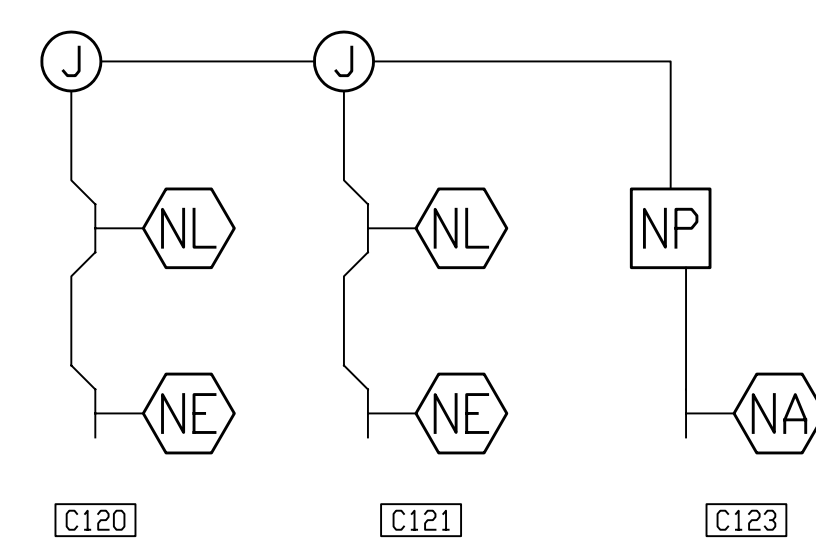


NURSE CALL DIAGRAM

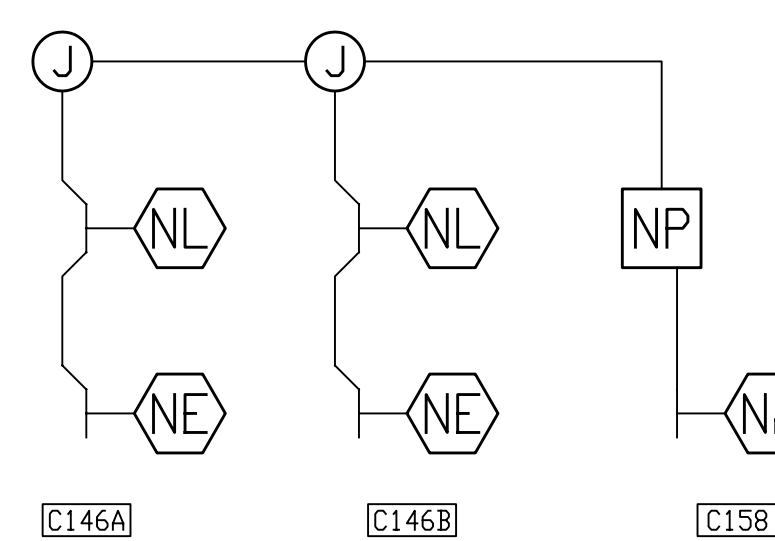

2 NURSE CALL DIAGRAM

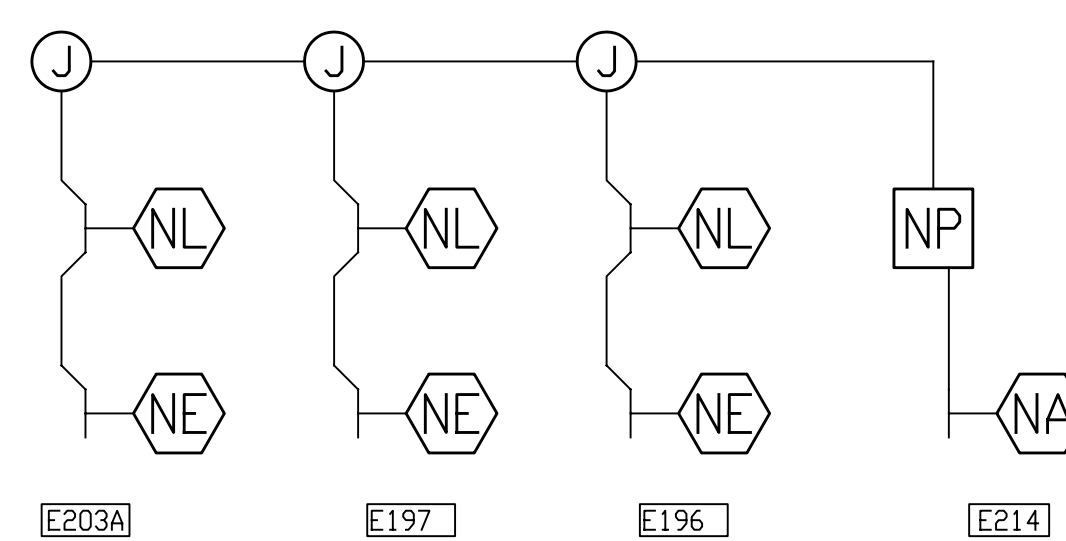



3 NURSE CALL DIAGRAM

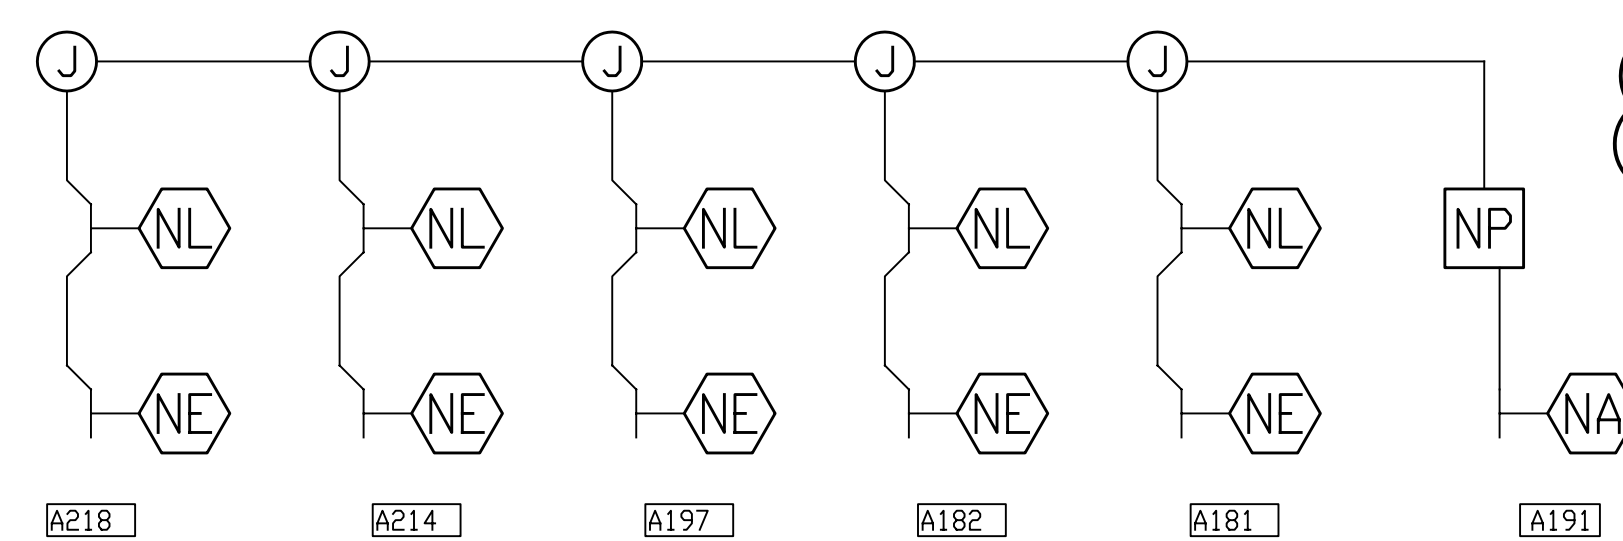

4 ^{NTS} NURSE CALL DIAGRAM

FIRE ALARM EQUIPMENT LEGEND			
SYMBOL	MODEL NO.	DESCRIPTION	REMARKS
	MXL	PYROTRODNICS MAIN ANALOG/ADDRESSABLE PANEL WITH ADDRESSABLE LOOPS, AUDIBLE CIRCUITS AND 24 HR. STANDBY BATTERIES	EXISTING
	RCC-1FT	PYROTRODNICS REMOTE ANNUNCIATOR/CONTROL PANEL.	FLUSH MOUNT AS INDICATED.
	MSI-10B	MANUAL FIRE ALARM STATION, SINGLE ACTION ADDRESSABLE TYPE	FLUSH MOUNT TO 3 1/2" DEEP OUTLET BOX, MOUNT 48" A. F. F.
	FP-11 w/ DB-11	PHOTO ELECTRIC SMOKE DETECTOR, ADDRESSABLE TYPE WITH STANDARD 2 WIRE BASE	MOUNTS TO 4" OCTAGON BOX.
	FP-11 w/ DB-11XPR	PHOTO ELECTRIC SMOKE DETECTOR, ADDRESSABLE TYPE WITH RELAY SURFACE BASE	MOUNTS TO 4" OCTAGON BOX.
	AD-11 XPR w/FP-11	PHOTO ELECTRIC DUCT SMOKE DETECTOR, ADDRESSABLE TYPE WITH RELAY SURFACE BASE	MOUNT AS INDICATED ON DRAWINGS. FINAL LOCATION TO BE DETERMINED IN FIELD.
	FP-11 w/ DB-11	135° THERMAL DETECTOR, ADDRESSABLE TYPE WITH STANDARD 2 WIRE SURFACE BASE.	MOUNTS TO 4" OCTAGON BOX.
	EXISTING	COMBINATION HORN/STROBE, 24V D/C, (ADA APPROVED)	MOUNTS TO 4" SQ. BY 2 1/8" DEEP BOX. MOUNT 6" BELOW FINISHED CEILING.
15	EXISTING	STROBE ONLY UNIT, 24V D/C, 15 INDICATES CP (ADA APPROVED)	MOUNTS TO STANDARD 4" SQ. BOX. SEE
	TRI-S	ADDRESSABLE INTERFACE MODULE-SINGLE ADDRESS	MOUNTS TO STANDARD 4" SQ. BOX
	TRI-D	ADDRESSABLE INTERFACE MODULE-DUAL ADDRESS	MOUNT IN FTC
	TRI-R	ADDRESSABLE INTERFACE MODULE-SINGLE ADDRESS w/ PROGRAMMABLE RELAY	
	--	24V D/C SPRINKLER SOLENOID	BY OTHERS
	--	SPRINKLER SYSTEM WATERFLOW SWITCH	BY OTHERS
	--	SPRINKLER SYSTEM TAMPER SWITCH	BY OTHERS
	--	PULL BOX WITH COVERPLATE PAINTED RED	4 11/16" DEEP BOX.
	SDH-2D	24V D/C SEMI-FLUSH MOUNTED MAGNETIC DOOR HOLDER	
	--	CONDUIT UP	
	--	CONDUIT DOWN	
	--	RESET SW. INDICATING SMOKE DAMPERS ABOVE CEILING	
	--	--	(E) DENOTED EXISTING DEVICE

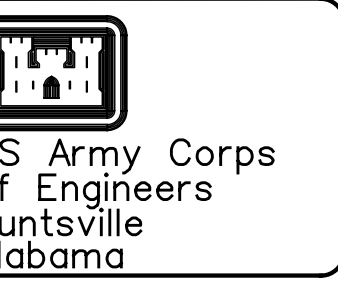[illegible]

U.S. ARMY ENGINEERING AND SUPPORT CENTER CORPS OF ENGINEERS HUNTSVILLE, ALABAMA	 E A R T H T E C H 3315 Waterford Rd., Oak Brook, IL 60521 • (630) 574-0000	DRAWN BY:	PROJECT NO. 61503	DATE: 09/04/2003
		CHECKED BY:	DRAWING CODE:	
		REVIEWED BY:	SOLICITATION NUMBER:	

**FIRE ALARM RISER DIAGRAM
AS-BUILT**

SHEET
REFERENCE
NUMBER:
E2.02
SHEET X OF XX