

REVISIONS
DATE
BY
DESCRIPTION

8
7
6
5
4
3
2
1

A

B

C

D

E




F

G

H

I


J

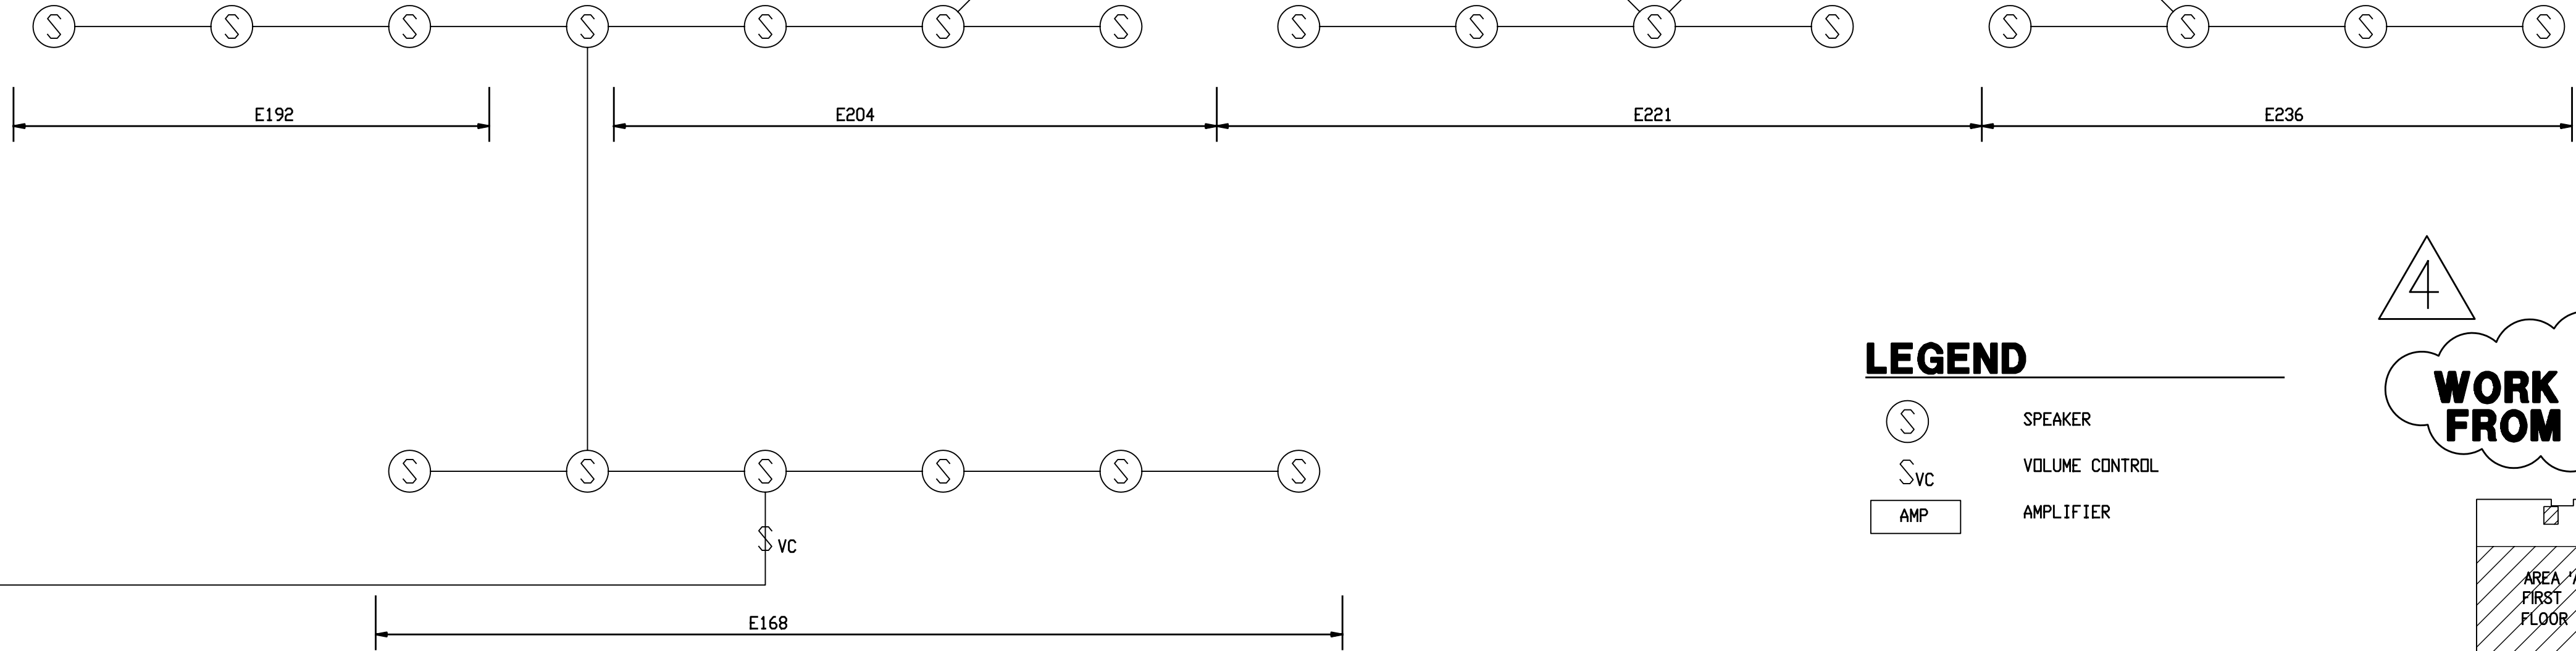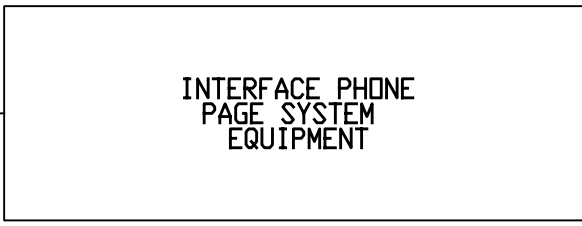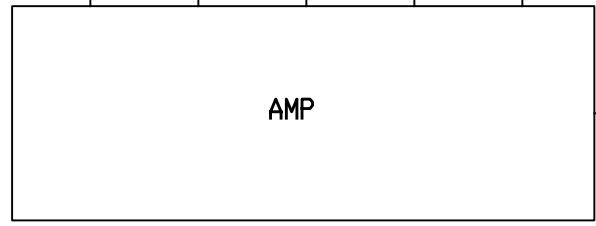

LEGEND

- (S) SPEAKER
SVC VOLUME CONTROL
AMP AMPLIFIER

4
WORK OF ZONE B DELETED
FROM SCOPE OF PROJECT

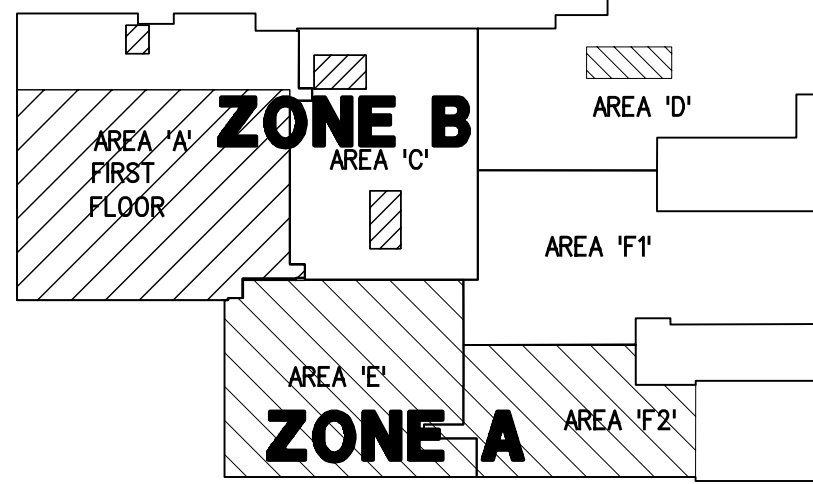

KEY PLAN

N.T.S.

SCALE



US Army Corps
of Engineers
Huntsville
Alabama

REVISIONS	DATE	BY	DESCRIPTION
A	8/07/2005		REVISIONS AS-BUILT
B	10/31/2003		ISSUED FOR FINAL WORK PLAN
C	10/14/2003		ADDITIONAL NEW SHEET
D	10/17/2003		ISSUED FOR CONSTRUCTION
E	10/17/2003		ISSUED FOR CONSTRUCTION
DESIGNED BY: DATE: 08/04/2003	PROJECT NO: 6503
DRAWN BY:	DRAWING CODE:
CHECKED BY:	REVIEWED BY: SOLICITATION NUMBER:

U.S. ARMY ENGINEERING AND SUPPORT CENTER
CORPS OF ENGINEERS
HUNTSVILLE, ALABAMA

EARTHTECH

FLM Design

RENOVATE CLINIC
BUILDING 1090
LITTLE ROCK AFB, ARKANSAS

PA DIAGRAM
AS-BUILT

SHEET
REFERENCE
NUMBER:
E2.03
SHEET X OF XX