

LITTLE ROCK A.F.B.
ARKANSAS

GARVER ENGINEERS

1010 BATTERY STREET
LITTLE ROCK, ARKANSAS 72202
www.garverengineers.com
(501) 376-3633

CROMWELL
ARCHITECTS ENGINEERS

101 SOUTH SPRING ST
LITTLE ROCK AR 72201
TELEPHONE 501-372-2900
FACSIMILE 501-372-0482

No.	Revision/Issue	Date	BY	APP'D


PROJECT TITLE REPAIR & RENOVATE MEDICAL CLINIC PH IV LITTLE ROCK AIR FORCE BASE JACKSONVILLE, ARKANSAS 100% SUBMITTAL		SHEET TITLE FIRE PROTECTION INSTALLATION PLAN AREA "B"	
DRAWN BY CAG	LEAD DESIGNER JCF	PROJECT NUMBER NKAK#06-8006-4	F-202
TECH REVIEWER JCF	DESIGNED BY JCF	SHEET	
DATE JULY 1, 2008	SCALE AS SHOWN	20 OF	



1 FIRE PROTECTION INSTALLATION PLAN AREA "B"
SCALE: 1/8" = 1'-0"

SPRINKLER SYMBOL LEGEND

- EXISTING SPRINKLER HEAD TO REMAIN
- NEW SPRINKLER HEAD

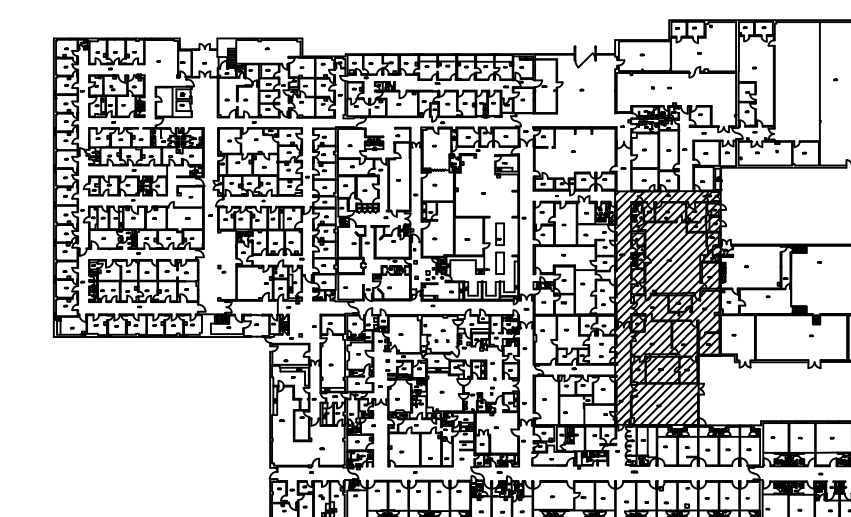

KEY PLAN